

STONE FILL TYPE I & GRUBBING MATERIAL (6")
~~STA. 90+10 TO 90+56, LT~~
~~STA. 94+85 TO 95+00, RT~~

DURABLE 4 INCH WHITE LINE (OPTION BID ITEM)
 TEMPORARY 4 INCH WHITE LINE, PAINT
 (ALL LINES SHALL INCLUDE EDGE LINE BREAKS AND RADII FOR SIDE ROADS)
 STA. 90+00 TO 95+00, SOLID LT & RT

DURABLE 4 INCH YELLOW LINE (OPTION BID ITEM)
 TEMPORARY 4 INCH YELLOW LINE, PAINT
 (ALL LINES SHALL INCLUDE CENTER LINE BREAKS FOR SIDE ROADS)
 STA. 90+00 TO 95+00, SOLID LT, DASHED RT

STEEL BEAM GUARDRAIL, GALVANIZED
 STA. 90+00.0 TO 90+62.5, LT
 STA. 91+17.5 TO 91+42.5, LT
 STA. 92+92.5 TO 93+17.5, LT
 STA. 92+00.0 TO 92+25.0, RT

STEEL BEAM GUARDRAIL, GALVANIZED W/ 8 FEET POSTS
 STA. 91+42.5 TO 92+92.5, LT
 STA. 92+25.0 TO 95+00.0, RT


ANCHOR FOR STEEL BEAM RAIL
 STA. 90+62.5, LT
 STA. 91+17.5, LT
 STA. 92+00.0, RT
 STA. 93+17.5, LT

REMOVAL AND DISPOSAL OF GUARDRAIL
 STA. 91+52 TO 92+01, LT
 STA. 92+29 TO 95+00, RT



CLEANING CULV. PIPE, IN-PLACE (GREATER THAN 24IN.)
 CULVERT #13, 100LF

BARRIER FENCE
 STA. 90+00 TO 95+00, LT
 STA. 91+35 TO 95+00, RT

EROSION LOG
 STA. 90+00 TO 95+00, LT
 STA. 92+10 TO 93+15, RT
 STA. 94+40 TO 95+00, RT

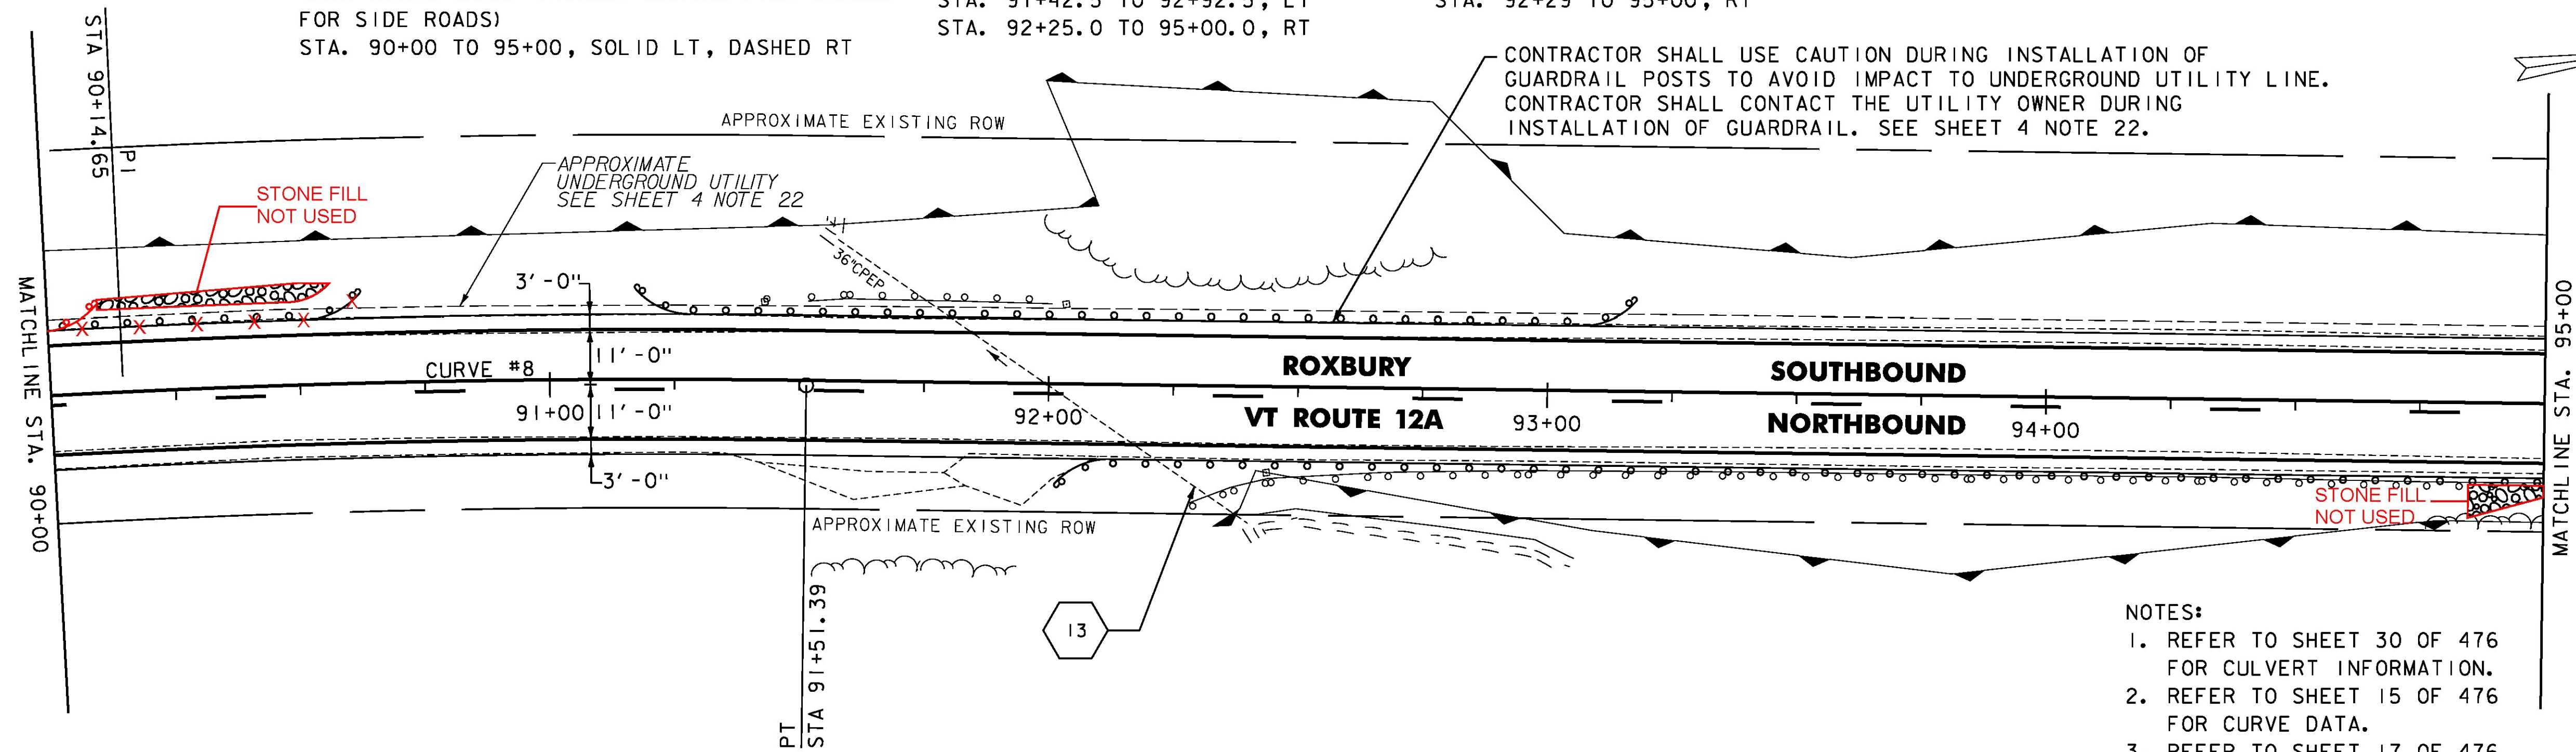

- NOTES:
1. REFER TO SHEET 30 OF 476 FOR CULVERT INFORMATION.
 2. REFER TO SHEET 15 OF 476 FOR CURVE DATA.
 3. REFER TO SHEET 17 OF 476 FOR SOIL BORING DATA.

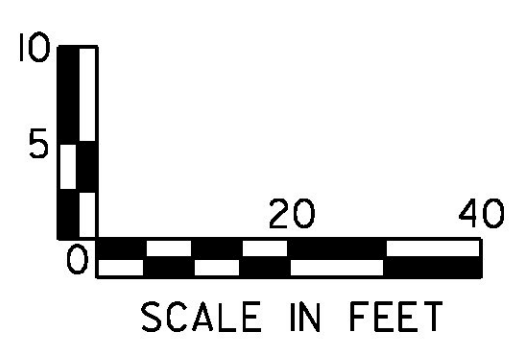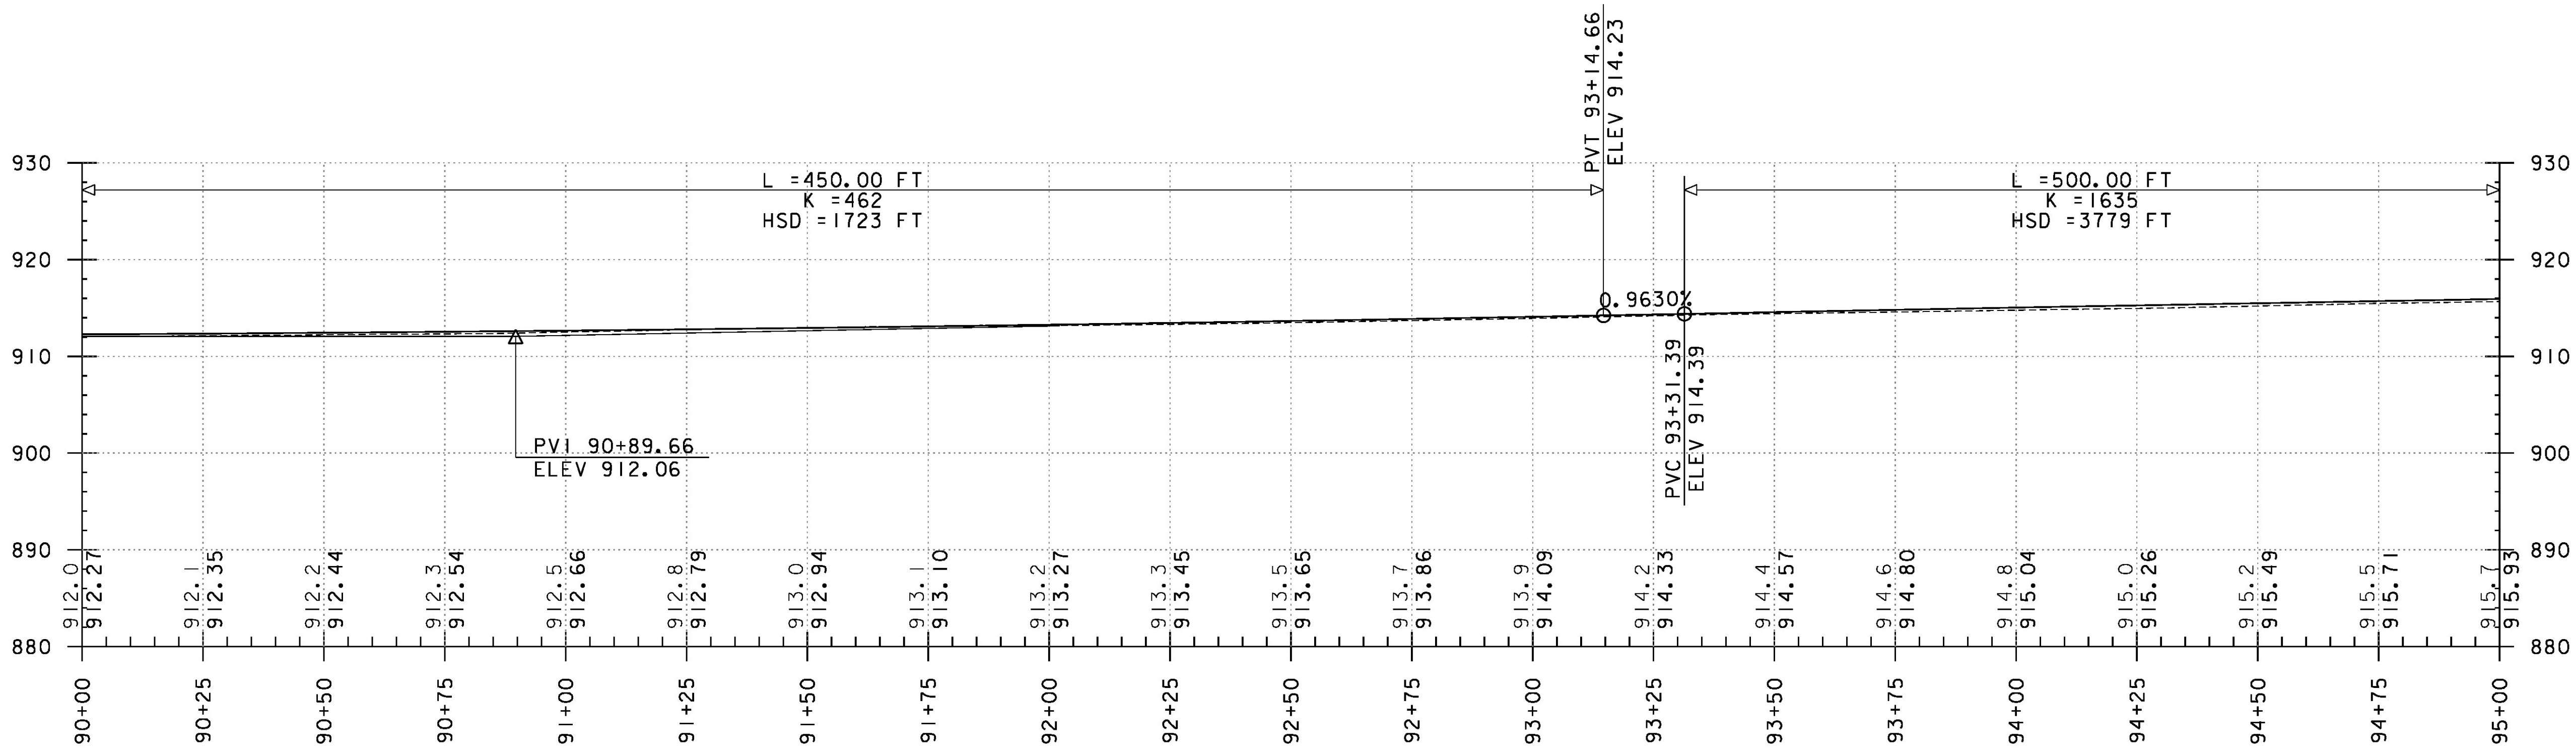

PROJECT NAME: ROXBURY - NORTHFIELD	PLOT DATE: 5/25/2016
PROJECT NUMBER: ER STP 0187(13)	DRAWN BY: G. BARRETT
FILE NAME: z13cl84bdr.dgn	CHECKED BY: G. EDWARDS
PROJECT LEADER: M. FOISY	SHEET 62 OF 476
DESIGNED BY: G. BURGMEIER	
PLAN & PROFILE SHEET 12	