

STONE FILL TYPE I & GRUBBING MATERIAL (6")
~~STA. 95+00 TO 96+55, RT~~

DURABLE 4 INCH WHITE LINE (OPTION BID ITEM)
 TEMPORARY 4 INCH WHITE LINE, PAINT
 (ALL LINES SHALL INCLUDE EDGE LINE BREAKS AND RADII FOR SIDE ROADS)
 STA. 95+00 TO 100+00, SOLID LT & RT

DURABLE 4 INCH YELLOW LINE (OPTION BID ITEM)
 TEMPORARY 4 INCH YELLOW LINE, PAINT
 (ALL LINES SHALL INCLUDE CENTER LINE BREAKS FOR SIDE ROADS)
 STA. 95+00 TO 96+36, SOLID LT, DASHED RT
 STA. 96+36 TO 100+00, DASHED C

REMOVING SIGNS AS SHOWN - 1

STEEL BEAM GUARDRAIL, GALVANIZED
 STA. 96+37.5 TO 96+62.5, RT
 STA. ~~98+82.8~~ TO ~~99+07.8~~, LT
 99+00.0 99+25.0



STEEL BEAM GUARDRAIL, GALVANIZED W/ 8 FEET POSTS
 STA. 95+00.0 TO 96+37.5, RT
 STA. ~~99+07.8~~ TO 100+00.0, LT
 25.0

ANCHOR FOR STEEL BEAM RAIL
 STA. 96+62.5, RT
 STA. ~~98+82.8~~, LT
 99+00.0




REMOVAL AND DISPOSAL OF GUARDRAIL
 STA. 95+00 TO 96+26, RT

BARRIER FENCE
 STA. 95+00 TO 100+00, LT
 STA. 95+00 TO 98+05, RT
 EROSION LOG
 STA. 95+00 TO 100+00, LT
 STA. 95+00 TO 97+25, RT

CONTRACTOR SHALL USE CAUTION DURING INSTALLATION OF GUARDRAIL POSTS TO AVOID IMPACT TO UNDERGROUND UTILITY LINE. CONTRACTOR SHALL CONTACT THE UTILITY OWNER DURING INSTALLATION OF GUARDRAIL. SEE SHEET 4 NOTE 22.

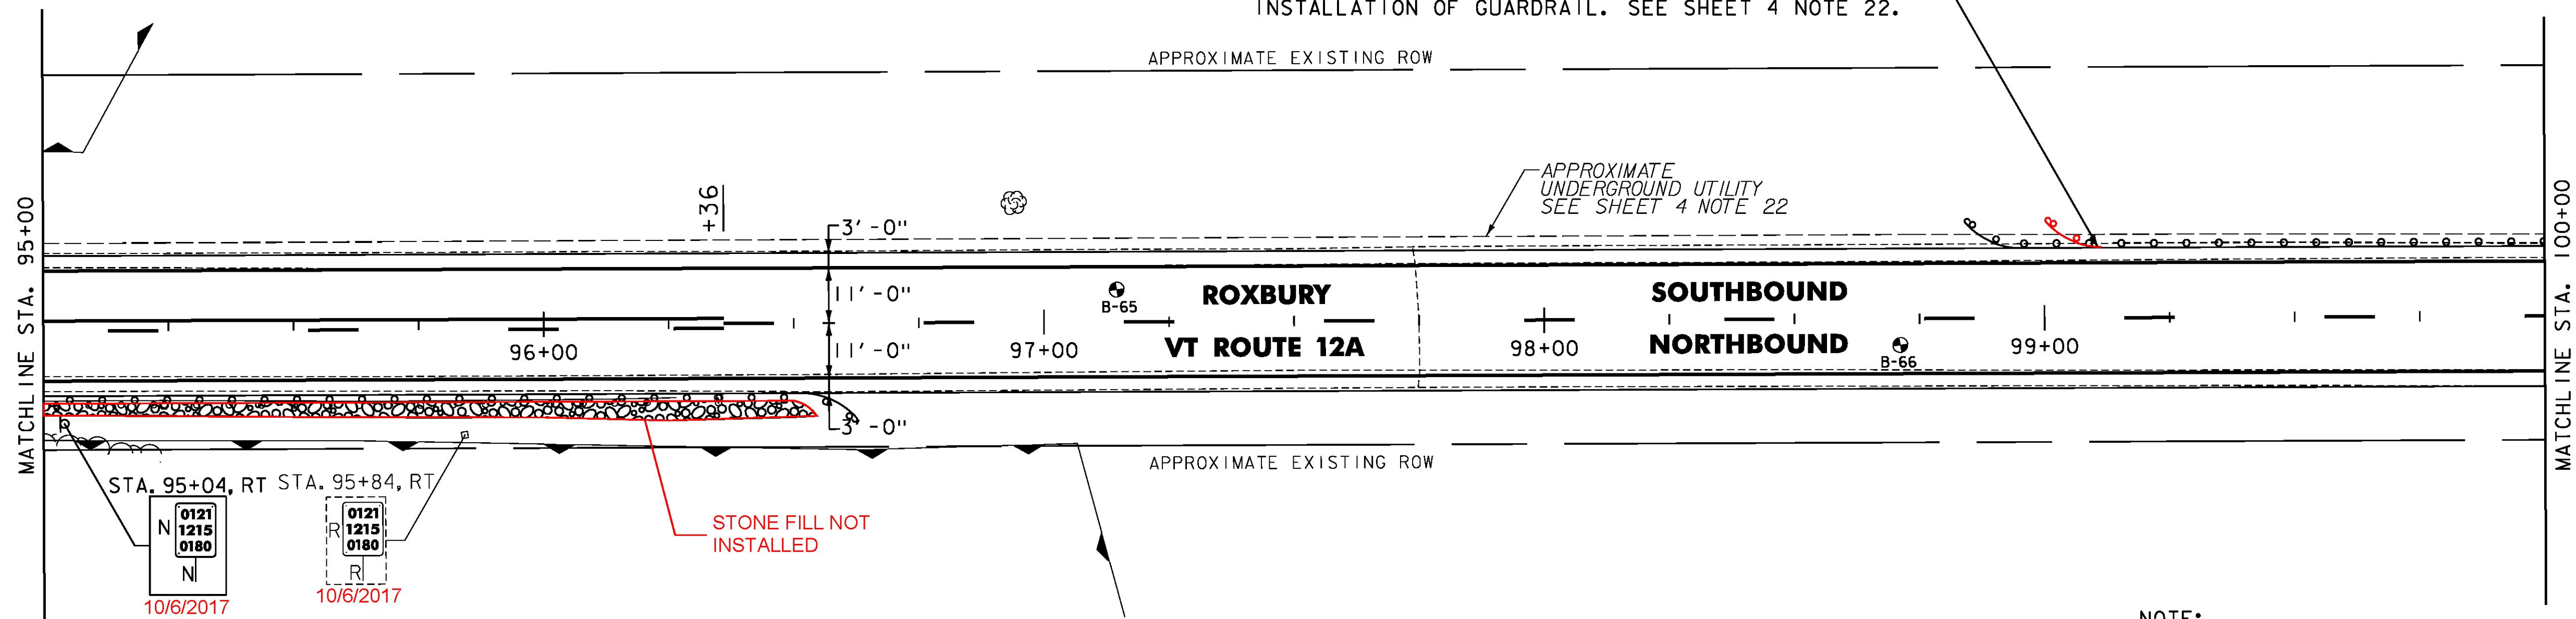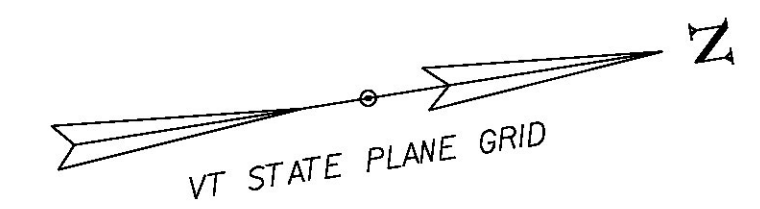

NOTE:
 1. REFER TO SHEET 17 OF 476 FOR SOIL BORING DATA.

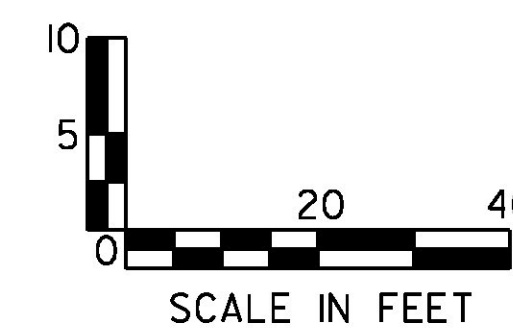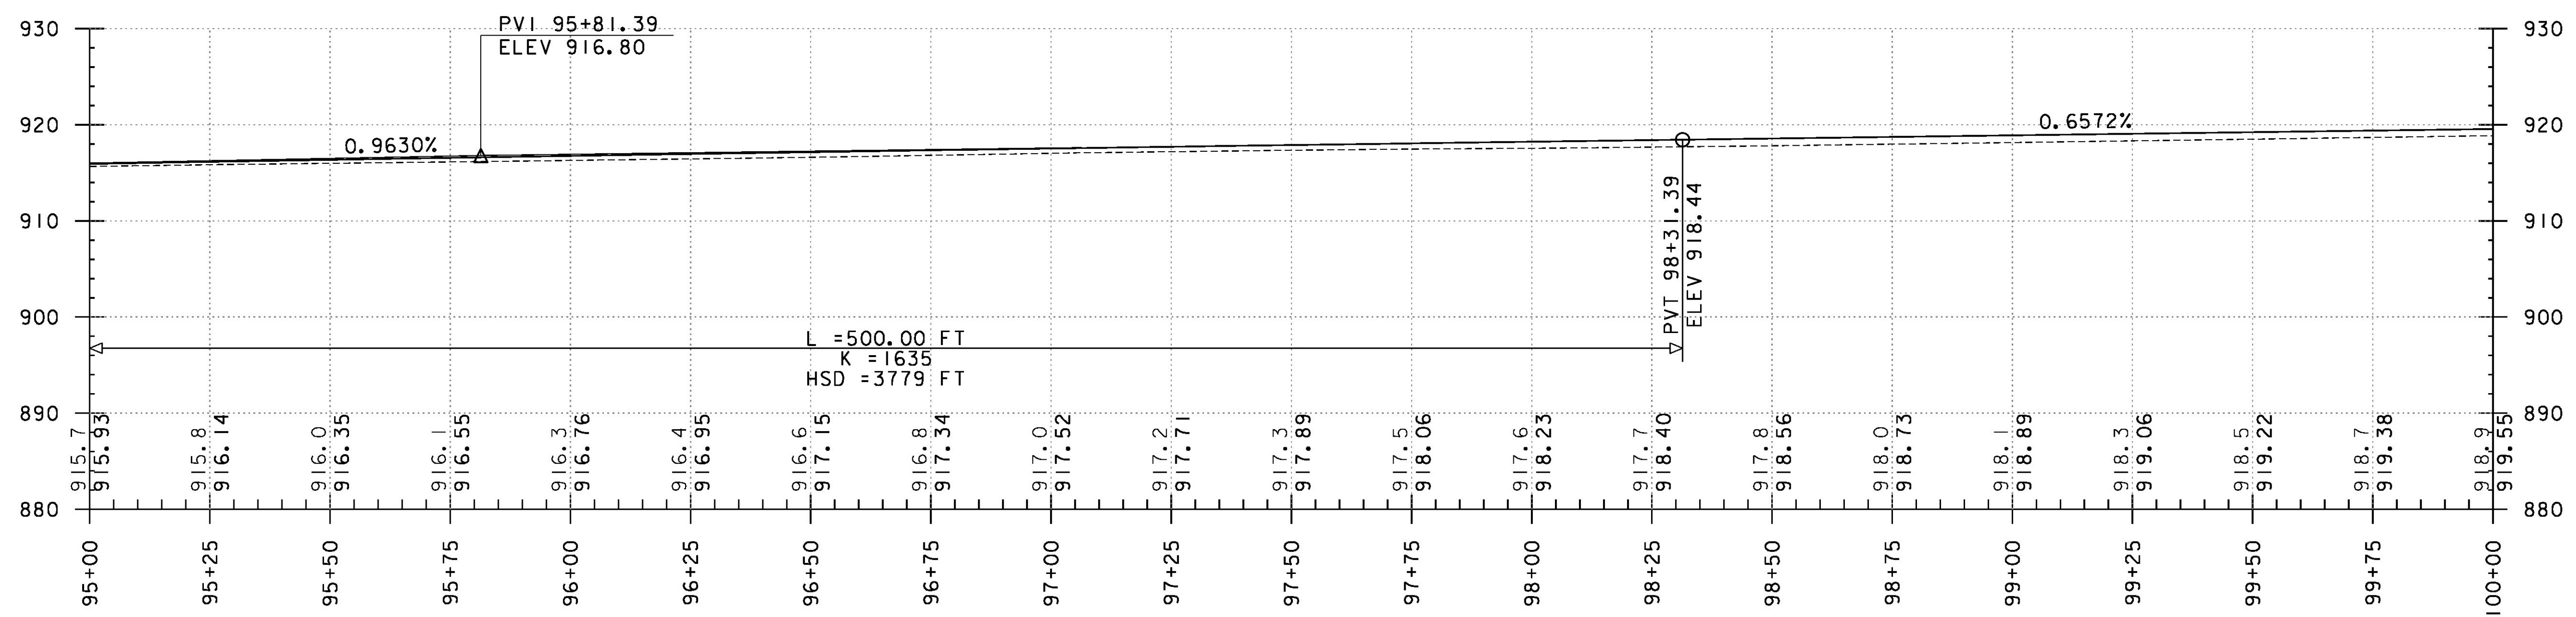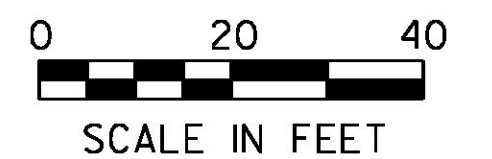

PROJECT NAME: ROXBURY - NORTHFIELD
 PROJECT NUMBER: ER STP 0187(I3)

FILE NAME: z13cl84bdr.dgn
 PROJECT LEADER: M. FOISY
 DESIGNED BY: G. BURGMEIER
 PLAN & PROFILE SHEET I3

PLOT DATE: 5/25/2016
 DRAWN BY: G. BARRETT
 CHECKED BY: G. EDWARDS
 SHEET 63 OF 476