

STONE FILL TYPE I & GRUBBING MATERIAL (6")  
 STA. 117+25 TO 118+44, RT


DURABLE 4 INCH WHITE LINE (OPTION BID ITEM)  
 TEMPORARY 4 INCH WHITE LINE, PAINT  
 (ALL LINES SHALL INCLUDE EDGE LINE BREAKS AND RADII FOR SIDE ROADS)  
 STA. 115+00 TO 120+00, SOLID LT & RT

DURABLE 4 INCH YELLOW LINE (OPTION BID ITEM)  
 TEMPORARY 4 INCH YELLOW LINE, PAINT  
 (ALL LINES SHALL INCLUDE CENTER LINE BREAKS FOR SIDE ROADS)  
 STA. 115+00 TO 120+00, SOLID LT & RT

STEEL BEAM GUARDRAIL, GALVANIZED  
 STA. 115+43.5 TO 116+56.0, RT  
 STA. 116+31.0 TO 116+56.0, LT  
 STA. 117+43.5 TO 118+56.0, RT  
 STA. 117+43.5 TO 118+43.5, LT  
 STA. 119+22.2 TO 119+97.2, LT  
 STA. 119+92.0 TO 120+00.0, RT  
 HD STEEL BEAM GUARDRAIL, GALVANIZED  
 STA. 119+97.2 TO 120+00.0, LT

STEEL BEAM GUARDRAIL, GALVANIZED/NESTED 8' REMOVING SIGNS AS SHOWN - 3  
 STA. 116+56.0 TO 117+43.5, LT  
 STA. 116+56.0 TO 117+43.5, RT  
 ANCHOR FOR STEEL BEAM RAIL  
 STA. 115+43.5, RT  
 STA. 116+31.0, LT  
 STA. 118+56.0, RT  
 STA. 118+43.5, LT  
 STA. 119+22.2, LT  
 STA. 119+92.0, RT

CONTRACTOR SHALL USE CAUTION DURING INSTALLATION OF GUARDRAIL POSTS TO AVOID IMPACT TO UNDERGROUND UTILITY LINE. CONTRACTOR SHALL CONTACT THE UTILITY OWNER DURING INSTALLATION OF GUARDRAIL. SEE SHEET 4 NOTE 22.

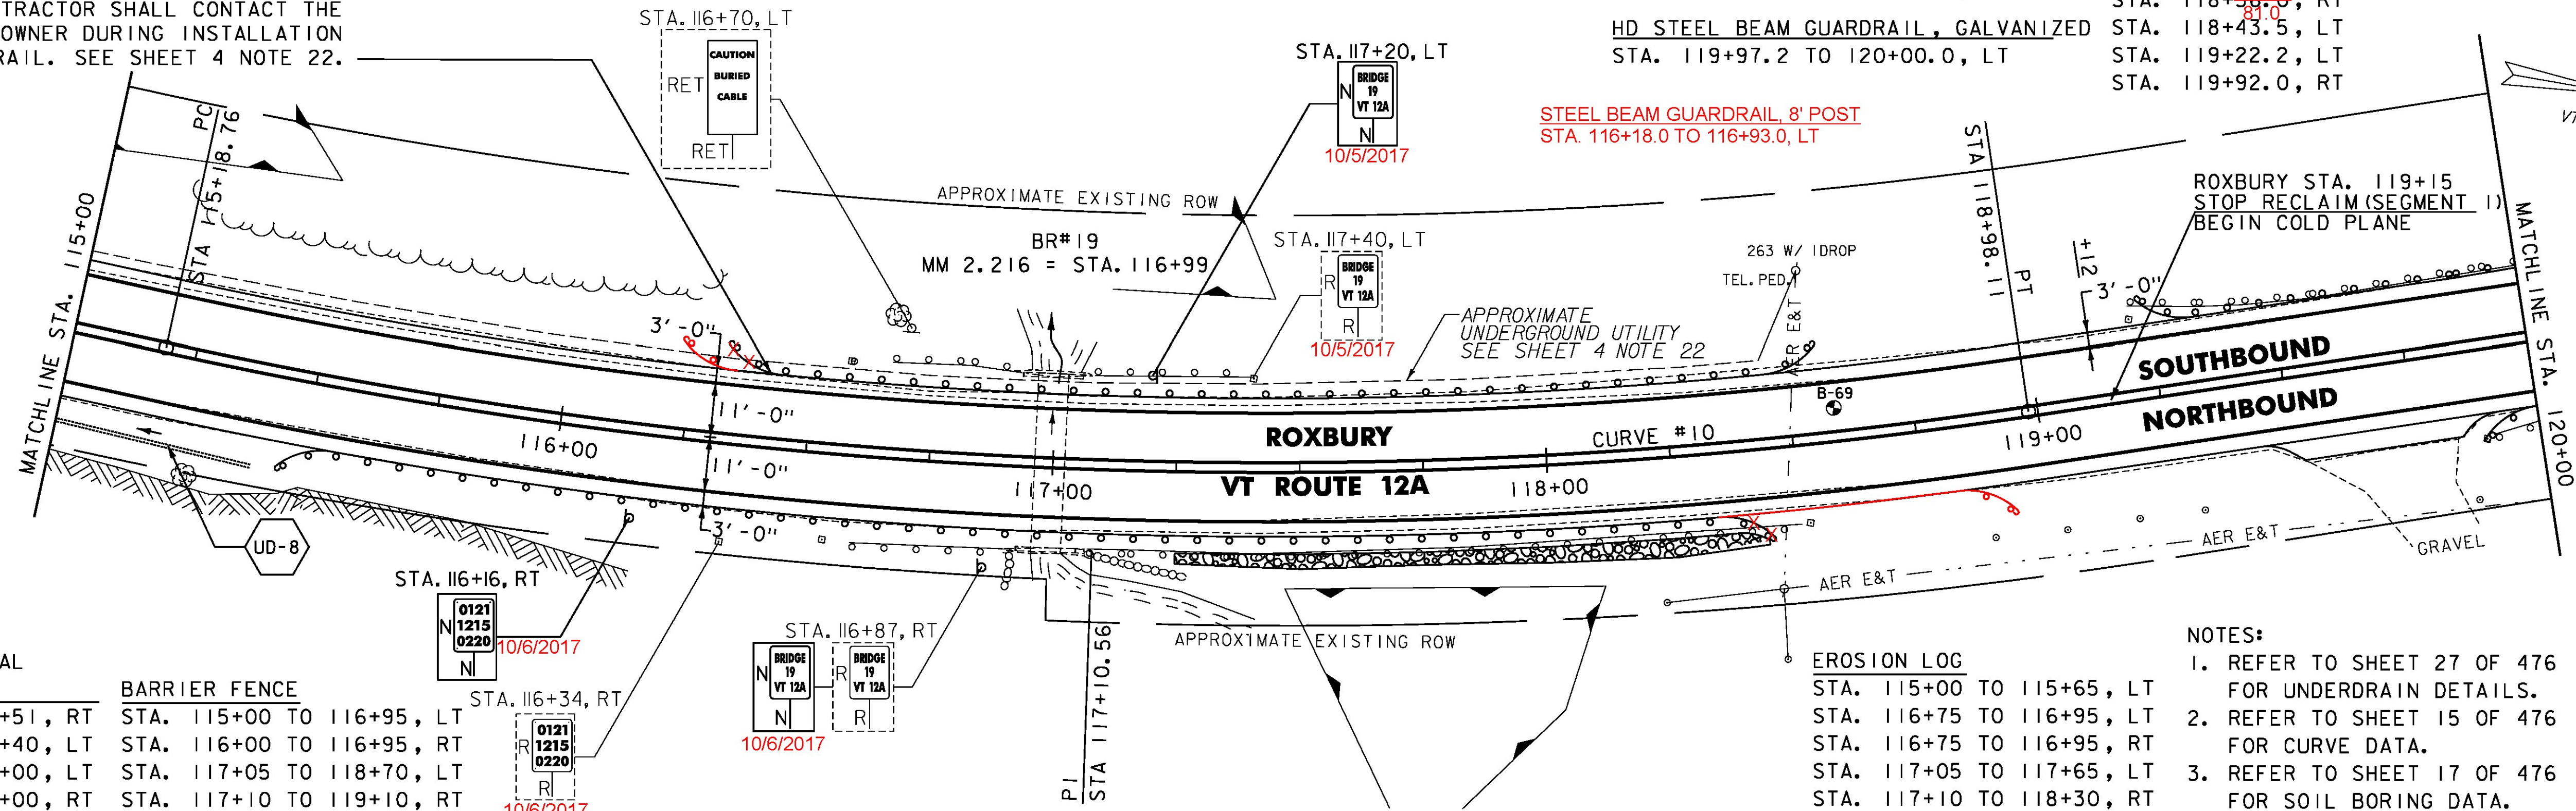




REMOVAL AND DISPOSAL OF GUARDRAIL

BARRIER FENCE

STA. 116+61 TO 118+51, RT	STA. 115+00 TO 116+95, LT
STA. 116+65 TO 117+40, LT	STA. 116+00 TO 116+95, RT
STA. 119+21 TO 120+00, LT	STA. 117+05 TO 118+70, LT
STA. 119+91 TO 120+00, RT	STA. 117+10 TO 119+10, RT

NOTES:

- REFER TO SHEET 27 OF 476 FOR UNDERDRAIN DETAILS.
- REFER TO SHEET 15 OF 476 FOR CURVE DATA.
- REFER TO SHEET 17 OF 476 FOR SOIL BORING DATA.

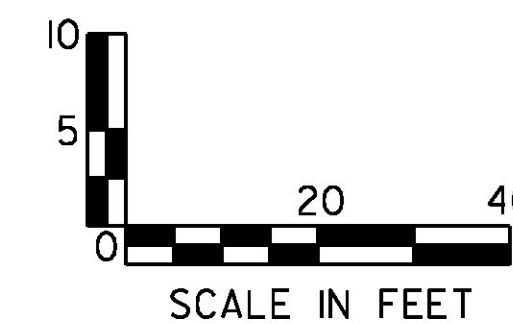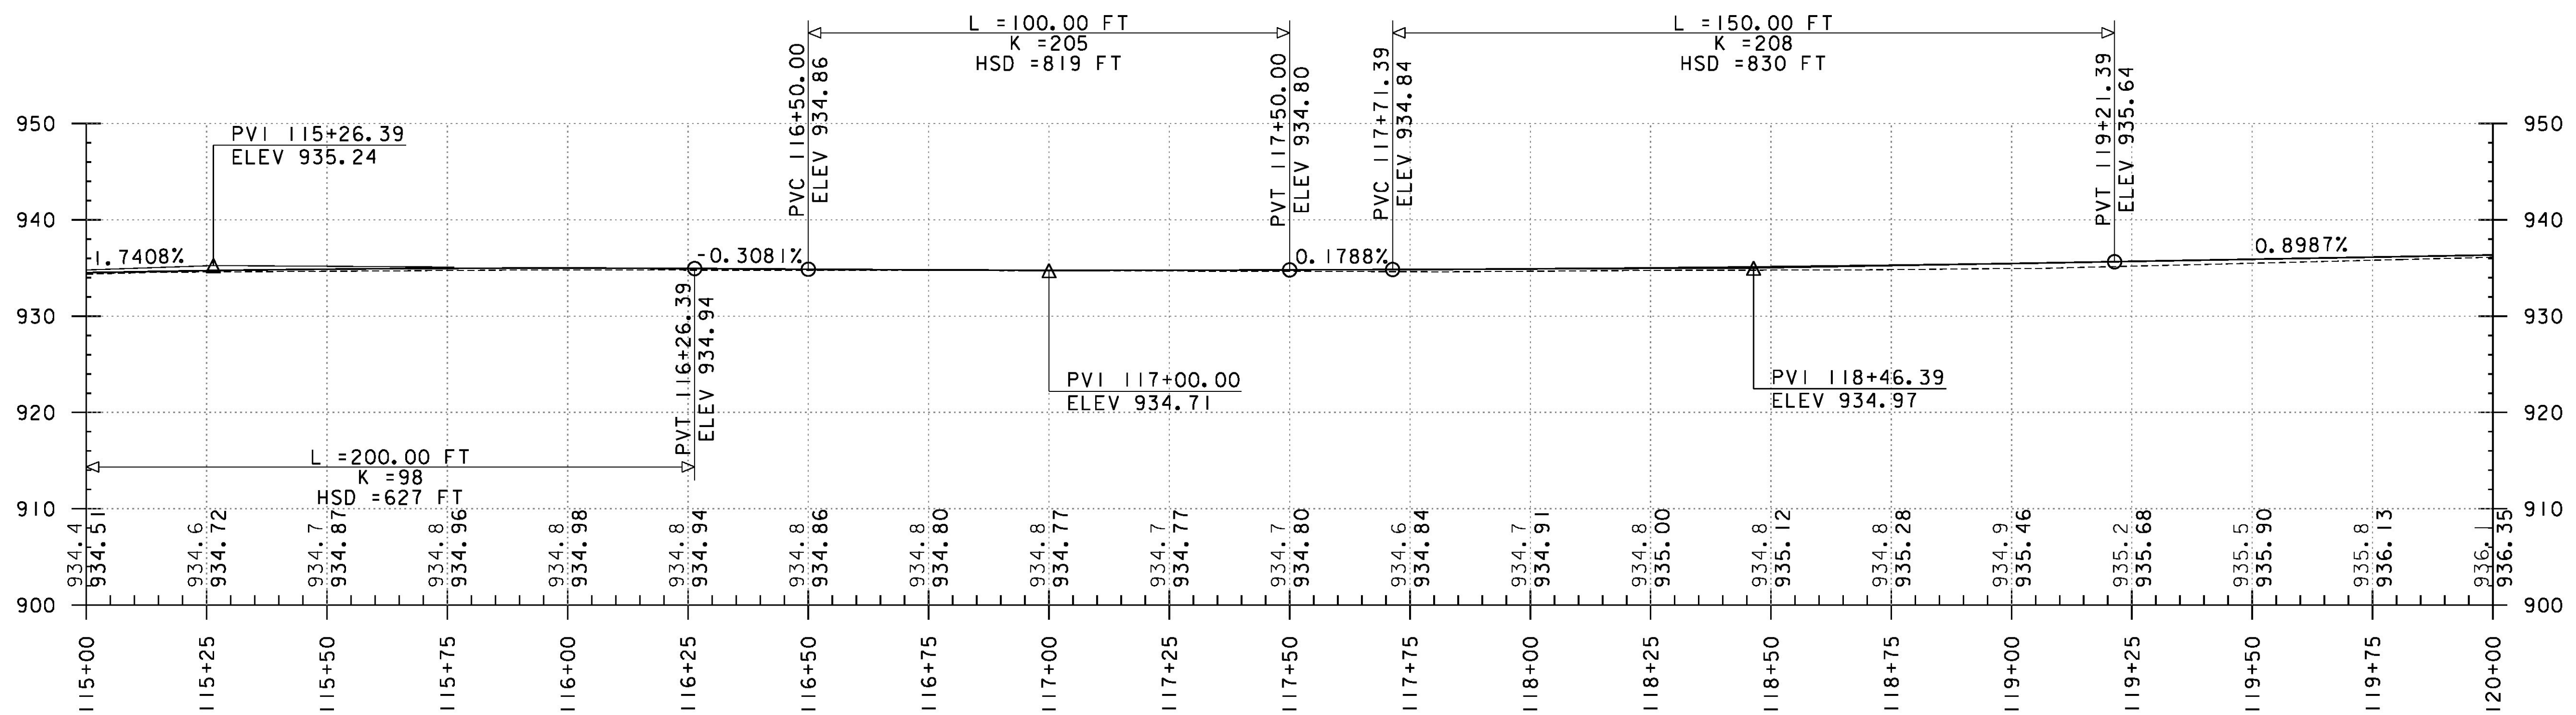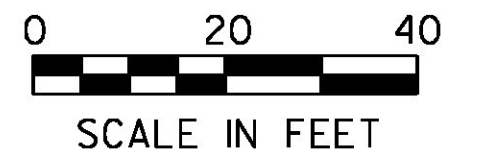

PROJECT NAME: ROXBURY - NORTHFIELD  
 PROJECT NUMBER: ER STP 0187(13)

FILE NAME: z13cl84bdr.dgn  
 PROJECT LEADER: M. FOISY  
 DESIGNED BY: G. BURGMEIER  
 PLAN & PROFILE SHEET 17

PLOT DATE: 5/25/2016  
 DRAWN BY: G. BARRETT  
 CHECKED BY: G. EDWARDS  
 SHEET 67 OF 476