




STONE FILL TYPE I & GRUBBING MATERIAL (6")
~~STA. 165+25 TO 168+50, LT~~
~~STA. 169+18 TO 170+00, LT~~

DURABLE 4 INCH WHITE LINE (OPTION BID ITEM)
 TEMPORARY 4 INCH WHITE LINE, PAINT
 (ALL LINES SHALL INCLUDE EDGE LINE BREAKS AND RADII FOR SIDE ROADS)
 STA. 165+00 TO 170+00, SOLID LT & RT

DURABLE 4 INCH YELLOW LINE (OPTION BID ITEM)
 TEMPORARY 4 INCH YELLOW LINE, PAINT
 (ALL LINES SHALL INCLUDE CENTER LINE BREAKS FOR SIDE ROADS)
 STA. 165+00 TO 170+00, SOLID LT & RT

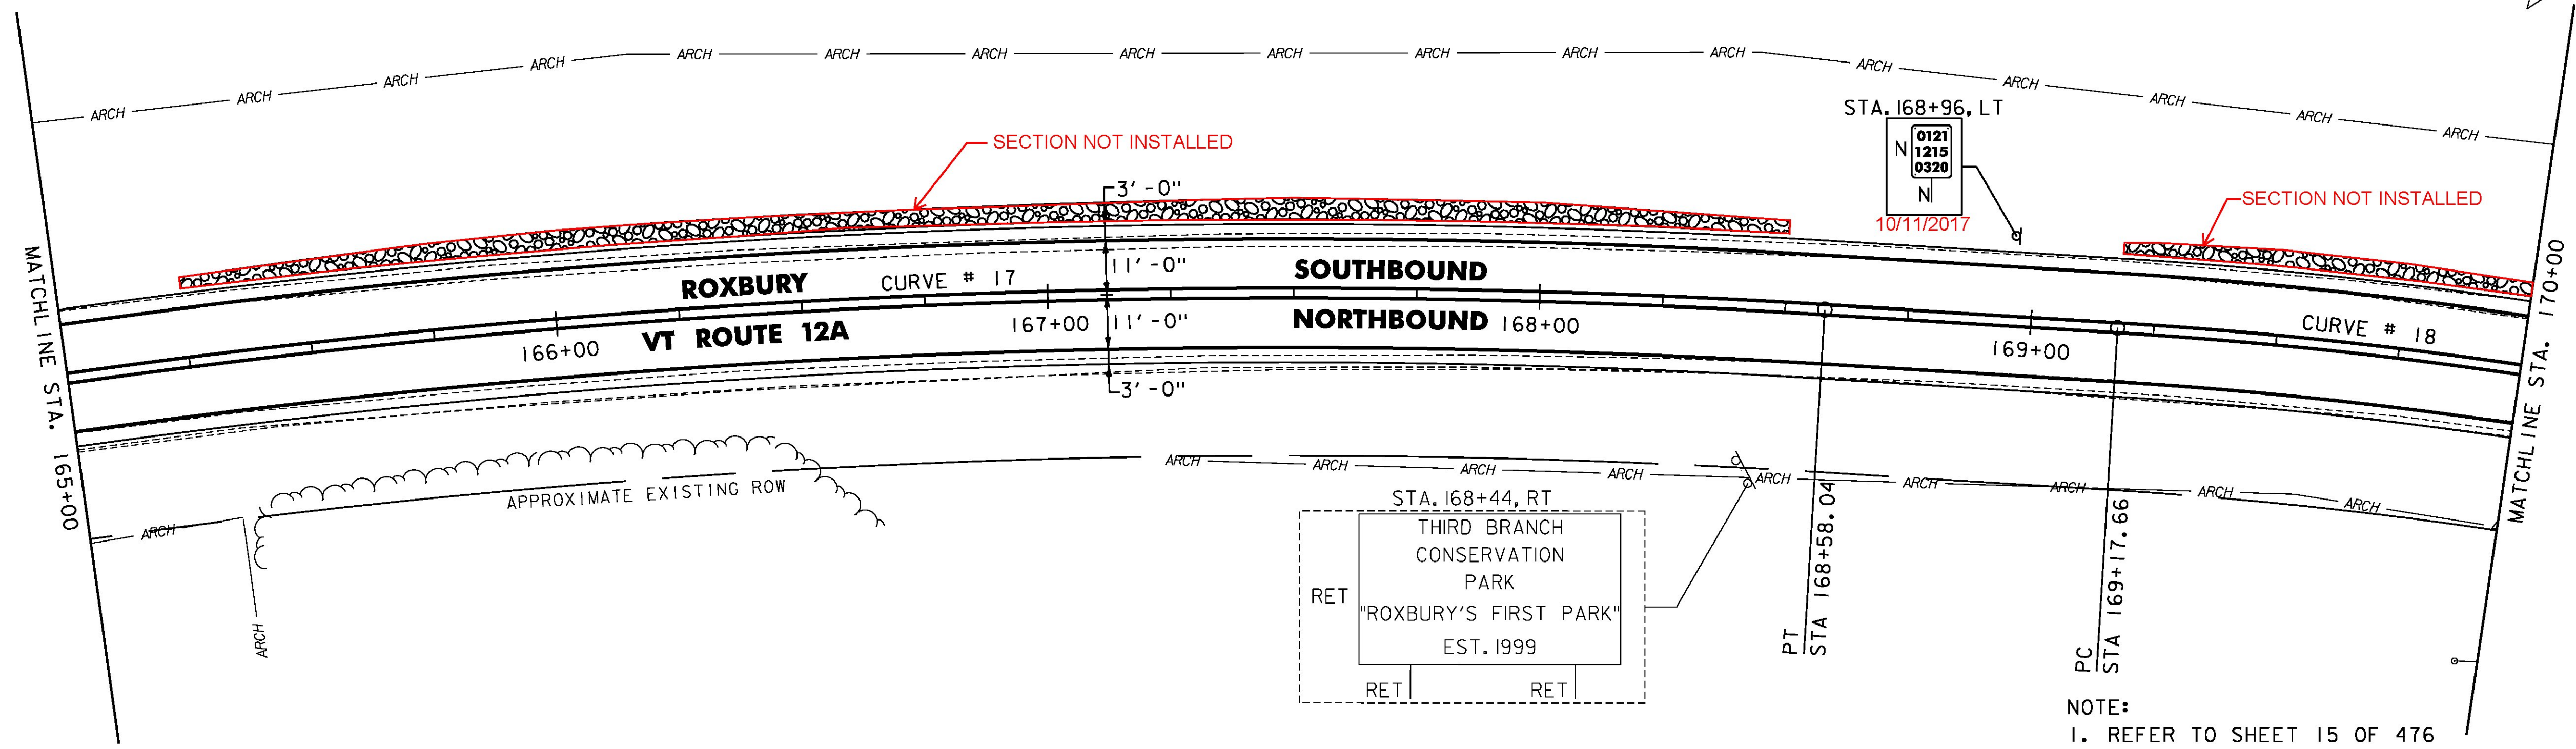

NOTE:
 1. REFER TO SHEET 15 OF 476 FOR CURVE DATA.

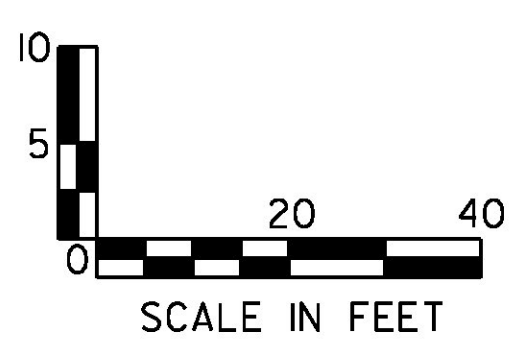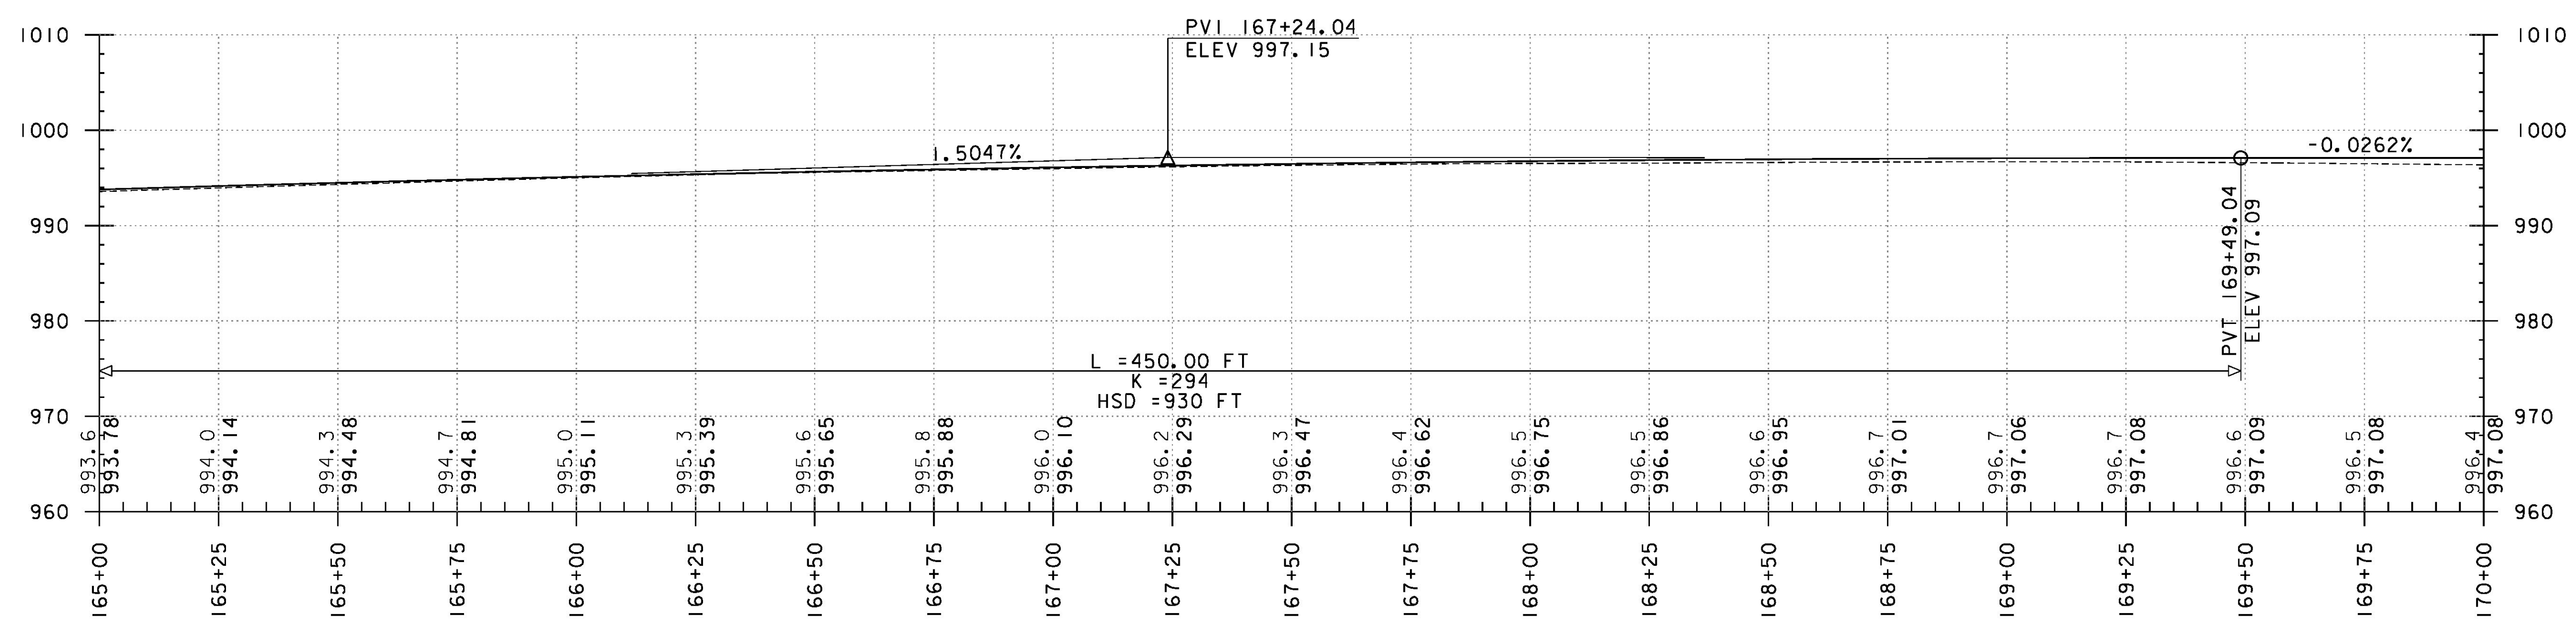

PROJECT NAME: ROXBURY - NORTHFIELD	PLOT DATE: 5/25/2016
PROJECT NUMBER: ER STP 0187(13)	DRAWN BY: G. BARRETT
FILE NAME: z13cl84bdr.dgn	CHECKED BY: G. EDWARDS
PROJECT LEADER: M. FOISY	SHEET 77 OF 476
DESIGNED BY: G. BURGMIEIER	
PLAN & PROFILE SHEET 27	