




STONE FILL TYPE I & GRUBBING MATERIAL (6")  
 STA. 176+25 TO 177+00, LT  
 175+00 TO 176+75, LT

DURABLE 4 INCH WHITE LINE (OPTION BID ITEM)  
 TEMPORARY 4 INCH WHITE LINE, PAINT  
 (ALL LINES SHALL INCLUDE EDGE LINE BREAKS AND RADII FOR SIDE ROADS)  
 STA. 175+00 TO 180+00, SOLID LT & RT

DURABLE 4 INCH YELLOW LINE (OPTION BID ITEM)  
 TEMPORARY 4 INCH YELLOW LINE, PAINT  
 (ALL LINES SHALL INCLUDE CENTER LINE BREAKS FOR SIDE ROADS)  
 STA. 175+00 TO 180+00, SOLID LT & RT

REMOVING SIGNS  
 AS SHOWN - 2

REMOVE AND RESET GUARDRAIL  
 STA. 175+00.0 TO 177+33.8, LT  
 STEEL BEAM GUARDRAIL  
 STA. 177+06 TO 177+43, LT  
 ANCHOR FOR STEEL BEAM GUARDRAIL  
 STA. 177+43, LT

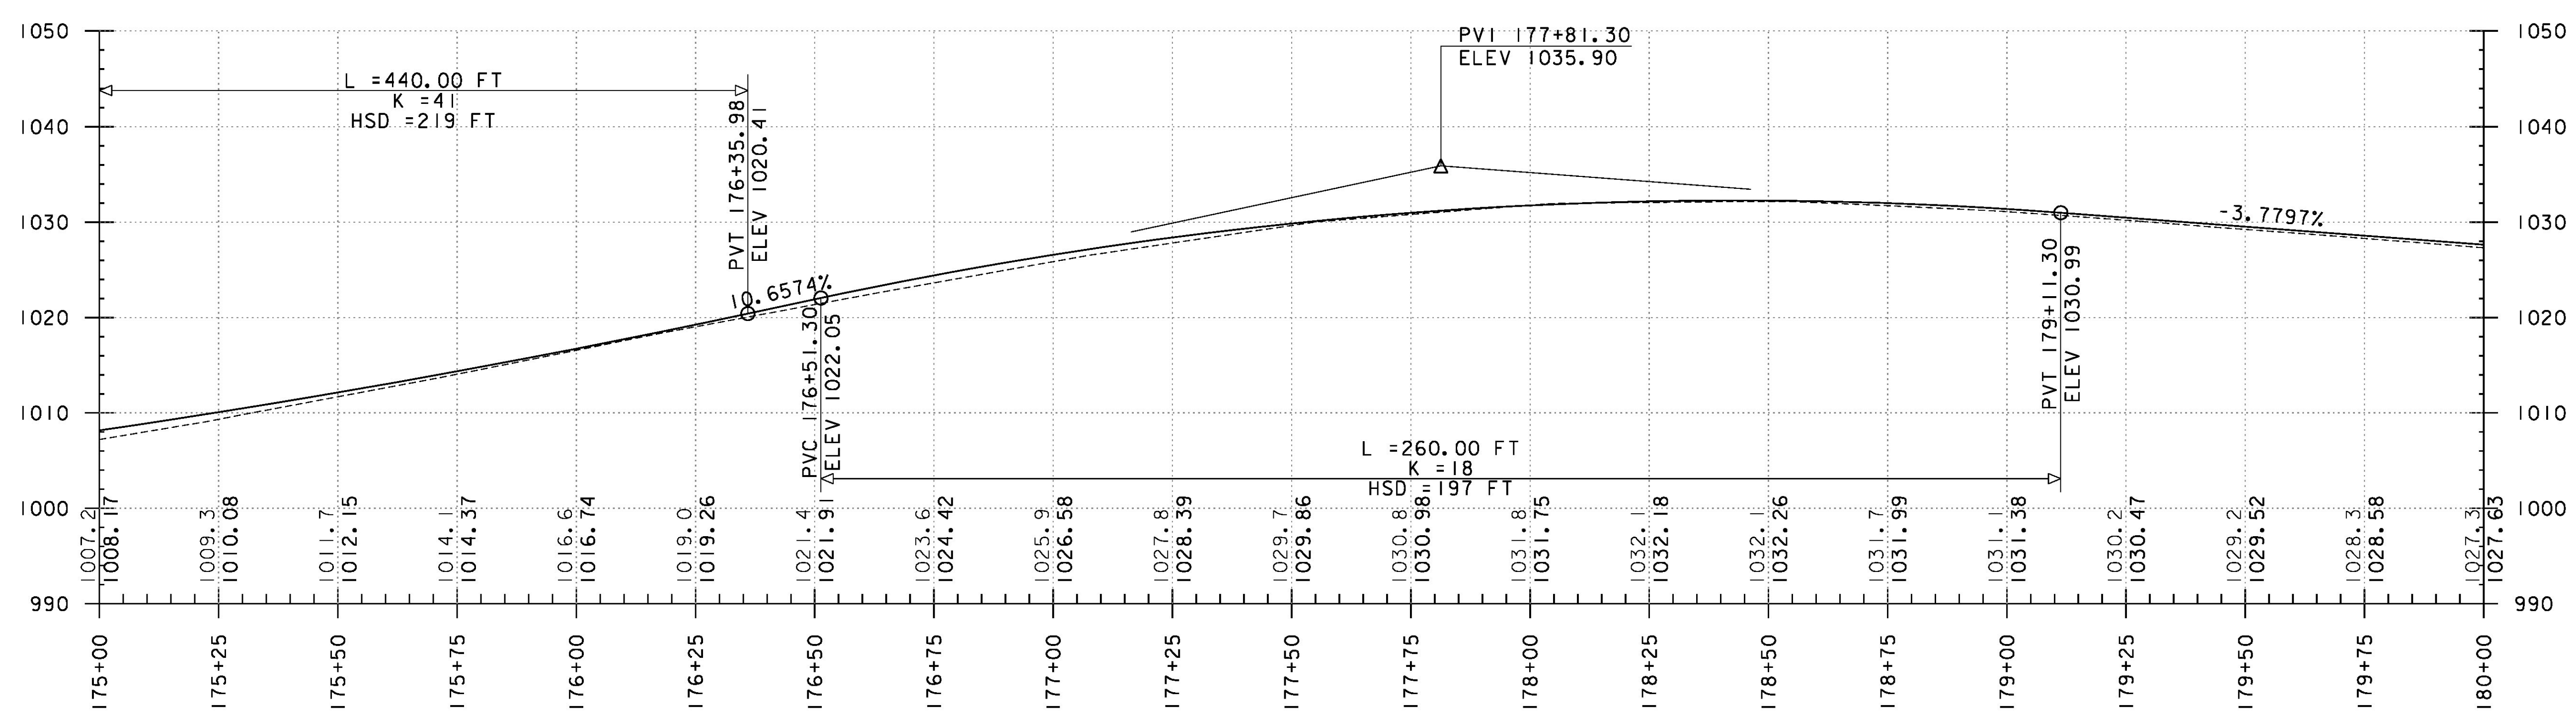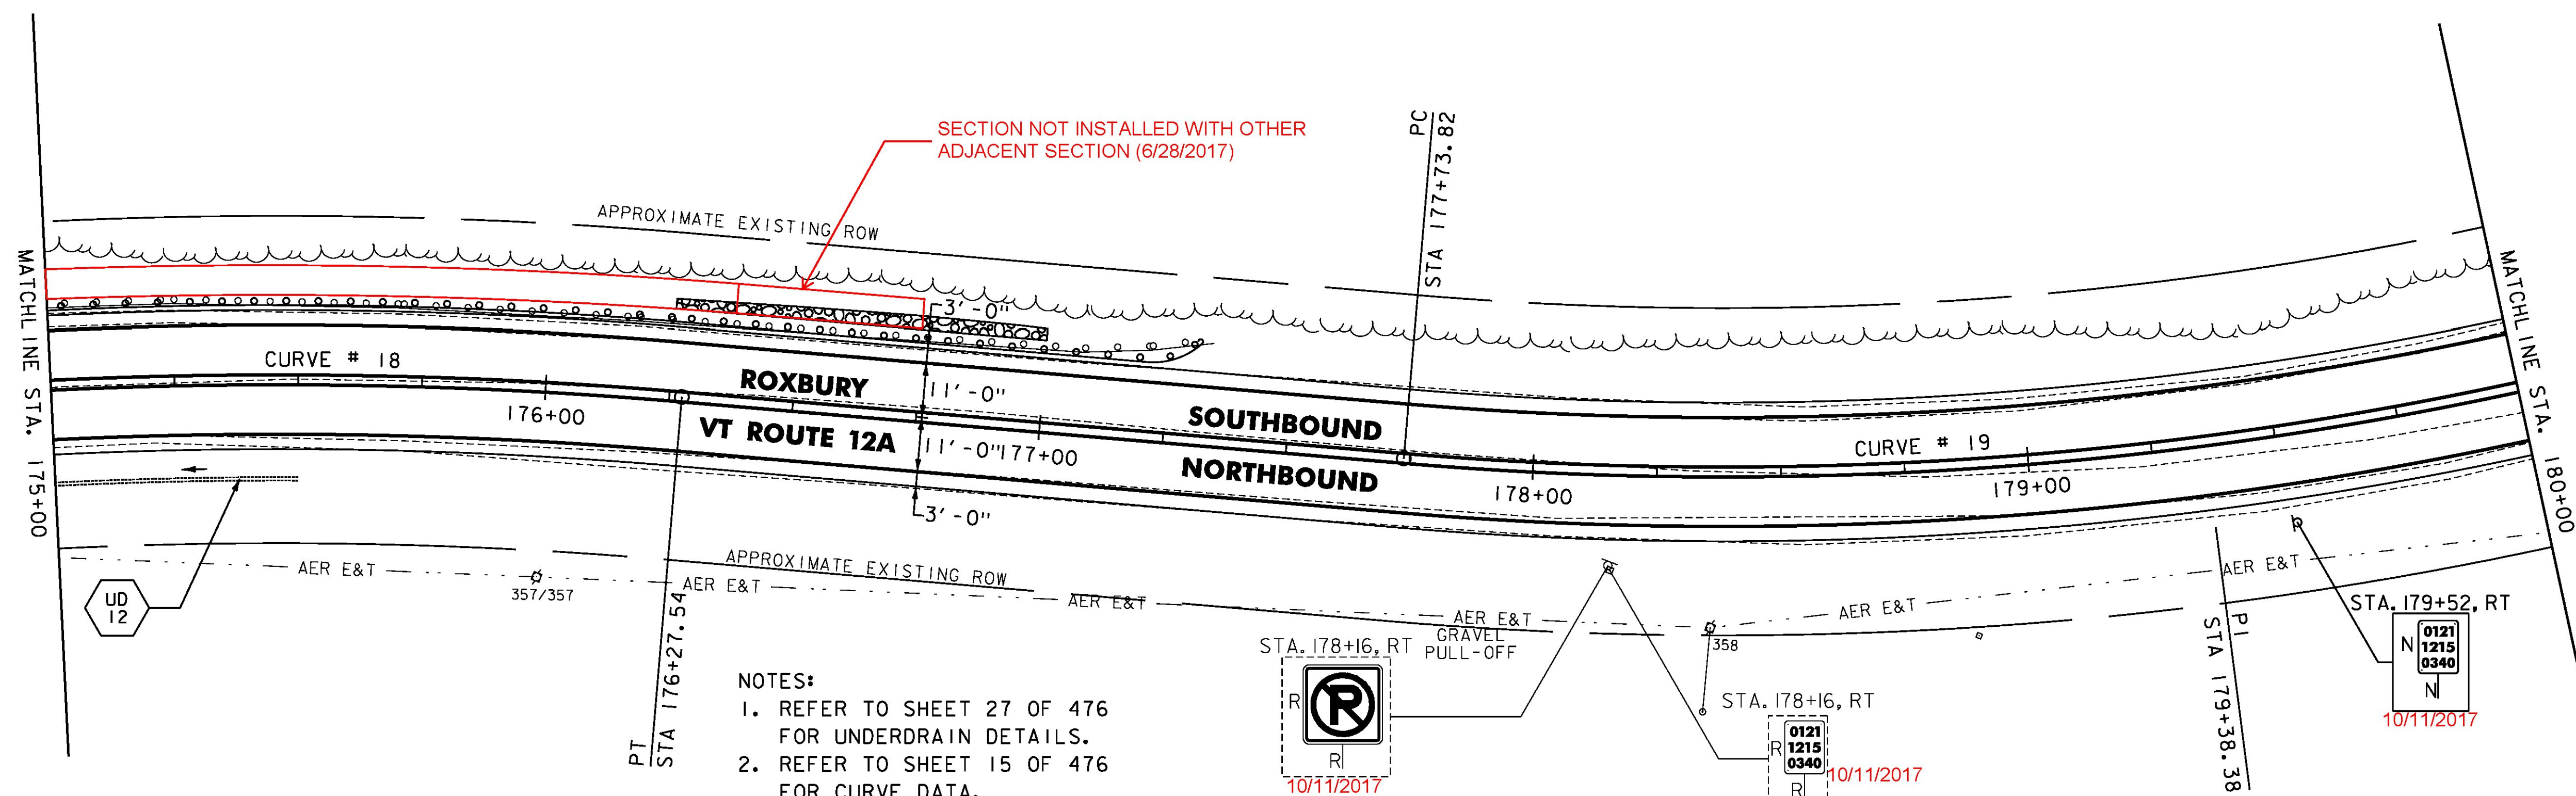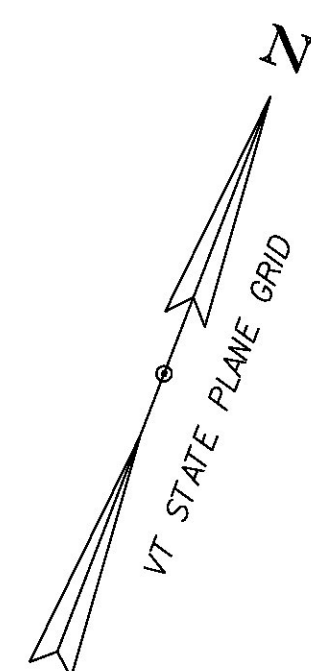

PROJECT NAME:	ROXBURY - NORTHFIELD
PROJECT NUMBER:	ER STP 0187(13)
FILE NAME:	z13cl84bdr.dgn
PROJECT LEADER:	M. FOISY
DESIGNED BY:	G. BURGMEIER
PLANNING & PROFILE SHEET 29	
PLOT DATE:	5/25/2016
DRAWN BY:	G. BARRETT
CHECKED BY:	G. EDWARDS
SHEET	79 OF 476

