

STONE FILL TYPE I & GRUBBING MATERIAL (6")
 STA. 186+25 TO 187+25, LT
 STA. 188+25 TO 189+00, LT

REMOVING SIGNS
 AS SHOWN - 1

DURABLE 4 INCH WHITE LINE (OPTION BID ITEM)
 TEMPORARY 4 INCH WHITE LINE, PAINT
 (ALL LINES SHALL INCLUDE EDGE LINE BREAKS AND RADII FOR SIDE ROADS)
 STA. 185+00 TO 190+00, SOLID LT & RT

DURABLE 4 INCH YELLOW LINE (OPTION BID ITEM)
 TEMPORARY 4 INCH YELLOW LINE, PAINT
 (ALL LINES SHALL INCLUDE CENTER LINE BREAKS FOR SIDE ROADS)
 STA. 185+00 TO 190+00, SOLID LT & RT

STEEL BEAM GUARDRAIL, GALVANIZED
 STA. 189+42.7 TO 189+67.7, LT
 STA. 185+00.0 TO 187+12.5, RT
 185+89.0

STEEL BEAM GUARDRAIL, GALVANIZED
 W/8 FEET POSTS
 STA. 185+00.0 TO 189+42.7, LT
 STA. 185+89 TO 190+29, RT
 STA. 189+68 TO 189+80, LT

ANCHOR FOR STEEL BEAM RAIL
 STA. 187+12.5, RT
 STA. 189+67.7, LT
 80.0



REMOVAL AND DISPOSAL OF GUARDRAIL
 STA. 185+00 TO 190+00, RT
 STA. 185+00 TO 189+72, LT

CLEANING CULV. PIPE, IN-PLACE
 (GREATER THAN 24IN.)
 CULVERT #21, 99LF

CLEANING CULV. PIPE, IN-PLACE
 (0 TO 24IN., INCL.)
 CULVERT #22, 71LF
 CULVERT #23, 77LF

NOTES:

1. REFER TO SHEET 30 OF 476 FOR CULVERT INFORMATION.
2. REFER TO SHEET 27 OF 476 FOR UNDERDRAIN DETAILS.
3. REFER TO SHEET 15 OF 476 FOR CURVE DATA.

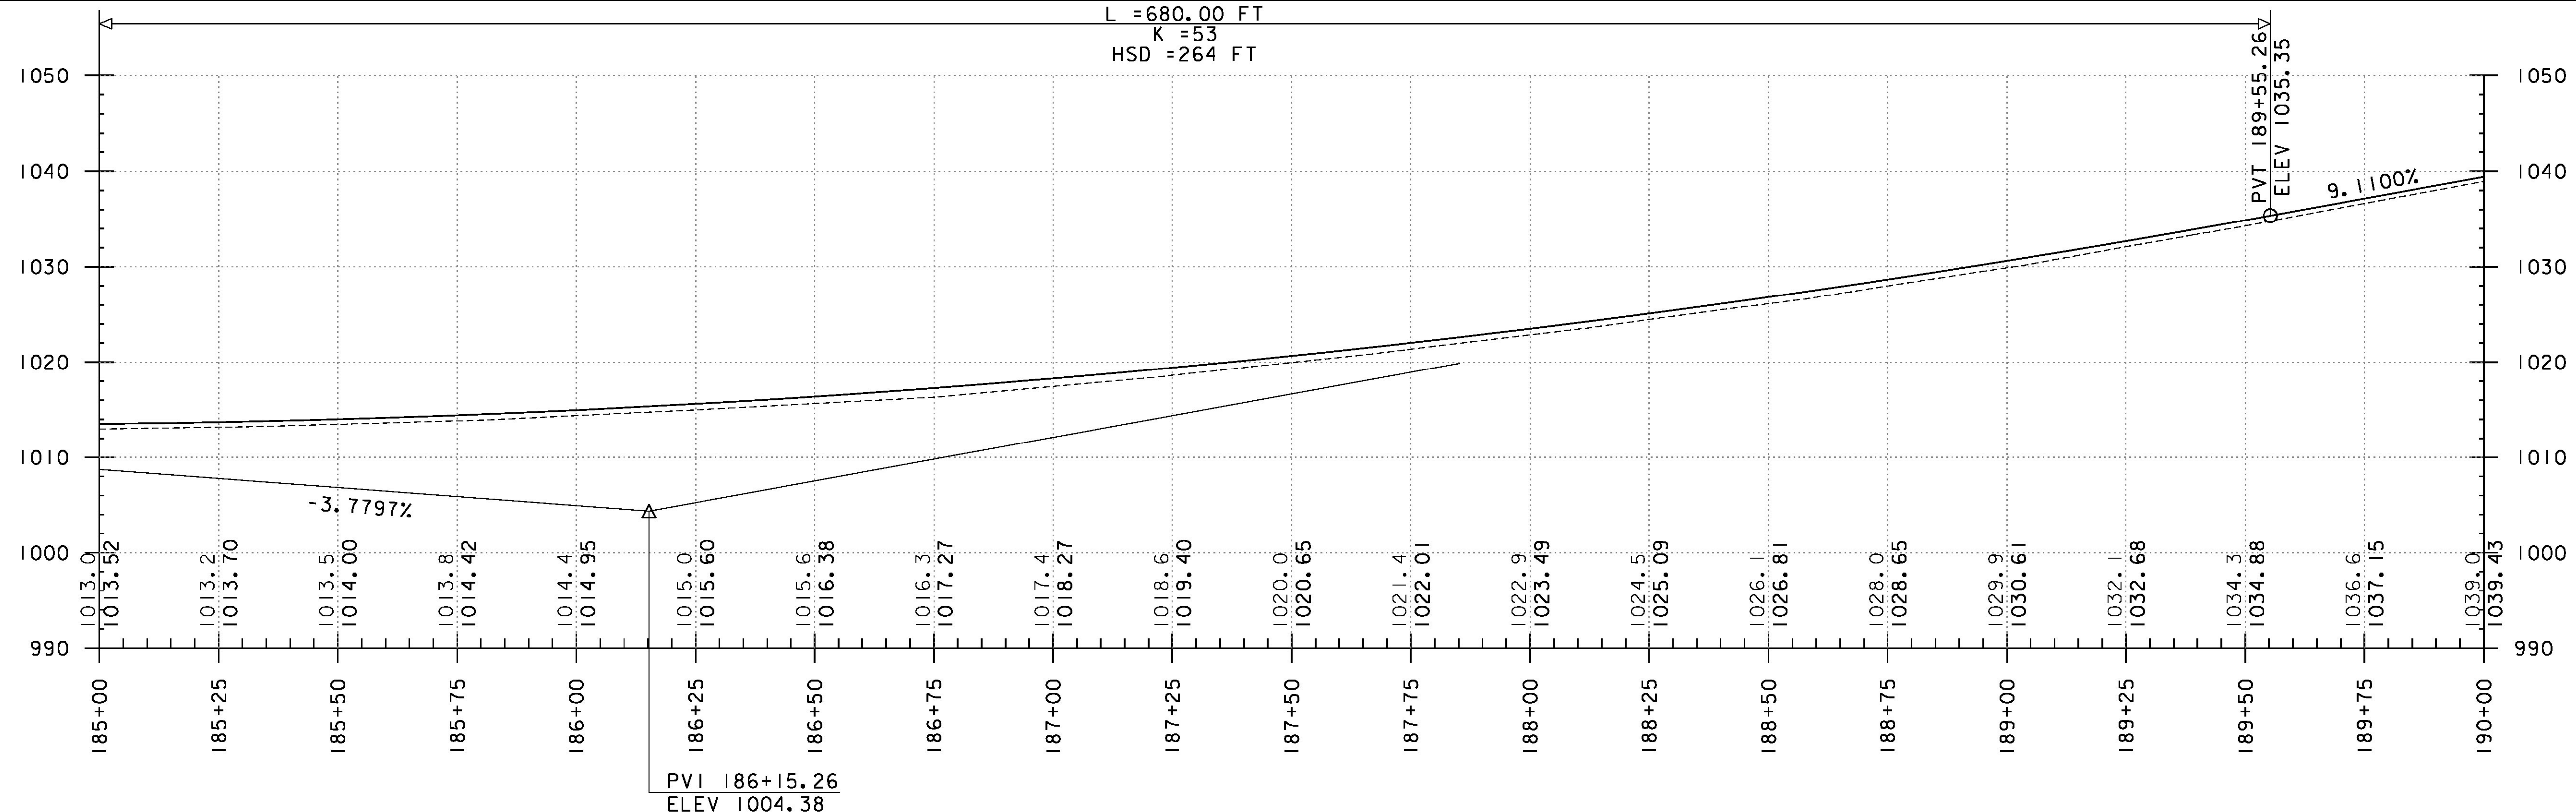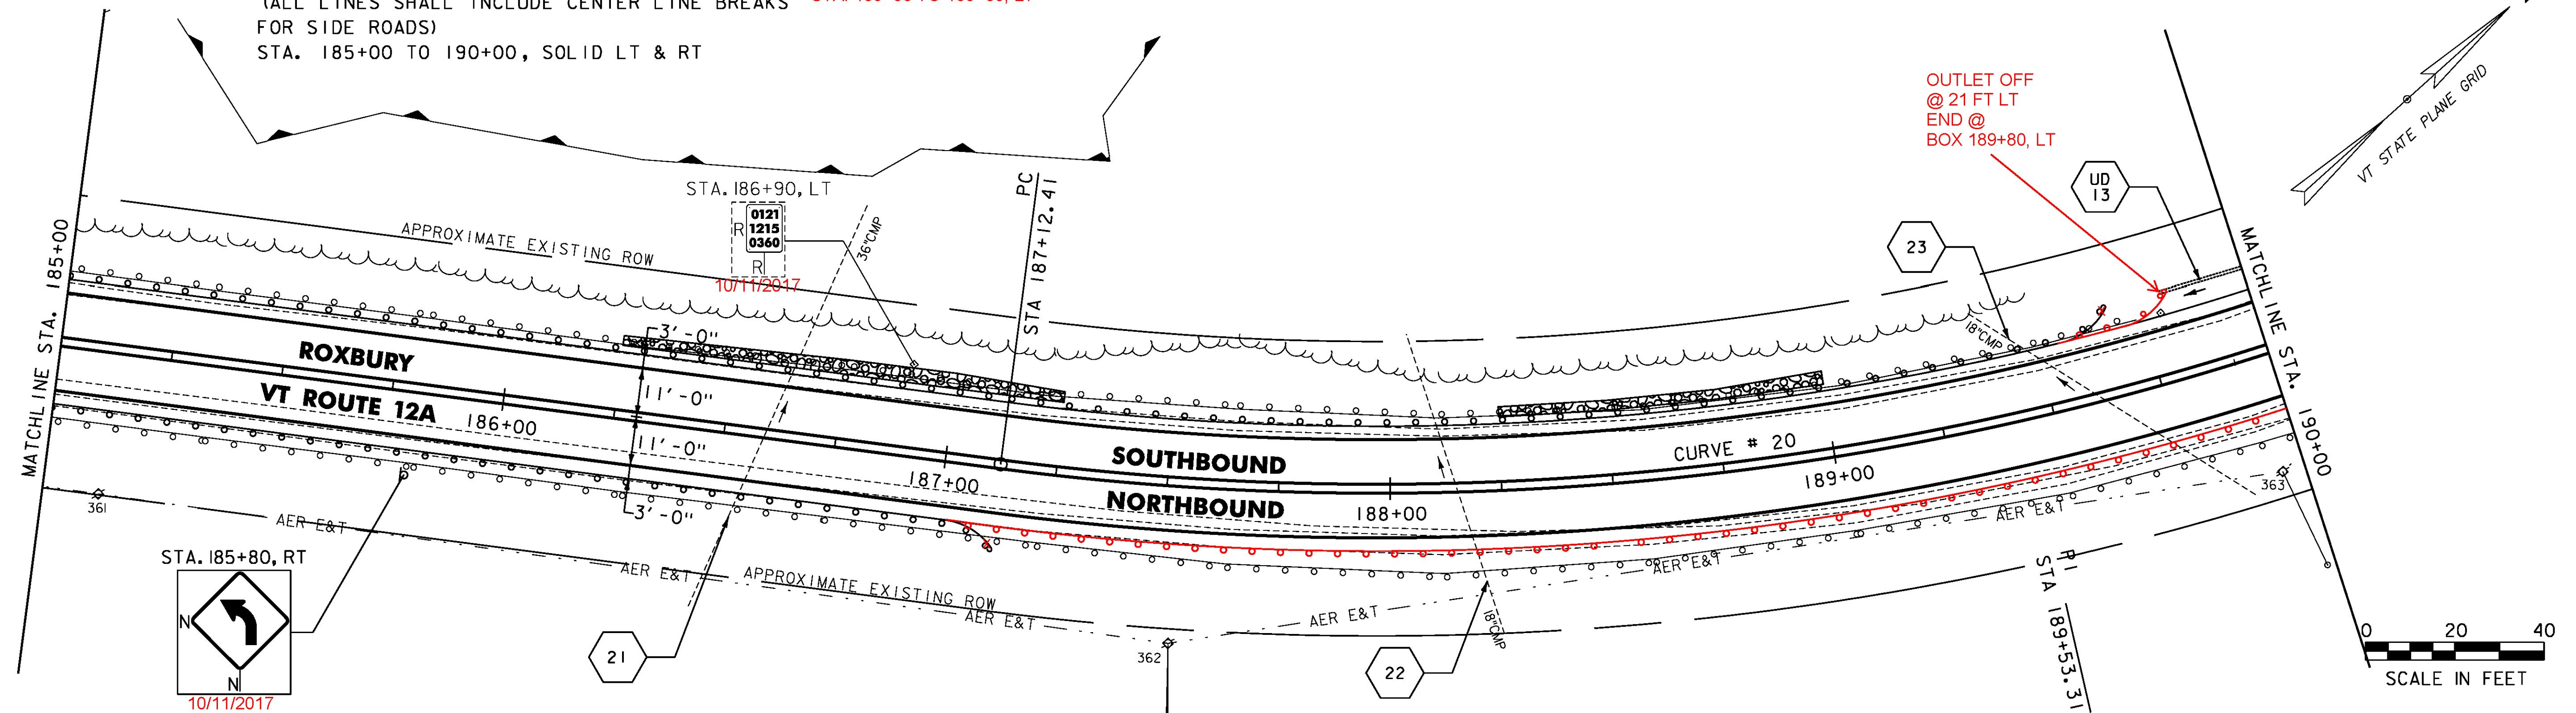

PROJECT NAME:	ROXBURY - NORTHFIELD
PROJECT NUMBER:	ER STP 0187(13)
FILE NAME:	z13cl84bdr.dgn
PROJECT LEADER:	M. FOISY
DESIGNED BY:	G. BURGMEIER
PLANNED & PROFILE SHEET 31	
PLOT DATE:	5/25/2016
DRAWN BY:	G. BARRETT
CHECKED BY:	G. EDWARDS
SHEET	81 OF 476

