



STONE FILL TYPE I & GRUBBING MATERIAL (6")
 STA. 214+70 TO 215+00, RT

DURABLE 4 INCH WHITE LINE (OPTION BID ITEM)
 TEMPORARY 4 INCH WHITE LINE, PAINT
 (ALL LINES SHALL INCLUDE EDGE LINE BREAKS AND RADII FOR SIDE ROADS)
 STA. 210+00 TO 215+00, SOLID LT & RT




DURABLE 4 INCH YELLOW LINE (OPTION BID ITEM)
 TEMPORARY 4 INCH YELLOW LINE, PAINT
 (ALL LINES SHALL INCLUDE CENTER LINE BREAKS FOR SIDE ROADS)
 STA. 210+00 TO 215+00, SOLID LT & RT

BARRIER FENCE
 STA. 211+60 TO 215+00, RT

EROSION LOG
 STA. 212+40 TO 214+60, RT

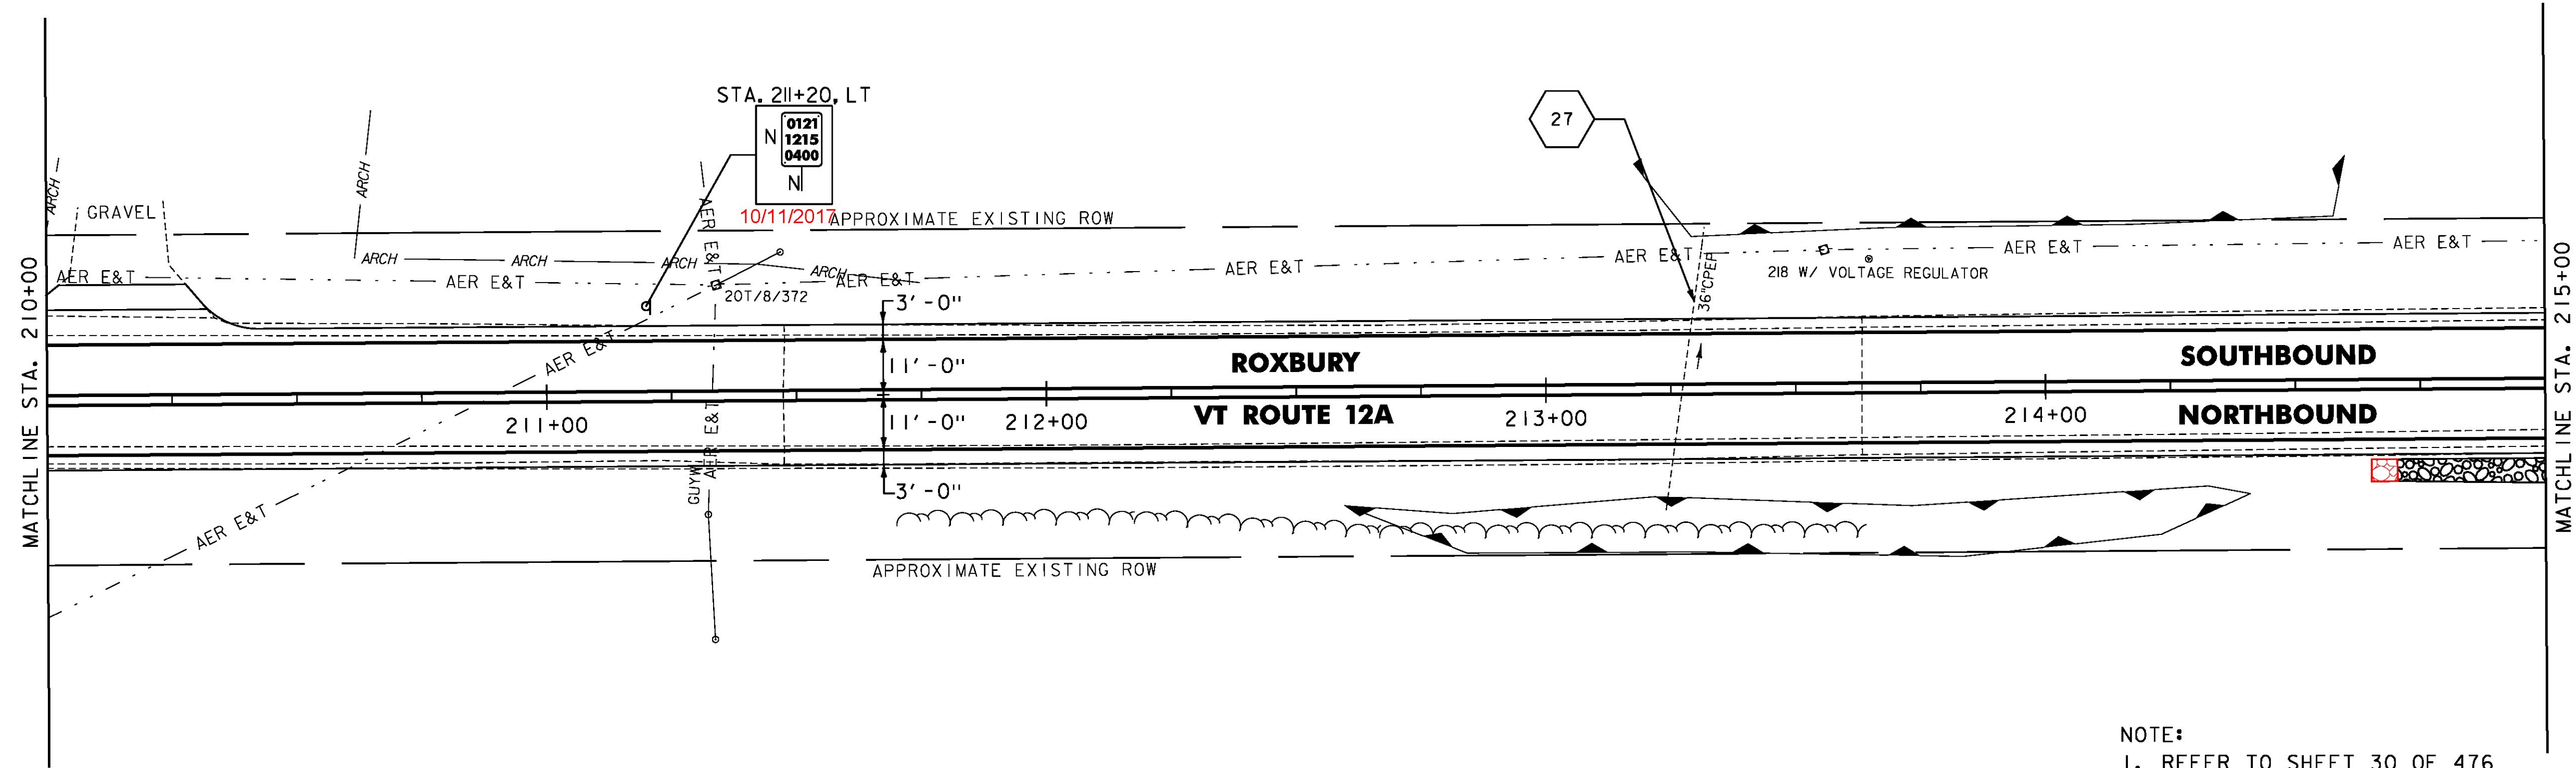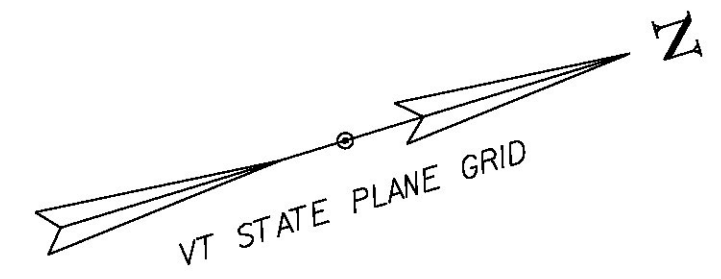

NOTE:
 1. REFER TO SHEET 30 OF 476 FOR CULVERT INFORMATION.

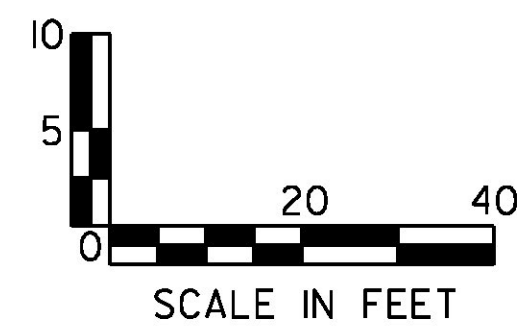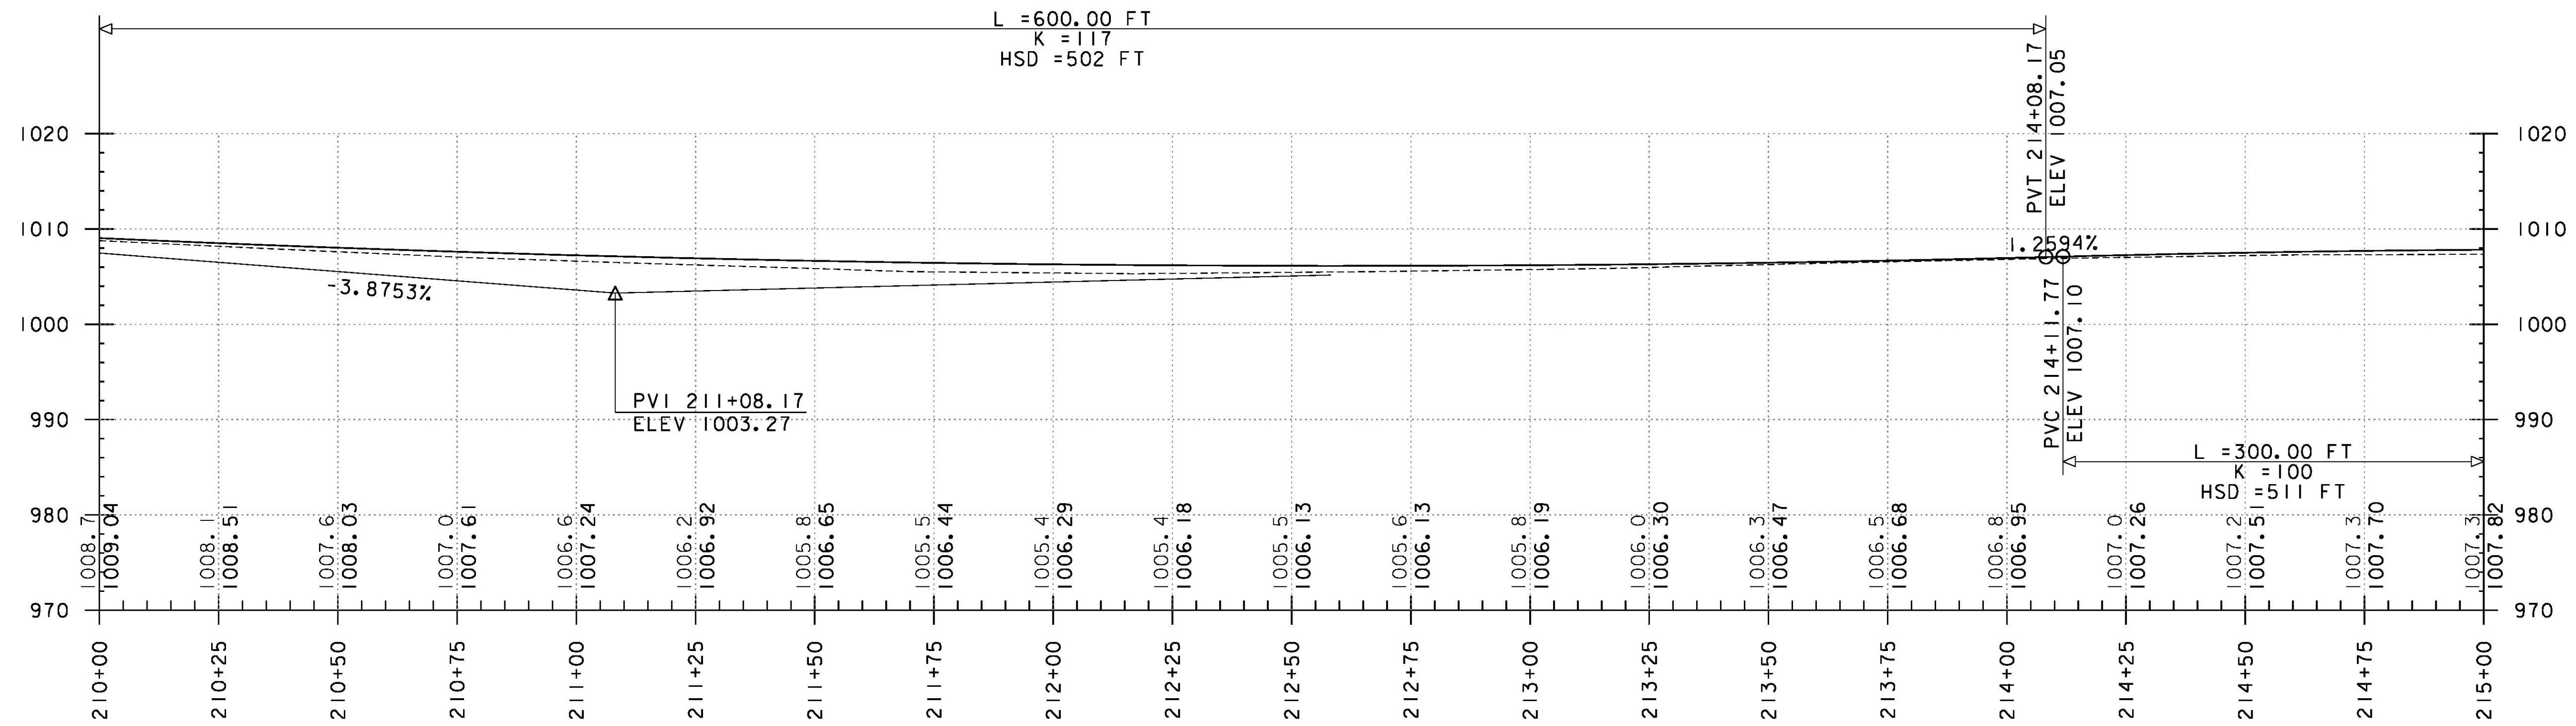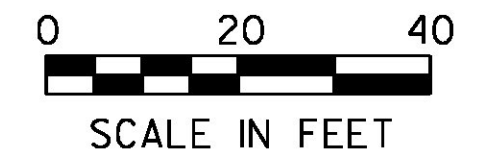

PROJECT NAME:	ROXBURY - NORTHFIELD
PROJECT NUMBER:	ER STP 0187(13)
FILE NAME:	z13cl84bdr.dgn
PROJECT LEADER:	M. FOISY
DESIGNED BY:	G. BURGMEIER
PLANNING & PROFILE SHEET 36	
PLOT DATE:	5/25/2016
DRAWN BY:	G. BARRETT
CHECKED BY:	G. EDWARDS
SHEET	86 OF 476