


DURABLE 4 INCH WHITE LINE (OPTION BID ITEM)
 TEMPORARY 4 INCH WHITE LINE, PAINT
 (ALL LINES SHALL INCLUDE EDGE LINE BREAKS
 AND RADII FOR SIDE ROADS)
 STA. 245+00 TO 250+00, SOLID LT & RT



DURABLE 4 INCH YELLOW LINE (OPTION BID ITEM)
 TEMPORARY 4 INCH YELLOW LINE, PAINT
 (ALL LINES SHALL INCLUDE CENTER LINE BREAKS
 FOR SIDE ROADS)
 STA. 245+00 TO 250+00, SOLID LT & RT
 STA. 248+40, DOUBLE SOLID LT (WARREN MOUNTAIN RD)

DURABLE 24 INCH STOP BAR (OPTION BID ITEM)
 TEMPORARY 24 INCH STOP BAR, PAINT
 STA. 248+40, LT (WARREN MOUNTAIN RD) (23 LF)
 REMOVING SIGNS
 AS SHOWN - 15

DURABLE LETTER OR SYMBOL (OPTION BID ITEM)
 TEMPORARY LETTER OR SYMBOL, PAINT
 STA. 248+40, LT "STOP" (WARREN MOUNTAIN RD)

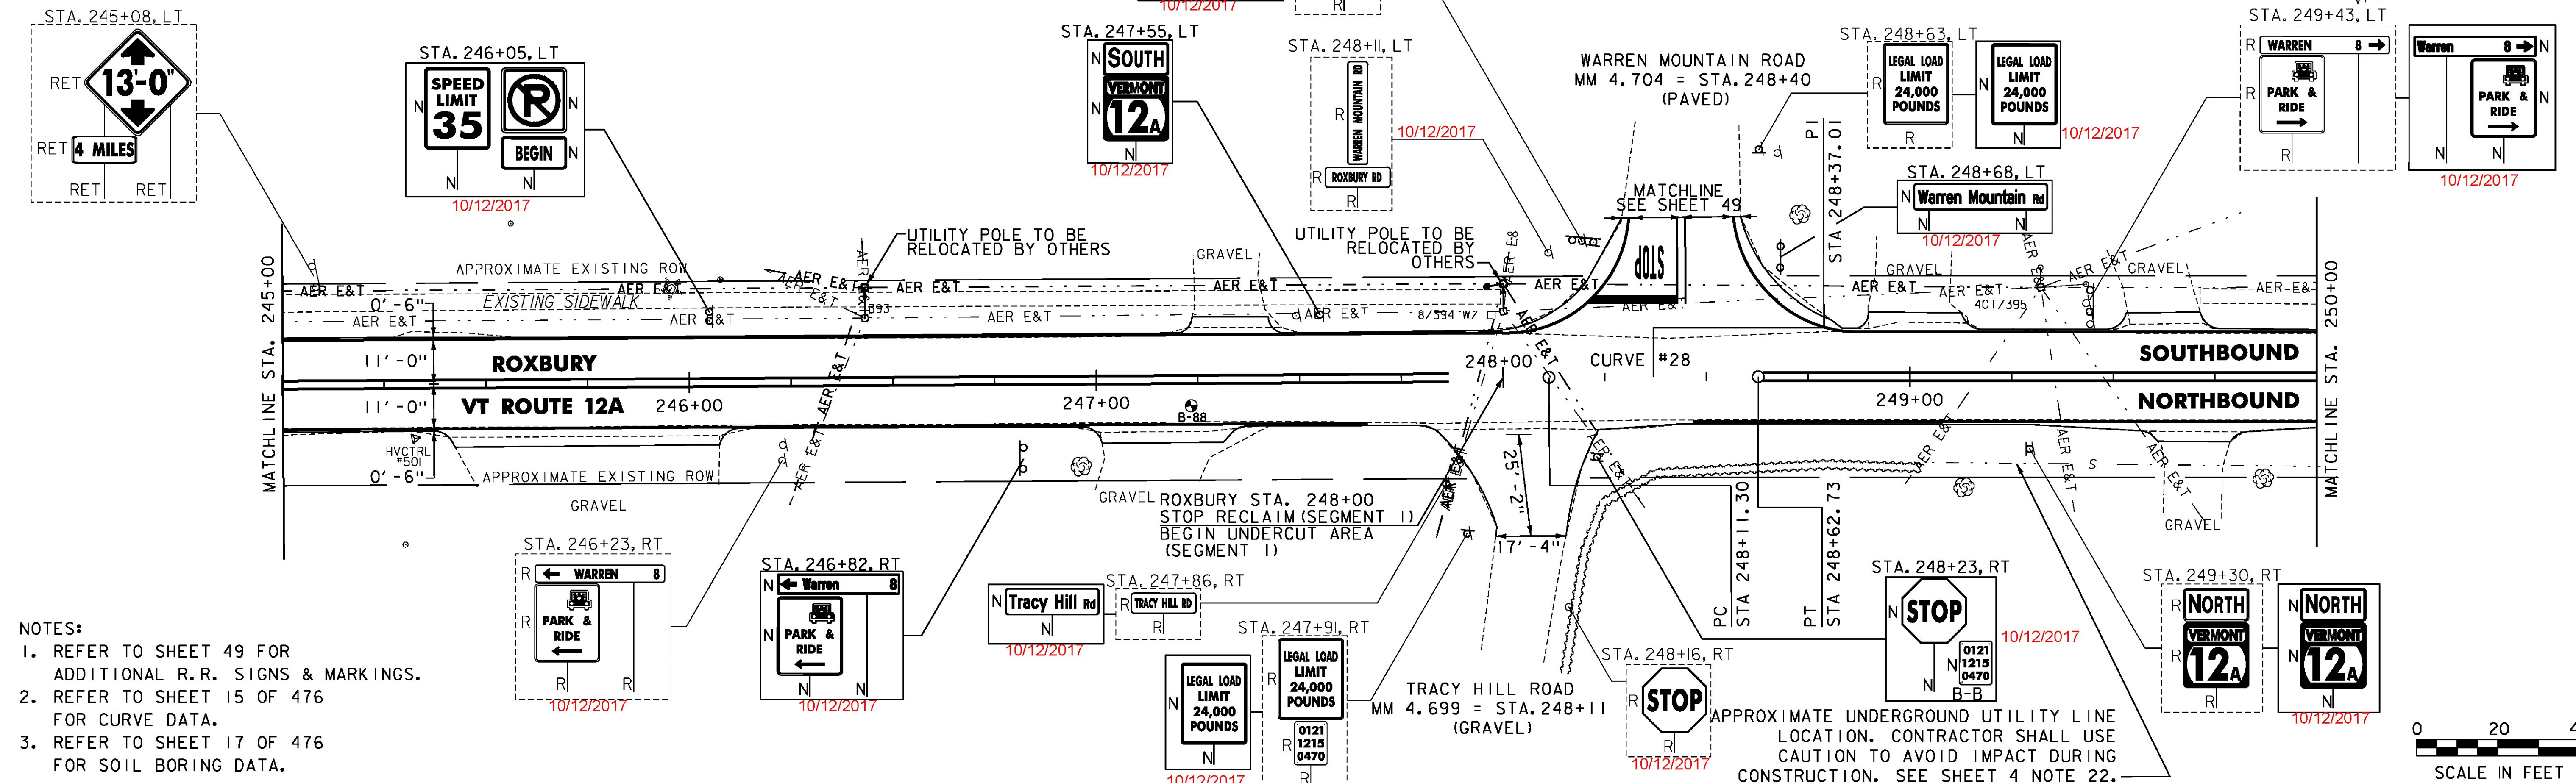

- NOTES:
1. REFER TO SHEET 49 FOR ADDITIONAL R.R. SIGNS & MARKINGS.
 2. REFER TO SHEET 15 OF 476 FOR CURVE DATA.
 3. REFER TO SHEET 17 OF 476 FOR SOIL BORING DATA.

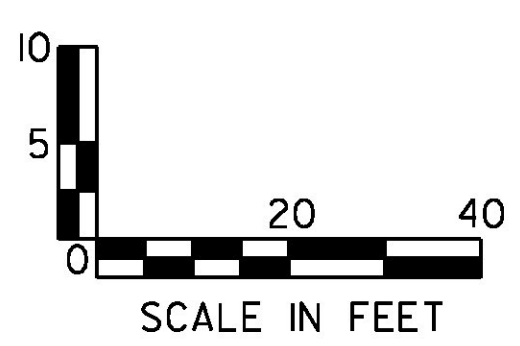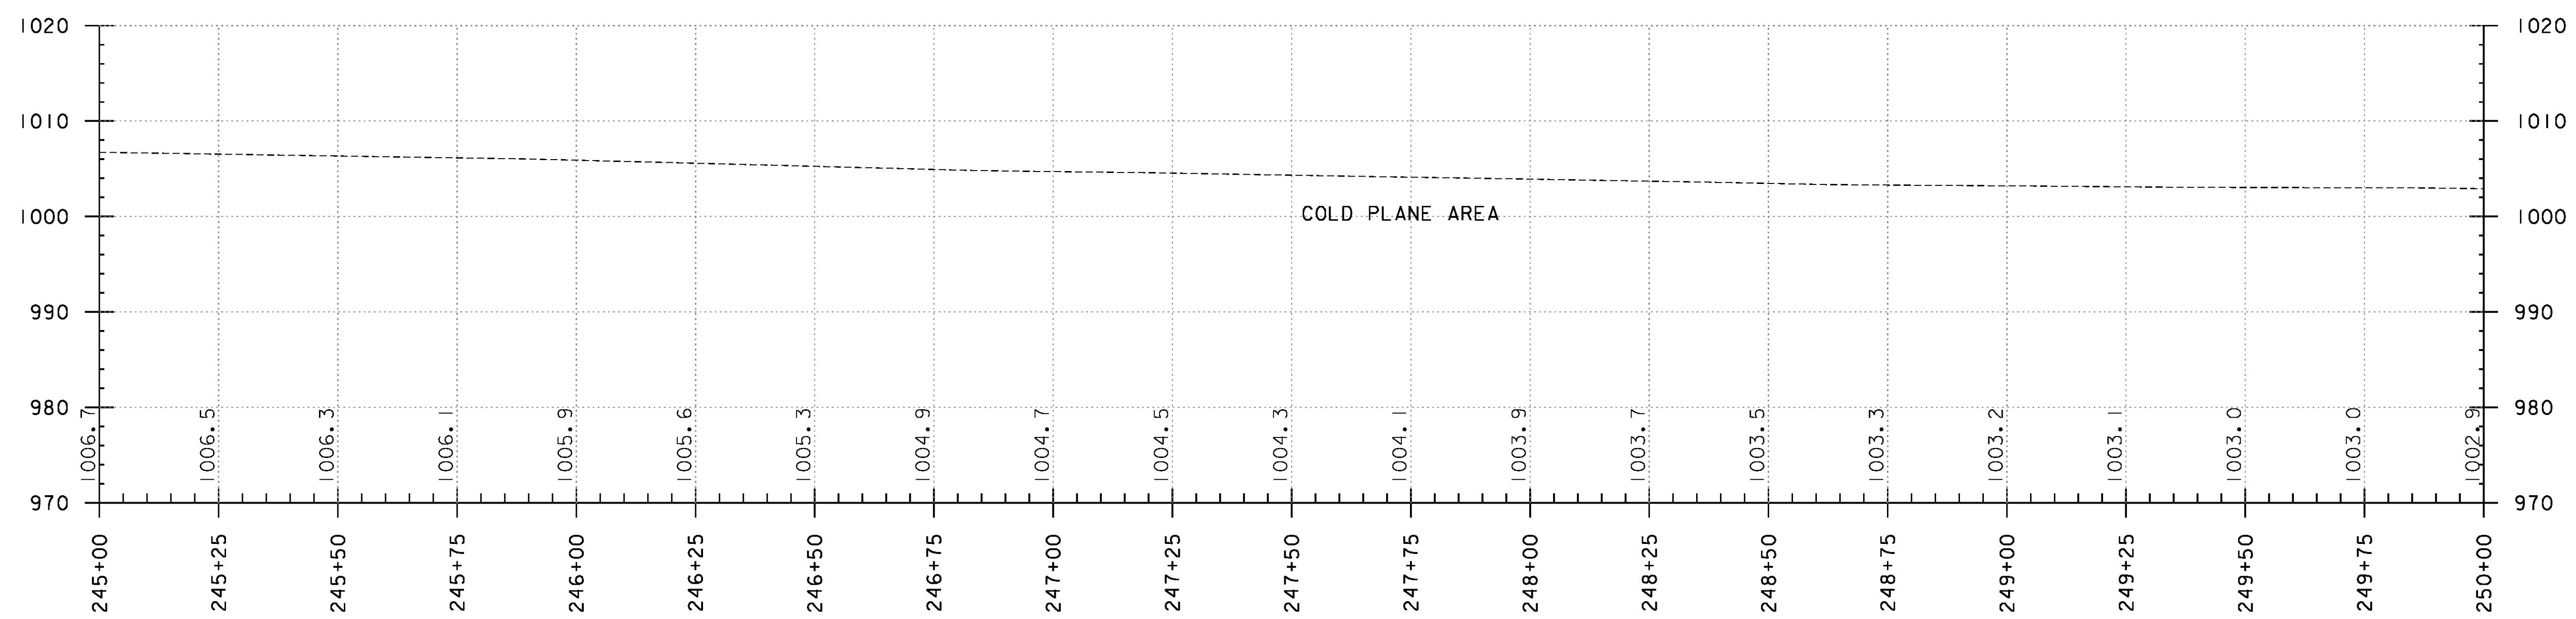

PROJECT NAME:	ROXBURY - NORTHFIELD
PROJECT NUMBER:	ER STP 0187(I3)
FILE NAME:	z13cl84bdr.dgn
PROJECT LEADER:	M. FOISY
DESIGNED BY:	G. BURGMEIER
PLAN & PROFILE SHEET 43	
PLOT DATE:	5/25/2016
DRAWN BY:	G. BARRETT
CHECKED BY:	G. EDWARDS
SHEET	93 OF 476

