



STONE FILL TYPE I & GRUBBING MATERIAL (6")
STA. 265+00 TO 266+40, LT

DURABLE 4 INCH WHITE LINE (OPTION BID ITEM)
TEMPORARY 4 INCH WHITE LINE, PAINT
(ALL LINES SHALL INCLUDE EDGE LINE BREAKS AND RADII FOR SIDE ROADS)
STA. 265+00 TO 270+00, SOLID LT & RT

DURABLE 4 INCH YELLOW LINE (OPTION BID ITEM)
TEMPORARY 4 INCH YELLOW LINE, PAINT
(ALL LINES SHALL INCLUDE CENTER LINE BREAKS FOR SIDE ROADS)
STA. 265+00 TO 270+00, SOLID LT & RT

REMOVING SIGNS
AS SHOWN - 3
MILLED RUMBLE STRIPS
STA. 266+43 TO 270+00, C

BARRIER FENCE
STA. 265+00 TO 267+50, LT
EROSION LOG
STA. 265+00 TO 266+70, LT

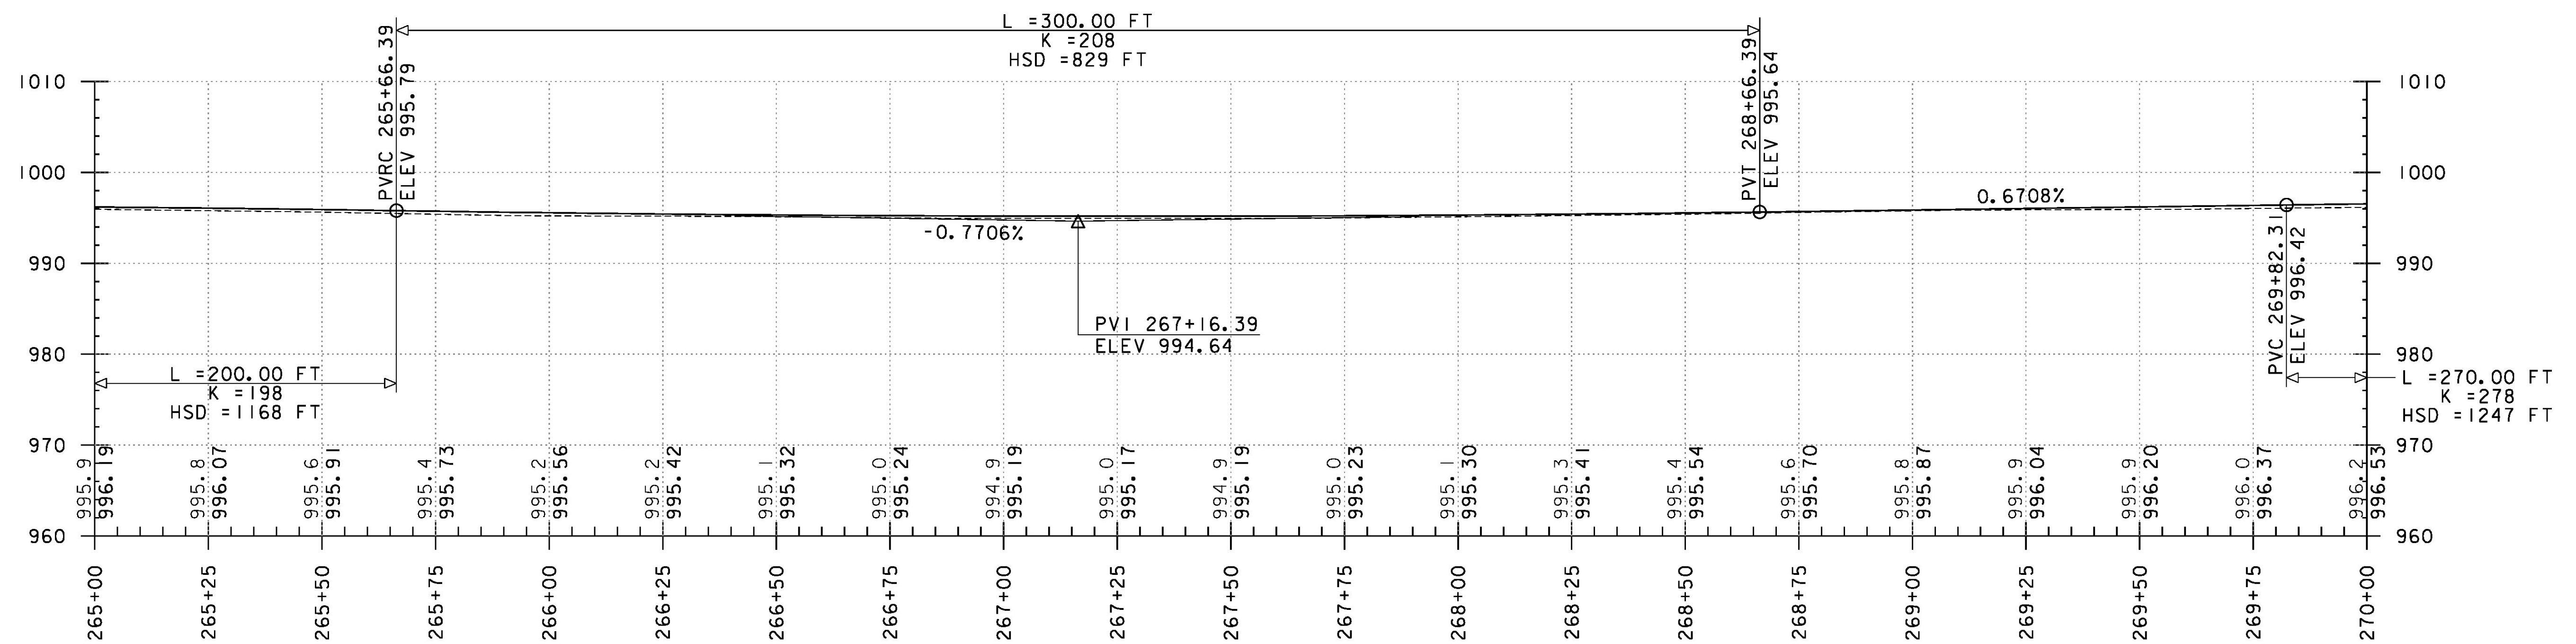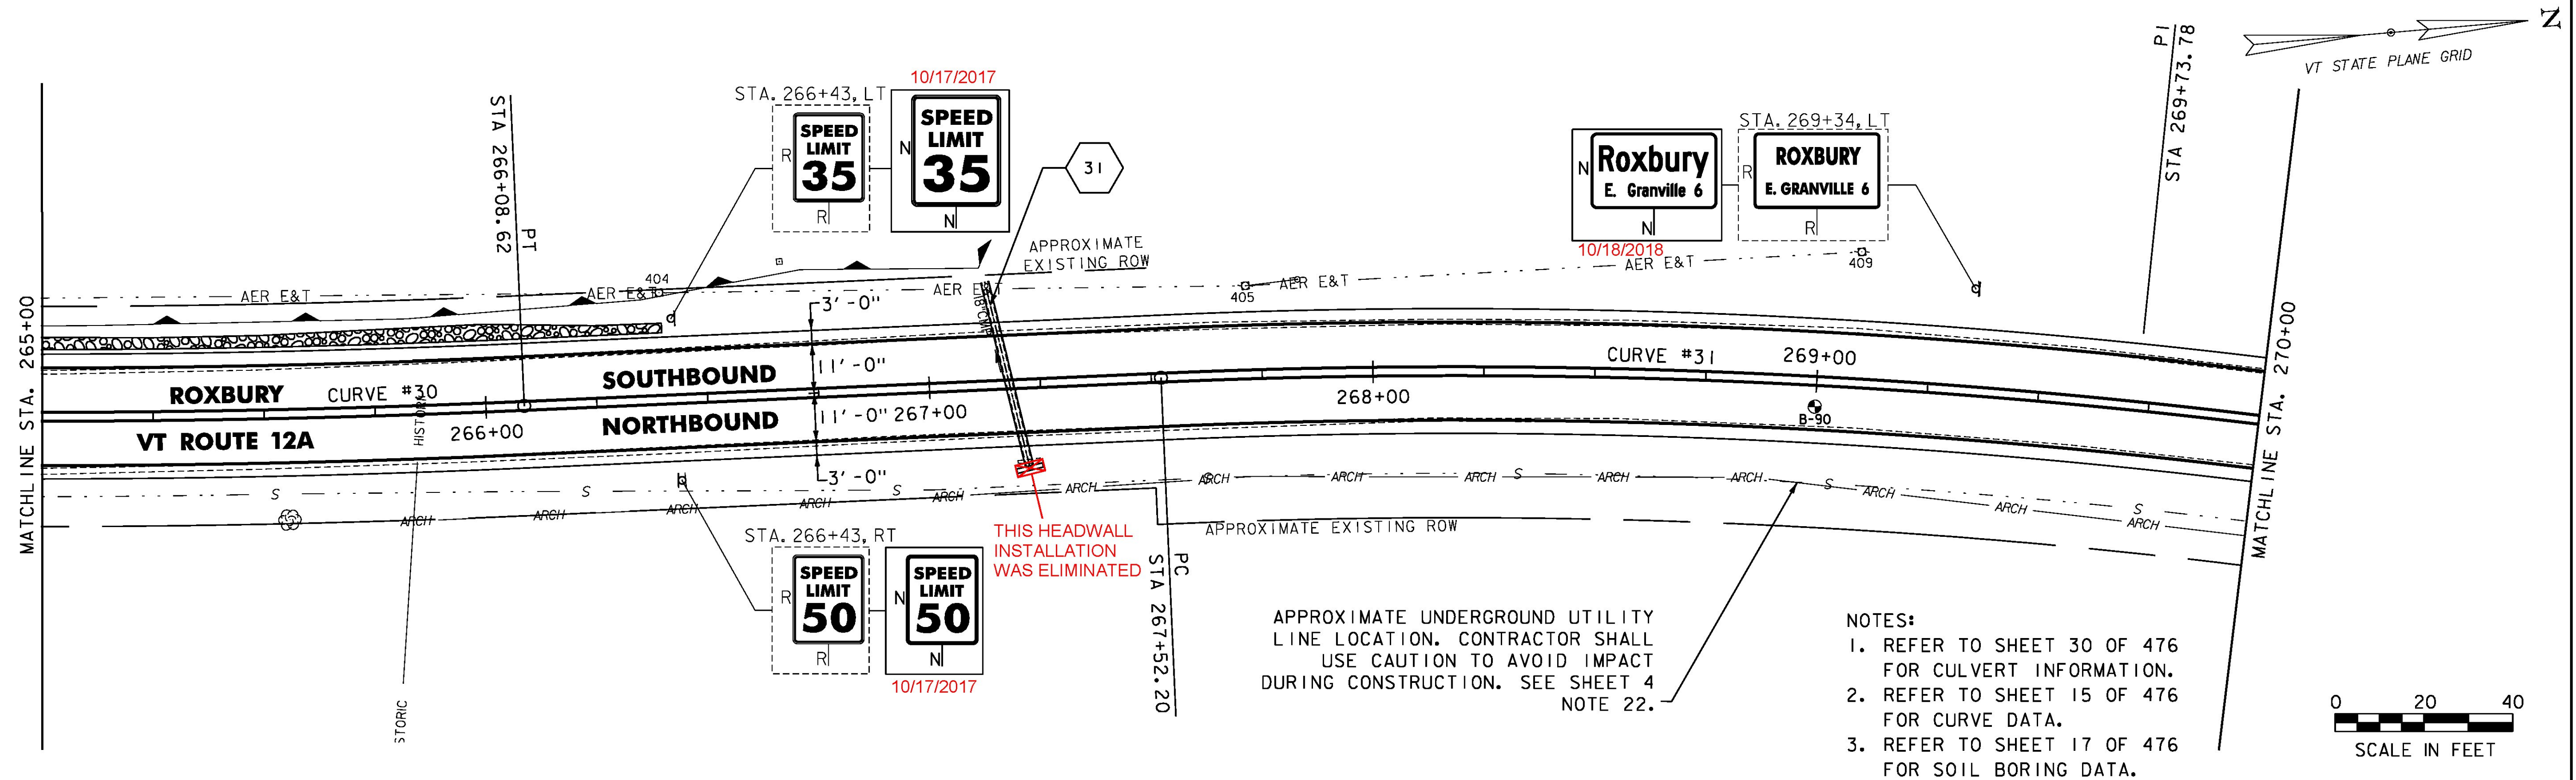

PROJECT NAME: ROXBURY - NORTHFIELD
PROJECT NUMBER: ER STP 0187(I3)
FILE NAME: z13cl84bdr.dgn
PROJECT LEADER: M. FOISY
DESIGNED BY: G. BURGMEIER
PLOT DATE: 5/25/2016
DRAWN BY: G. BARRETT
CHECKED BY: G. EDWARDS
PLAN & PROFILE SHEET 47
SHEET 97 OF 476

