


CLEANING CULV. PIPE, IN-PLACE
(0 TO 24IN., INCL.)
CULVERT #35, 45LF

RELOCATE MAILBOX, SINGLE SUPPORT
STA. 320+28, LT
STONE FILL TYPE I & GRUBBING
MATERIAL (6")
STA. 322+25 TO 323+00, LT



DURABLE 4 INCH WHITE LINE (OPTION BID ITEM)
TEMPORARY 4 INCH WHITE LINE, PAINT
(ALL LINES SHALL INCLUDE EDGE LINE BREAKS
AND RADII FOR SIDE ROADS)
STA. 320+00 TO 325+00, SOLID LT & RT

DURABLE 4 INCH YELLOW LINE (OPTION BID ITEM)
TEMPORARY 4 INCH YELLOW LINE, PAINT
(ALL LINES SHALL INCLUDE CENTER LINE BREAKS
FOR SIDE ROADS)
STA. 320+00 TO 325+00, SOLID LT & RT

MILLED RUMBLE STRIPS
STA. 321+50 TO 325+00, C

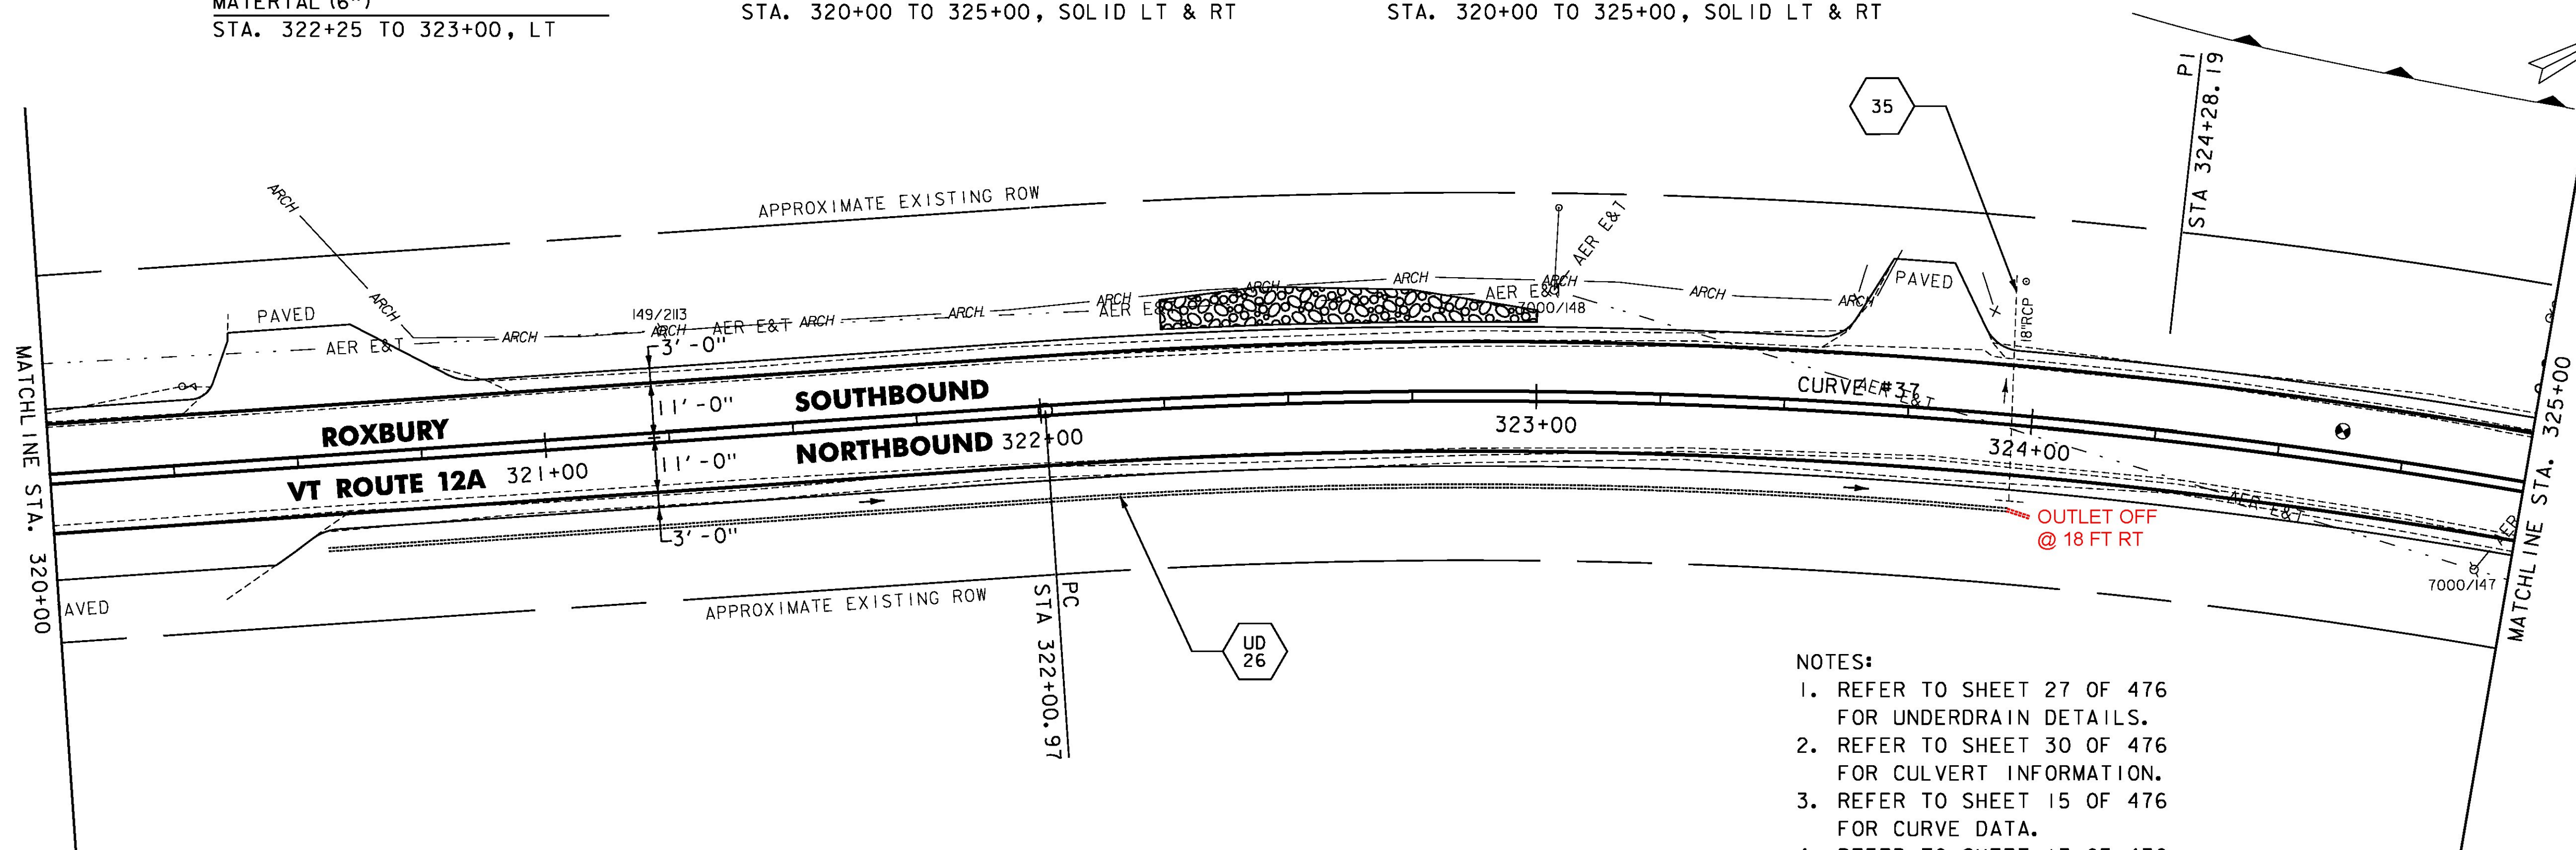

- NOTES:
1. REFER TO SHEET 27 OF 476 FOR UNDERDRAIN DETAILS.
 2. REFER TO SHEET 30 OF 476 FOR CULVERT INFORMATION.
 3. REFER TO SHEET 15 OF 476 FOR CURVE DATA.
 4. REFER TO SHEET 17 OF 476 FOR SOIL BORING DATA.

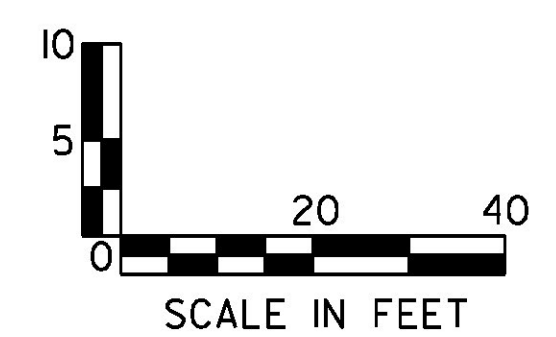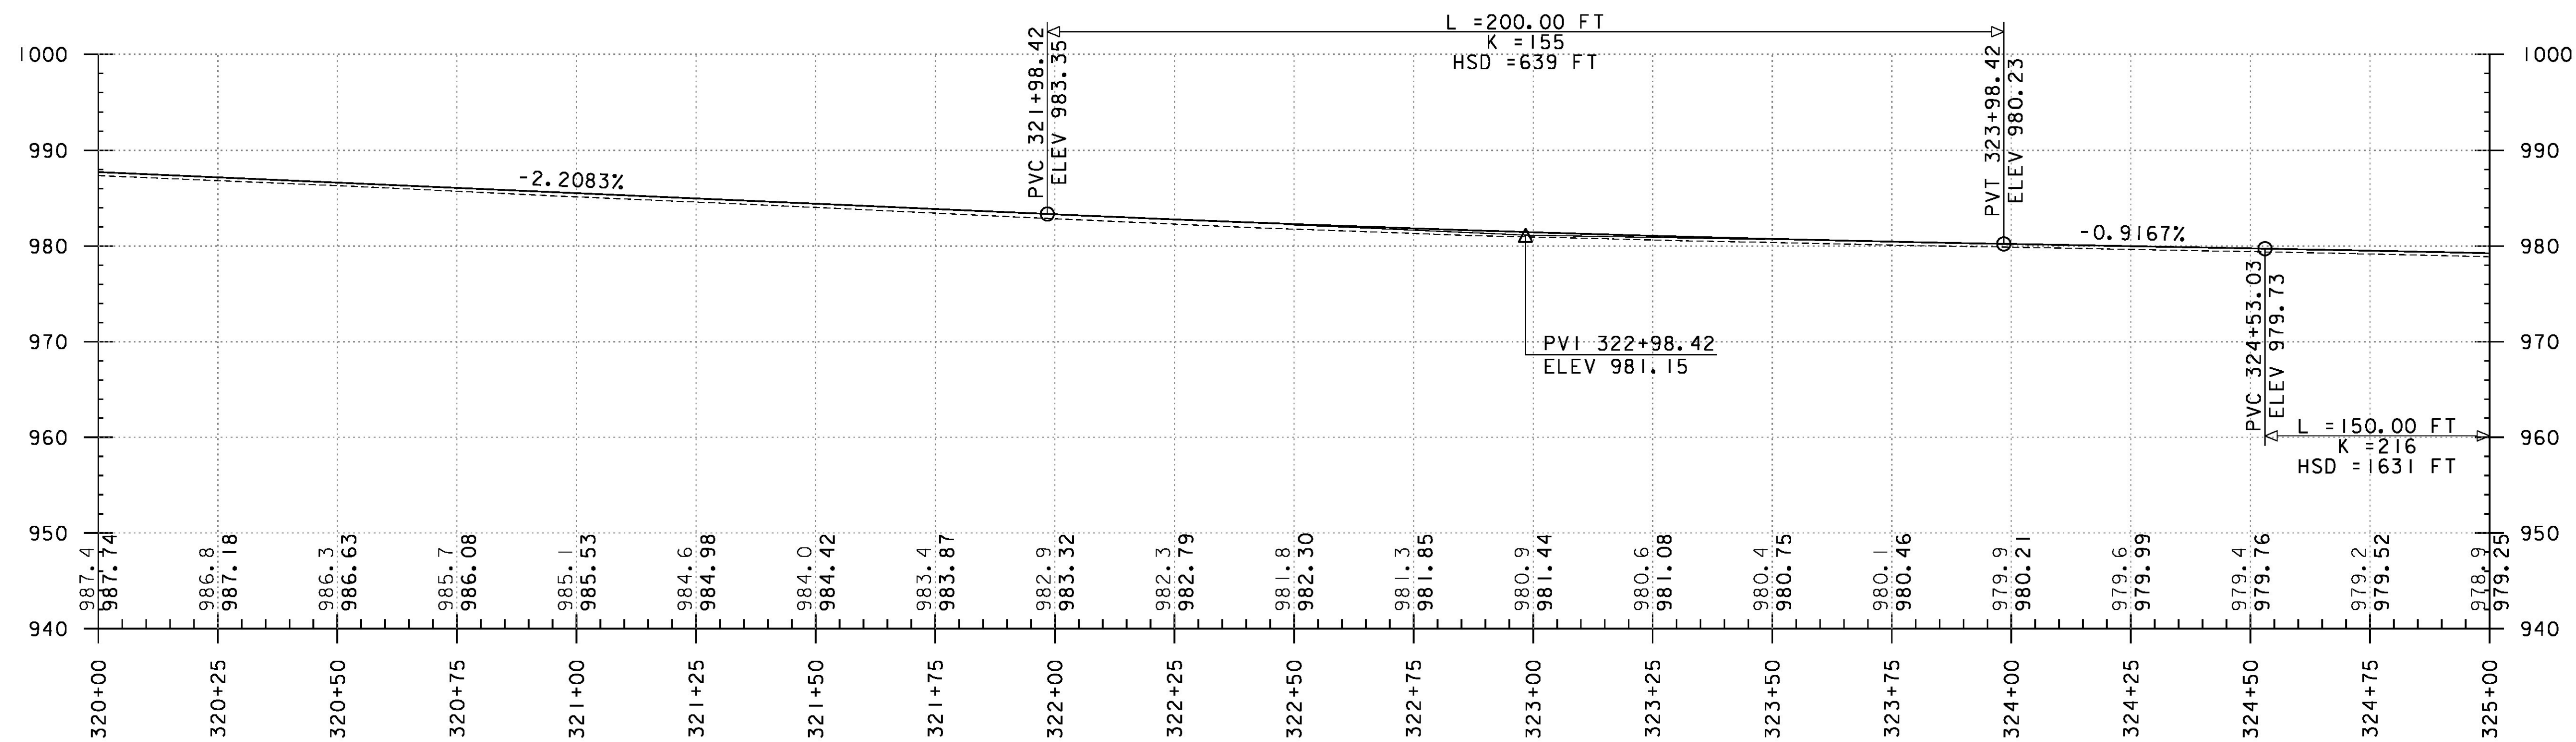

| | |
|------------------------------------|---------------------------|
| PROJECT NAME: ROXBURY - NORTHFIELD | PLOT DATE: 5/25/2016 |
| PROJECT NUMBER: ER STP 0187(13) | DRAWN BY: G. BARRETT |
| FILE NAME: z13ci84bdr.dgn | DESIGNED BY: G. BURGMEIER |
| PROJECT LEADER: M. FOISY | CHECKED BY: G. EDWARDS |
| PLAN & PROFILE SHEET 58 | SHEET 108 OF 476 |