
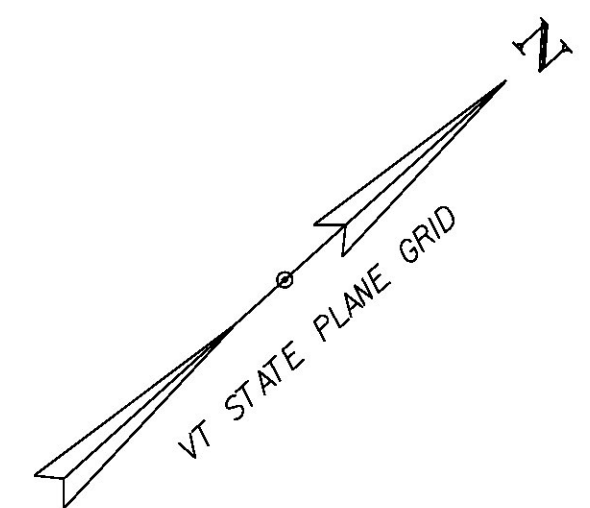
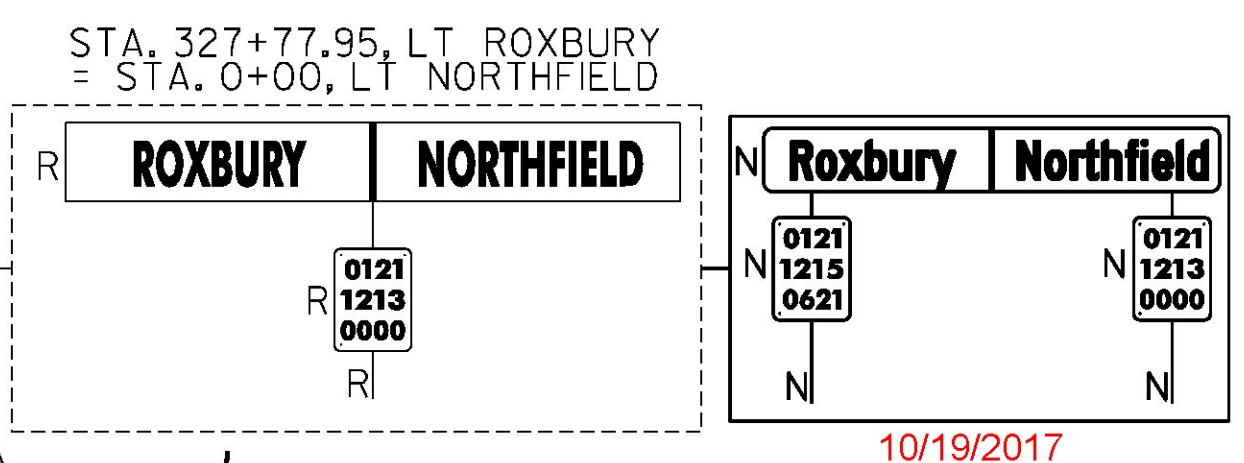


DURABLE 4 INCH WHITE LINE (OPTION BID ITEM)
 TEMPORARY 4 INCH WHITE LINE, PAINT
 (ALL LINES SHALL INCLUDE EDGE LINE BREAKS
 AND RADII FOR SIDE ROADS)
 STA. 325+00 TO 327+77.95, SOLID LT & RT




DURABLE 4 INCH YELLOW LINE (OPTION BID ITEM)
 TEMPORARY 4 INCH YELLOW LINE, PAINT
 (ALL LINES SHALL INCLUDE CENTER LINE BREAKS
 FOR SIDE ROADS)
 STA. 325+00 TO 327+77.95, SOLID LT & RT

REMOVING SIGNS
 AS SHOWN - 2

MILLED RUMBLE STRIPS
 STA. 325+00 TO 327+77.95, C

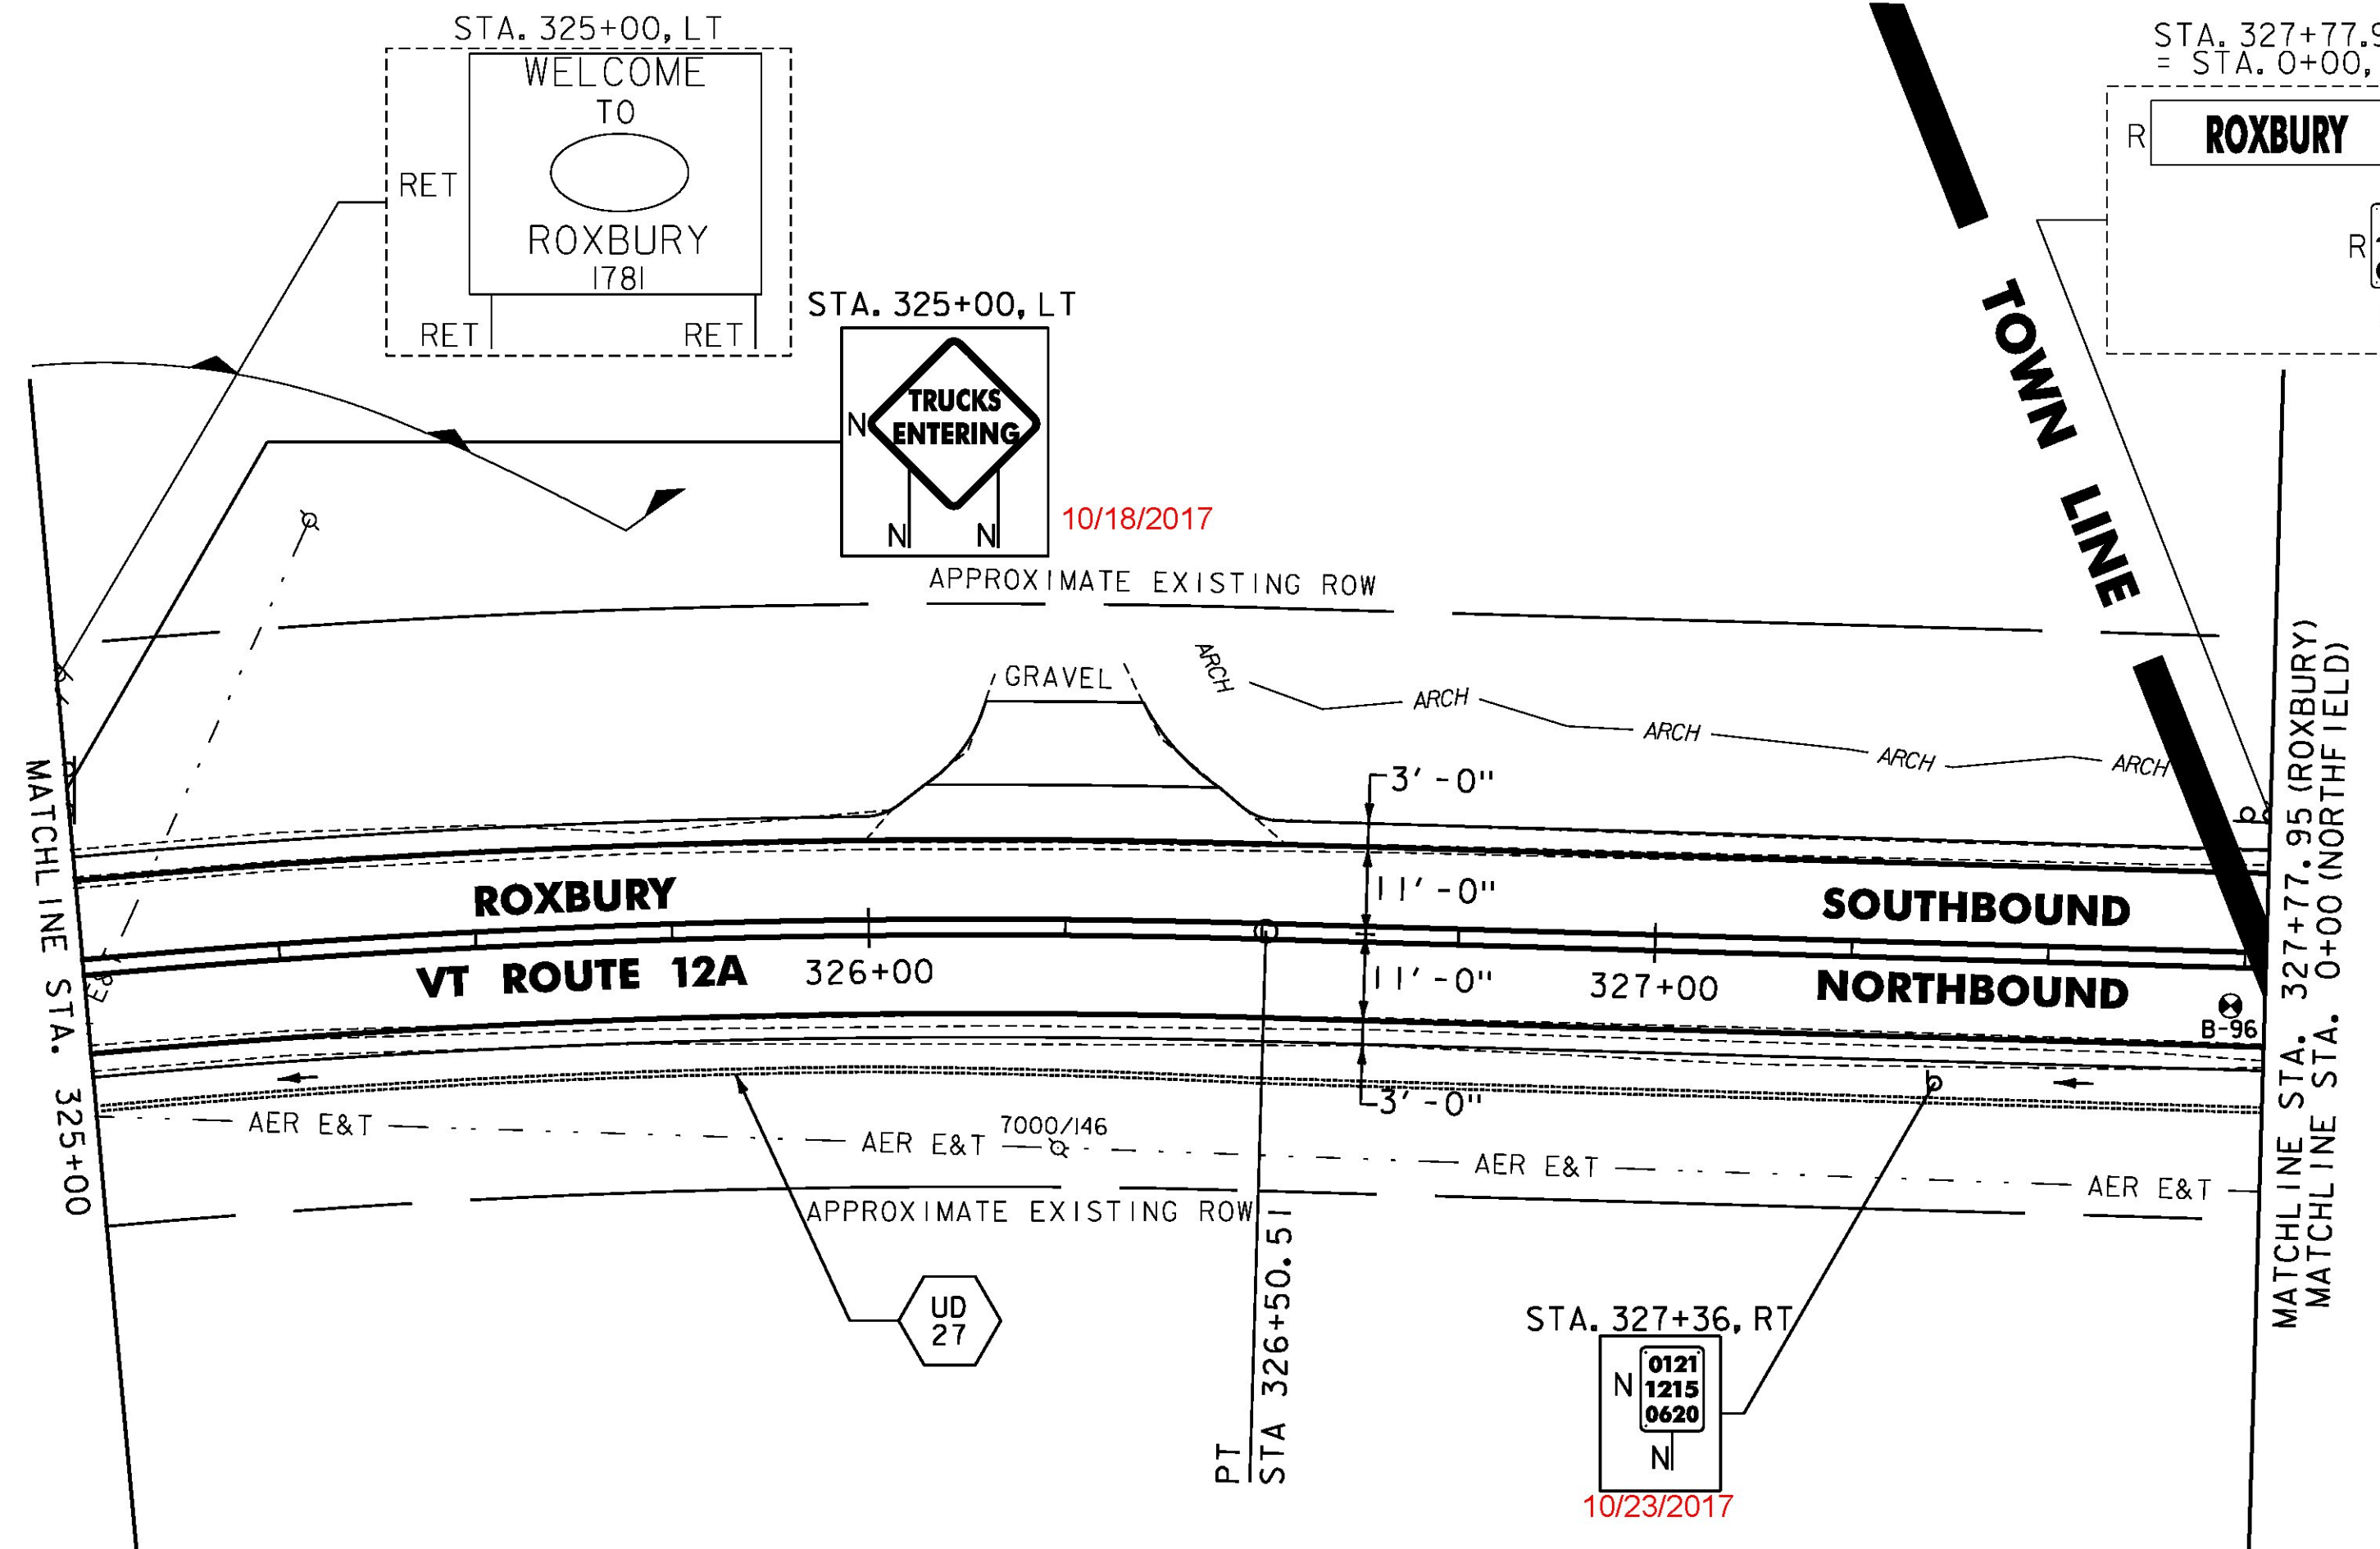

- NOTES:
1. REFER TO SHEET 27 OF 476 FOR UNDERDRAIN DETAILS.
 2. REFER TO SHEET 15 OF 476 FOR CURVE DATA.
 3. REFER TO SHEET 17 OF 476 FOR SOIL BORING DATA.

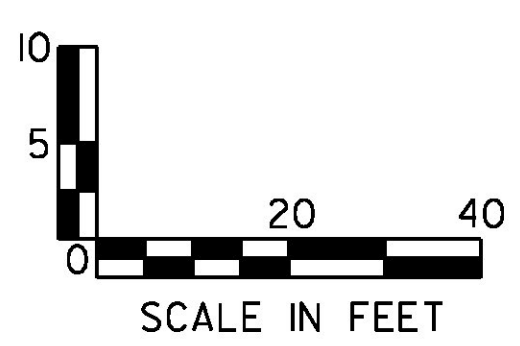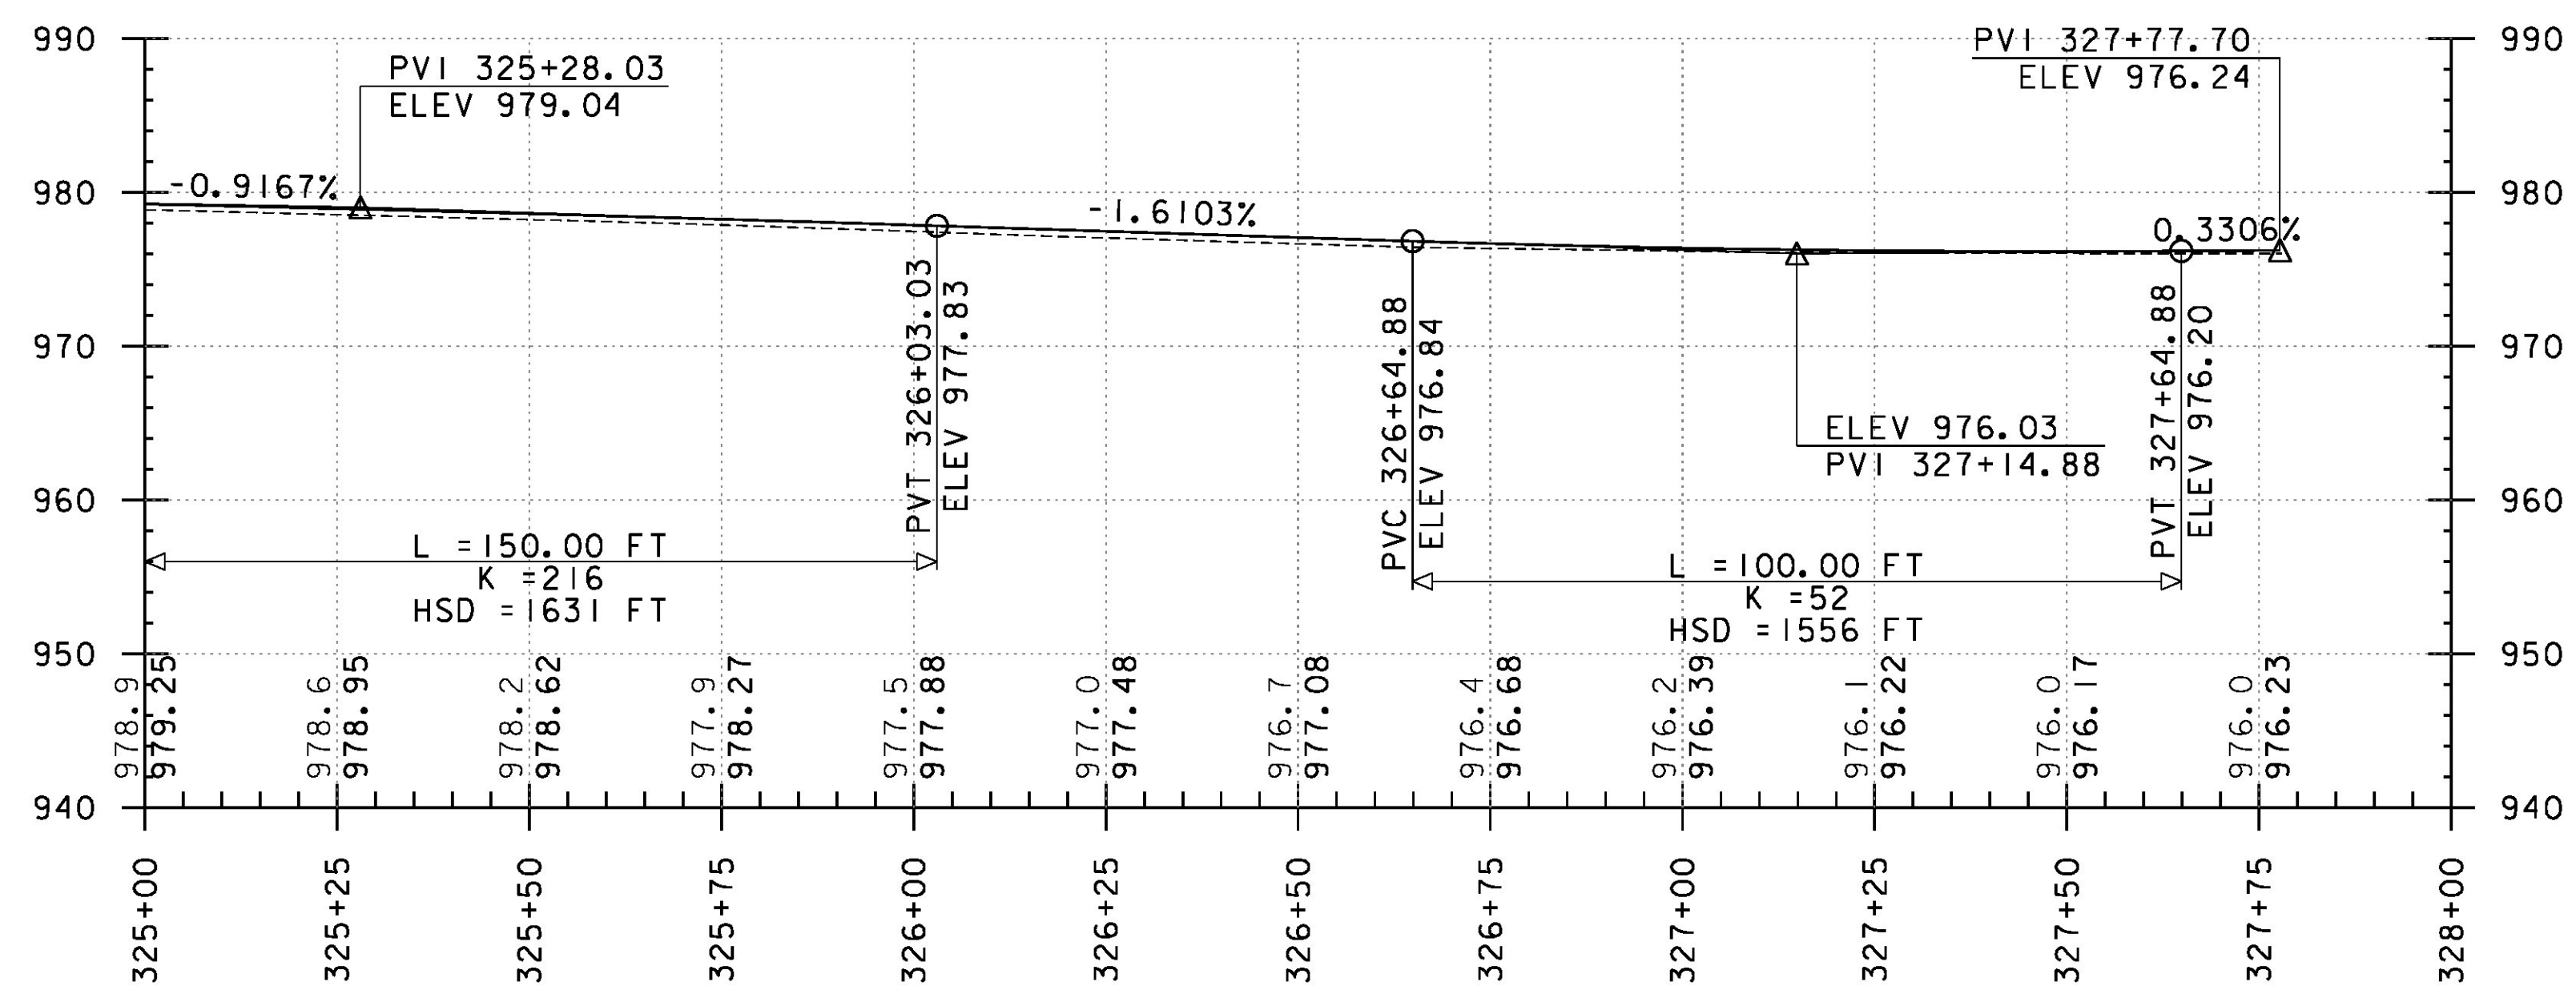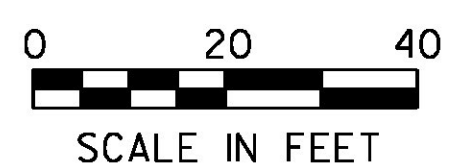

PROJECT NAME: ROXBURY - NORTHFIELD	PLOT DATE: 5/25/2016
PROJECT NUMBER: ER STP 0187(13)	DRAWN BY: G. BARRETT
FILE NAME: z13ci84bdr.dgn	CHECKED BY: G. EDWARDS
DESIGNED BY: G. BURGMEIER	SHEET 109 OF 476
PLAN & PROFILE SHEET 59	