

RELOCATE MAILBOX, SINGLE SUPPORT
 STA. 40+69, RT
 STONE FILL TYPE I & GRUBBING
 MATERIAL (6")
 STA. 40+00 TO 40+03, RT


DURABLE 4 INCH WHITE LINE (OPTION BID ITEM)
 TEMPORARY 4 INCH WHITE LINE, PAINT
 (ALL LINES SHALL INCLUDE EDGE LINE BREAKS
 AND RADII FOR SIDE ROADS)
 STA. 40+00 TO 45+00, SOLID LT & RT

DURABLE 4 INCH YELLOW LINE (OPTION BID ITEM)
 TEMPORARY 4 INCH YELLOW LINE, PAINT
 (ALL LINES SHALL INCLUDE CENTER LINE BREAKS
 FOR SIDE ROADS)
 STA. 40+00 TO 41+18, DASHED LT, SOLID RT
 STA. 41+18 TO 45+00, SOLID LT & RT




STEEL BEAM GUARDRAIL, GALVANIZED
 W/8 FEET POSTS
 STA. 40+00.0 TO 45+00.0, RT

MILLED RUMBLE STRIPS
 STA. 42+00 TO 45+00, C

REMOVING SIGNS
 AS SHOWN - 1

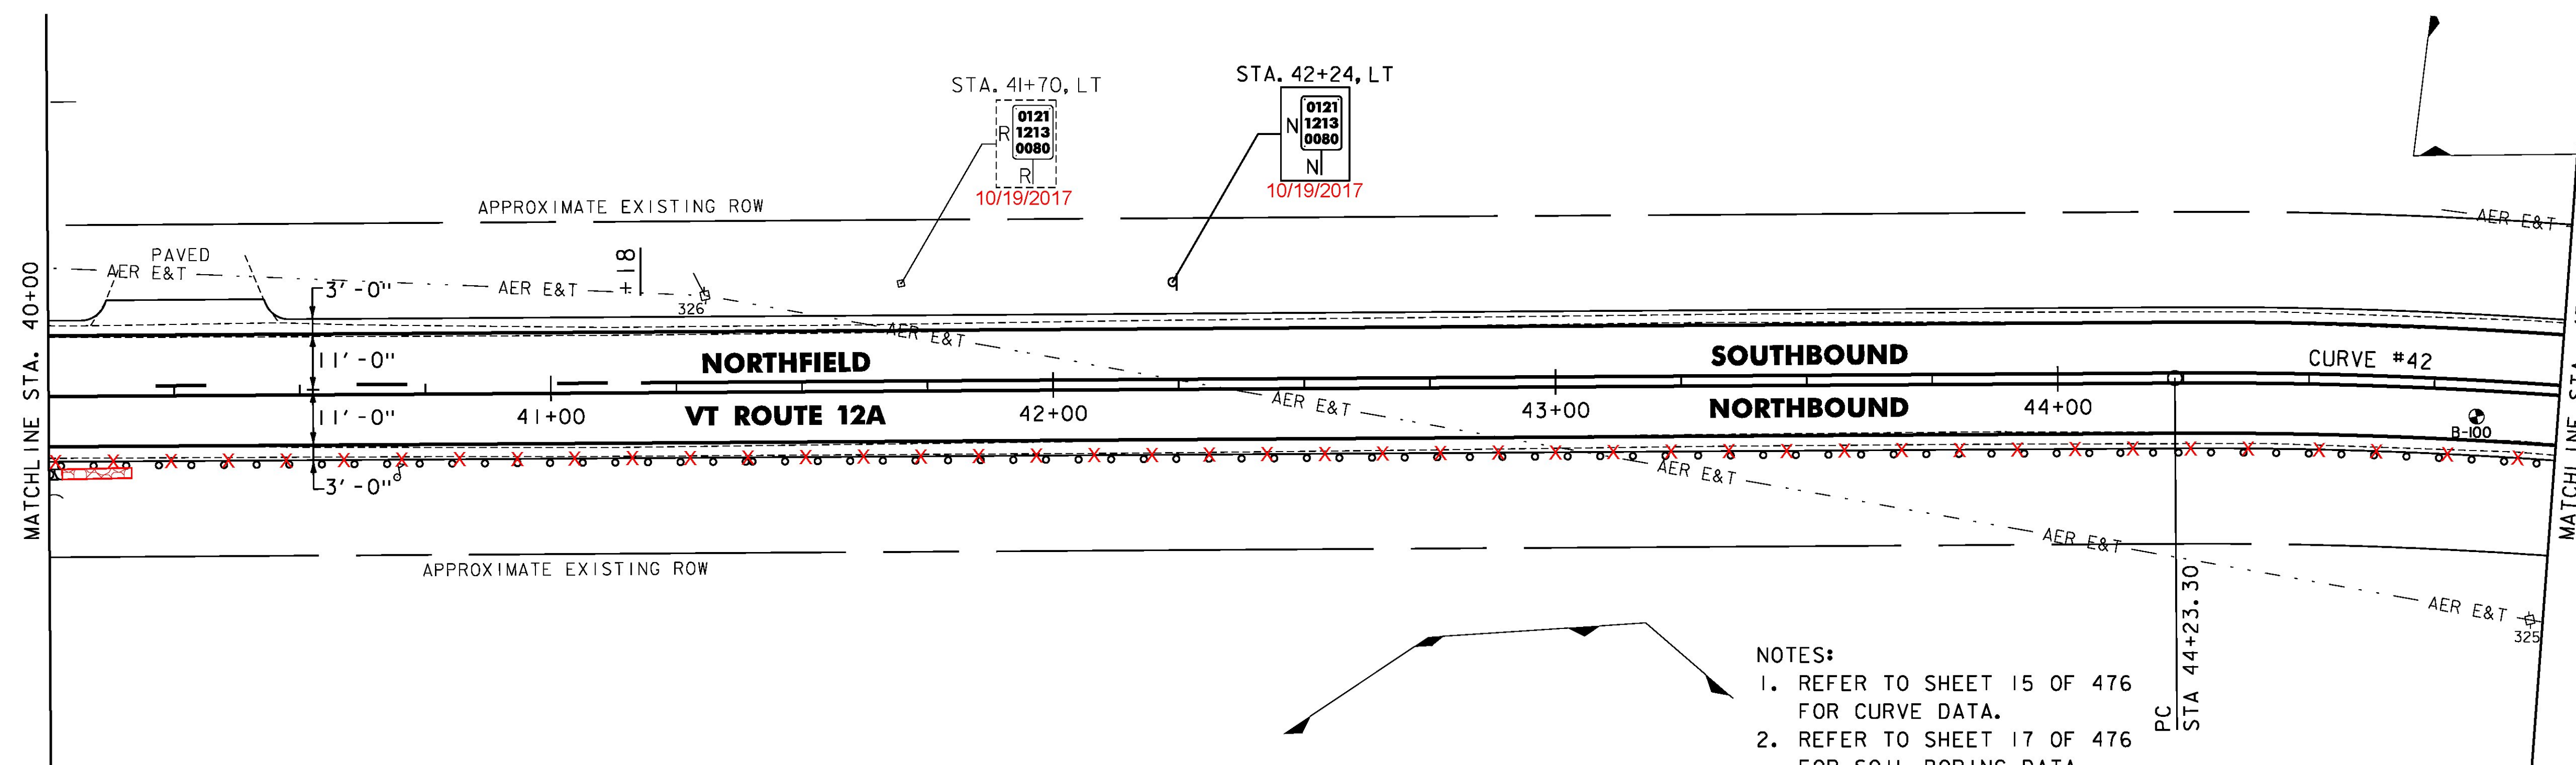

NOTES:
 1. REFER TO SHEET 15 OF 476 FOR CURVE DATA.
 2. REFER TO SHEET 17 OF 476 FOR SOIL BORING DATA.

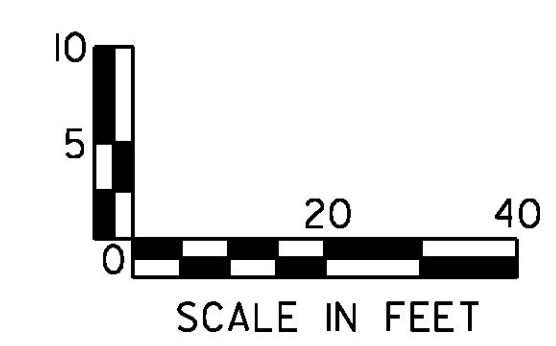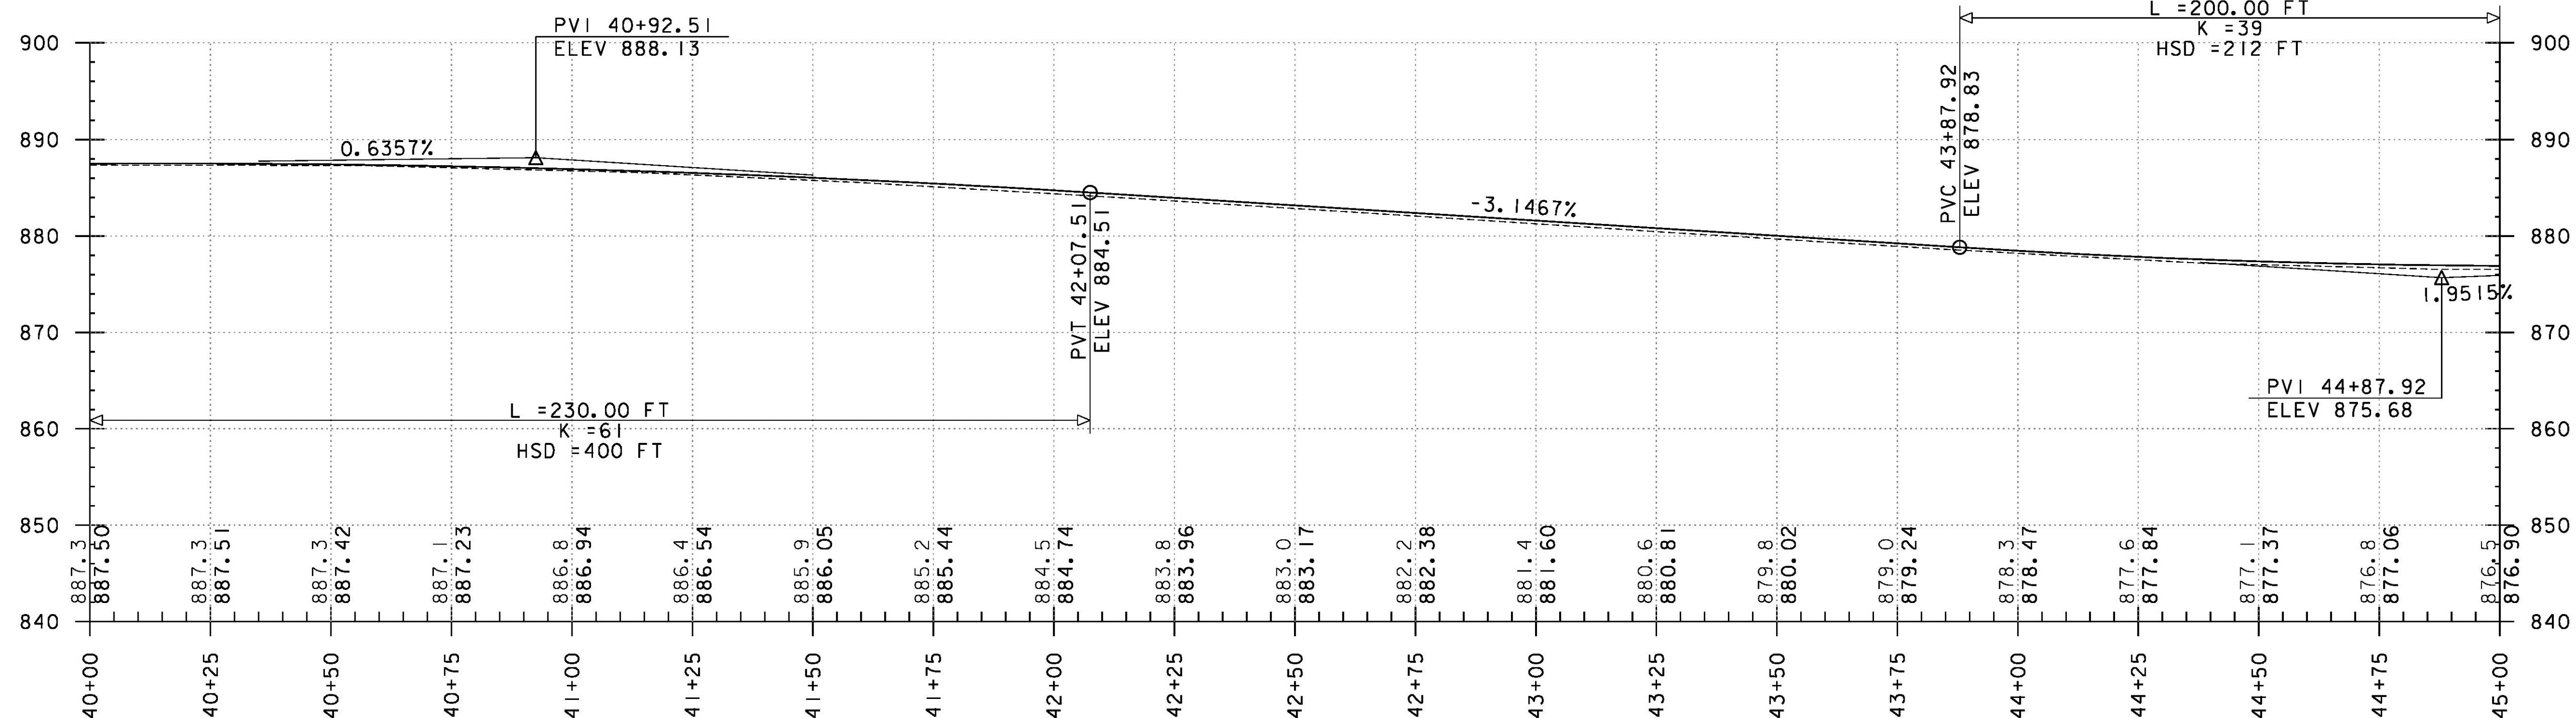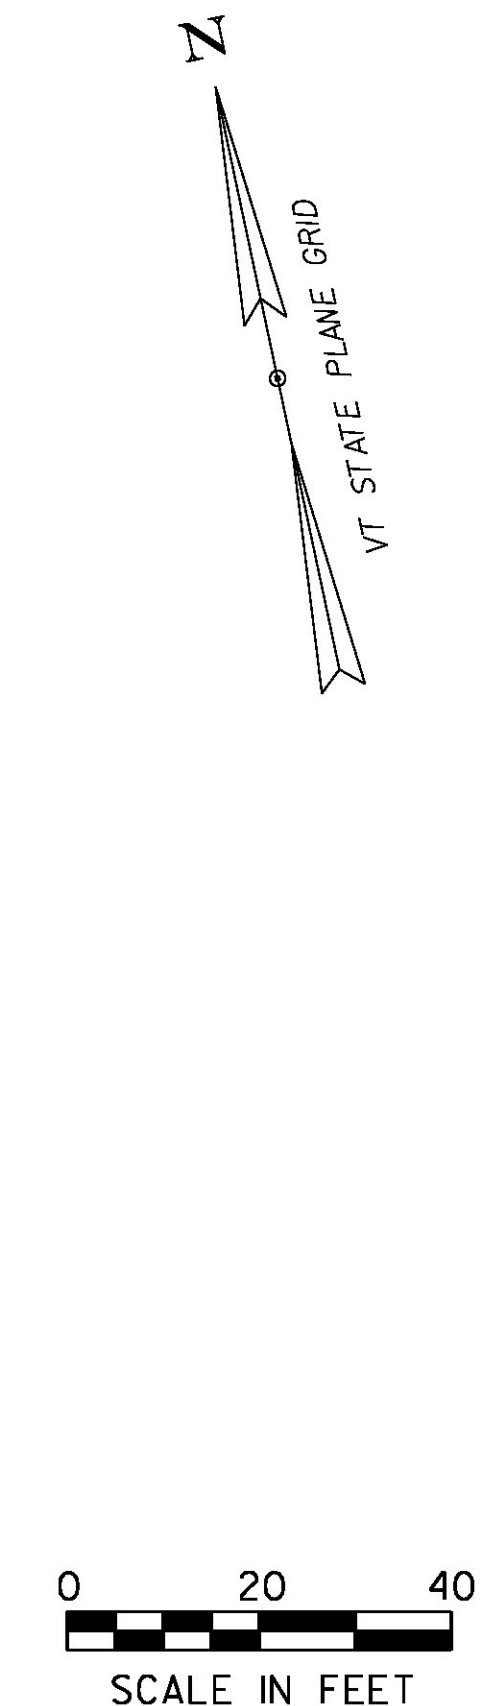

PROJECT NAME:	ROXBURY - NORTHFIELD
PROJECT NUMBER:	ER STP 0187(13)
FILE NAME:	z13cl84bdr.dgn
PROJECT LEADER:	M. FOISY
DESIGNED BY:	G. BURGMEIER
PLANNING & PROFILE SHEET 68	
PLOT DATE:	5/25/2016
DRAWN BY:	G. BARRETT
CHECKED BY:	G. EDWARDS
SHEET	118 OF 476