

DURABLE 4 INCH WHITE LINE (OPTION BID ITEM)  
 TEMPORARY 4 INCH WHITE LINE, PAINT  
 (ALL LINES SHALL INCLUDE EDGE LINE BREAKS  
 AND RADII FOR SIDE ROADS)  
 STA. 140+00 TO 145+00, SOLID LT & RT




DURABLE 4 INCH YELLOW LINE (OPTION BID ITEM)  
 TEMPORARY 4 INCH YELLOW LINE, PAINT  
 (ALL LINES SHALL INCLUDE CENTER LINE BREAKS  
 FOR SIDE ROADS)  
 STA. 140+00 TO 145+00, SOLID LT & RT

STEEL BEAM GUARDRAIL, GALVANIZED  
 STA. 143+55.0 TO 143+80.0, LT  
 STA. 144+77.0 TO 144+77.0, LT

STEEL BEAM GUARDRAIL, GALVANIZED  
 W/8 FEET POSTS  
 STA. 140+00.0 TO 143+55.0, LT  
 STA. 144+77.0 TO 145+00.0, LT

ANCHOR FOR STEEL BEAM RAIL  
 STA. 143+80.0, LT  
 STA. 144+77, LT

REMOVAL AND DISPOSAL OF GUARDRAIL  
 STA. 140+00 TO 143+71, LT  
 STA. 144+66 TO 145+00, LT

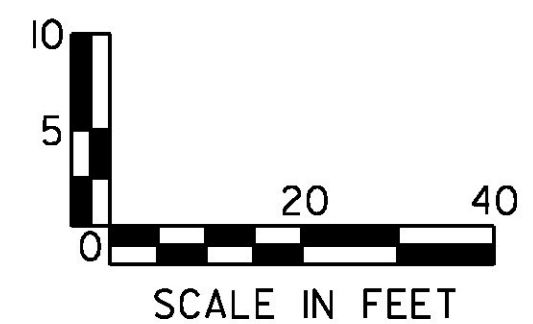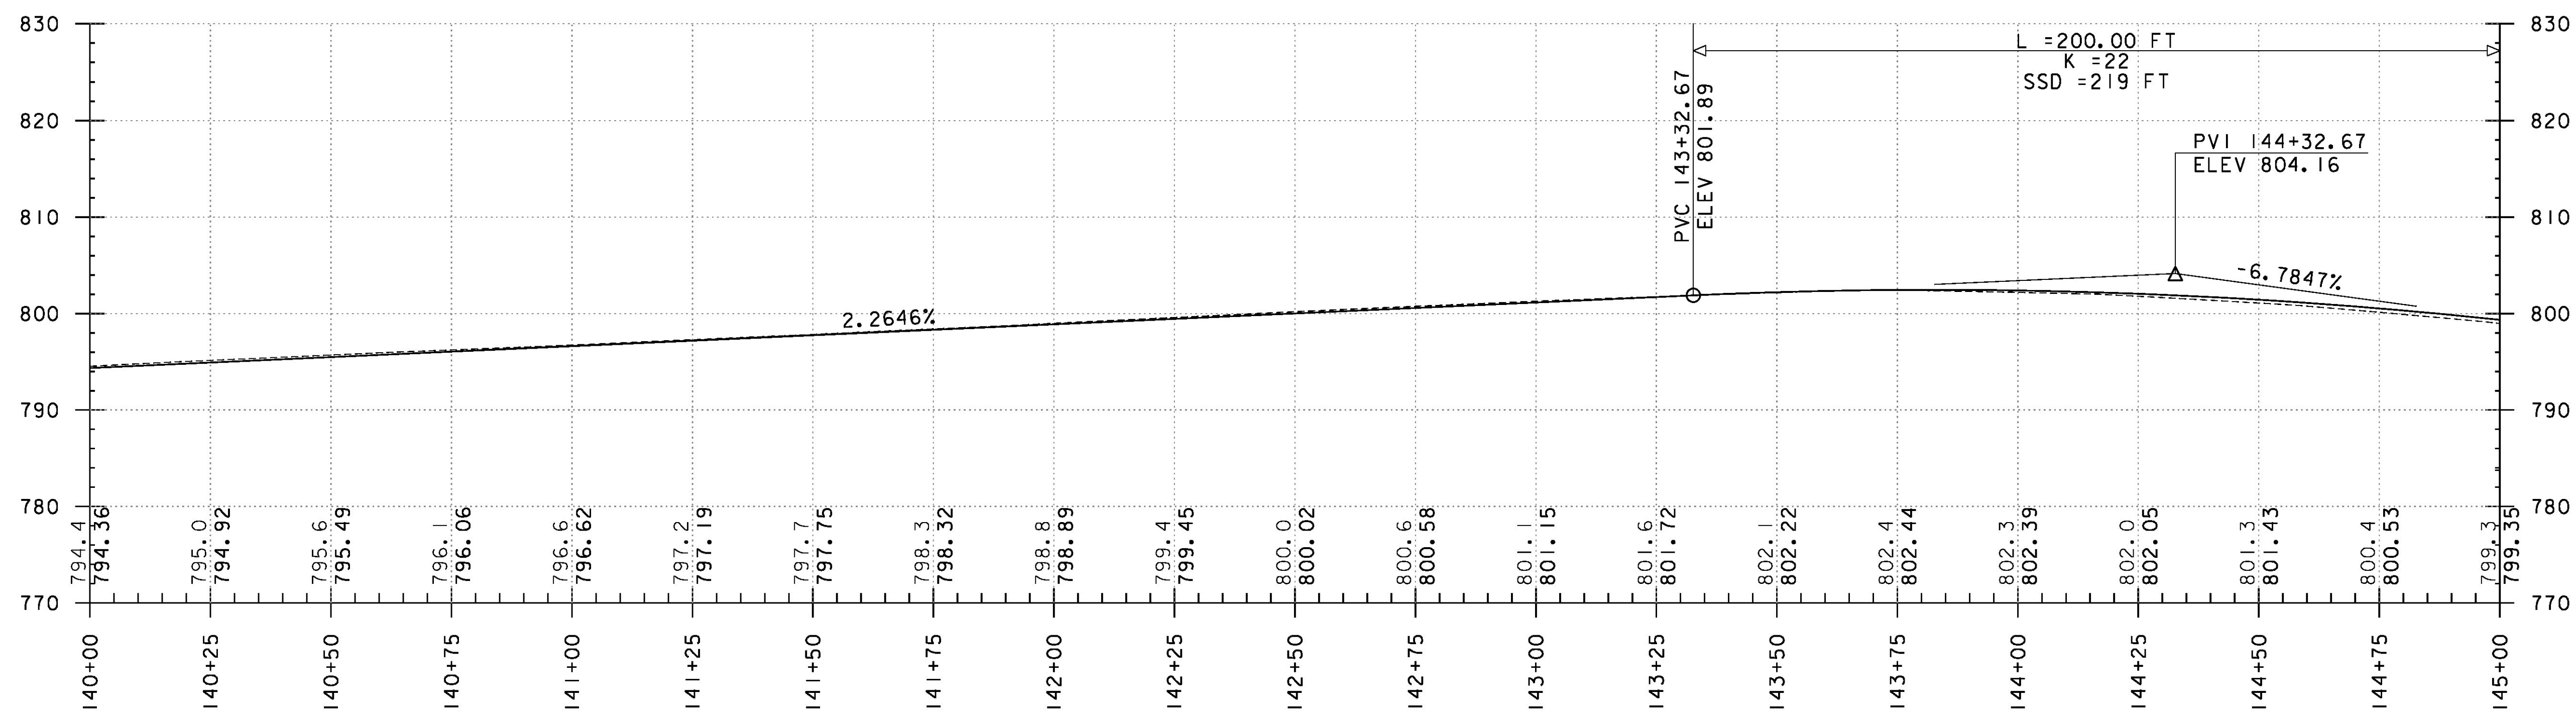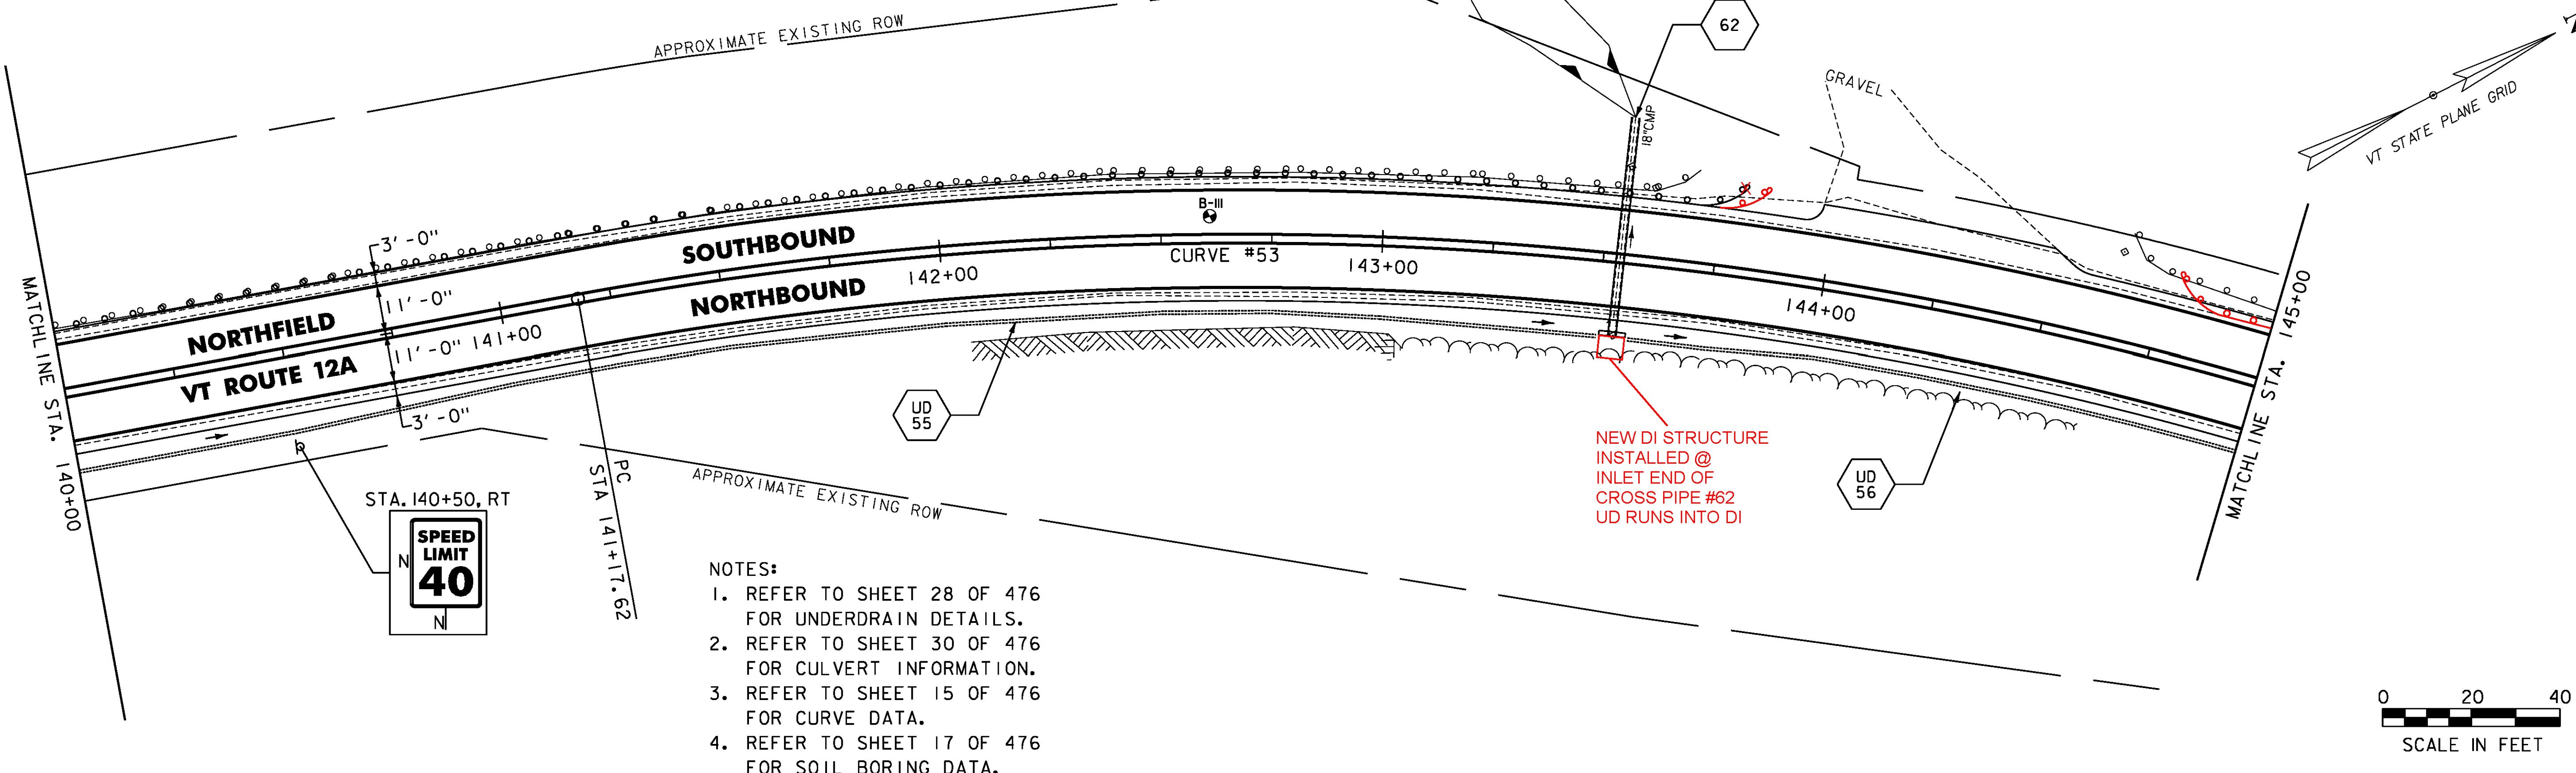

PROJECT NAME:	ROXBURY - NORTHFIELD
PROJECT NUMBER:	ER STP 0187(13)
FILE NAME:	z13cl84bdr.dgn
PROJECT LEADER:	M. FOISY
DESIGNED BY:	G. BURGMEIER
PLANNING & PROFILE SHEET 88	
PLOT DATE:	5/25/2016
DRAWN BY:	G. BARRETT
CHECKED BY:	G. EDWARDS
SHEET	138 OF 476