


DURABLE 4 INCH WHITE LINE (OPTION BID ITEM)
 TEMPORARY 4 INCH WHITE LINE, PAINT
 (ALL LINES SHALL INCLUDE EDGE LINE BREAKS
 AND RADII FOR SIDE ROADS)
 STA. 185+00 TO 190+00, SOLID LT & RT
 CLEANING CULV. PIPE, IN-PLACE
 (0 TO 24IN., INCL.)
 CULVERT #73, 45LF



DURABLE 4 INCH YELLOW LINE (OPTION BID ITEM)
 TEMPORARY 4 INCH YELLOW LINE, PAINT
 (ALL LINES SHALL INCLUDE CENTER LINE BREAKS
 FOR SIDE ROADS)
 STA. 185+00 TO 190+00, SOLID LT & RT
 STA. 186+63, DOUBLE SOLID RT (WINCH HILL RD)

DURABLE 24 INCH STOP BAR (OPTION BID ITEM)
 TEMPORARY 24 INCH STOP BAR, PAINT
 STA. 186+63, RT (WINCH HILL RD) (27 LF)

DURABLE LETTER OR SYMBOL (OPTION BID ITEM)
 TEMPORARY LETTER OR SYMBOL, PAINT
 REMOVING SIGNS
 AS SHOWN - 12
 STA. 186+63, RT "STOP" (WINCH HILL RD)

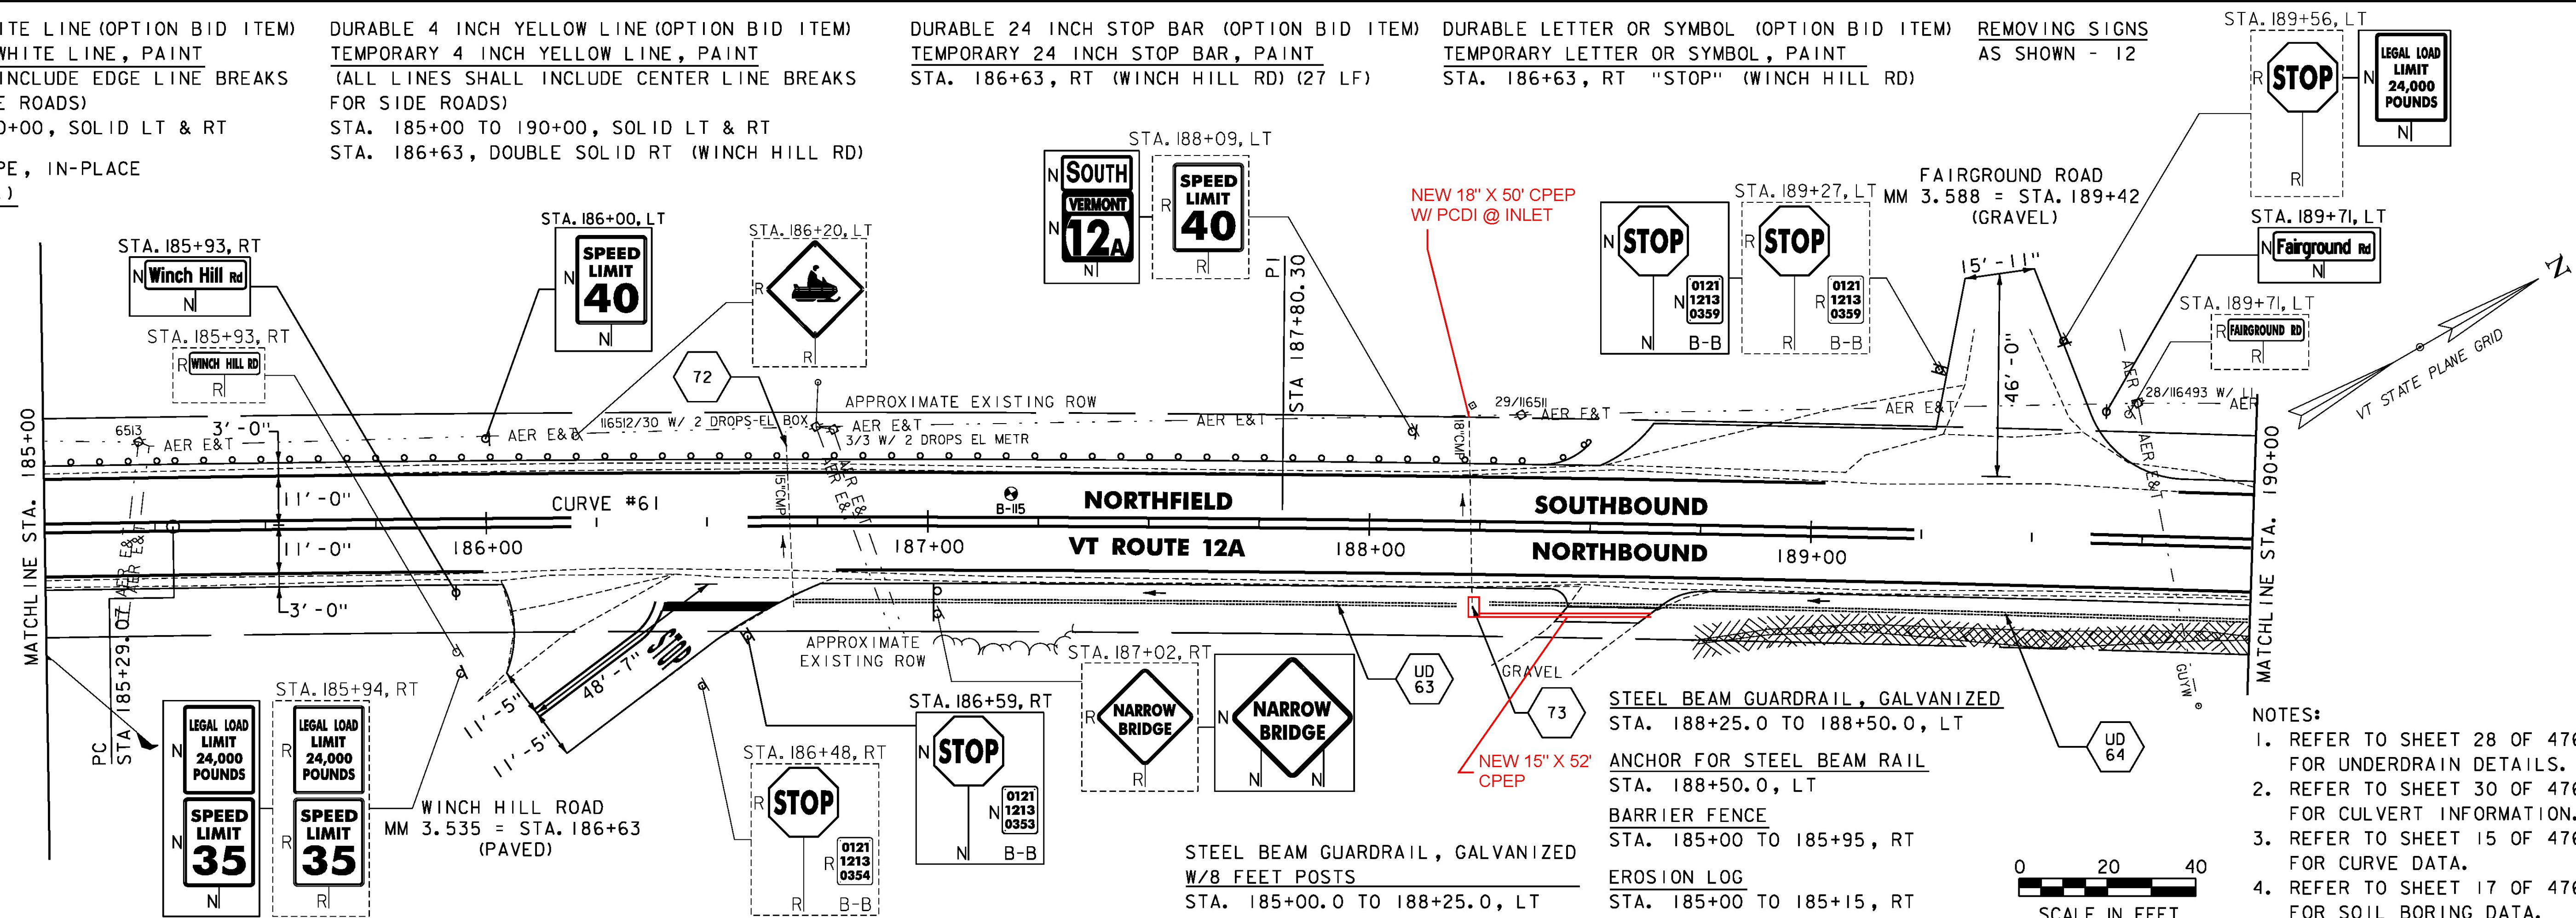

- NOTES:
1. REFER TO SHEET 28 OF 476 FOR UNDERDRAIN DETAILS.
 2. REFER TO SHEET 30 OF 476 FOR CULVERT INFORMATION.
 3. REFER TO SHEET 15 OF 476 FOR CURVE DATA.
 4. REFER TO SHEET 17 OF 476 FOR SOIL BORING DATA.

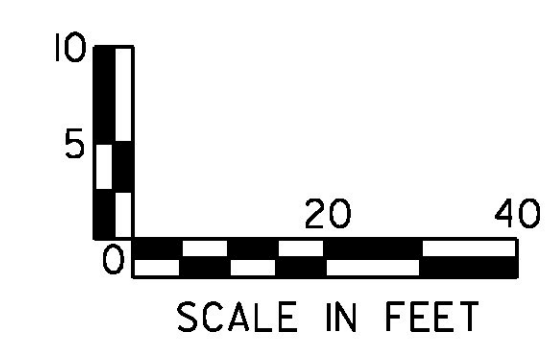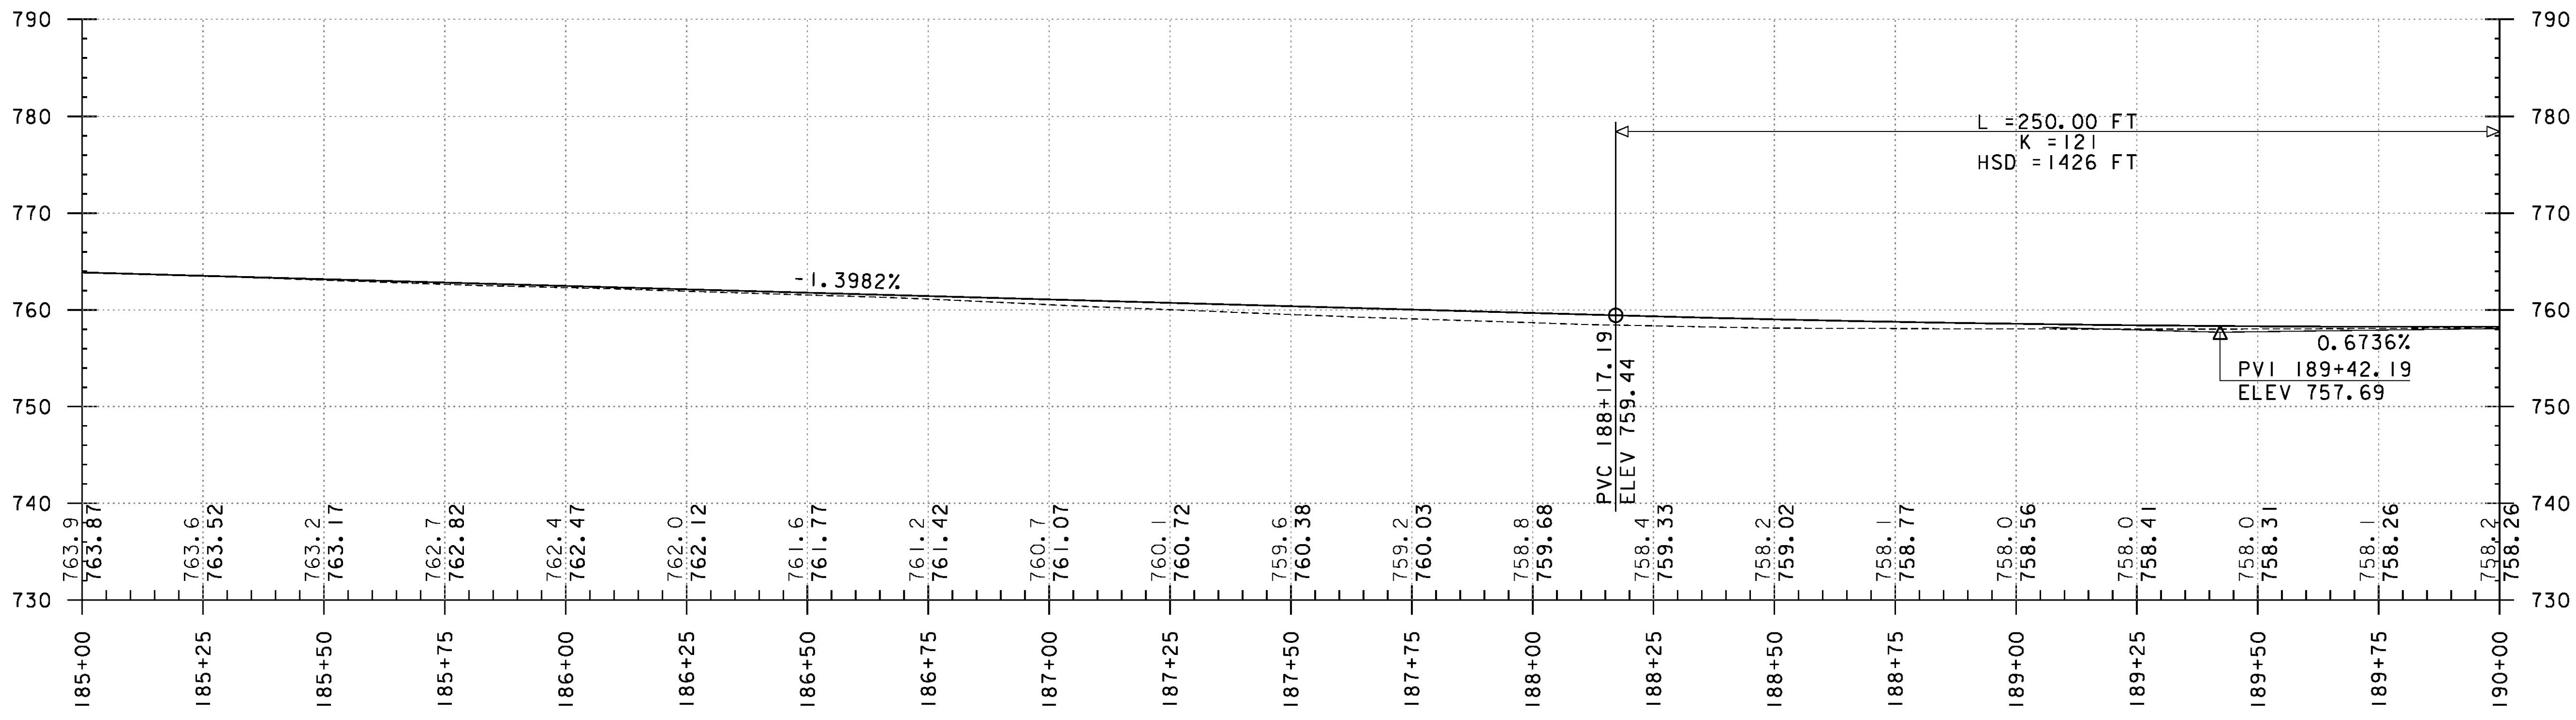

PROJECT NAME: ROXBURY - NORTHFIELD
 PROJECT NUMBER: ER STP 0187(13)
 FILE NAME: z13cl84bdr.dgn
 PROJECT LEADER: M. FOISY
 DESIGNED BY: G. BURGMEIER
 PLAN & PROFILE SHEET 97
 PLOT DATE: 5/25/2016
 DRAWN BY: G. BARRETT
 CHECKED BY: G. EDWARDS
 SHEET 147 OF 476

