
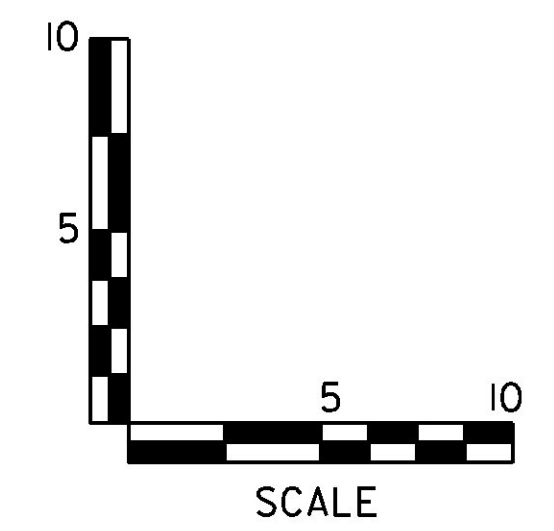
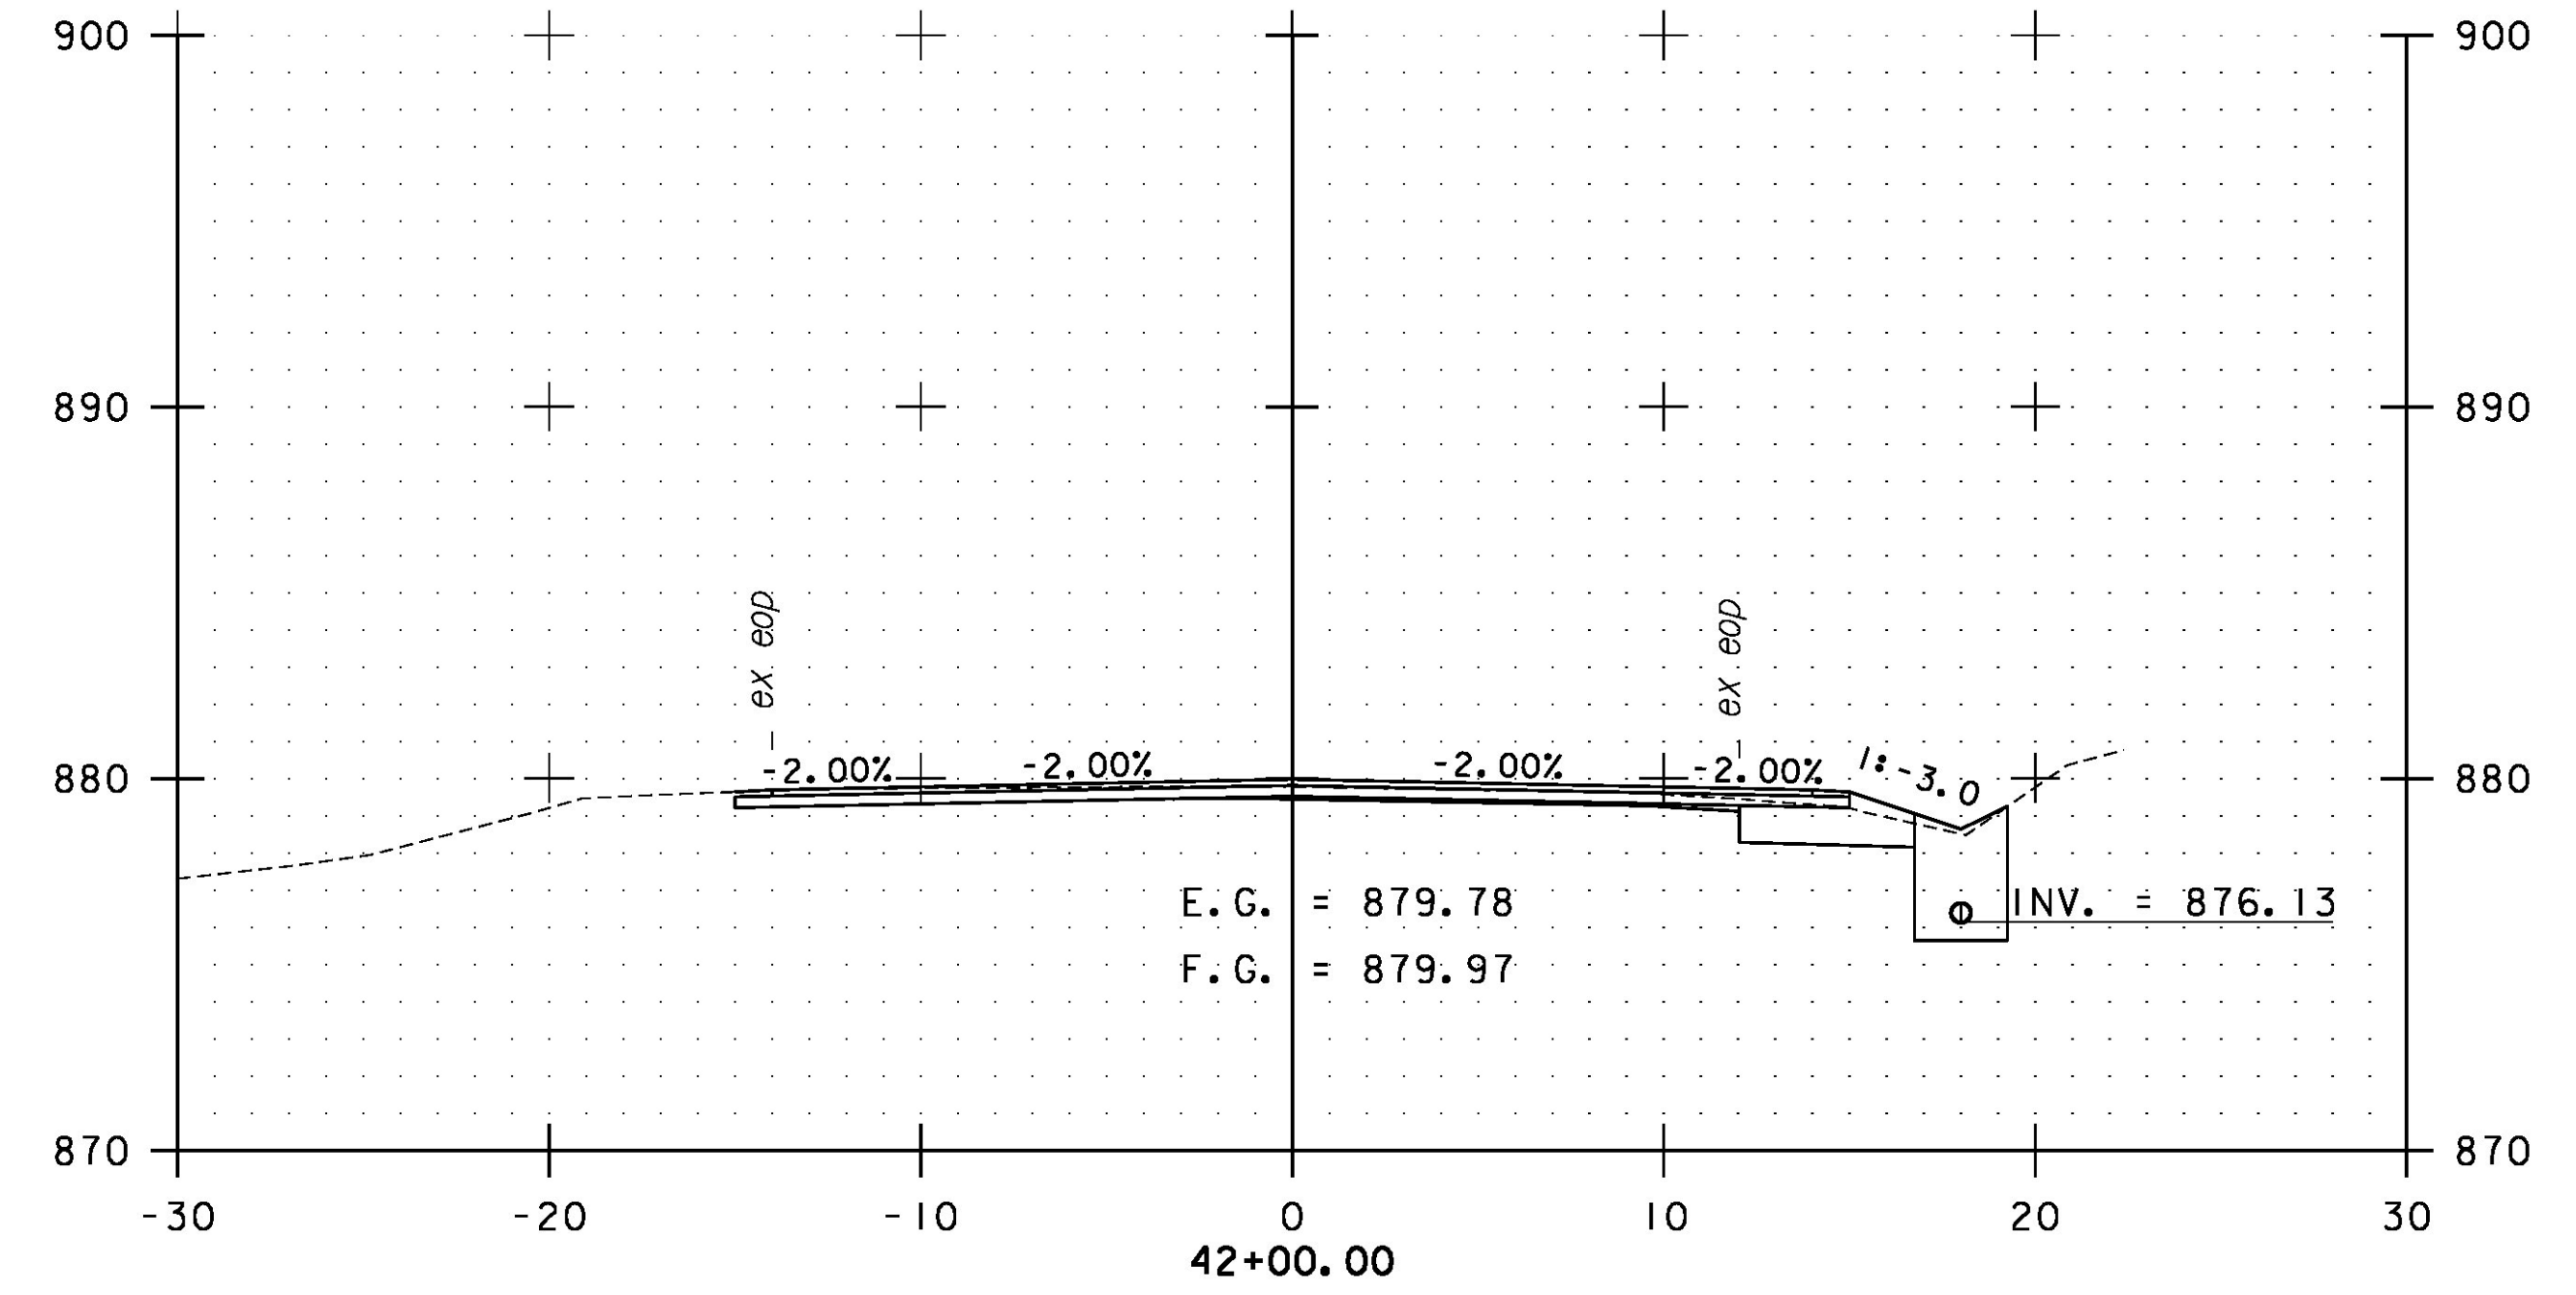


TRANSITION TO MATCH EXISTING SUPERELEVATION IN COLD PLANE AREA

ROXBURY-NORTHFIELD ER STP 0187(13)
ROXBURY STA. 40+35 (MM 0.764)
END COLD PLANE
BEGIN RECLAIM (SEGMENT 1)

STA. 40+50 TO STA. 42+50

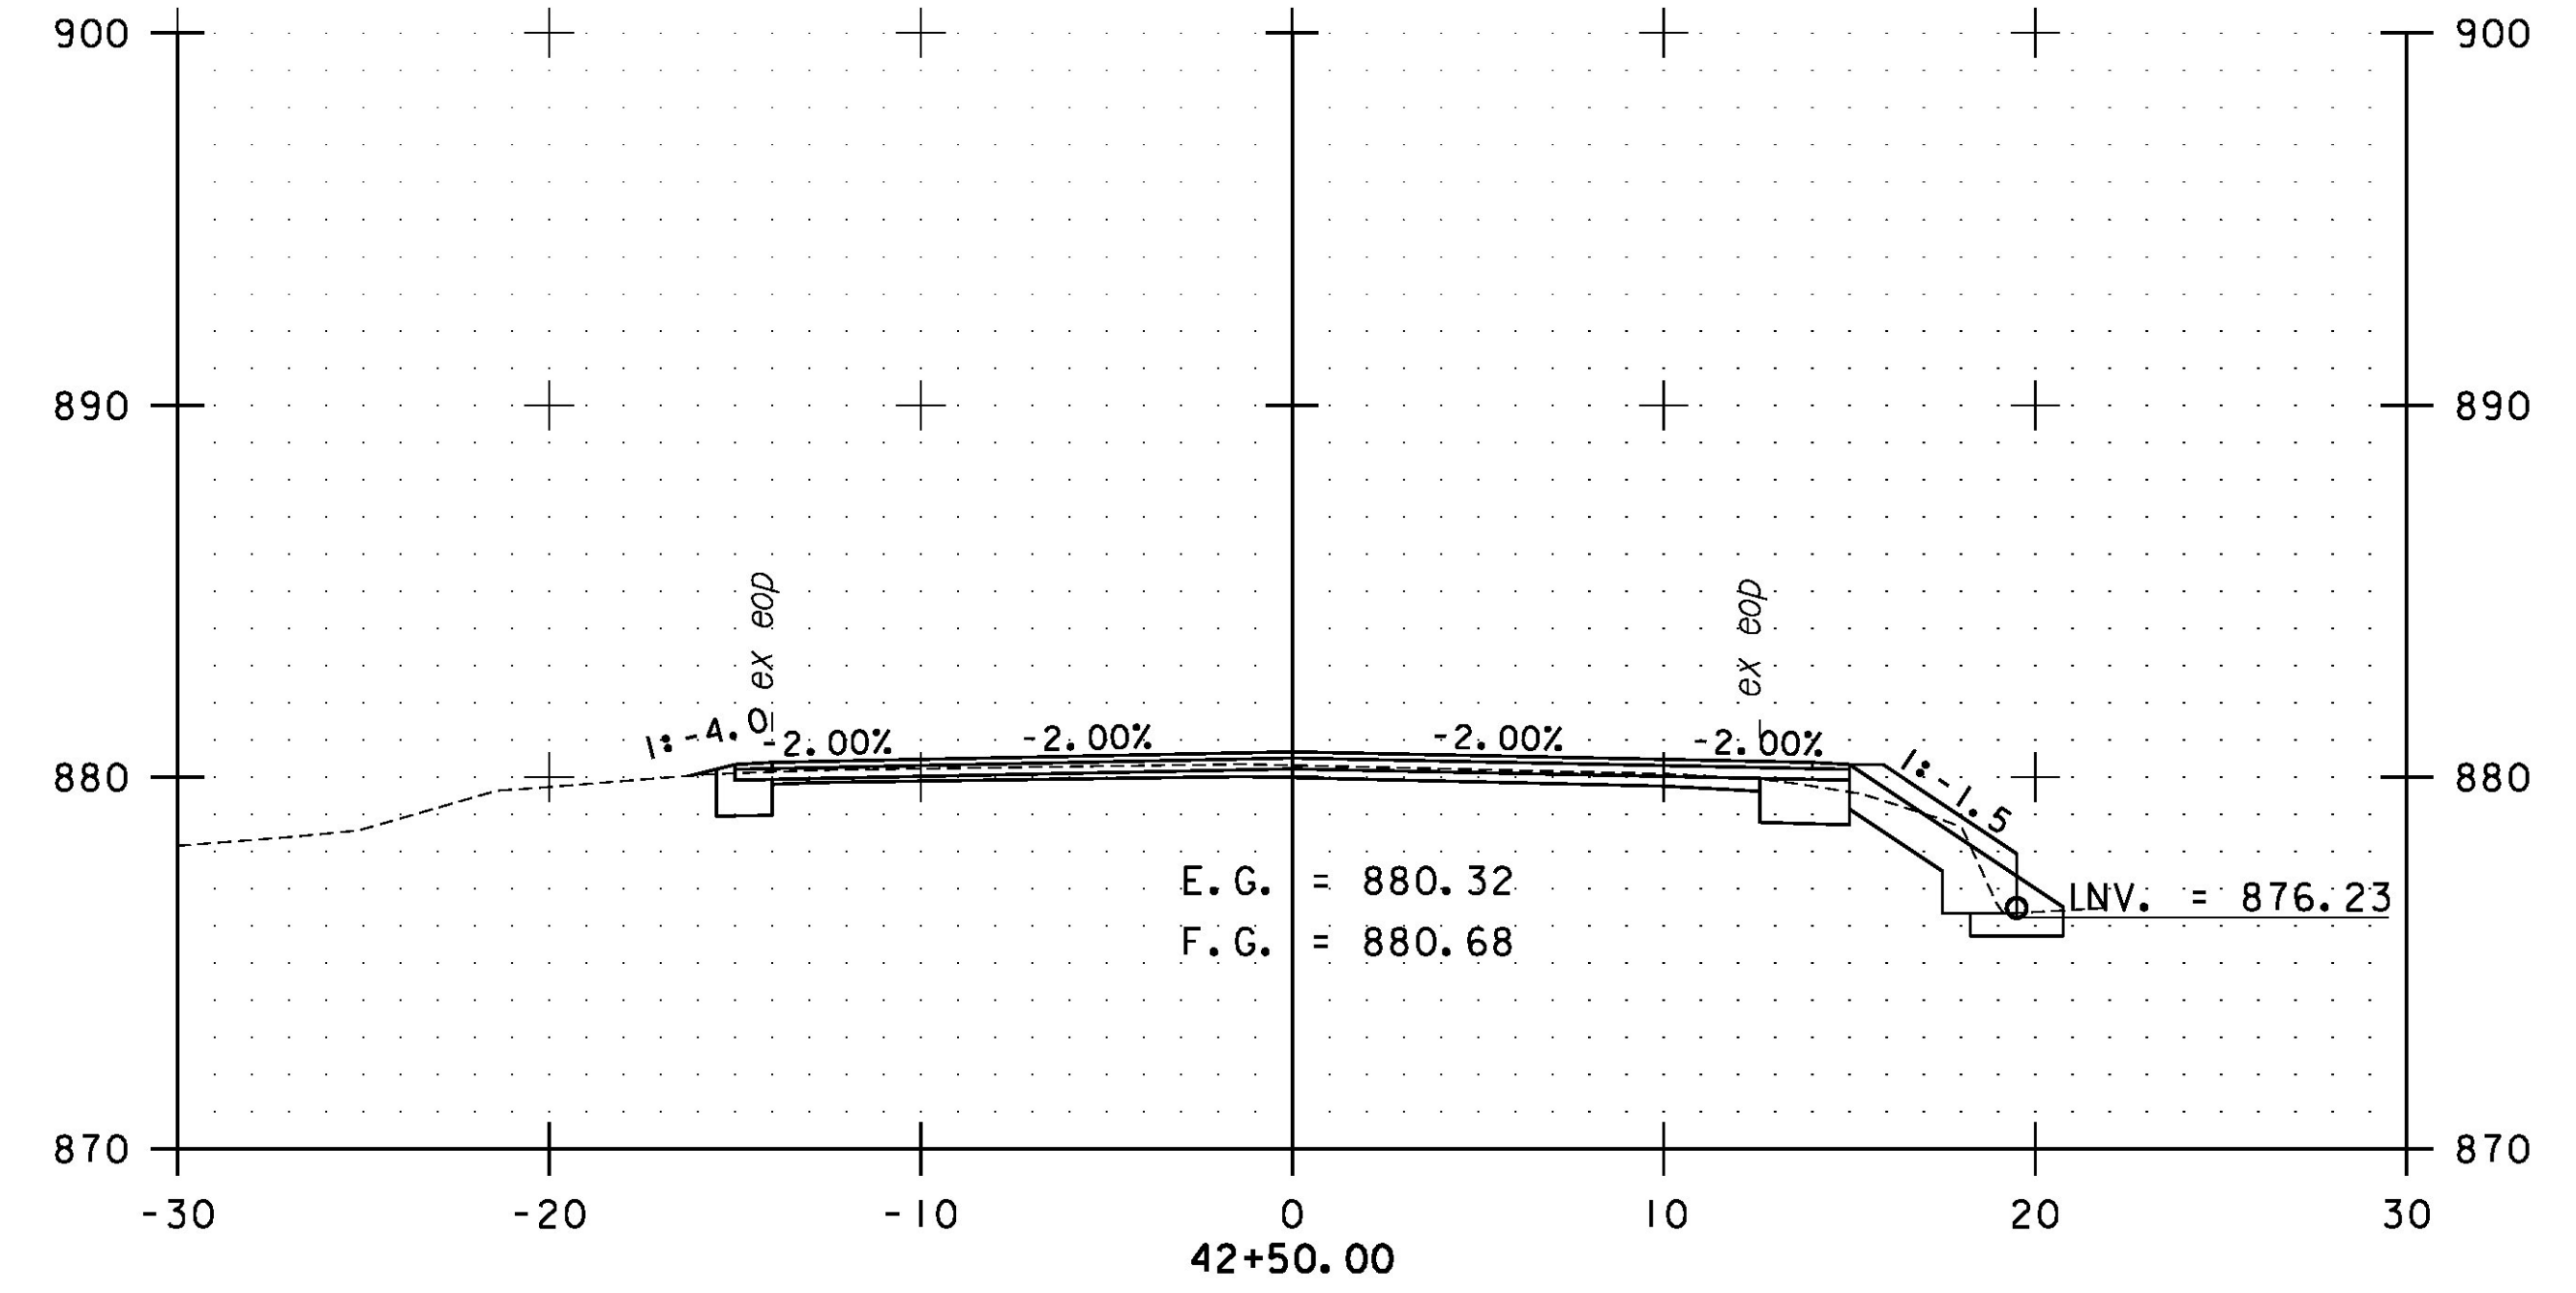

PROJECT NAME: ROXBURY-NORTHFIELD	PLOT DATE: 5/25/2016
PROJECT NUMBER: ER STP 0187(13)	DRAWN BY: G. BURGMEIER
FILE NAME: z13ci84xs.dgn	CHECKED BY: G. EDWARDS
PROJECT LEADER: M. FOISY	SHEET 192 OF 476
DESIGNED BY: G. BURGMEIER	
ROXBURY CROSS SECTIONS SHEET 1	