



51+50.00
TRANSITION TO MATCH EXISTING SUPERELEVATION IN COLD PLANE AREA

E.G. = 893.27
F.G. = 893.58

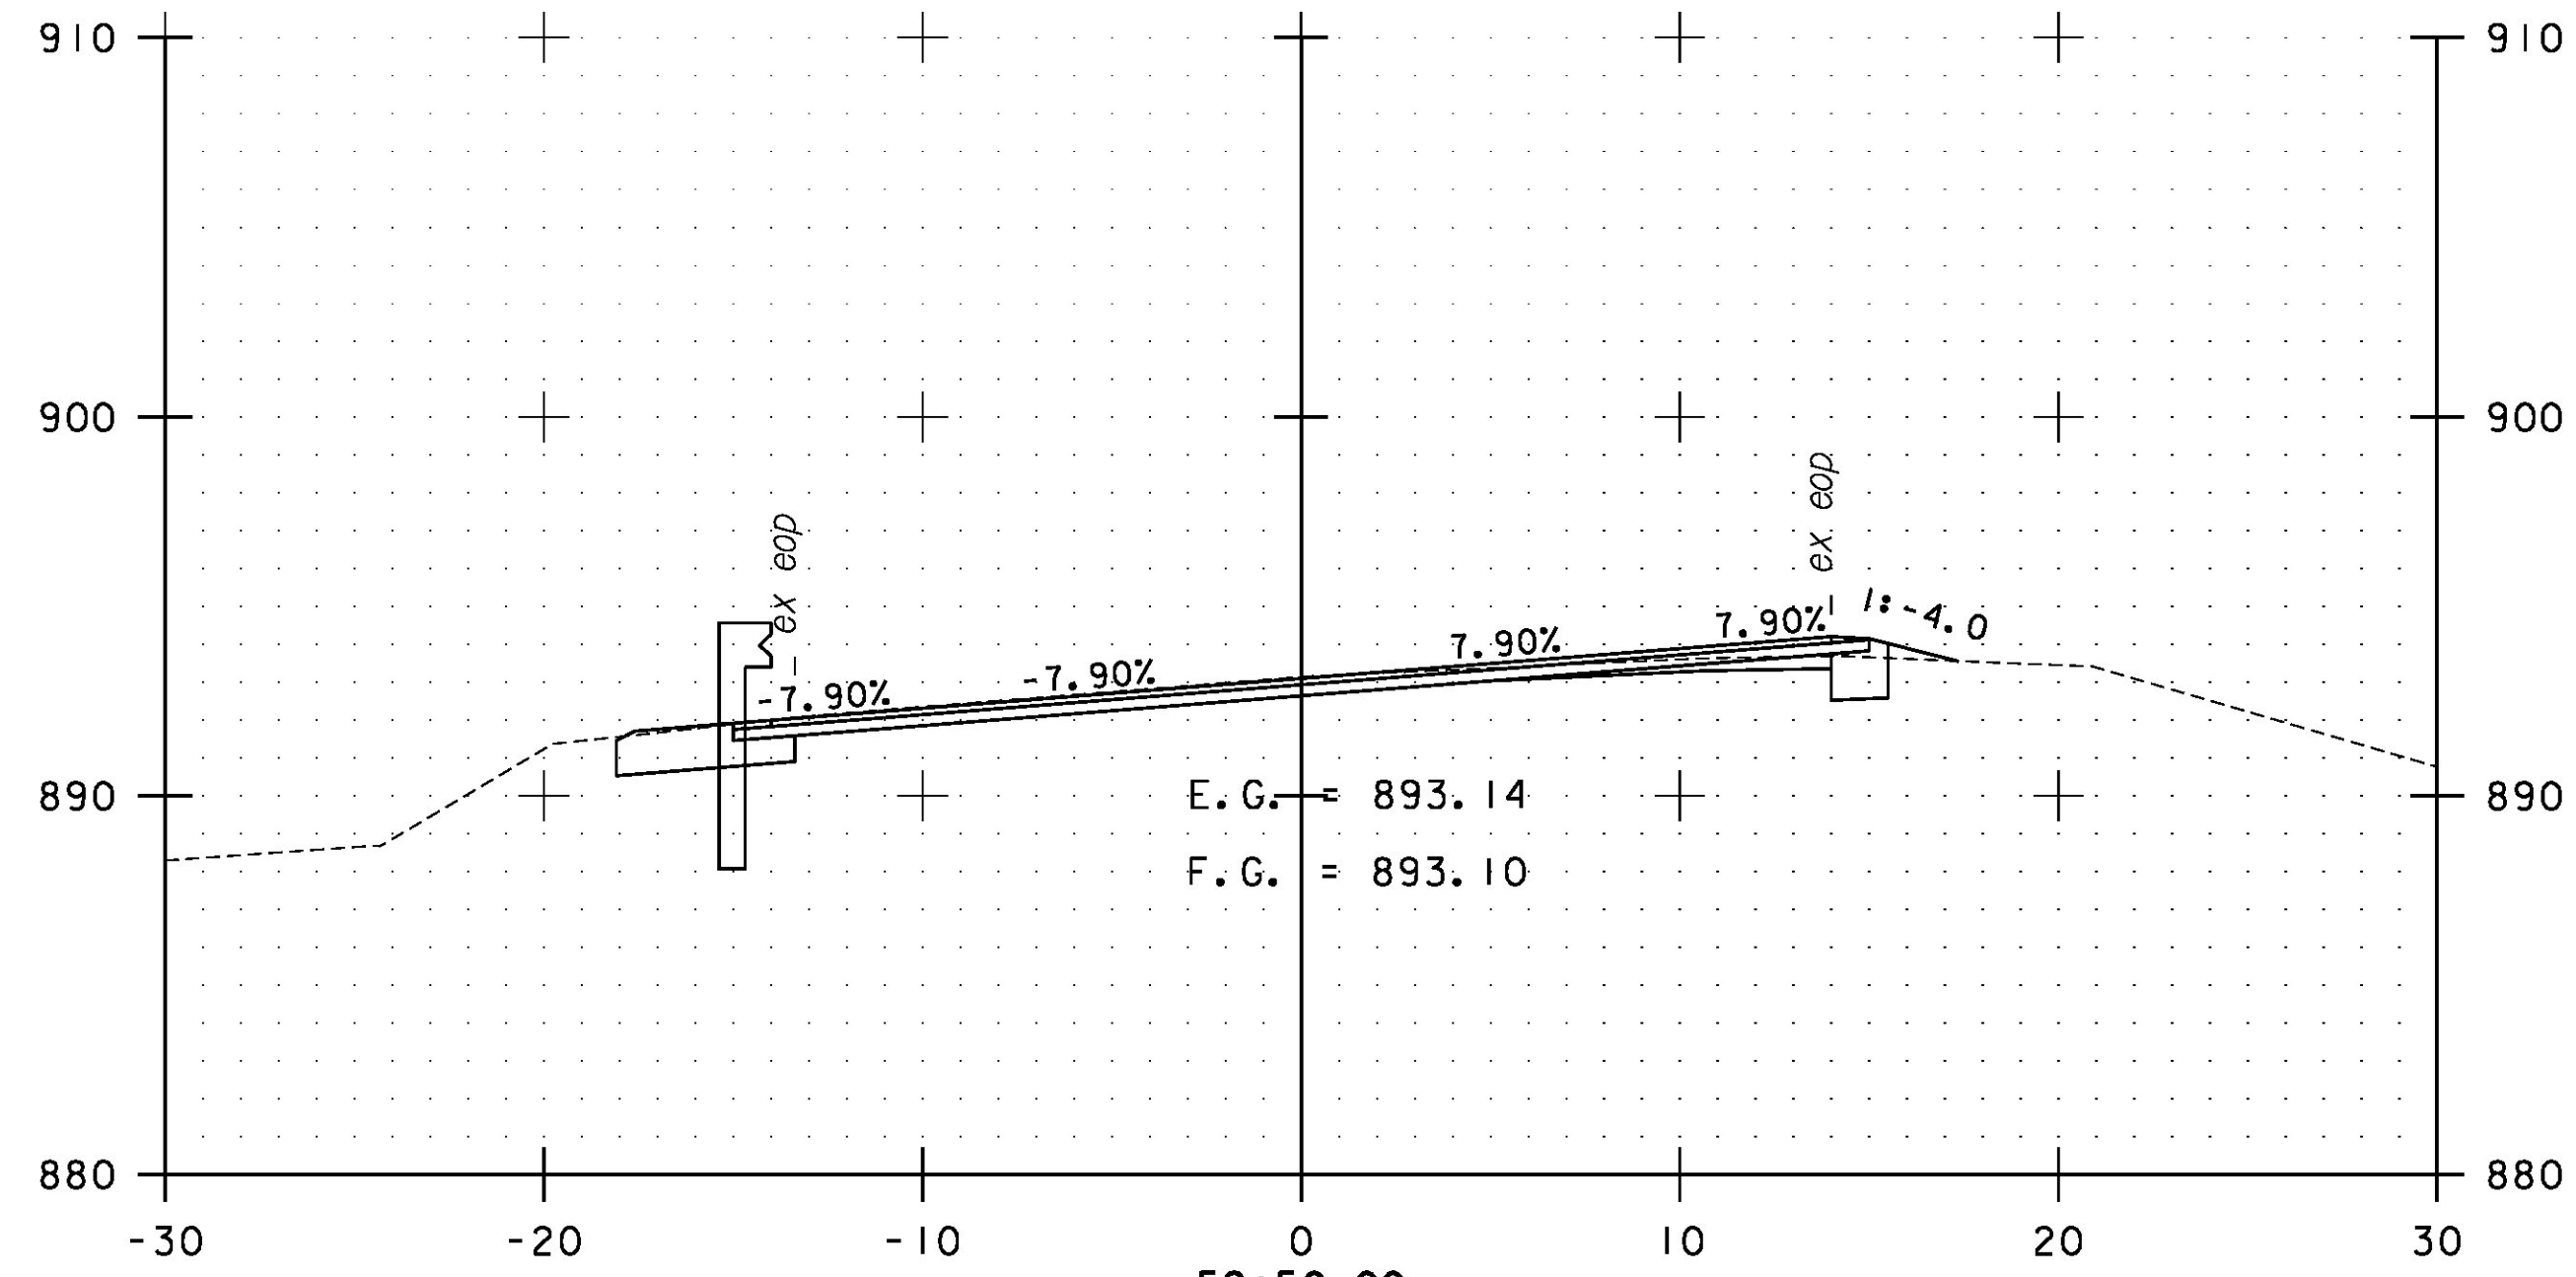


52+50.00

E.G. = 893.14
F.G. = 893.10

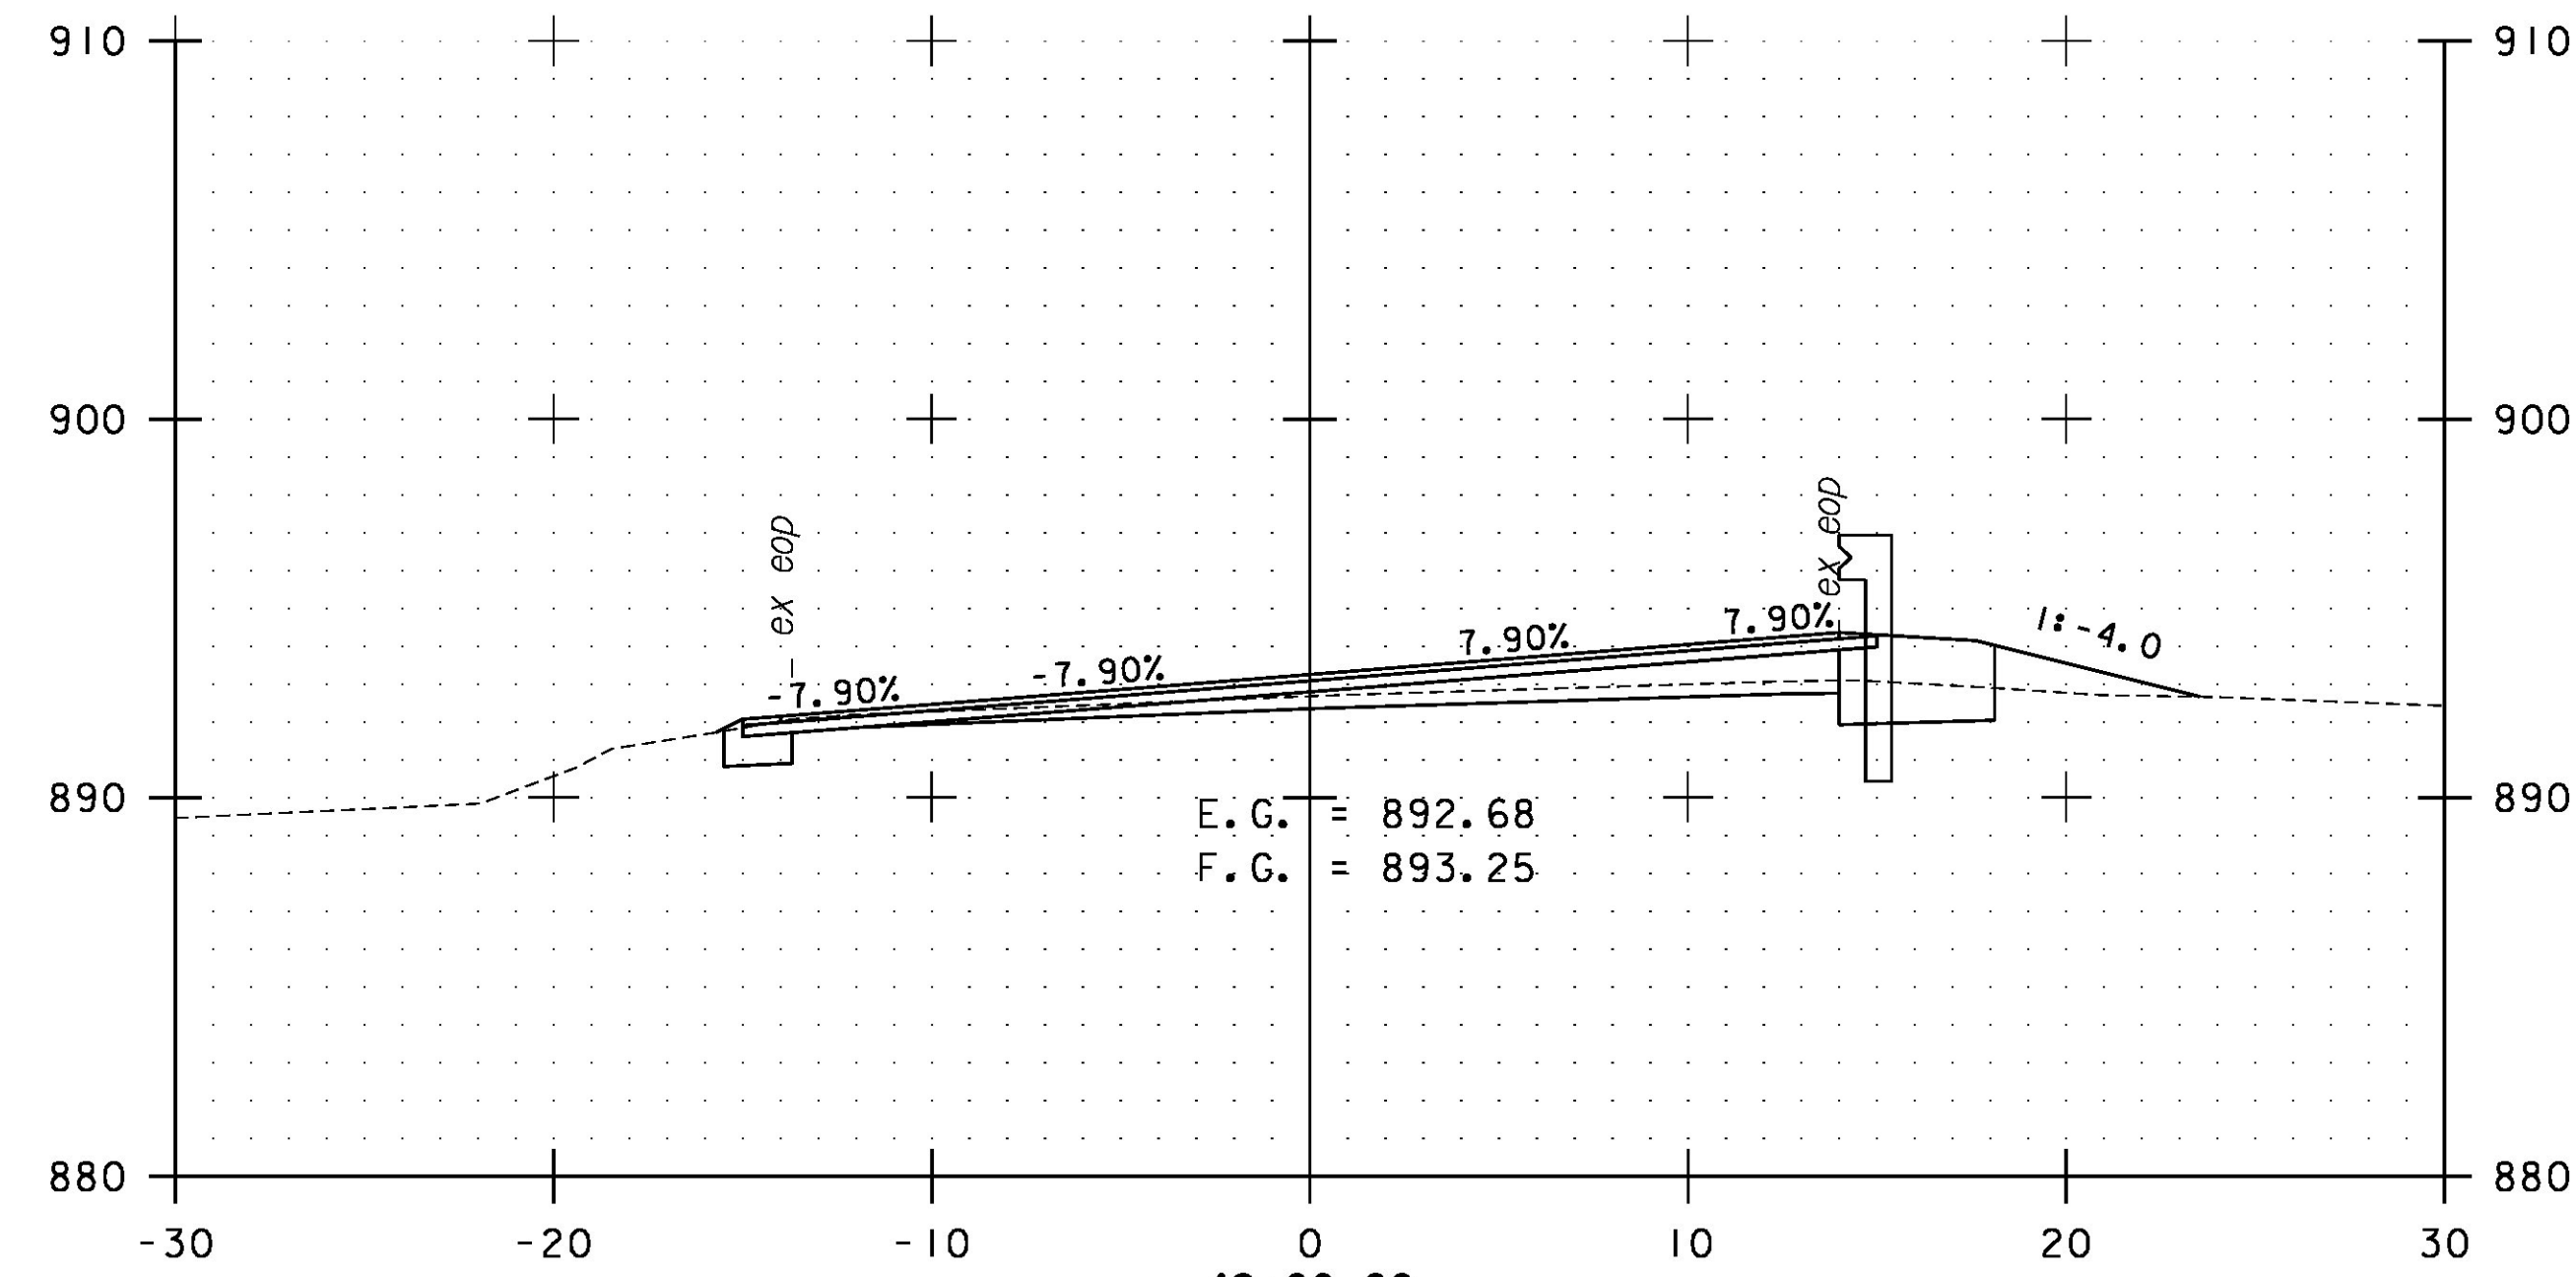


49+00.00
TRANSITION TO MATCH EXISTING SUPERELEVATION IN COLD PLANE AREA

E.G. = 892.68
F.G. = 893.25

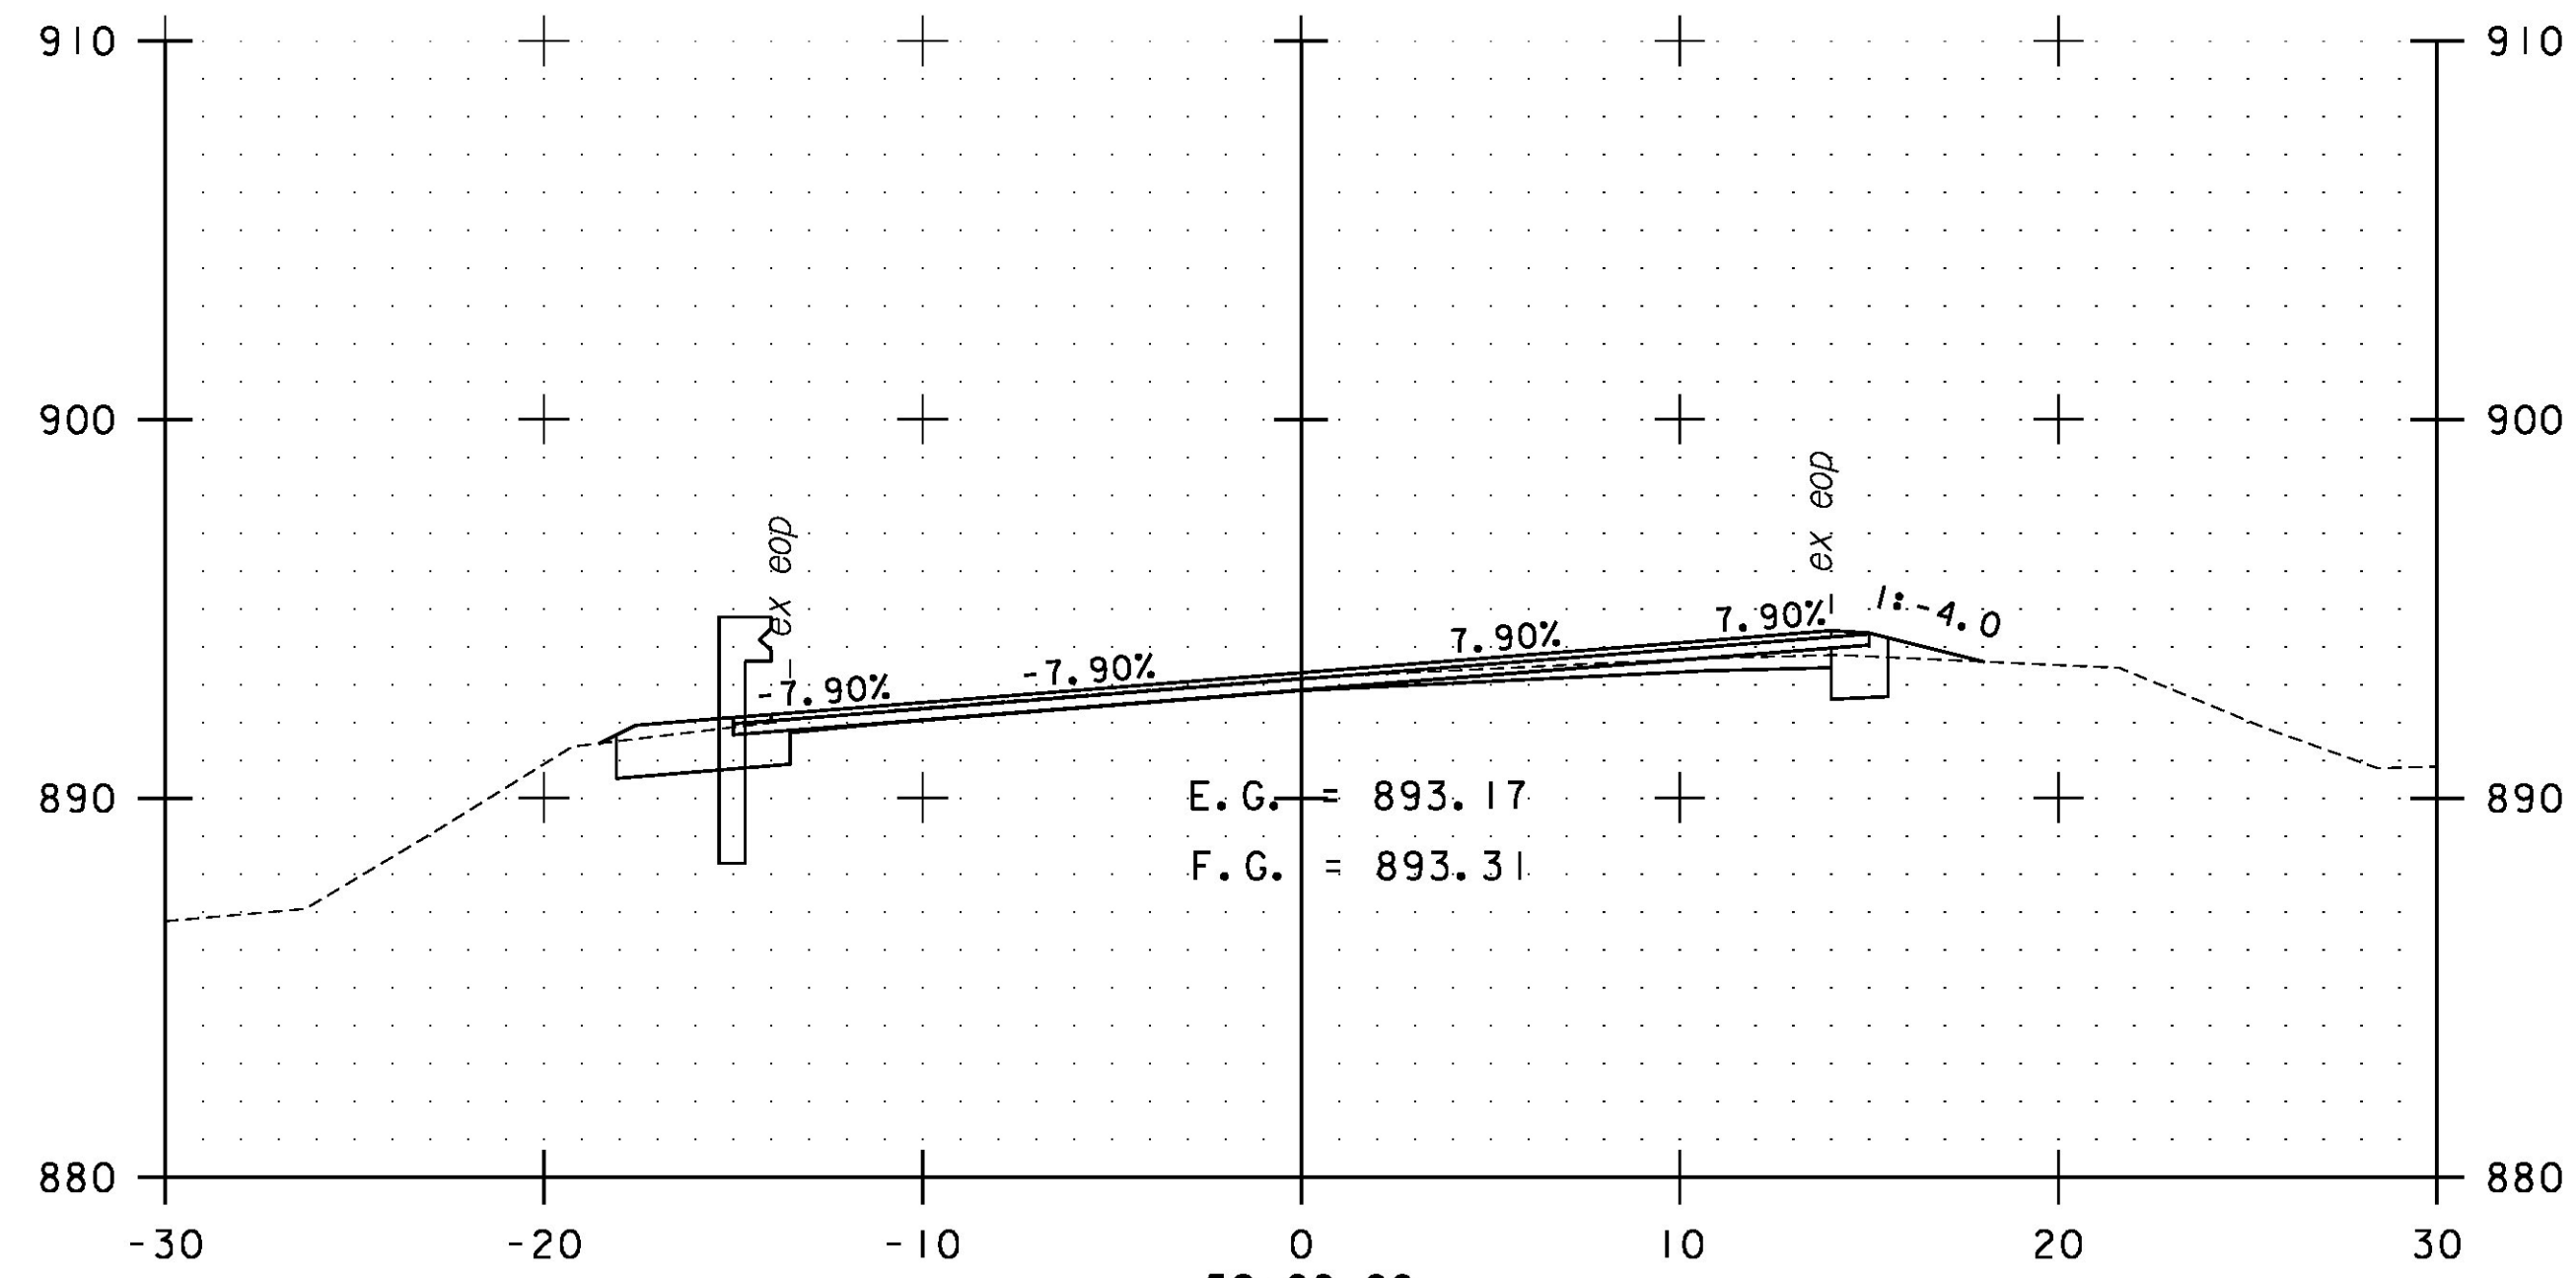

52+00.00

E.G. = 893.17
F.G. = 893.31

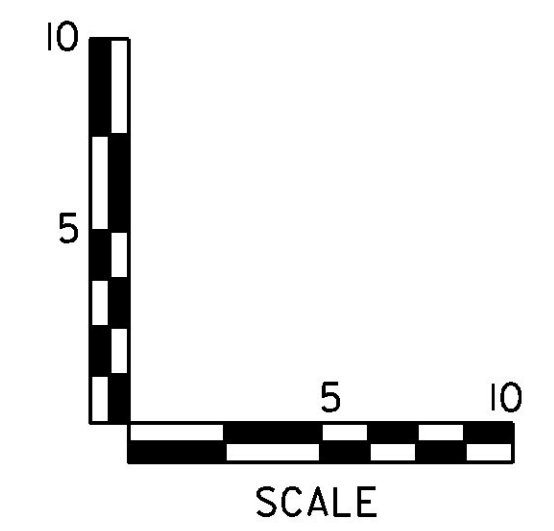

STA. 49+00 TO STA. 52+50



PROJECT NAME: ROXBURY-NORTHFIELD
PROJECT NUMBER: ER STP 0187(13)

FILE NAME: z13cl84xs.dgn
PROJECT LEADER: M. FOISY
DESIGNED BY: G. BURGMEIER
ROXBURY CROSS SECTIONS SHEET 5

PLOT DATE: 5/25/2016
DRAWN BY: G. BURGMEIER
CHECKED BY: G. EDWARDS
SHEET 196 OF 476