


STA. 75+00 TO STA. 76+50

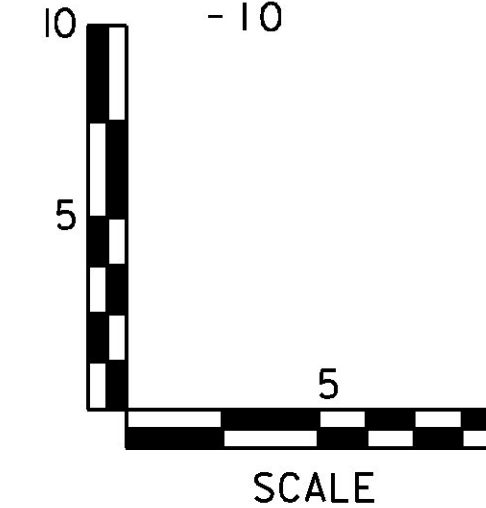

PROJECT NAME: ROXBURY-NORTHFIELD  
 PROJECT NUMBER: ER STP 0187(13)

FILE NAME: z13cl84xs.dgn  
 PROJECT LEADER: M. FOISY  
 DESIGNED BY: G. BURGMEIER  
 ROXBURY CROSS SECTIONS SHEET 17

PLOT DATE: 5/25/2016  
 DRAWN BY: G. BURGMEIER  
 CHECKED BY: G. EDWARDS  
 SHEET 208 OF 476