


STA. 109+00 TO STA. 110+50

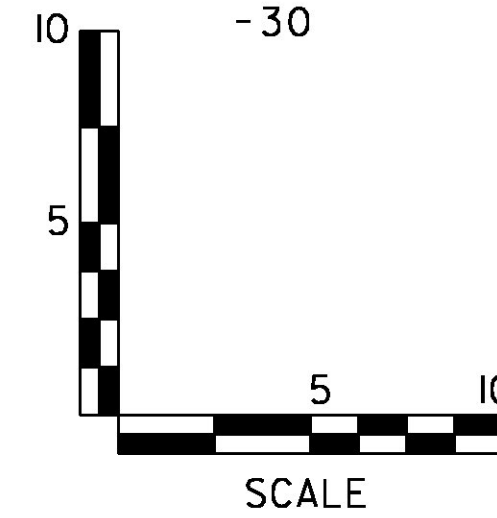

PROJECT NAME: ROXBURY-NORTHFIELD	
PROJECT NUMBER: ER STP 0187(13)	
FILE NAME: z13ci84xs.dgn	PLOT DATE: 5/25/2016
PROJECT LEADER: M. FOISY	DRAWN BY: G. BURGMEIER
DESIGNED BY: G. BURGMEIER	CHECKED BY: G. EDWARDS
ROXBURY CROSS SECTIONS SHEET 34	
SHEET 225 OF 476	