

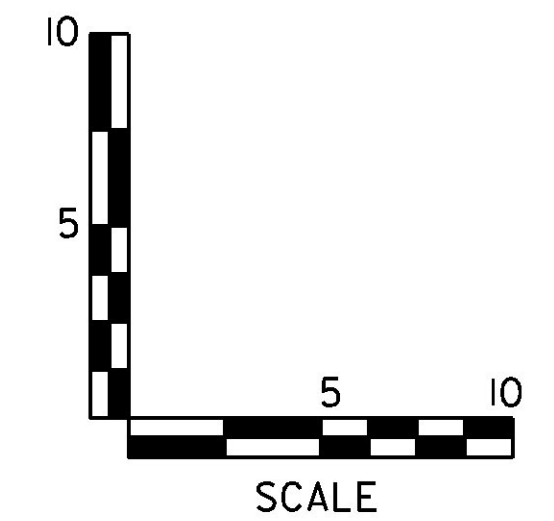


APPROXIMATE LOCATION OF EXISTING TELECOMMUNICATIONS BURIED CABLE. SEE LAYOUTS FOR LIMITS OF CABLE, TYPICAL.

STA. 123+00 TO STA. 124+50

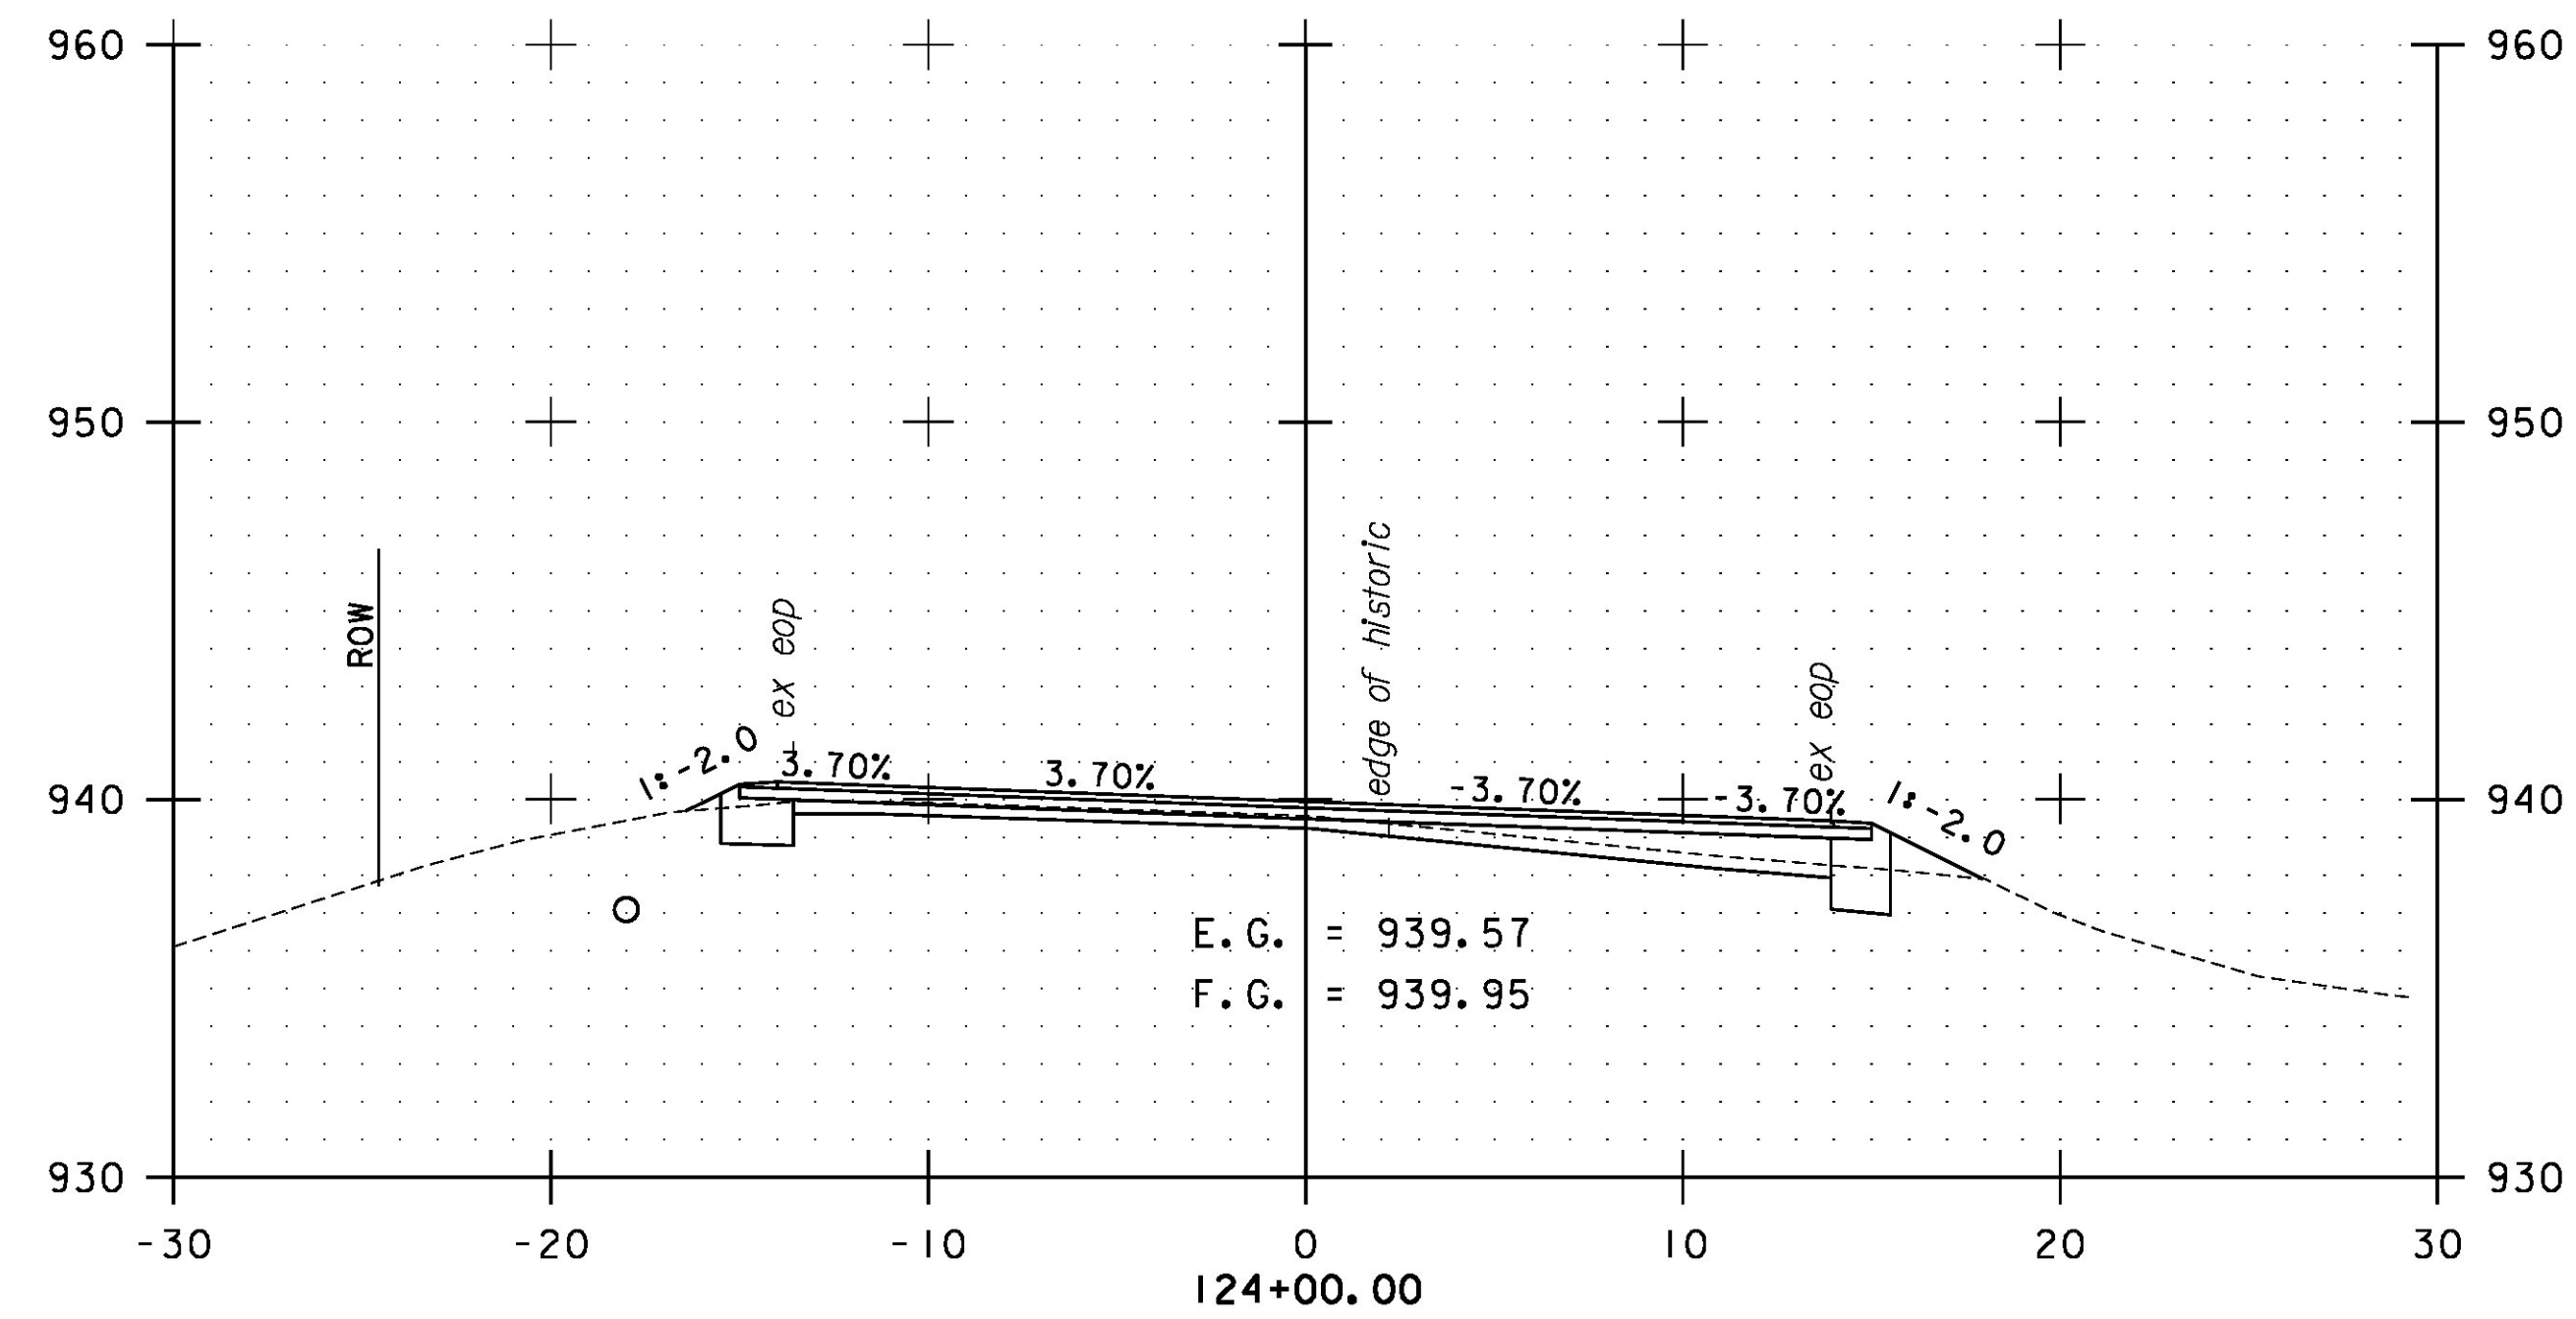

PROJECT NAME: ROXBURY-NORTHFIELD	
PROJECT NUMBER: ER STP 0187(13)	
FILE NAME: z13cl84xs.dgn	PLOT DATE: 5/25/2016
PROJECT LEADER: M. FOISY	DRAWN BY: G. BURGMEIER
DESIGNED BY: G. BURGMEIER	CHECKED BY: G. EDWARDS
<b>ROXBURY CROSS SECTIONS SHEET 41</b>	SHEET 232 OF 476

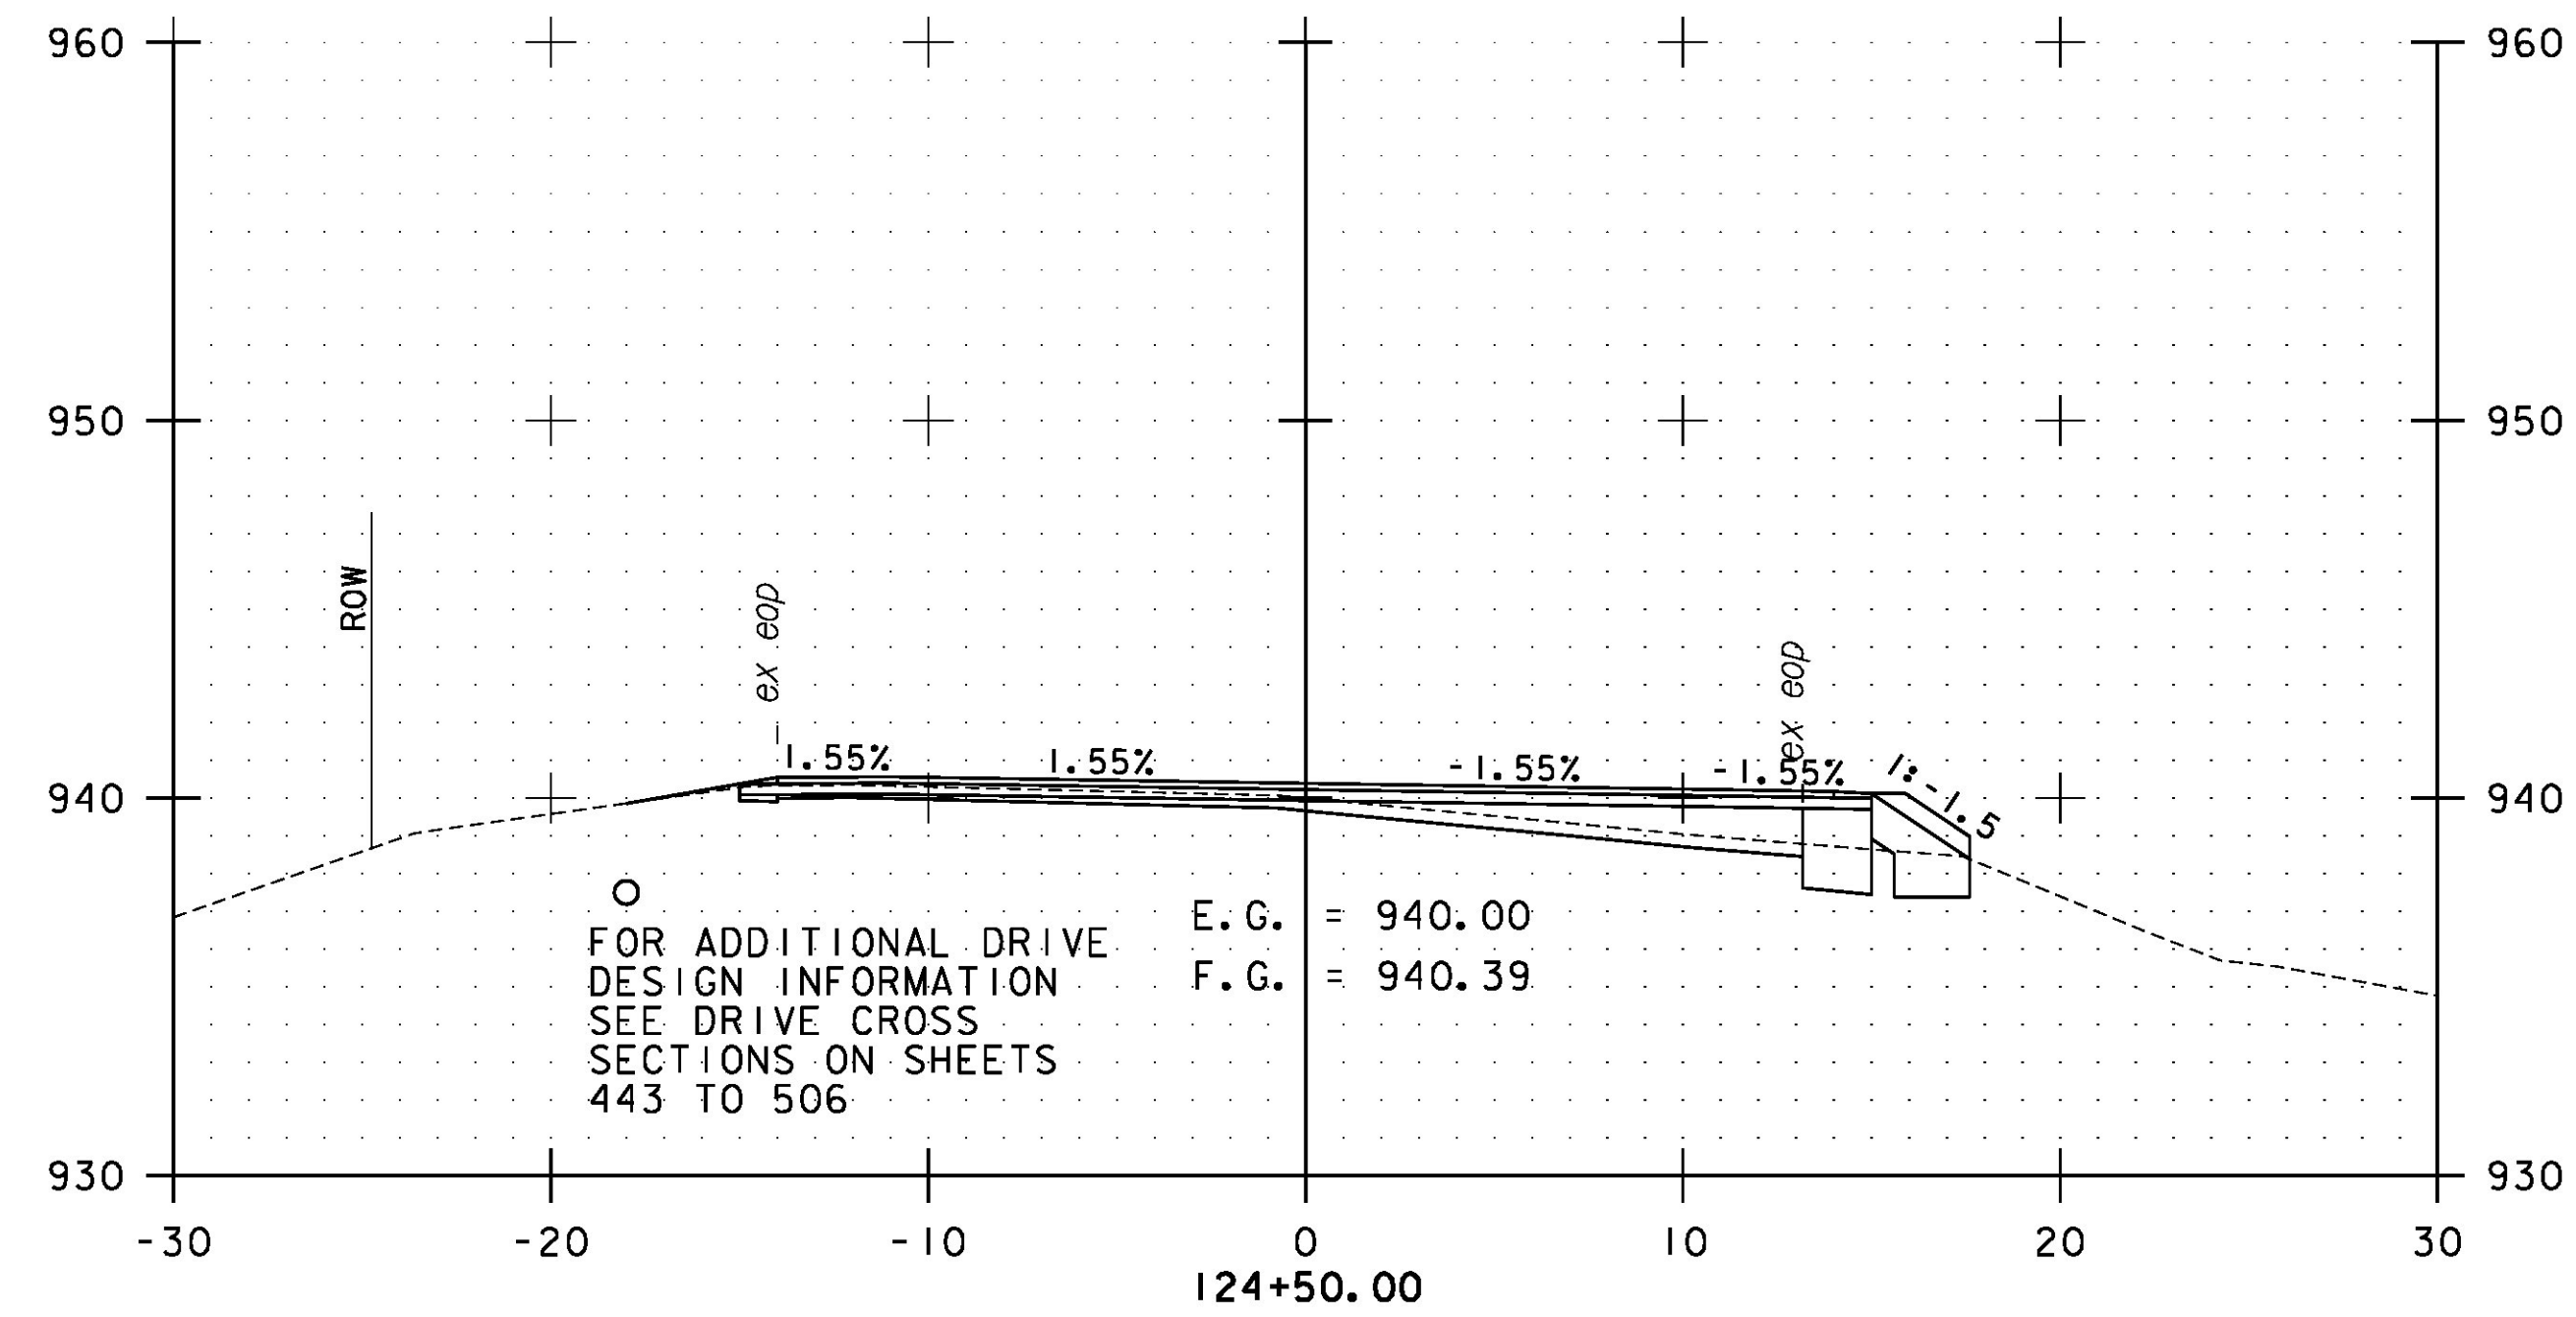