


APPROXIMATE LOCATION OF  
 EXISTING TELECOMMUNICATIONS  
 BURIED CABLE. SEE LAYOUTS  
 FOR LIMITS OF CABLE,  
 TYPICAL.

STA. 125+00 TO STA. 126+50

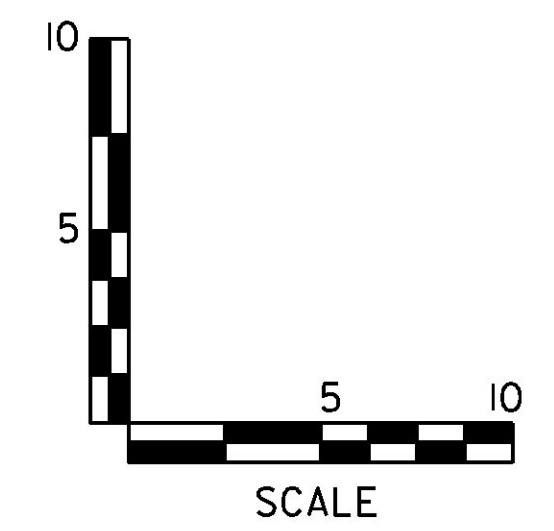

PROJECT NAME: ROXBURY-NORTHFIELD	
PROJECT NUMBER: ER STP 0187(13)	
FILE NAME: z13ci84xs.dgn	PLOT DATE: 5/25/2016
PROJECT LEADER: M. FOISY	DRAWN BY: G. BURGMEIER
DESIGNED BY: G. BURGMEIER	CHECKED BY: G. EDWARDS
<b>ROXBURY CROSS SECTIONS SHEET 42</b>	
SHEET 233 OF 476	