


APPROXIMATE LOCATION OF EXISTING TELECOMMUNICATIONS BURIED CABLE. SEE LAYOUTS FOR LIMITS OF CABLE, TYPICAL.



STA. 129+00 TO STA. 130+50

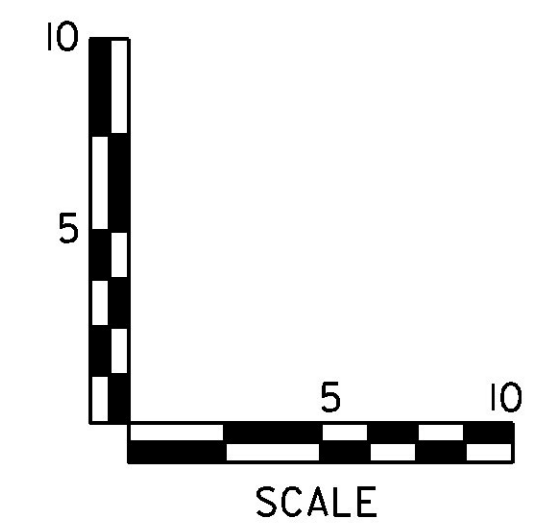

| | |
|--|------------------------|
| PROJECT NAME: ROXBURY-NORTHFIELD | |
| PROJECT NUMBER: ER STP 0187(13) | |
| FILE NAME: z13cl84xs.dgn | PLOT DATE: 5/25/2016 |
| PROJECT LEADER: M. FOISY | DRAWN BY: G. BURGMEIER |
| DESIGNED BY: G. BURGMEIER | CHECKED BY: G. EDWARDS |
| ROXBURY CROSS SECTIONS SHEET 44 | |
| SHEET 235 OF 476 | |