

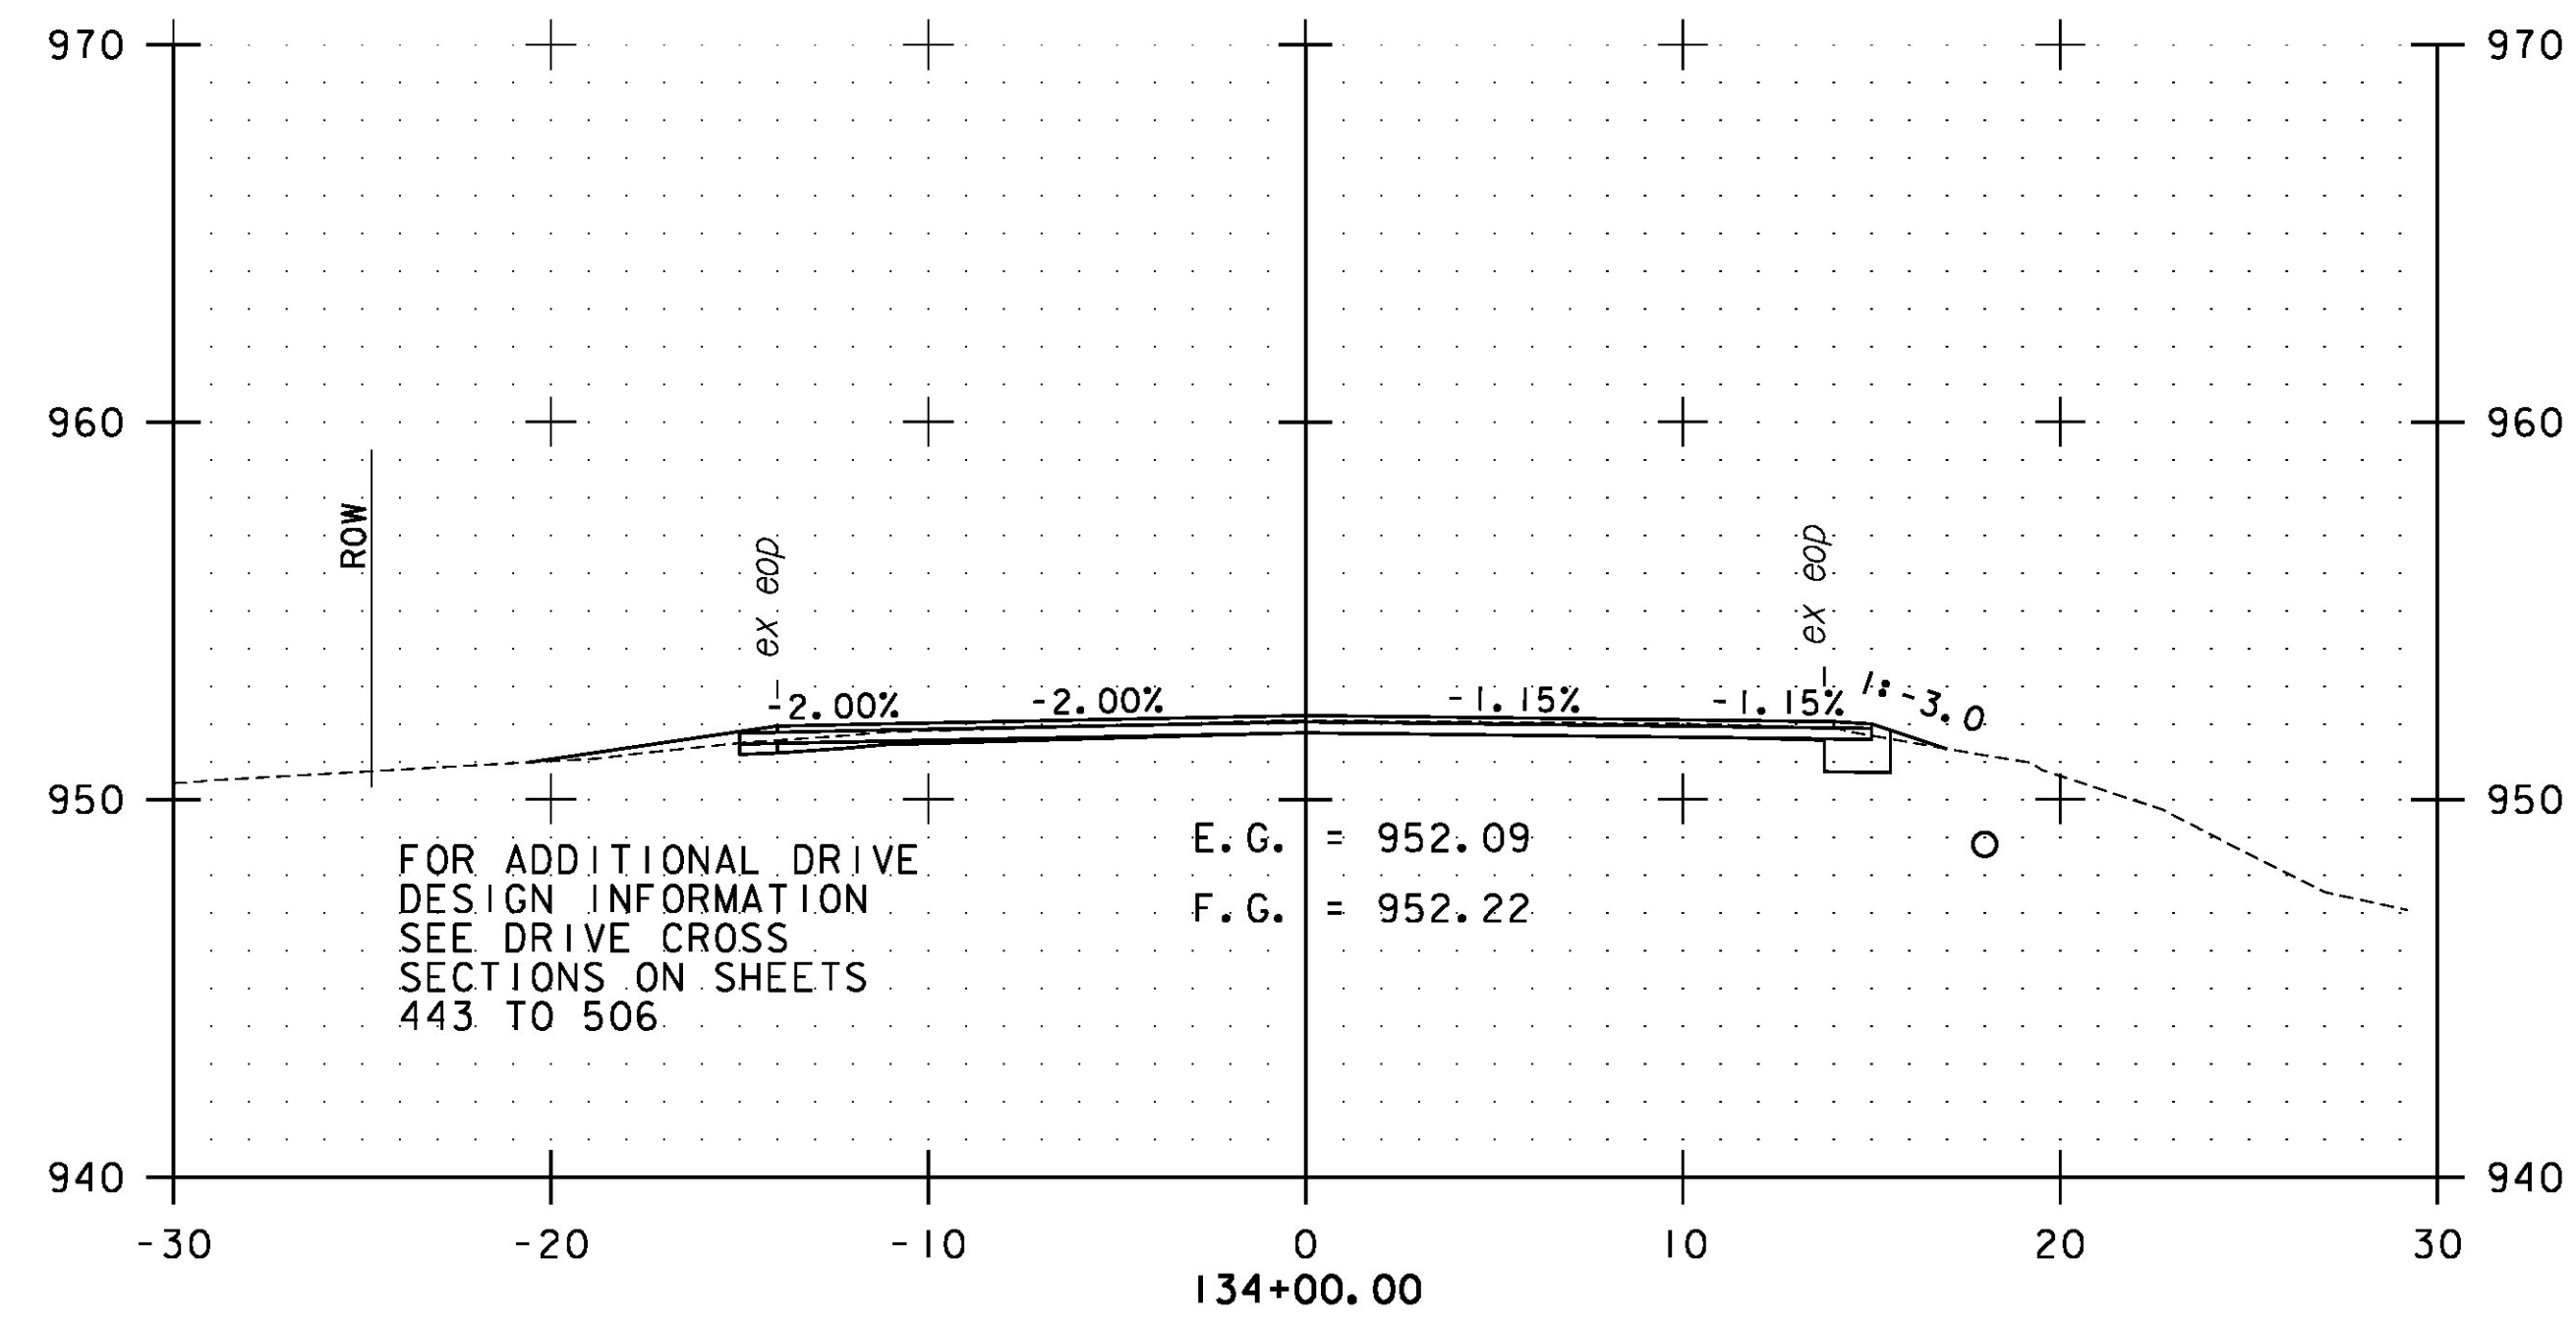


APPROXIMATE LOCATION OF EXISTING TELECOMMUNICATIONS BURIED CABLE. SEE LAYOUTS FOR LIMITS OF CABLE, TYPICAL.

STA. 133+00 TO STA. 134+50

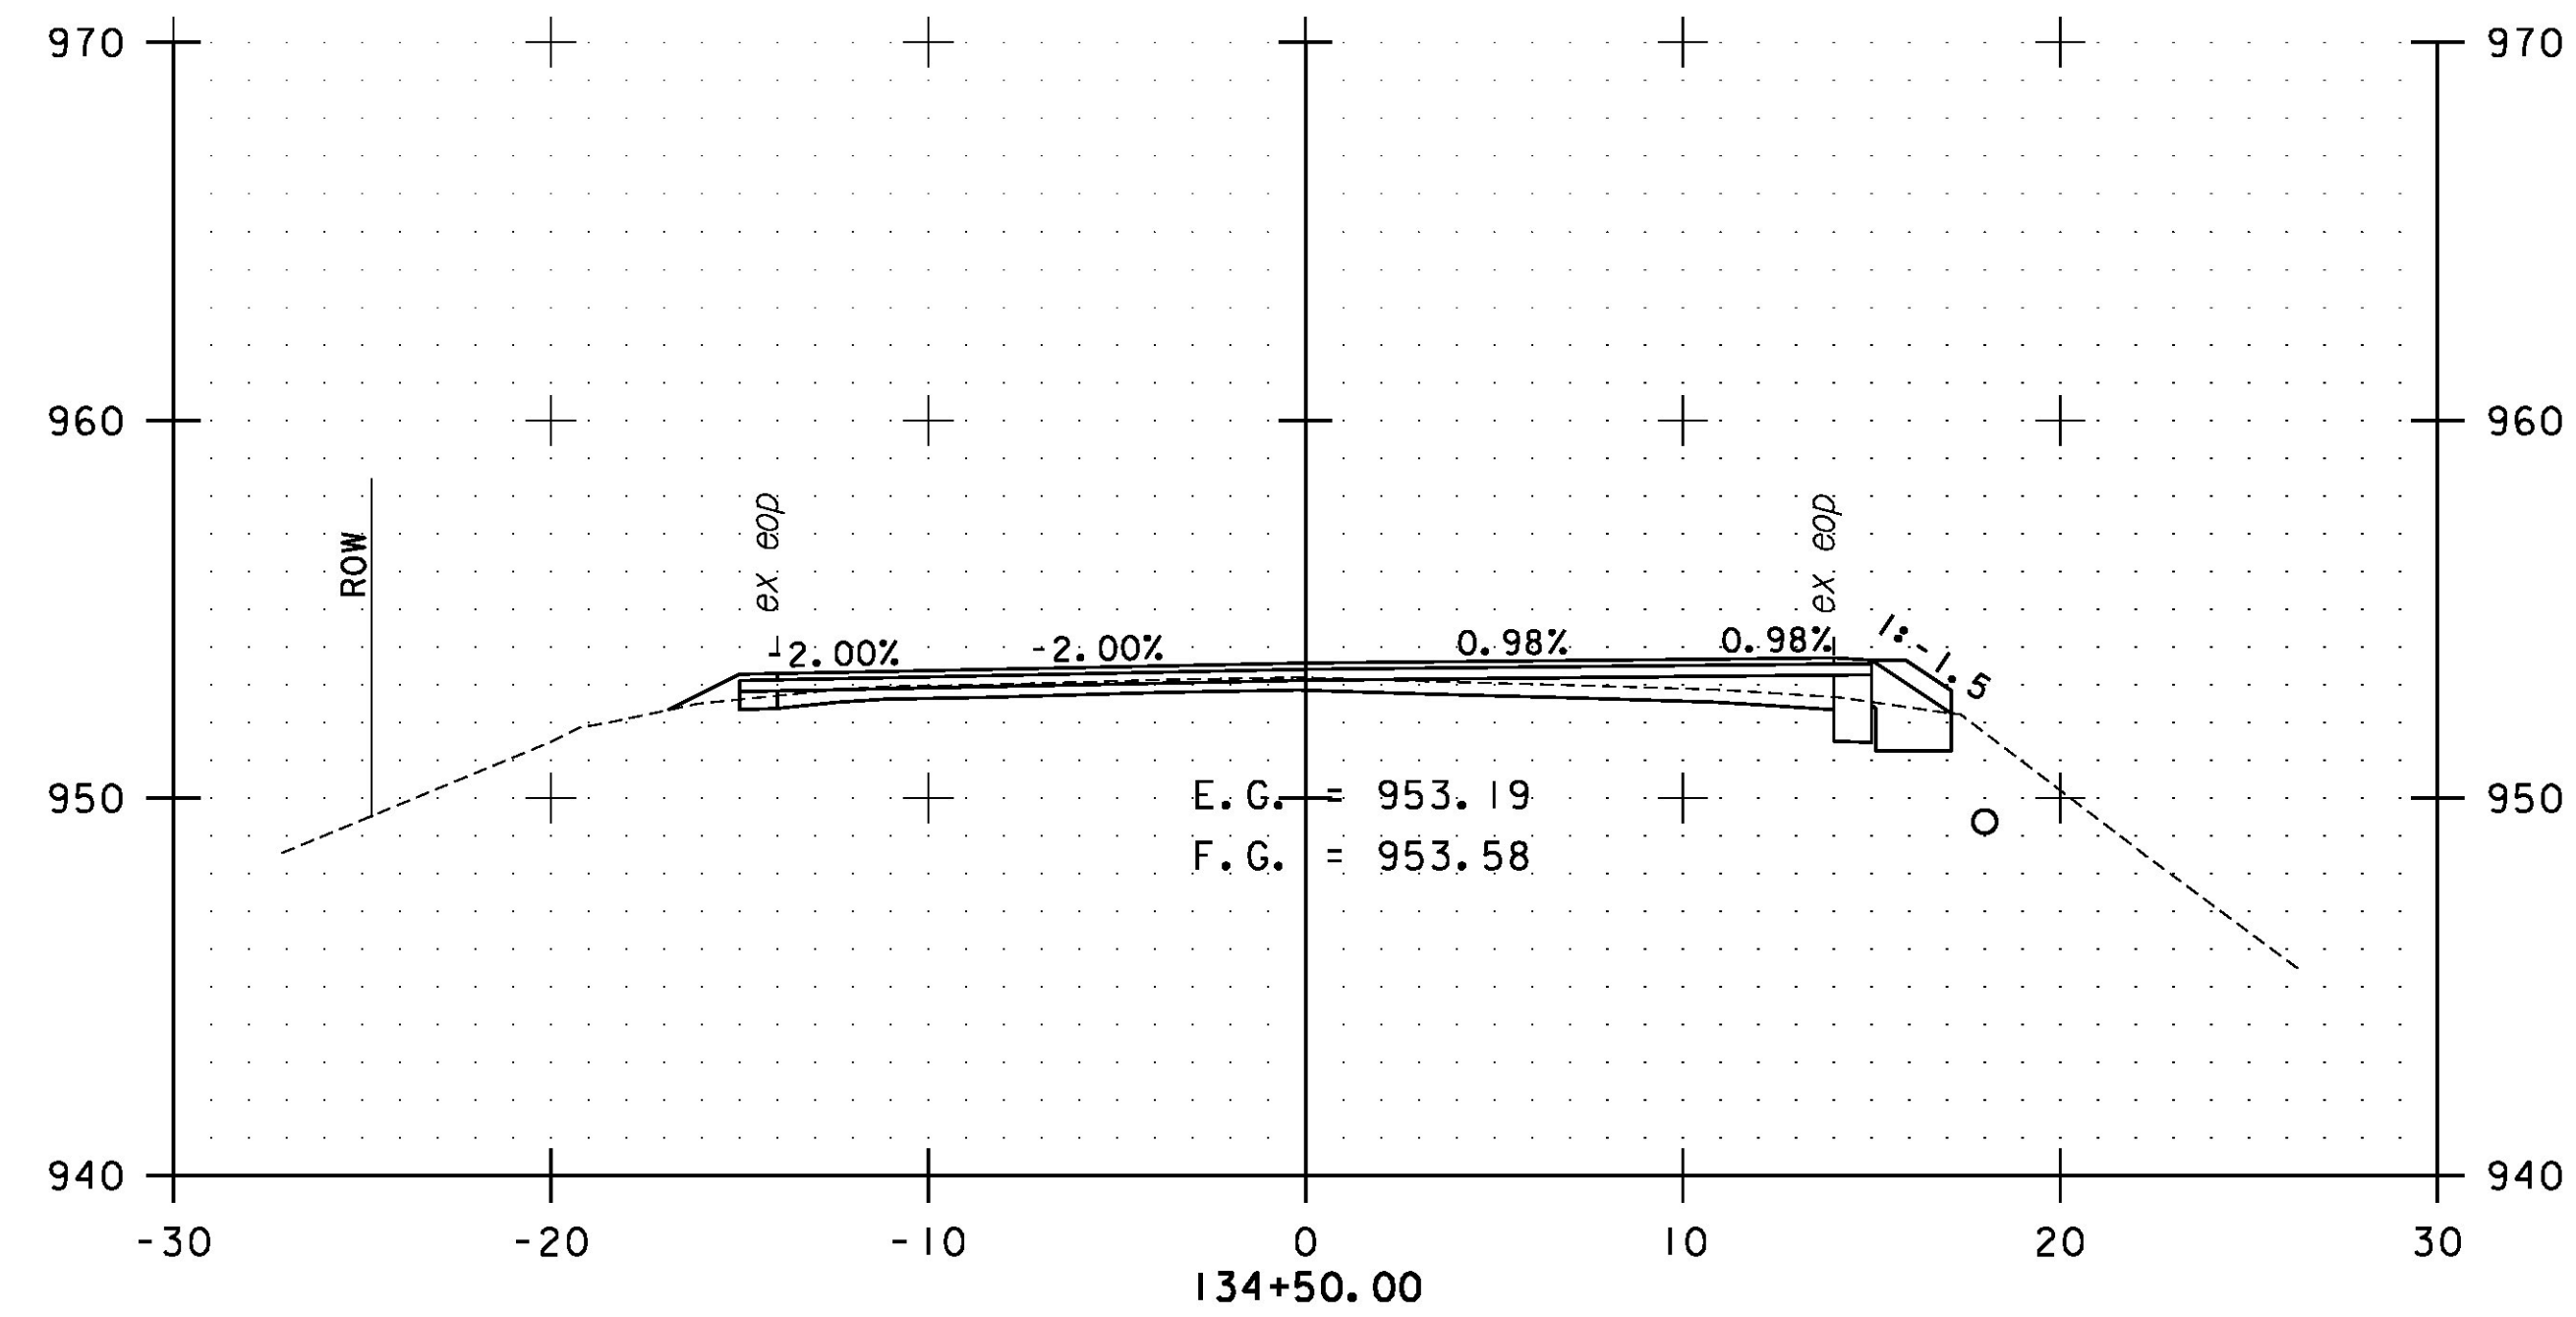

FOR ADDITIONAL DRIVE DESIGN INFORMATION SEE DRIVE CROSS SECTIONS ON SHEETS 443 TO 506.

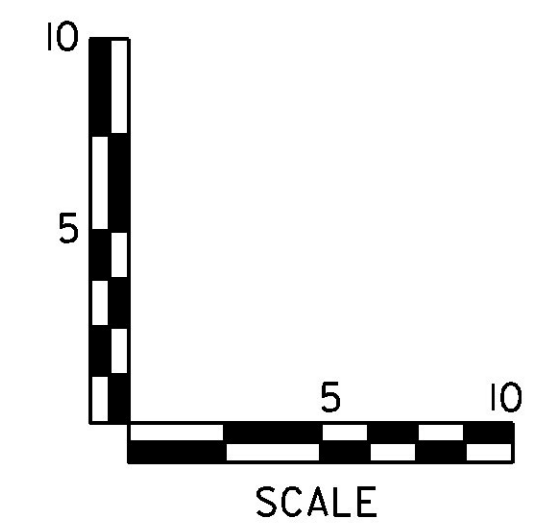

PROJECT NAME: ROXBURY-NORTHFIELD  
PROJECT NUMBER: ER STP 0187(13)

FILE NAME: z13ci84xs.dgn  
PROJECT LEADER: M. FOISY  
DESIGNED BY: G. BURGMEIER  
ROXBURY CROSS SECTIONS SHEET 46

PLOT DATE: 5/25/2016  
DRAWN BY: G. BURGMEIER  
CHECKED BY: G. EDWARDS  
SHEET 237 OF 476

