


STA. 164+00 TO STA. 165+50

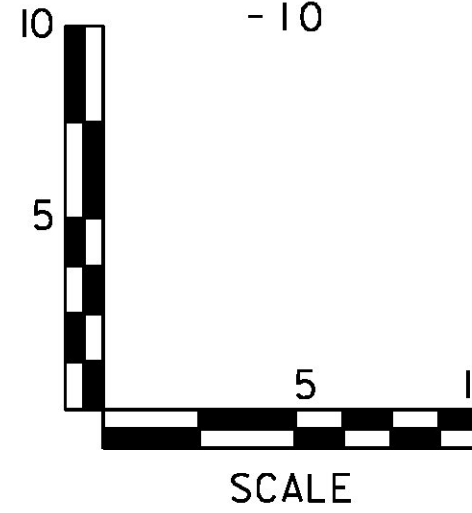

PROJECT NAME: ROXBURY-NORTHFIELD
PROJECT NUMBER: ER STP 0187(13)

FILE NAME: z13cl84xs.dgn
PROJECT LEADER: M. FOISY
DESIGNED BY: G. BURGMEIER
ROXBURY CROSS SECTIONS SHEET 61

PLOT DATE: 5/25/2016
DRAWN BY: G. BURGMEIER
CHECKED BY: G. EDWARDS
SHEET 252 OF 476