


STA. 223+50 TO STA. 225+00

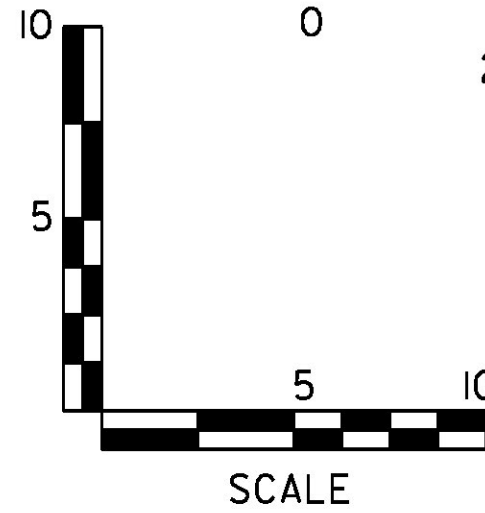

PROJECT NAME: ROXBURY-NORTHFIELD  
PROJECT NUMBER: ER STP 0187(13)

FILE NAME: z13ci84xs.dgn  
PROJECT LEADER: M. FOISY  
DESIGNED BY: G. BURGMEIER  
ROXBURY CROSS SECTIONS SHEET 90

PLOT DATE: 5/25/2016  
DRAWN BY: G. BURGMEIER  
CHECKED BY: G. EDWARDS  
SHEET 281 OF 476