
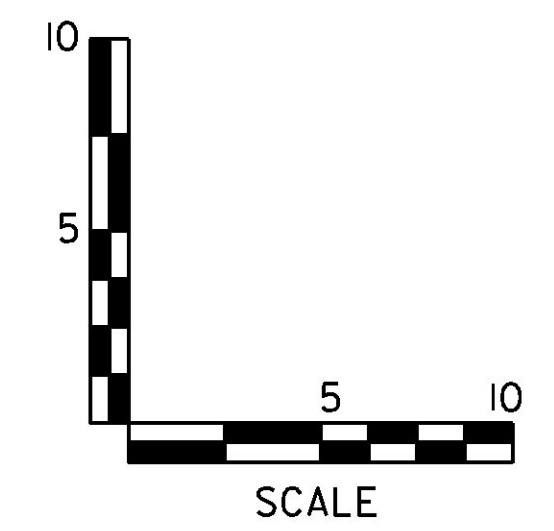


TRANSITION TO MATCH EXISTING SUPERELEVATION IN COLD PLANE AREA

**ROXBURY-NORTHFIELD ER STP 0187(13)**  
**ROXBURY STA. 262+00 (MM 4.962)**  
**END COLD PLANE**  
**BEGIN RECLAIM (SEGMENT 2)**

STA. 262+00 TO STA. 263+00

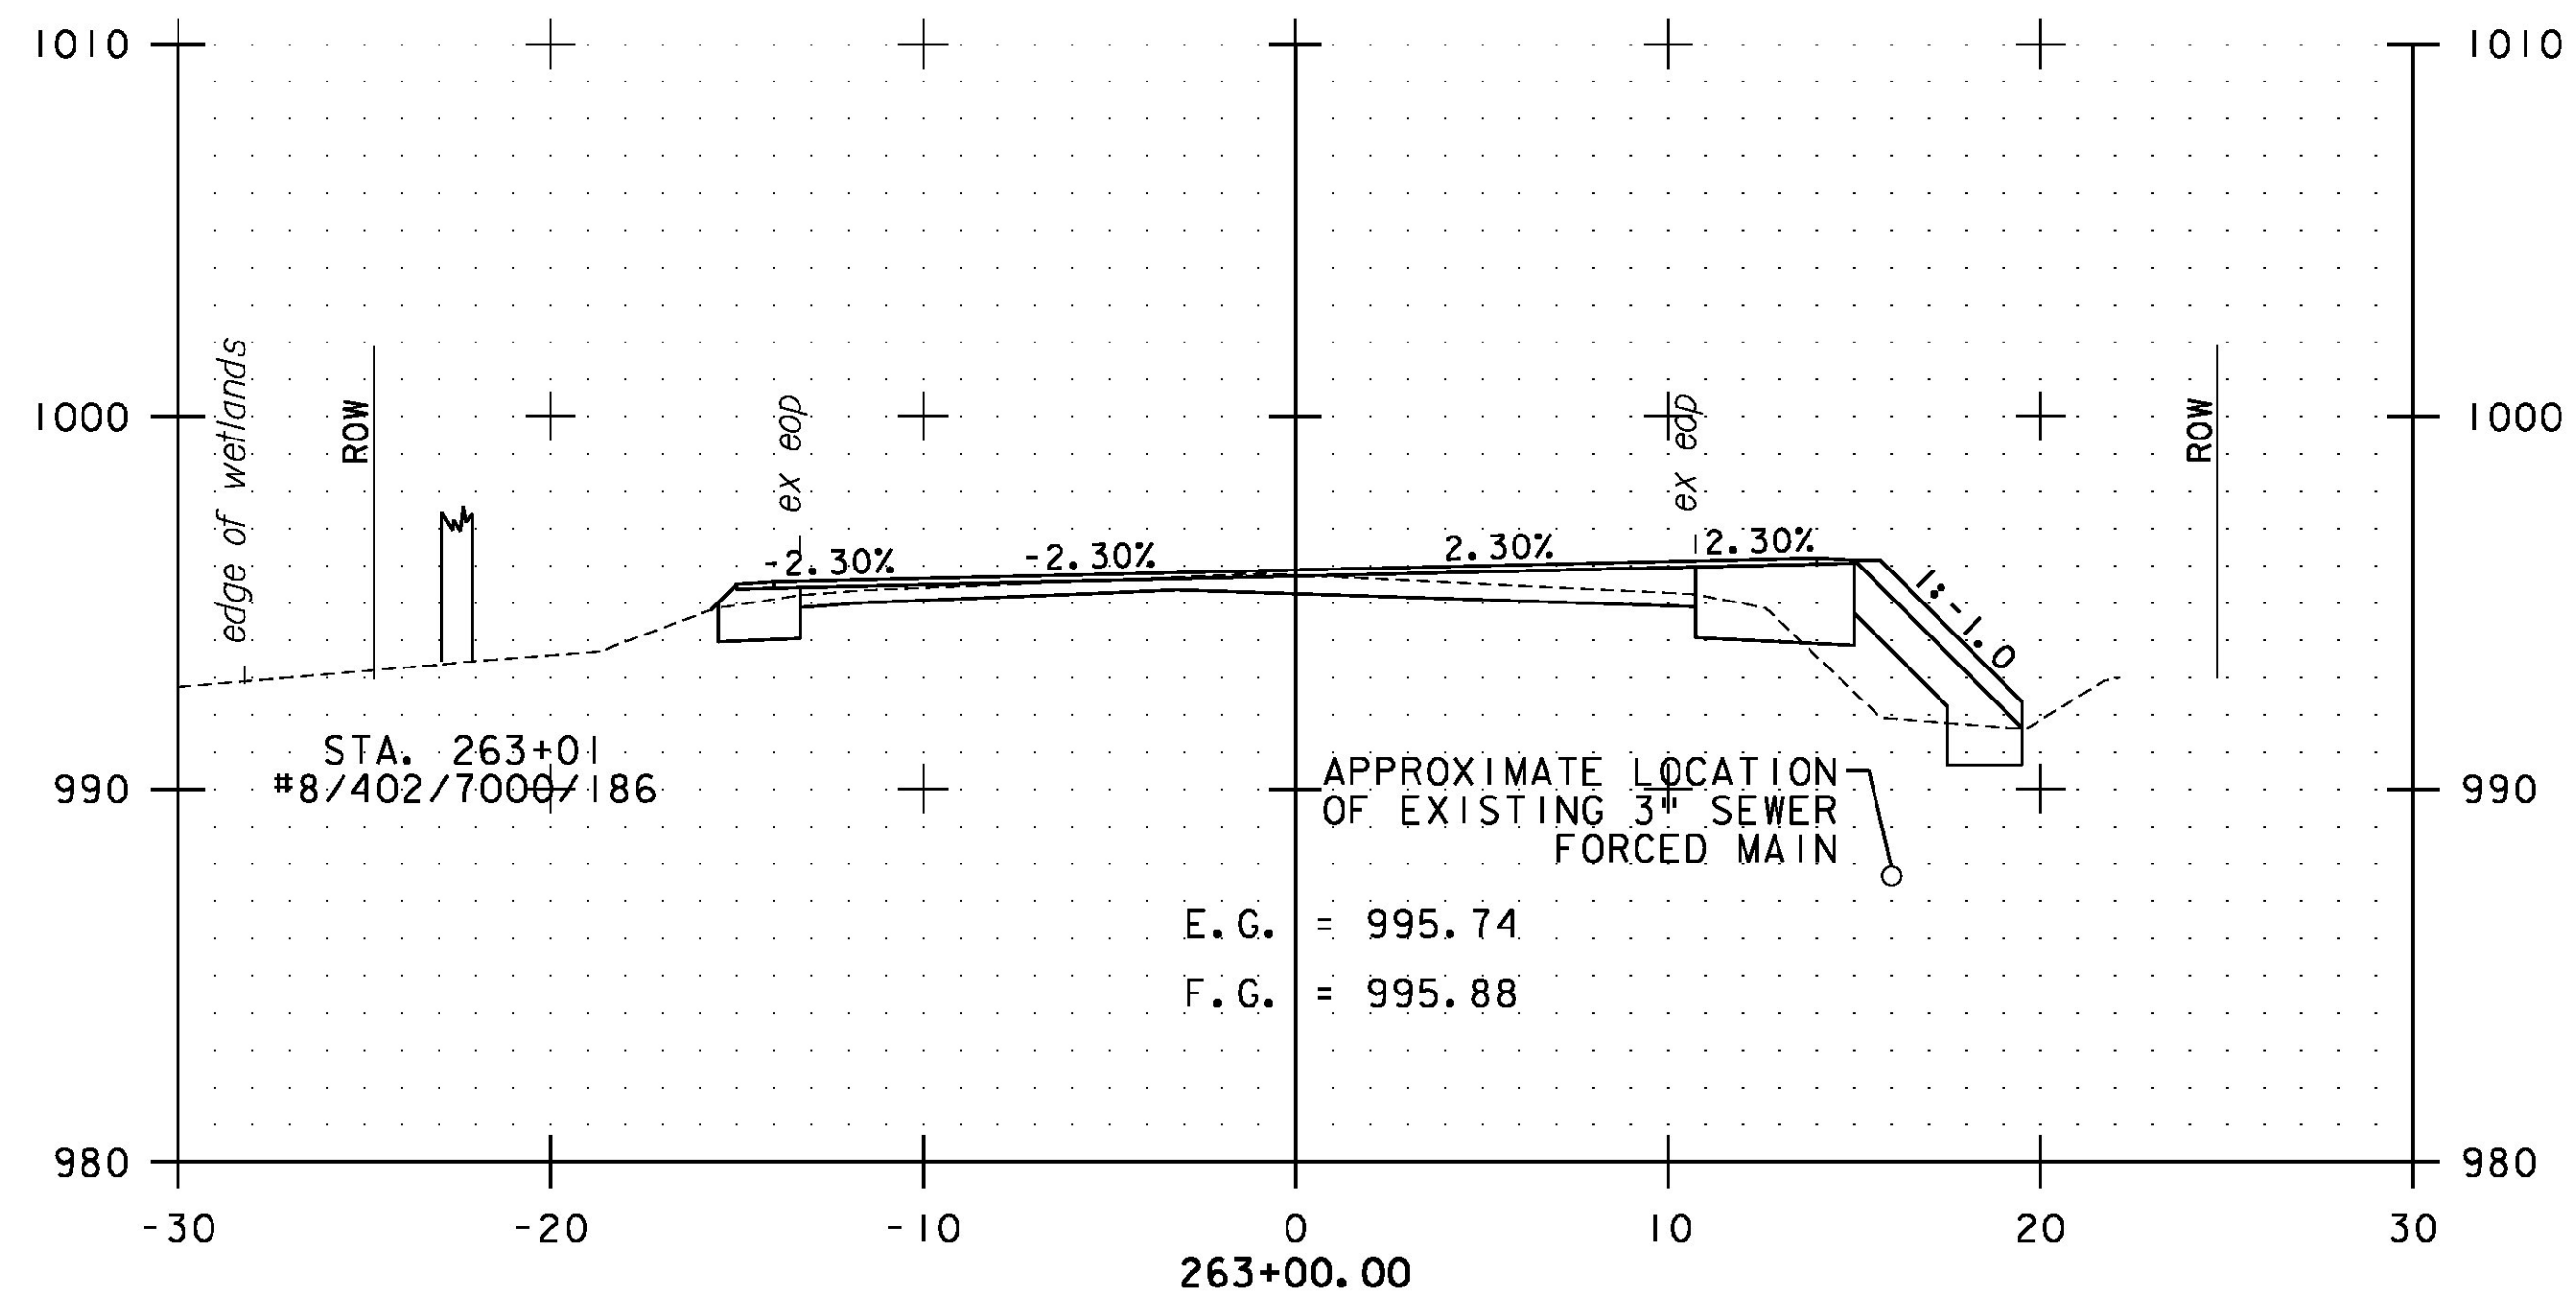

PROJECT NAME:	ROXBURY-NORTHFIELD
PROJECT NUMBER:	ER STP 0187(13)
FILE NAME:	z13cl84xs.dgn
PROJECT LEADER:	M. FOISY
DESIGNED BY:	G. BURGMEIER
<b>ROXBURY CROSS SECTIONS SHEET 94</b>	
PLOT DATE:	5/25/2016
DRAWN BY:	G. BURGMEIER
CHECKED BY:	G. EDWARDS
SHEET 285 OF 476	

