






APPROXIMATE LOCATION  
OF EXISTING 3" SEWER  
FORCED MAIN

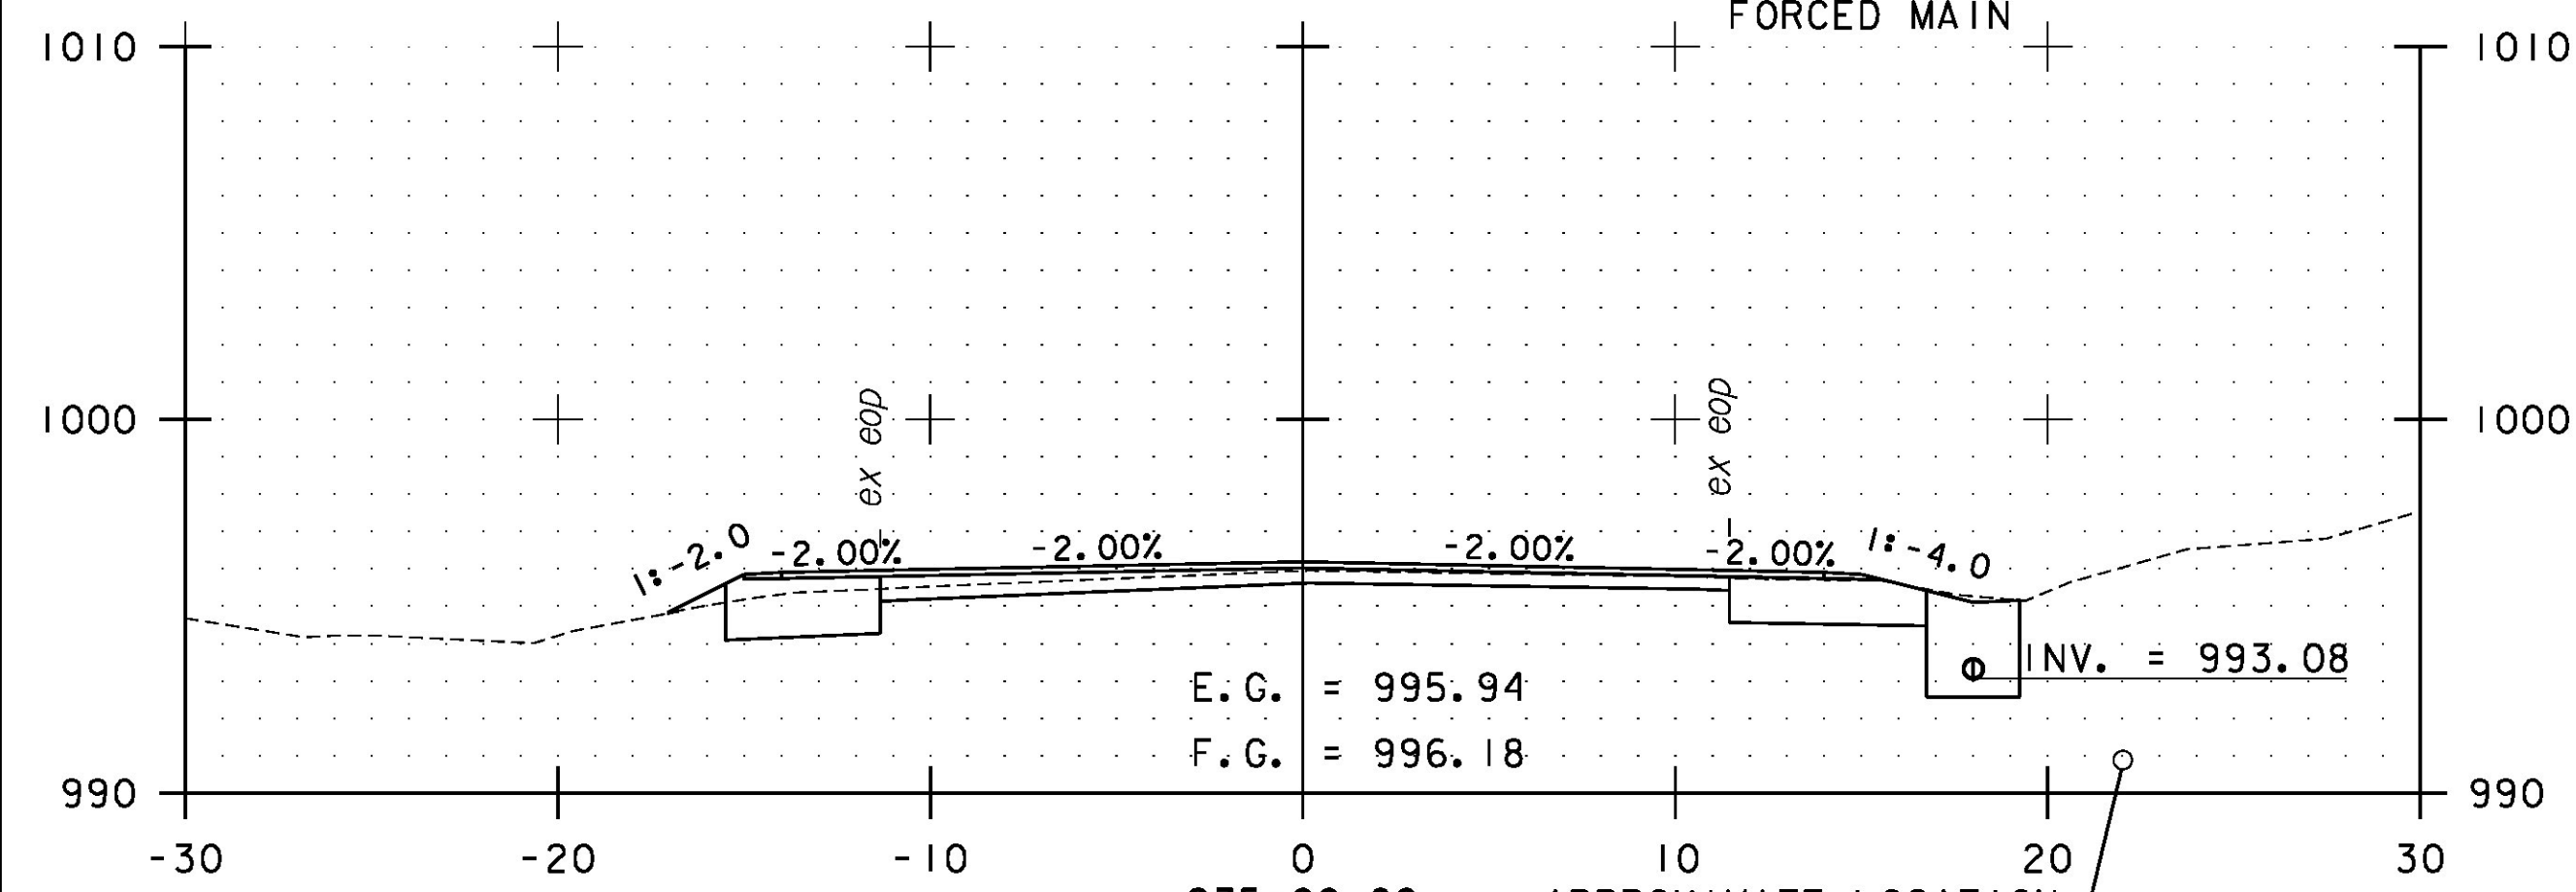

APPROXIMATE LOCATION  
OF EXISTING 3" SEWER  
FORCED MAIN

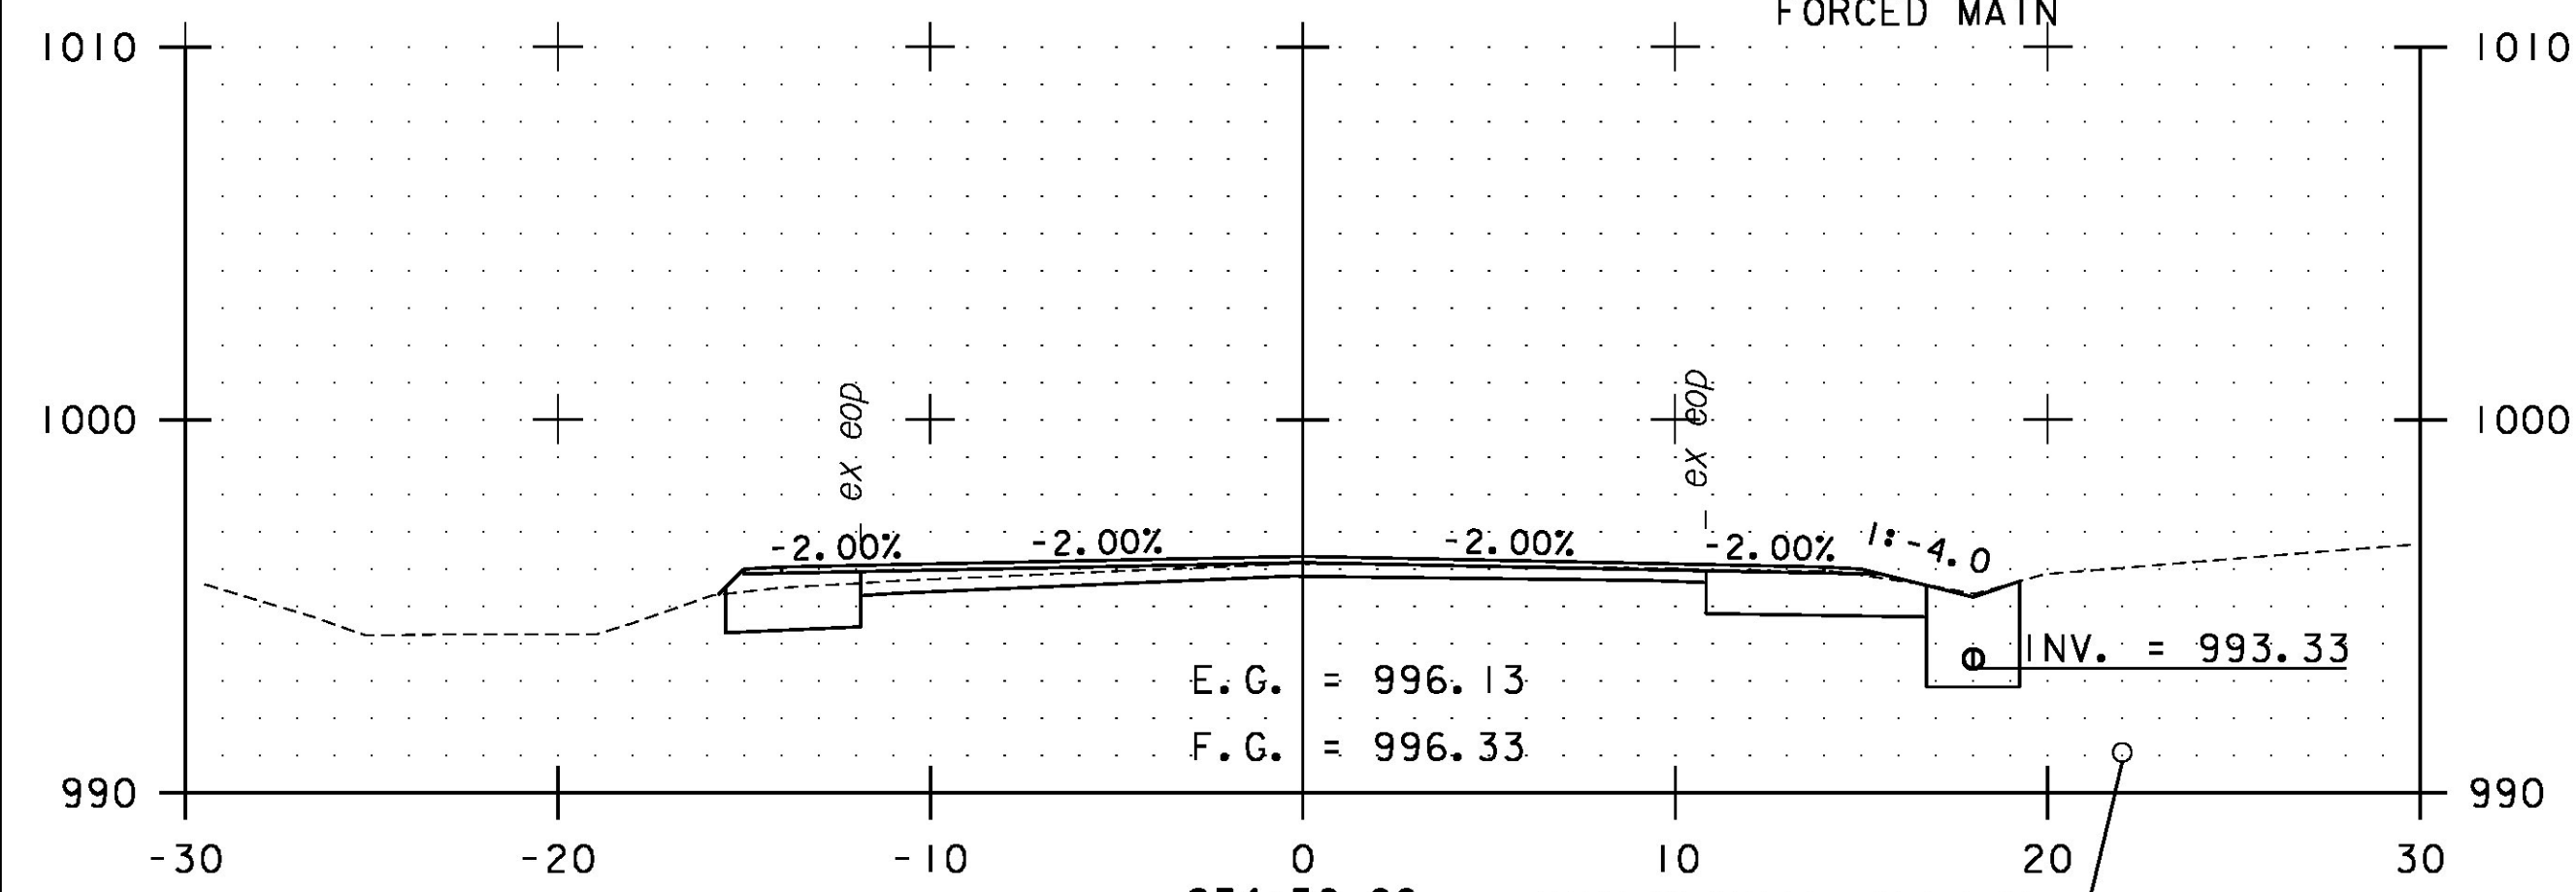

APPROXIMATE LOCATION  
OF EXISTING 3" SEWER  
FORCED MAIN

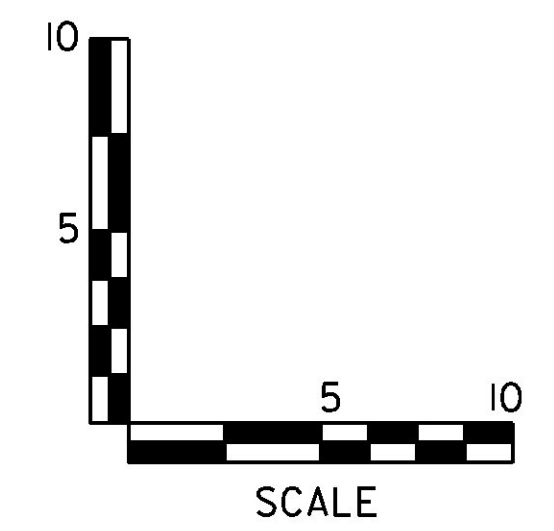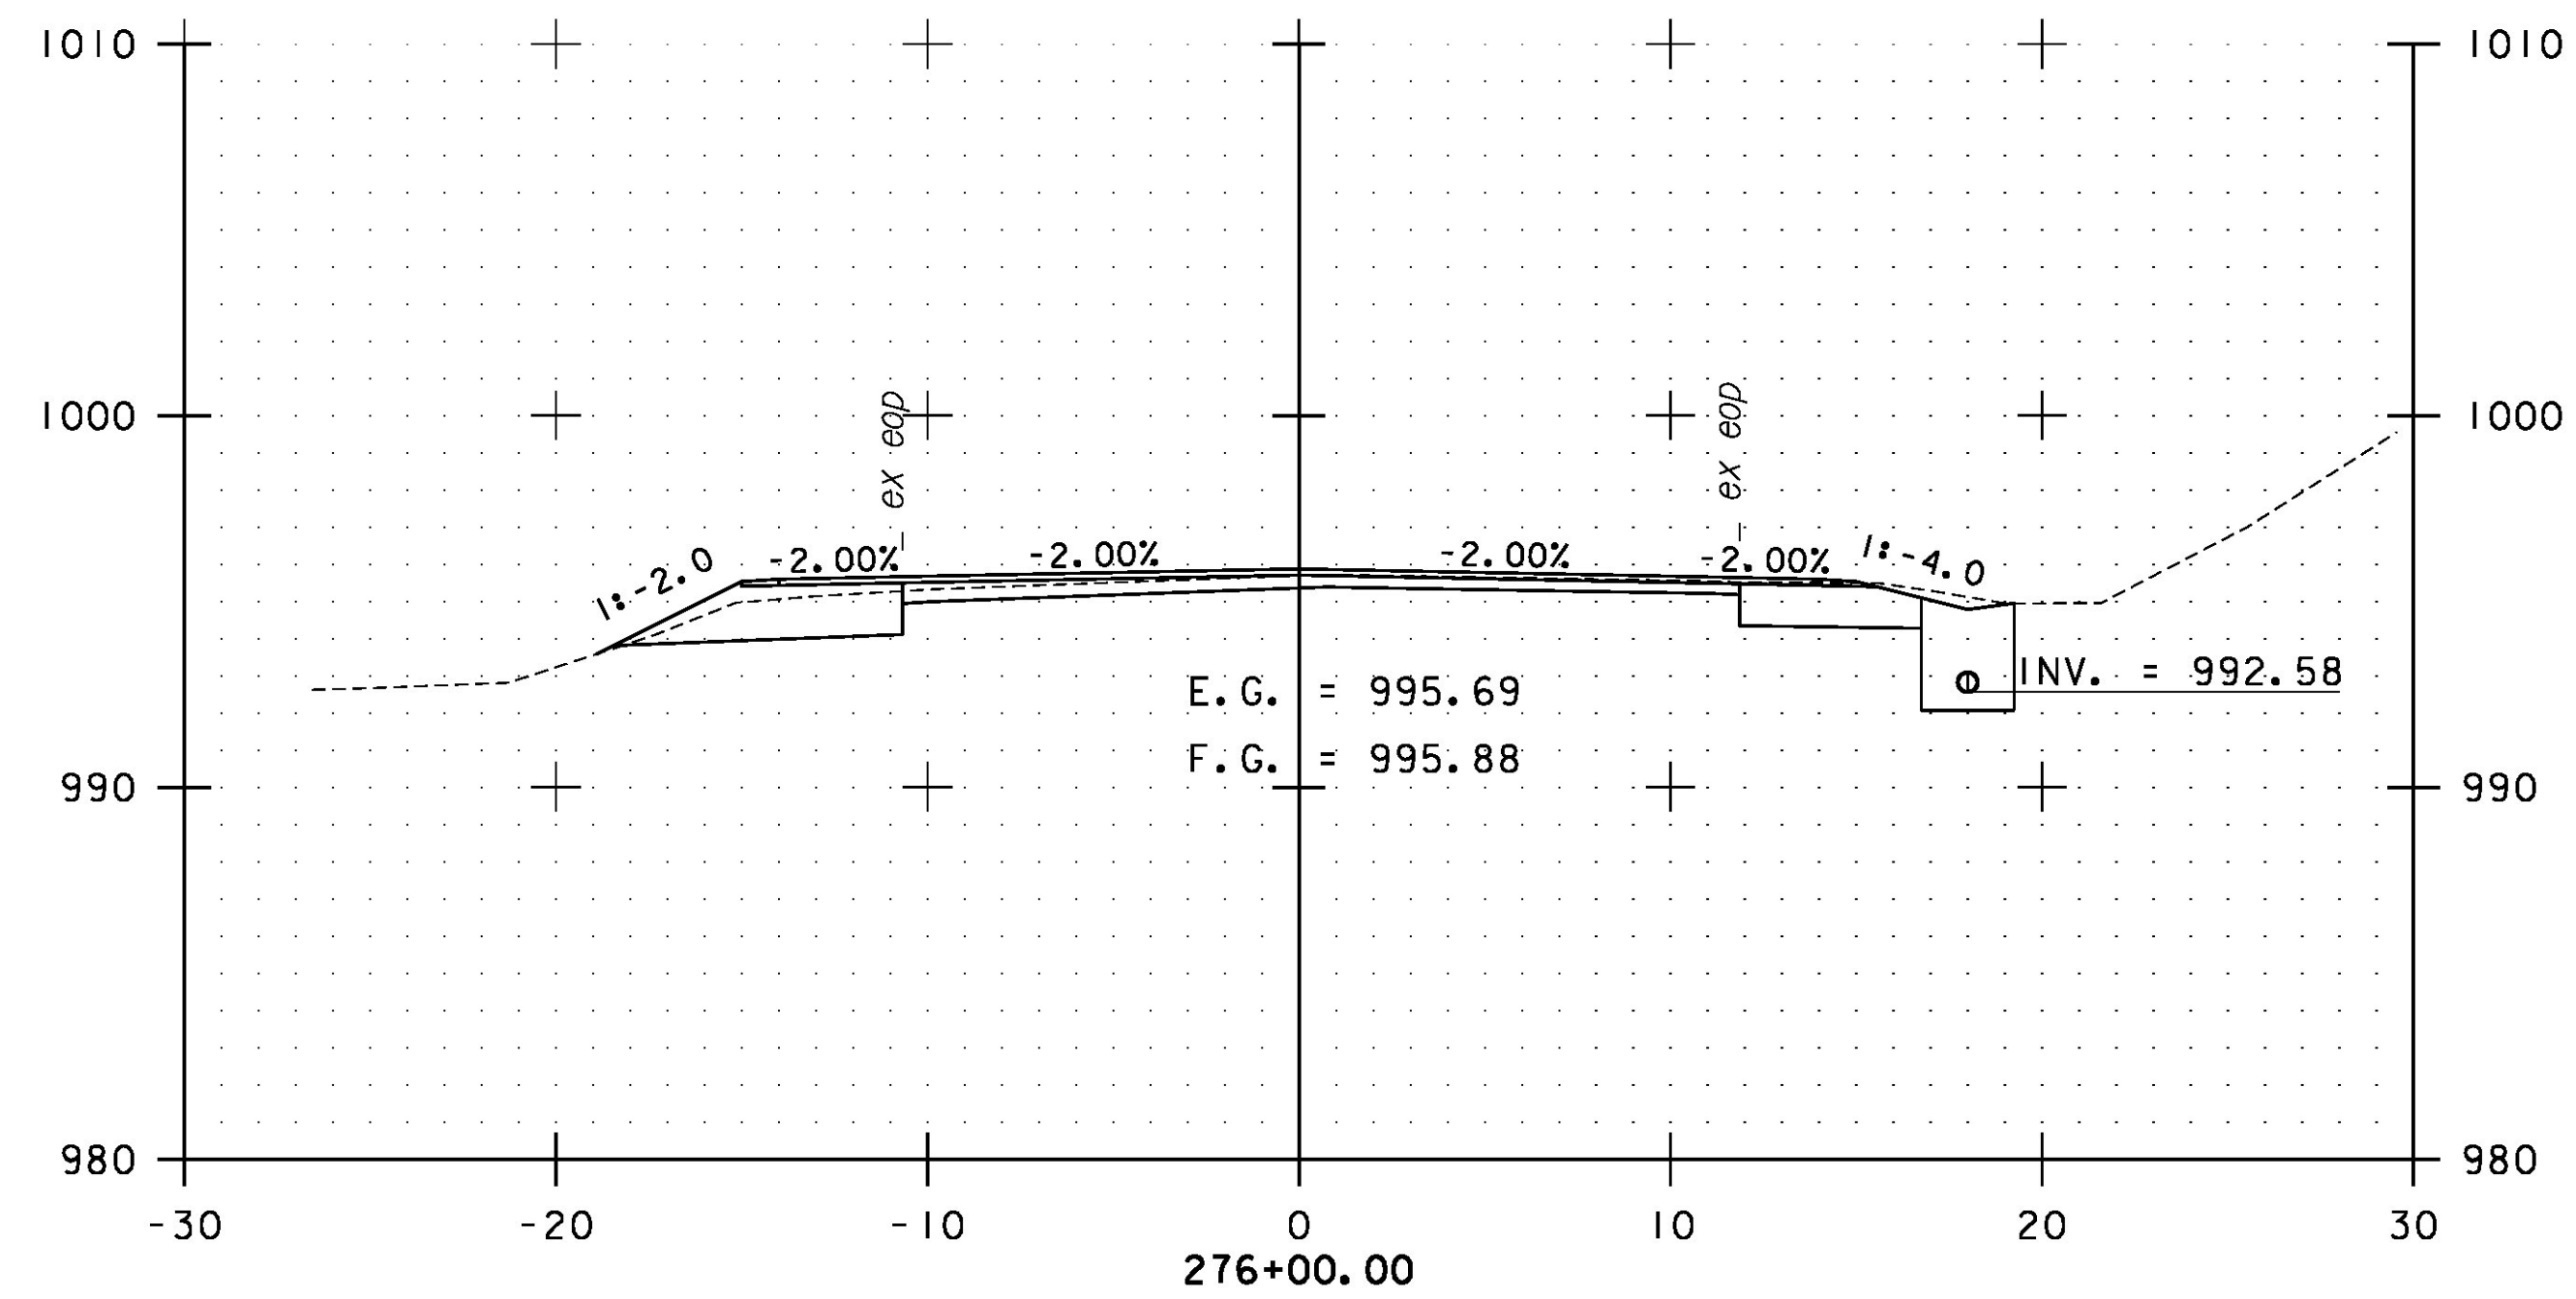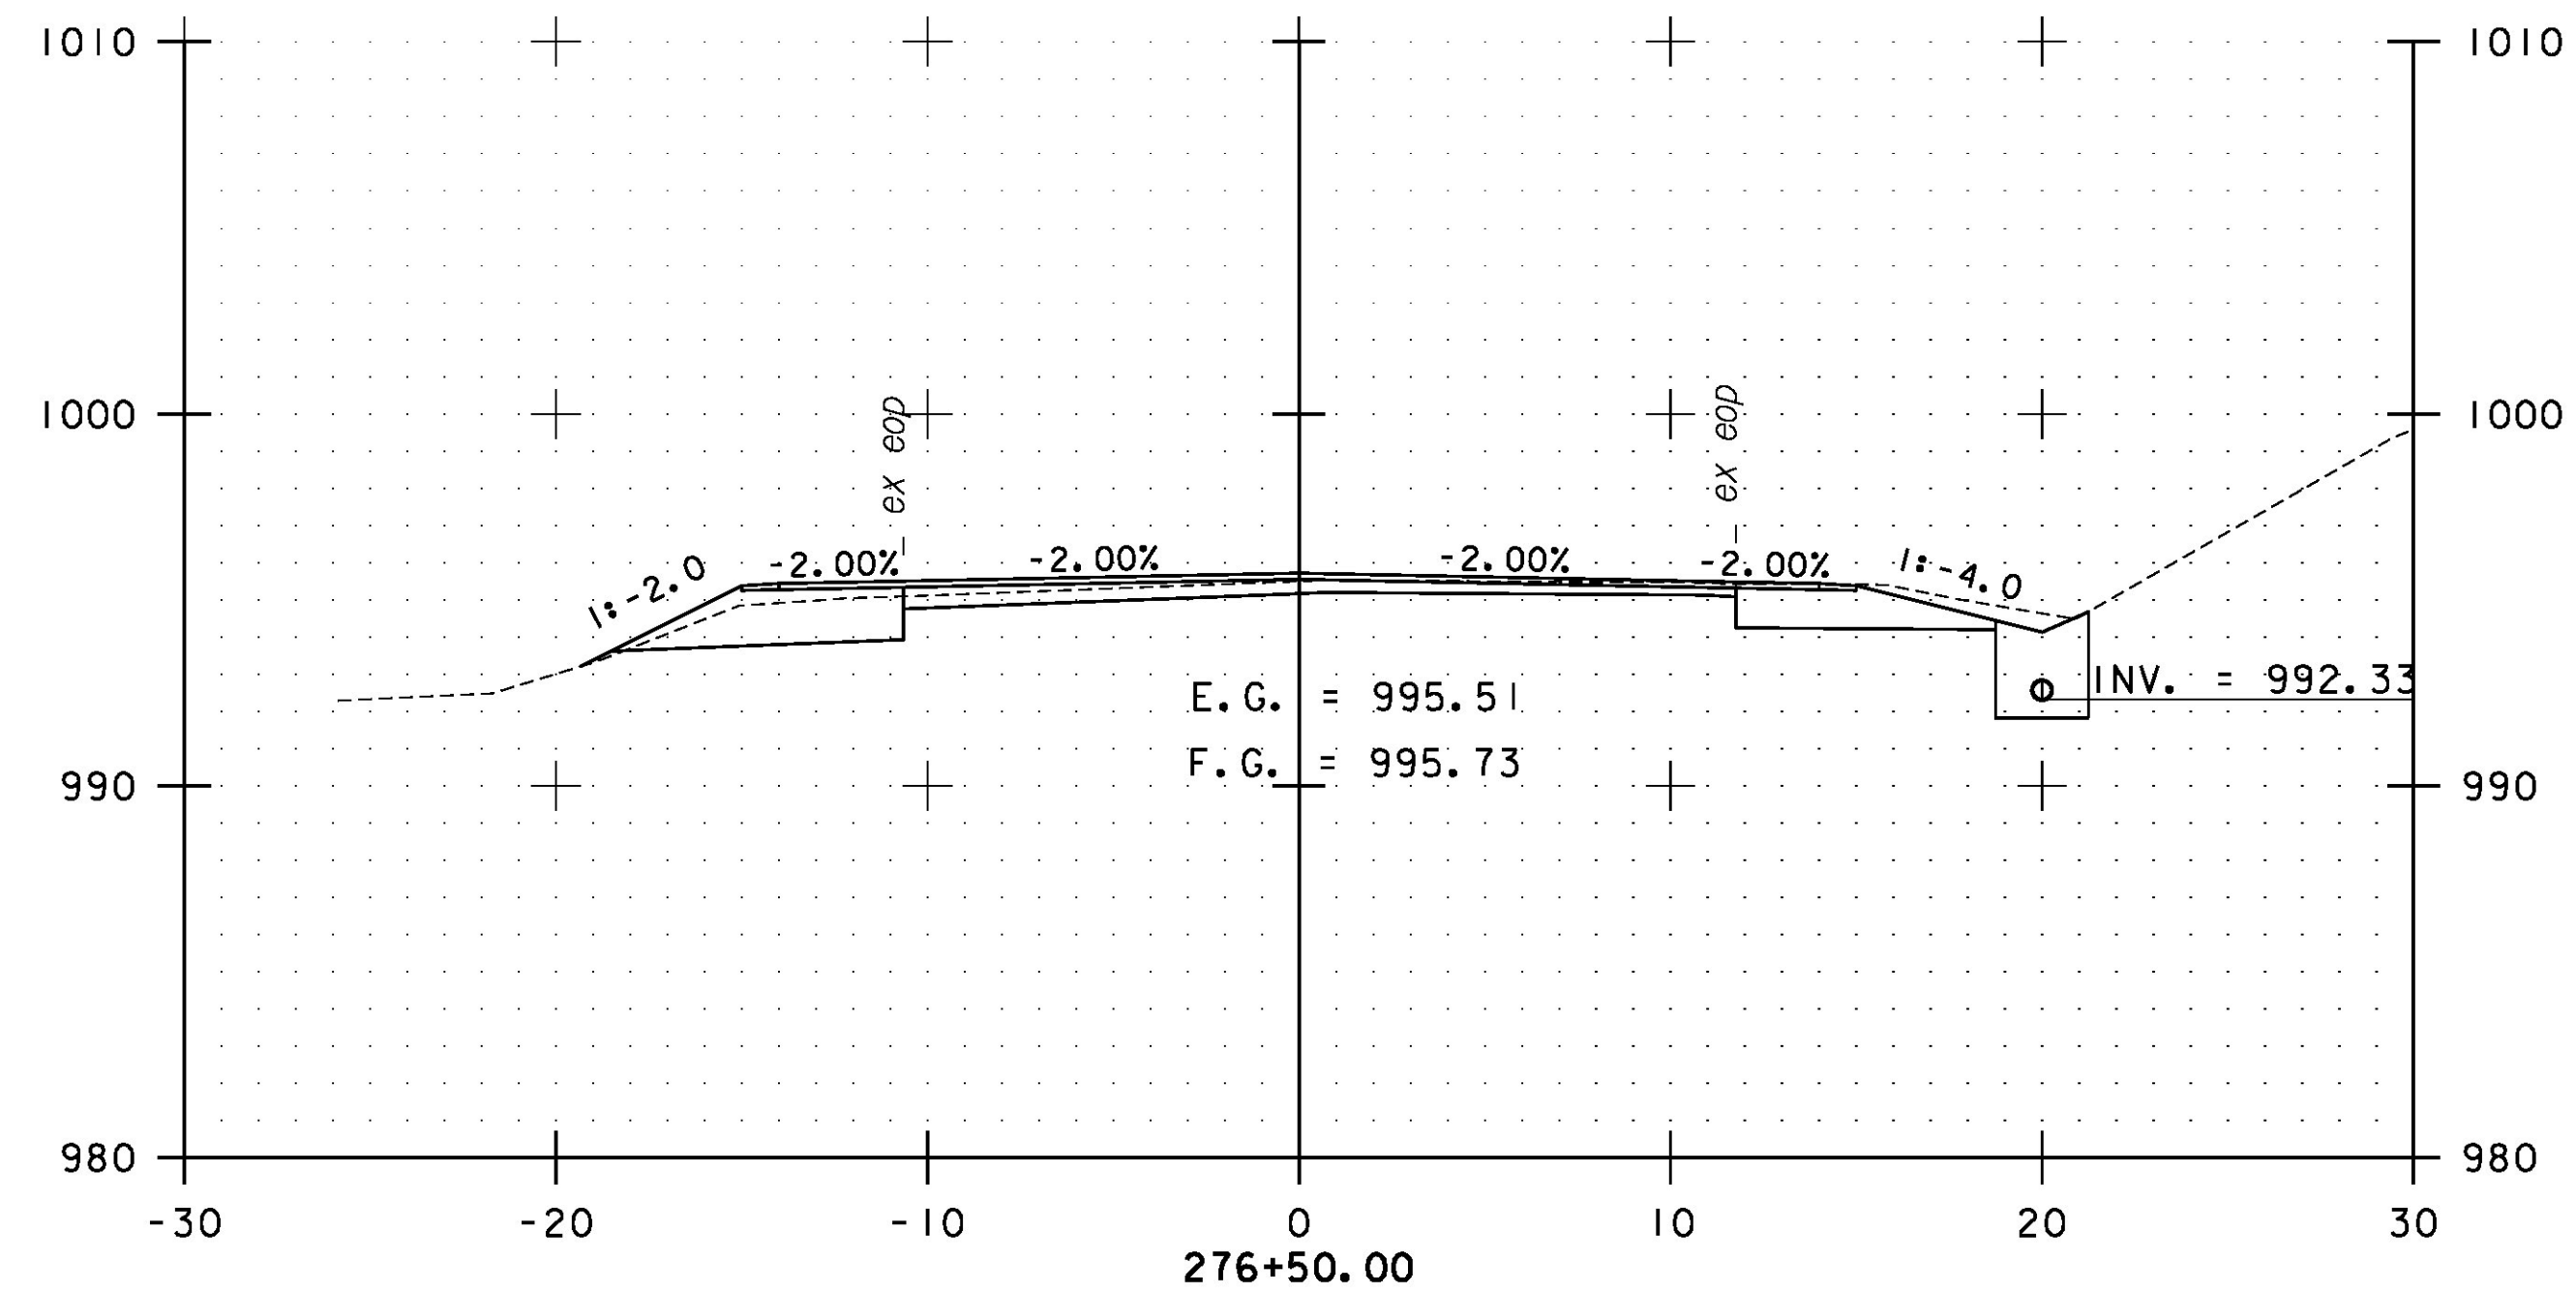

STA. 274+50 TO STA. 276+50



PROJECT NAME: ROXBURY-NORTHFIELD	
PROJECT NUMBER: ER STP 0187(13)	
FILE NAME: z13cl84xs.dgn	PLOT DATE: 5/25/2016
PROJECT LEADER: M. FOISY	DRAWN BY: G. BURGMEIER
DESIGNED BY: G. BURGMEIER	CHECKED BY: G. EDWARDS
<b>ROXBURY CROSS SECTIONS SHEET 100</b>	
SHEET 291 OF 476	