


STA. 279+00 TO STA. 281+00

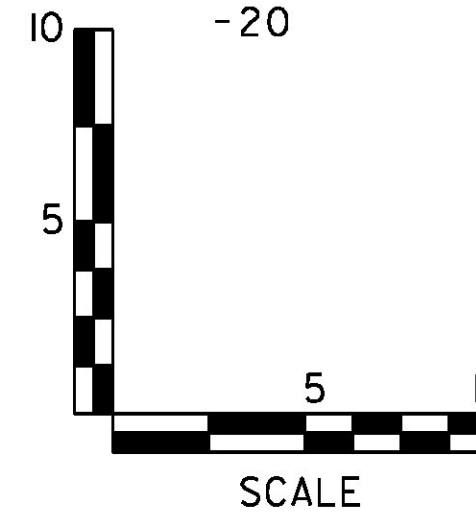

PROJECT NAME: ROXBURY-NORTHFIELD
 PROJECT NUMBER: ER STP 0187(13)

FILE NAME: z13cl84xs.dgn
 PROJECT LEADER: M. FOISY
 DESIGNED BY: G. BURGMEIER
 ROXBURY CROSS SECTIONS SHEET 102

PLOT DATE: 6/13/2016
 DRAWN BY: G. BURGMEIER
 CHECKED BY: G. EDWARDS
 SHEET 293 OF 476