


STA. 317+38  
 #151  
 FOR ADDITIONAL DRIVE  
 DESIGN INFORMATION  
 SEE DRIVE CROSS  
 SECTIONS ON SHEETS  
 443 TO 506



STA. 316+00 TO STA. 317+50

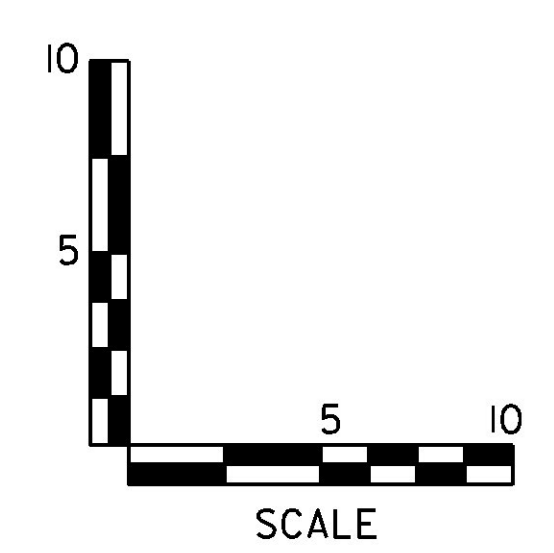

PROJECT NAME: ROXBURY-NORTHFIELD	
PROJECT NUMBER: ER STP 0187(13)	
FILE NAME: z13cl84xs.dgn	PLOT DATE: 5/25/2016
PROJECT LEADER: M. FOISY	DRAWN BY: G. BURGMEIER
DESIGNED BY: G. BURGMEIER	CHECKED BY: G. EDWARDS
<b>ROXBURY CROSS SECTIONS SHEET 120</b>	
SHEET 311 OF 476	