

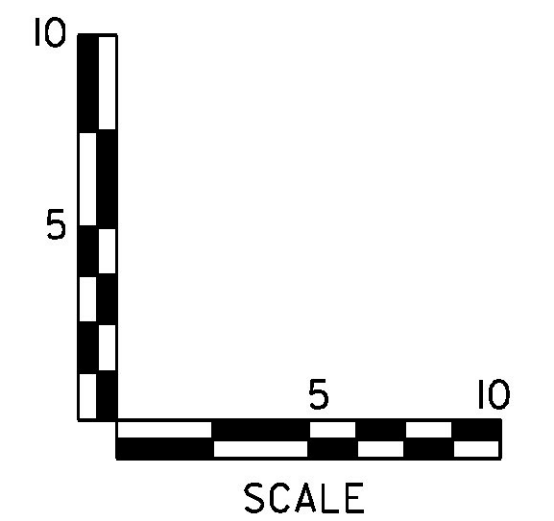


**ROXBURY-NORTHFIELD ER STP 0187(13)**  
**NORTHFIELD STA. 22+32.0**  
**END COLD PLANE**  
**RESUME RECLAIM (SEGMENT 2)**

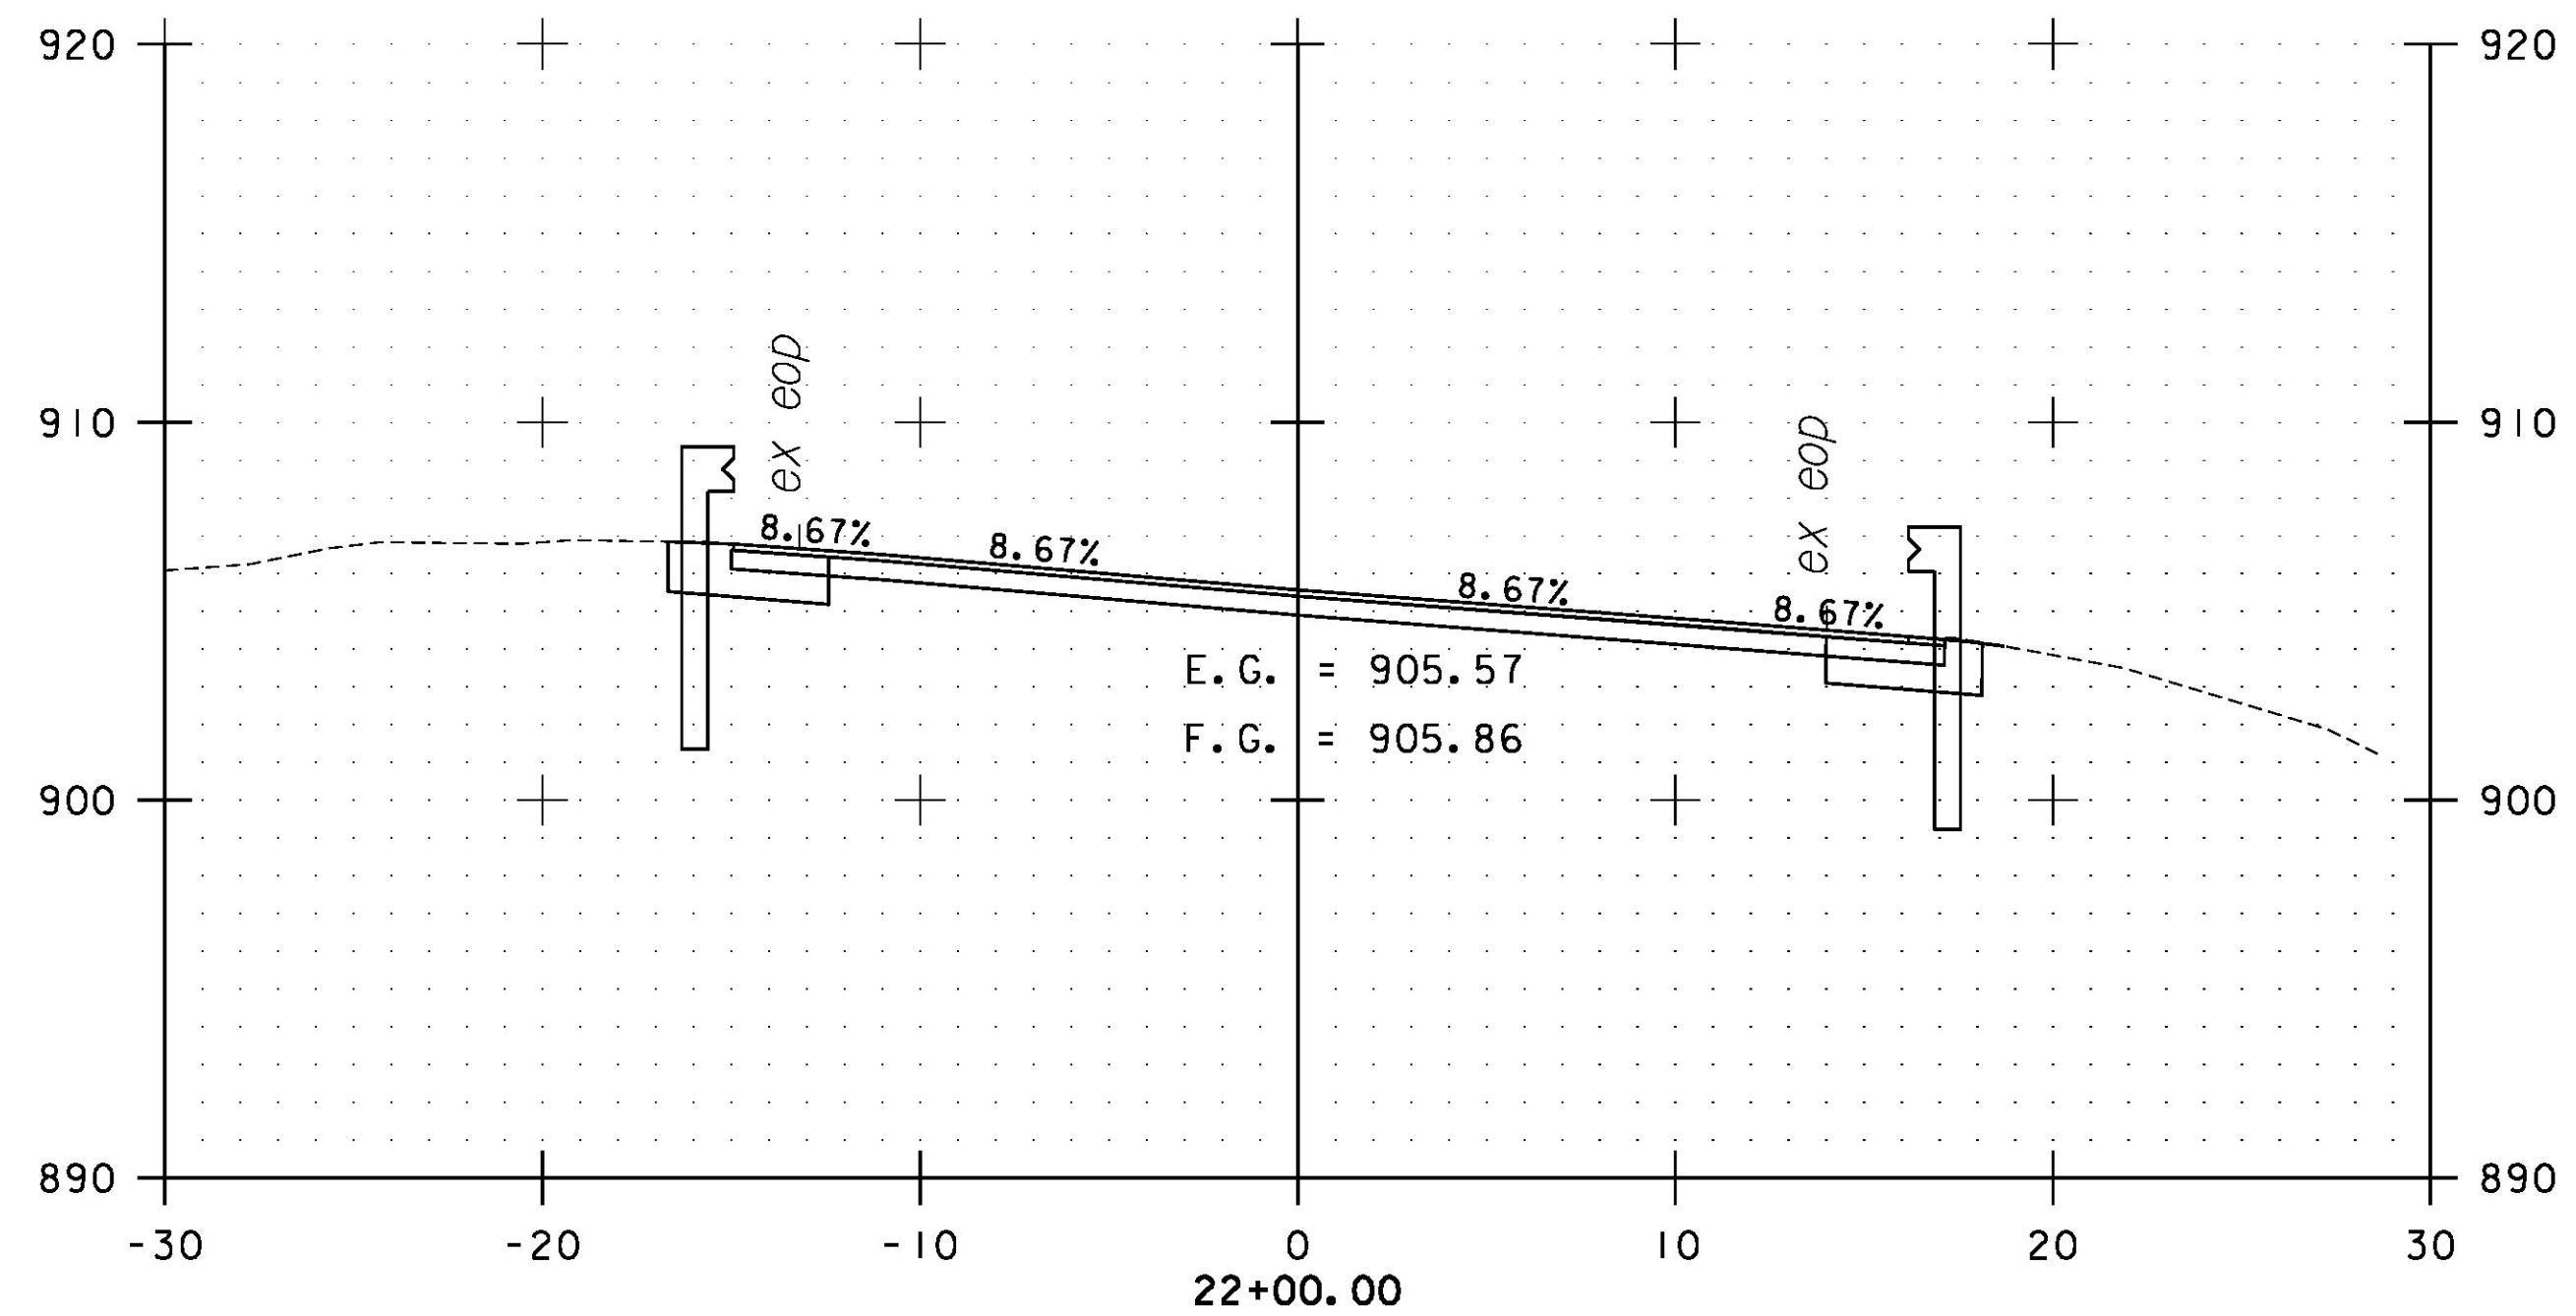

STA. 21+00 TO STA. 22+50

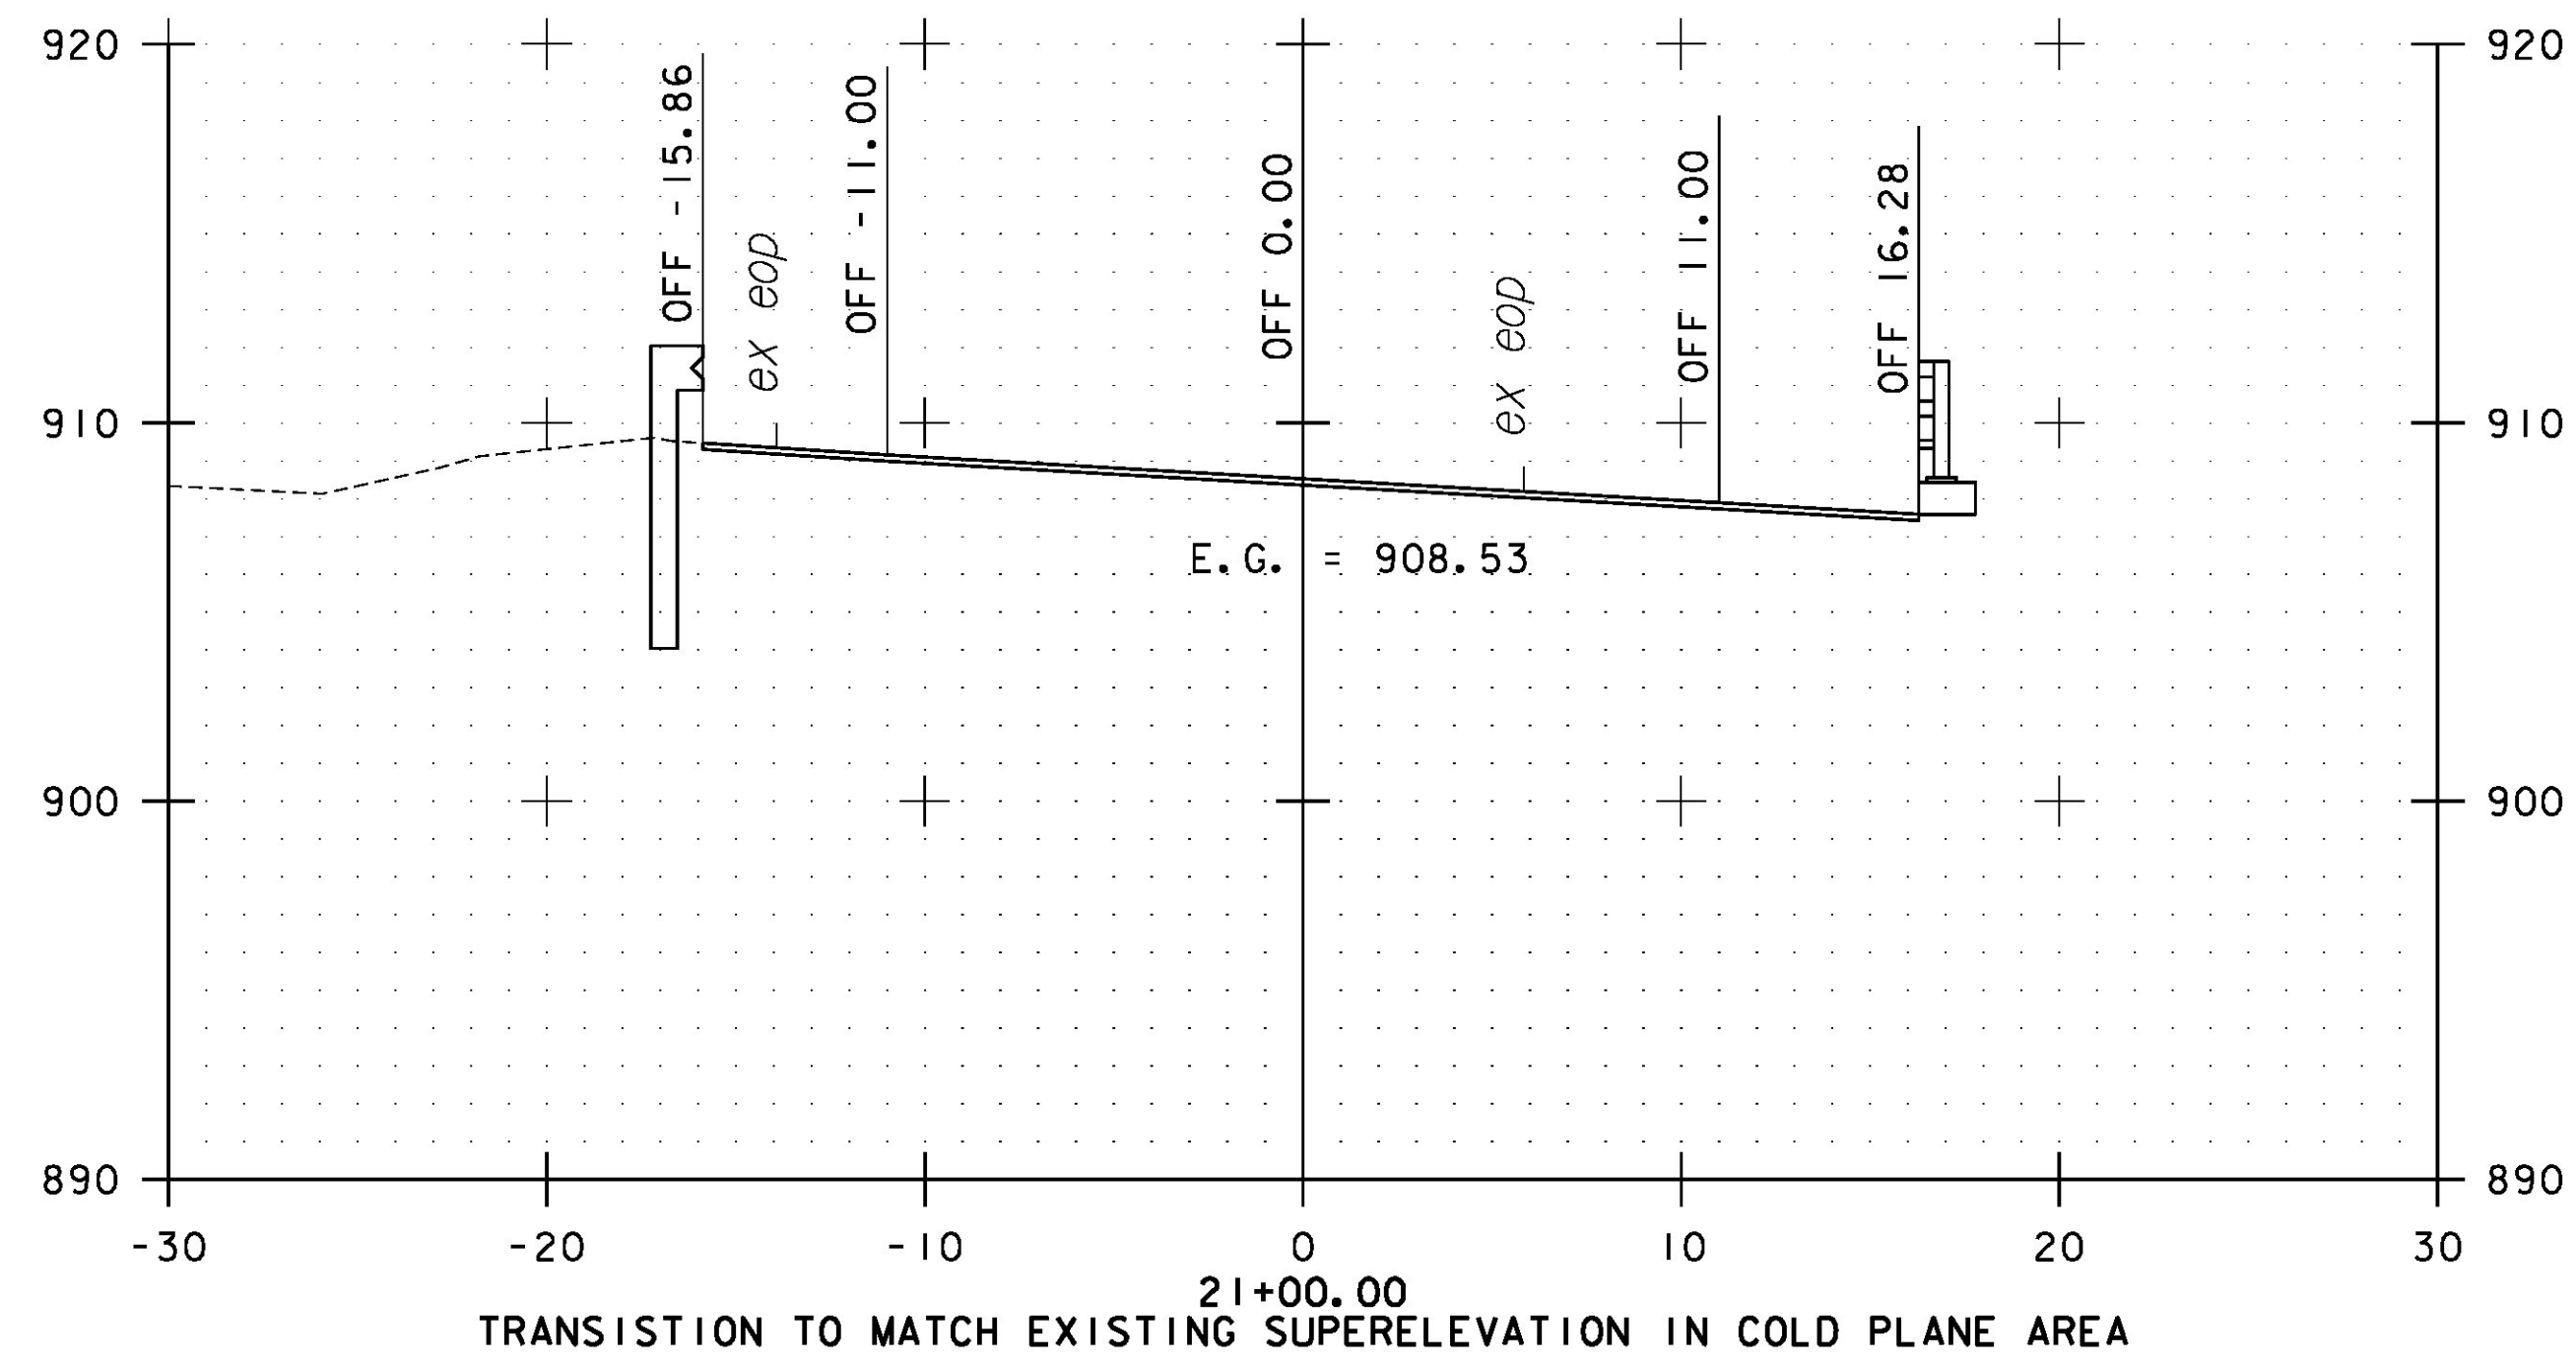

PROJECT NAME: ROXBURY-NORTHFIELD	
PROJECT NUMBER: ER STP 0187(13)	
FILE NAME: z13cl84xs.dgn	PLOT DATE: 5/25/2016
PROJECT LEADER: M. FOISY	DRAWN BY: G. BURGMEIER
DESIGNED BY: G. BURGMEIER	CHECKED BY: G. EDWARDS
<b>NORTHFIELD CROSS SECTIONS SHEET 9</b> SHEET 325 OF 476	