


UNSUITABLE BASE MATERIAL TO BE REMOVED AND REPLACED, SEE UNSUITABLE BASE MATERIAL DETAILS ON SHEET 11

STA. 101+00 TO STA. 102+50

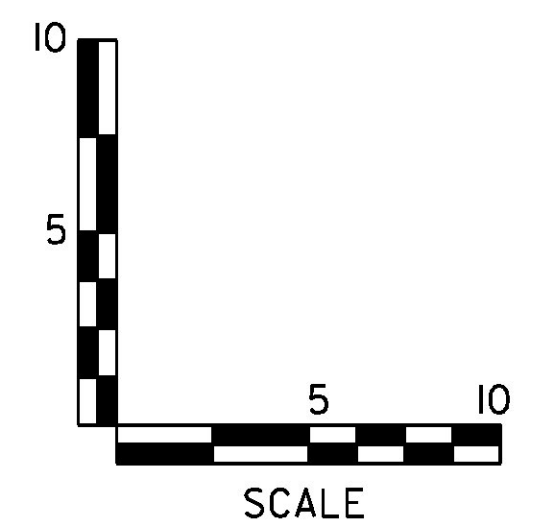

PROJECT NAME: ROXBURY-NORTHFIELD
PROJECT NUMBER: ER STP 0187(13)

FILE NAME: z13cl84xs.dgn PLOT DATE: 5/25/2016
PROJECT LEADER: M. FOISY DRAWN BY: G. BURGMEIER
DESIGNED BY: G. BURGMEIER CHECKED BY: G. EDWARDS
NORTHFIELD CROSS SECTIONS SHEET 48 SHEET 364 OF 476