


UNSUITABLE BASE MATERIAL TO BE REMOVED AND REPLACED, SEE UNSUITABLE BASE MATERIAL DETAILS ON SHEET 11

STA. 103+00 TO STA. 104+50

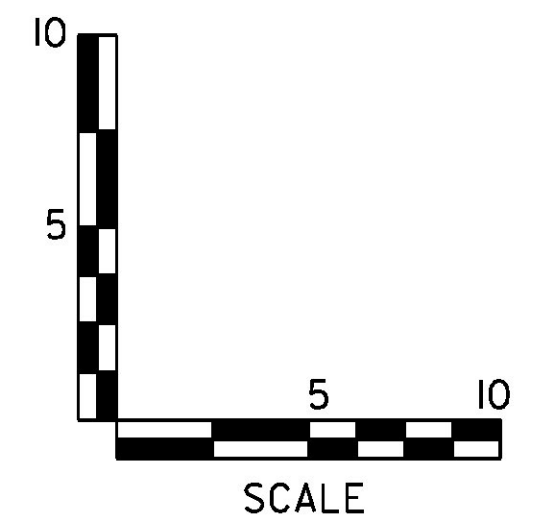

PROJECT NAME: ROXBURY-NORTHFIELD	
PROJECT NUMBER: ER STP 0187(13)	
FILE NAME: z13cl84xs.dgn	PLOT DATE: 5/25/2016
PROJECT LEADER: M. FOISY	DRAWN BY: G. BURGMEIER
DESIGNED BY: G. BURGMEIER	CHECKED BY: G. EDWARDS
NORTHFIELD CROSS SECTIONS SHEET 49 SHEET 365 OF 476	