


FOR ADDITIONAL DRIVE  
DESIGN INFORMATION  
SEE DRIVE CROSS  
SECTIONS ON SHEETS  
443 TO 506



STA. 161+50 TO STA. 163+50

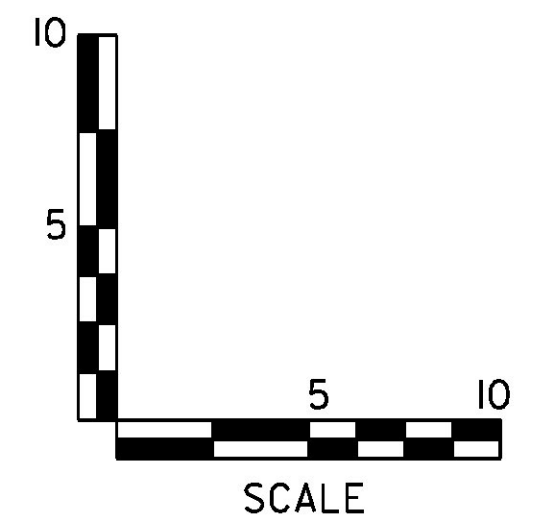

PROJECT NAME: ROXBURY-NORTHFIELD	
PROJECT NUMBER: ER STP 0187(13)	
FILE NAME: z13cl84xs.dgn	PLOT DATE: 5/25/2016
PROJECT LEADER: M. FOISY	DRAWN BY: G. BURGMEIER
DESIGNED BY: G. BURGMEIER	CHECKED BY: G. EDWARDS
<b>NORTHFIELD CROSS SECTIONS SHEET 76</b> SHEET 392 OF 476	