


FOR ADDITIONAL DRIVE
DESIGN INFORMATION
SEE DRIVE CROSS
SECTIONS ON SHEETS
443 TO 506



STA. 198+50 TO STA. 200+50

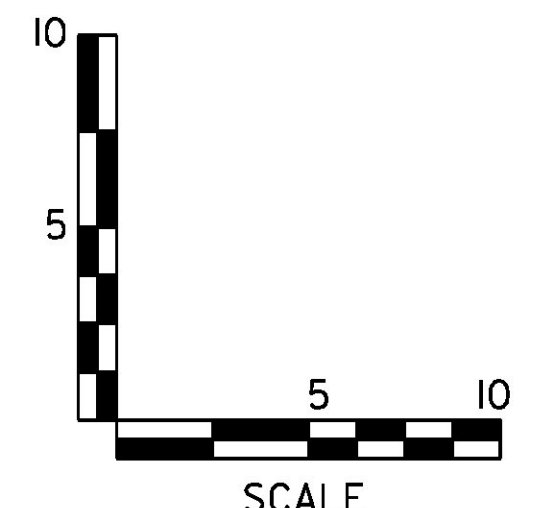

PROJECT NAME: ROXBURY-NORTHFIELD	
PROJECT NUMBER: ER STP 0187(13)	
FILE NAME: z13cl84xs.dgn	PLOT DATE: 5/25/2016
PROJECT LEADER: M. FOISY	DRAWN BY: G. BURGMEIER
DESIGNED BY: G. BURGMEIER	CHECKED BY: G. EDWARDS
NORTHFIELD CROSS SECTIONS SHEET 92 SHEET 408 OF 476	