


15" CPEP(SL) EXT. OF 2.5 FT WAS MADE. BELL END OF EXT. JOINED WITH 15" SLIP LINE PIPE. EXISTING PIPE THAT RUNS ACROSS THE ROAD IS A 15" PLASTIC SLIP LINE PIPE, ENCASED IN A 18" CMP.



PROJECT NAME:	ROXBURY-NORTHFIELD
PROJECT NUMBER:	ER STP 0187(13)
FILE NAME:	z13cl84xs_cul.dgn
PROJECT LEADER:	M. FOISY
DESIGNED BY:	G. BURGMEIER
CULVERT SECTIONS SHEET 6	
PLOT DATE:	6/13/2016
DRAWN BY:	G. BURGMEIER
CHECKED BY:	G. EDWARDS
SHEET	421 OF 476

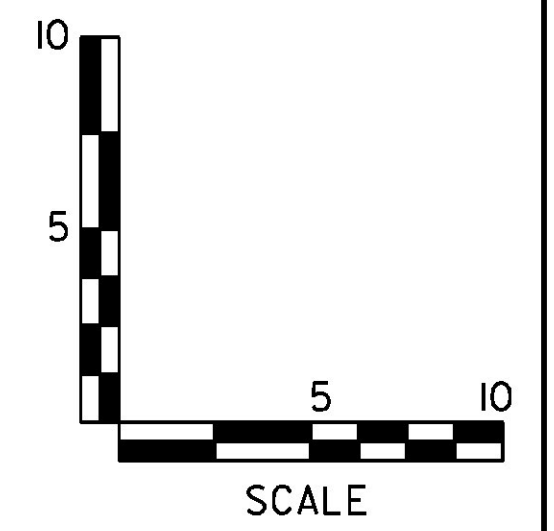