


OLD HEADWALL REMOVED. NEW DID STRUCTURE  
INSTALLED. 58" STRUCTURE. UNDERDRAIN RUN  
#55 END DAYLIGHTS INTO DI STRUCTURE, BUT  
ALSO DAYLIGHTS ON OTHER END.

TOP OF DI ELEVATION: 799.95'



PROJECT NAME: ROXBURY-NORTHFIELD	
PROJECT NUMBER: ER STP 0187(13)	
FILE NAME: z13cl84xs_cul.dgn	PLOT DATE: 6/13/2016
PROJECT LEADER: M. FOISY	DRAWN BY: G. BURGMEIER
DESIGNED BY: G. BURGMEIER	CHECKED BY: G. EDWARDS
<b>CULVERT SECTIONS SHEET 8</b>	
	SHEET 423 OF 476

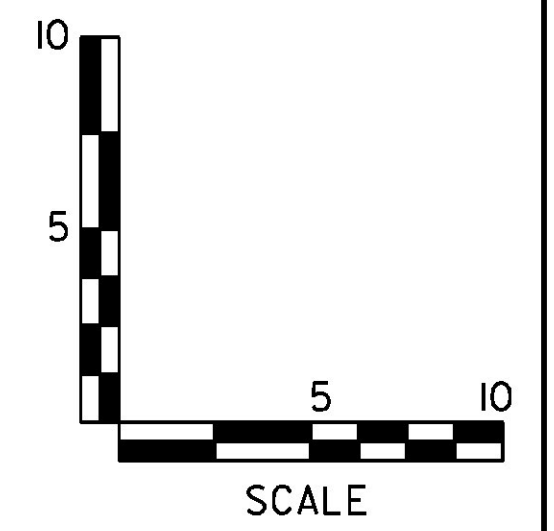