


SUMMARY OF SHEETS
 PROJECT COMPOSITE SHEETS: 1-2
 BF 0225 (4) SHEETS: 3-31
 BF 0225 (5) SHEETS: 32-63

STATE OF VERMONT AGENCY OF TRANSPORTATION



PROPOSED IMPROVEMENT BRIDGE PROJECT

TOWN OF WATERFORD
 COUNTY OF CALEDONIA

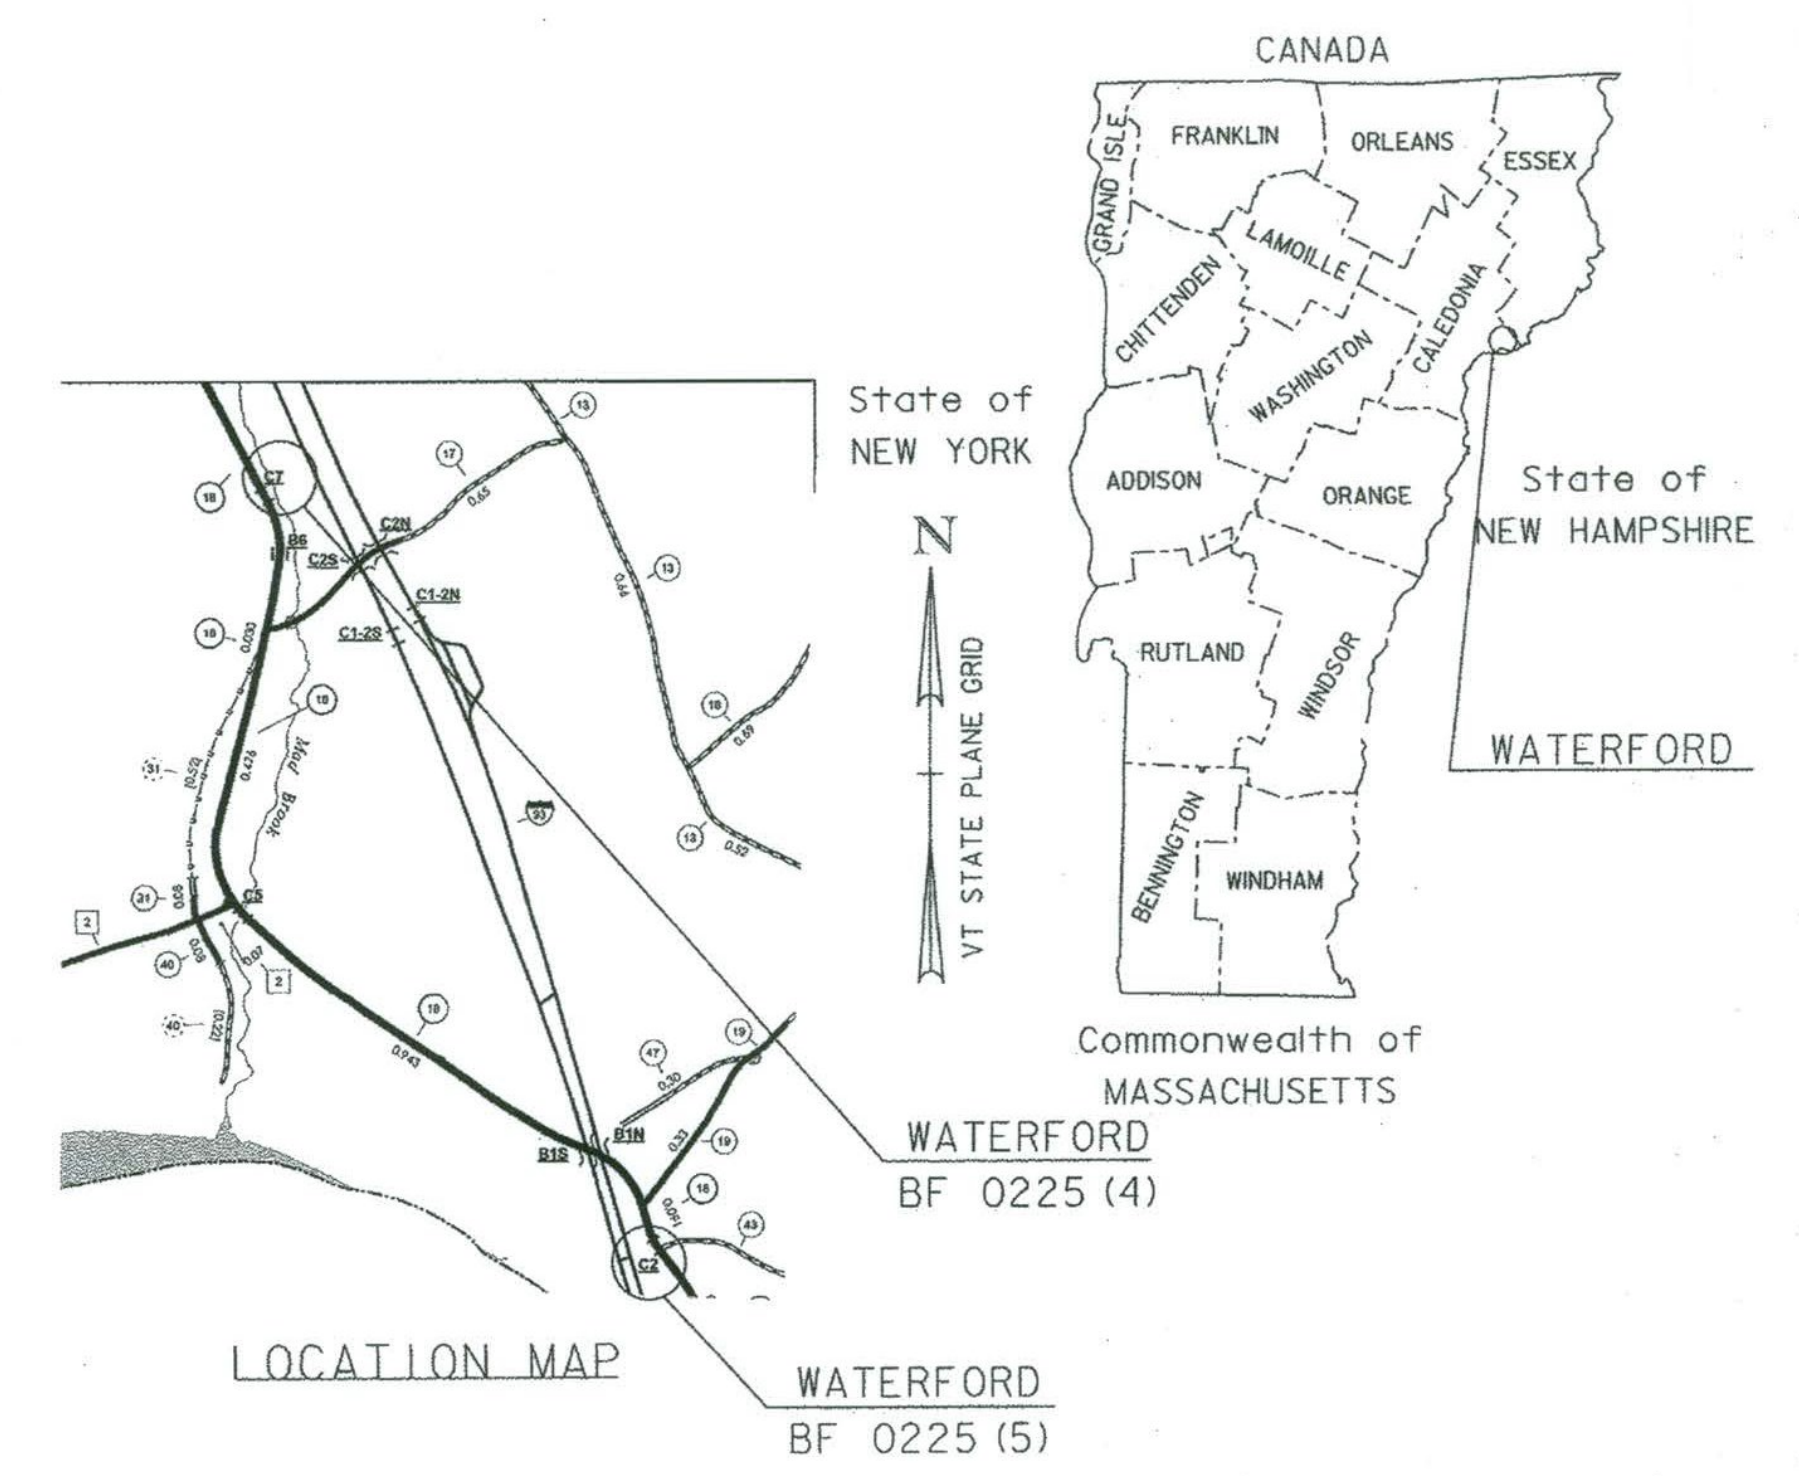

Record Plans
 Contractor: J. HUTCHINS, INC.
 Resident Engineer: PETE HODGSON
 Construction Began: JULY 10, 2018
 Construction Complete: JUNE 4, 2019
 Record Plans By: PETE HODGSON & JESSE IVES

I hereby certify that all construction required by this set of drawings has been accomplished as indicated herein.

BY: *Pete Hodgson* Resident Engineer

Date: 12-29-2019

NOTE: Any further information concerning final quantities, amounts or other details relative to this project may be found at Central Files in the electronic archives.


WATERFORD BF 0225 (4)

ROUTE NO : VT ROUTE 18, RURAL MAJOR COLLECTOR BRIDGE NO : 7

PROJECT LOCATION: APPROXIMATELY 5.9 MILES SOUTH OF THE INTERSECTION OF VT ROUTE 18 AND US ROUTE 2

PROJECT DESCRIPTION: REPLACEMENT OF EXISTING CULVERT WITH A NEW PRECAST CONCRETE BOX CULVERT WITH RELATED APPROACH ROADWAY AND CHANNEL WORK.

LENGTH OF STRUCTURE: 19.16 FEET
 LENGTH OF ROADWAY: 180.84 FEET
 LENGTH OF PROJECT: 200.00 FEET

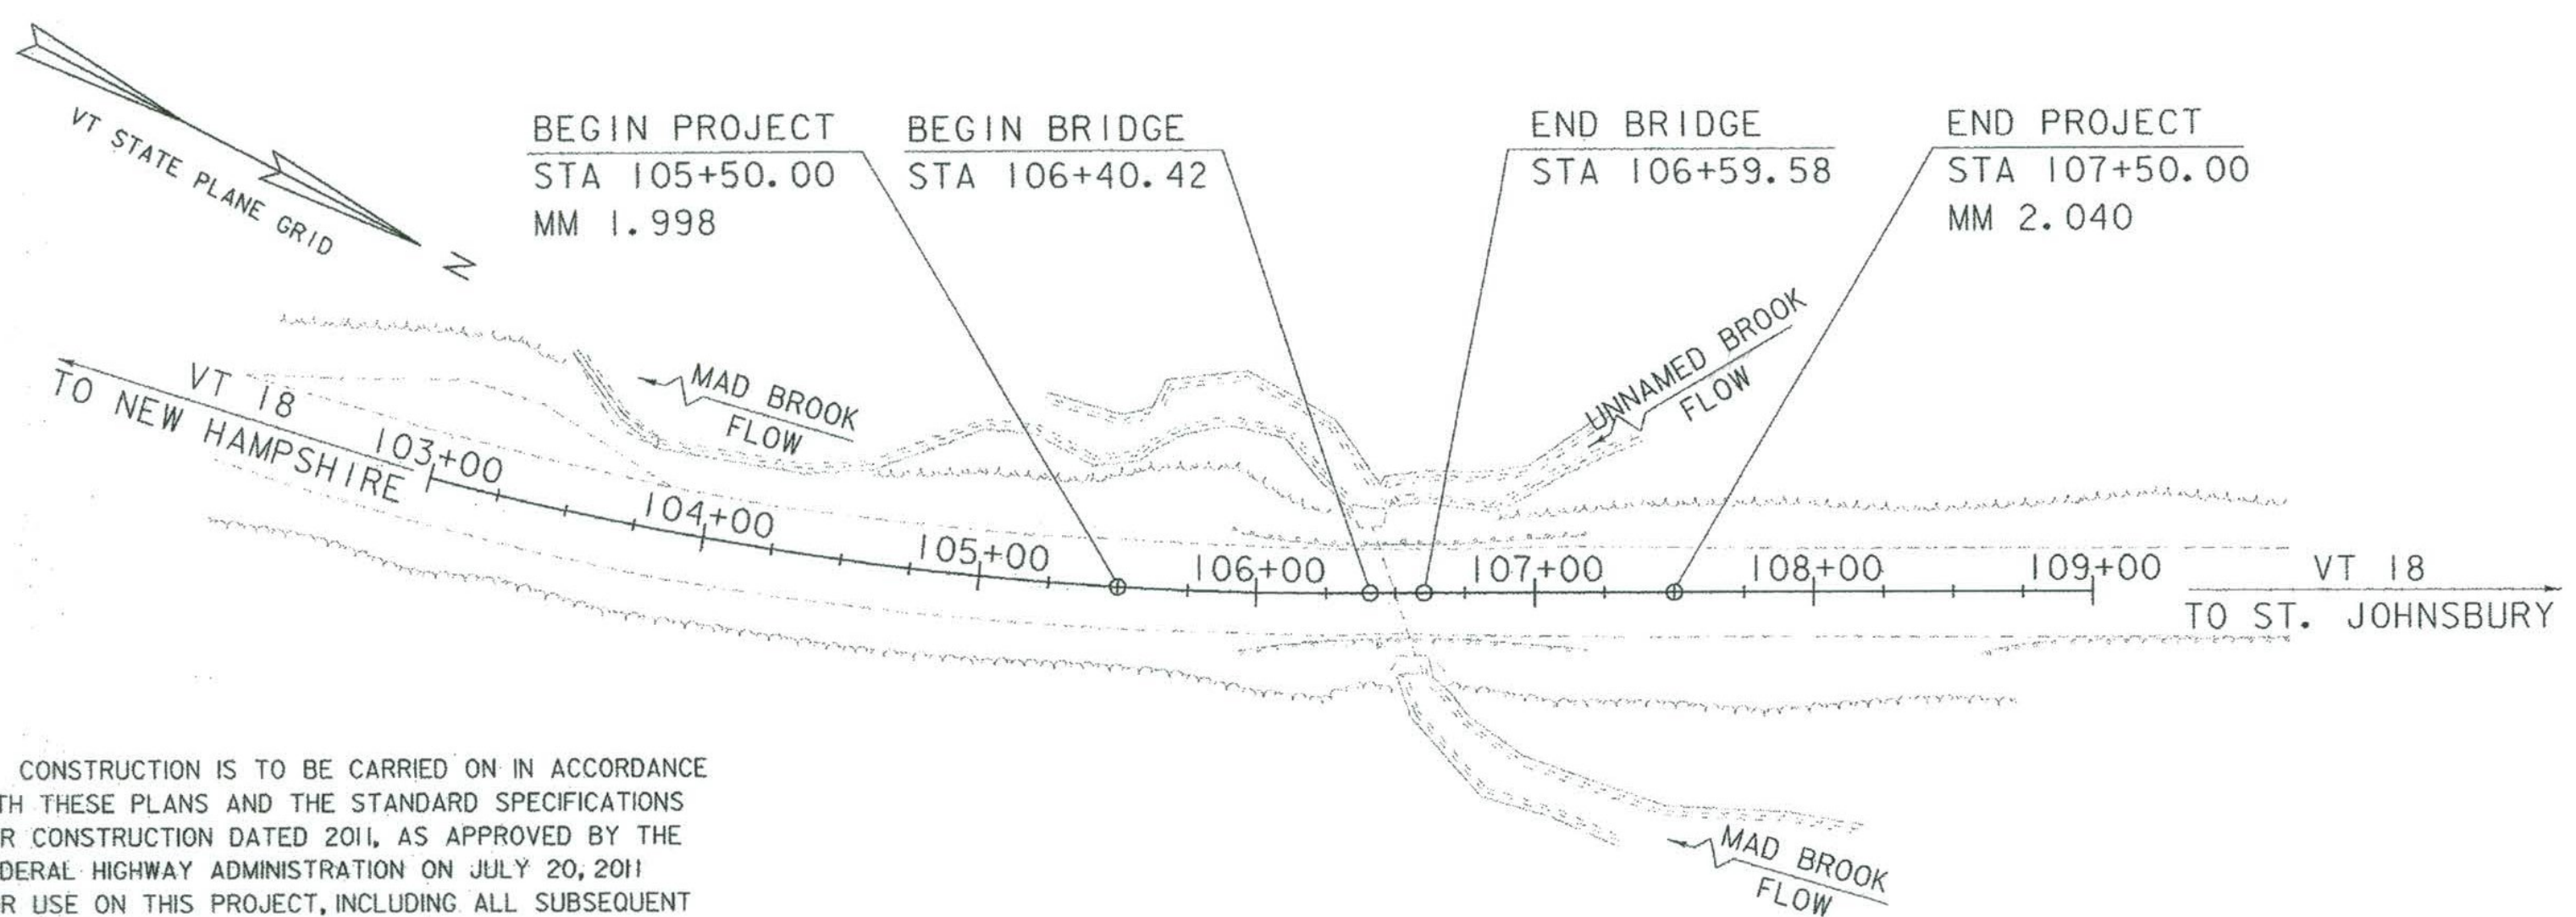

CONSTRUCTION IS TO BE CARRIED ON IN ACCORDANCE WITH THESE PLANS AND THE STANDARD SPECIFICATIONS FOR CONSTRUCTION DATED 2011, AS APPROVED BY THE FEDERAL HIGHWAY ADMINISTRATION ON JULY 20, 2011 FOR USE ON THIS PROJECT, INCLUDING ALL SUBSEQUENT REVISIONS AND SUCH REVISED SPECIFICATIONS AND SPECIAL PROVISIONS AS ARE INCORPORATED IN THESE PLANS.

QUALITY ASSURANCE PROGRAM : LEVEL 2	
SURVEYED BY :	R. GILMAN
SURVEYED DATE :	12-27-2013
DATUM	
VERTICAL	NAVD88
HORIZONTAL	NAD83 (2011)

SCALE 1" = 60'-0"
 60 0 60


WATERFORD BF 0225 (5)

ROUTE NO : VT ROUTE 18, RURAL MAJOR COLLECTOR BRIDGE NO : 2

PROJECT LOCATION: APPROXIMATELY 7.6 MILES SOUTH OF THE INTERSECTION OF VT ROUTE 18 AND US ROUTE 2.

PROJECT DESCRIPTION: REPLACEMENT OF EXISTING CULVERT WITH A NEW PRECAST CONCRETE BOX CULVERT WITH RELATED APPROACH ROADWAY AND CHANNEL WORK.

LENGTH OF STRUCTURE: 21.90 FEET
 LENGTH OF ROADWAY: 178.10 FEET
 LENGTH OF PROJECT: 200.00 FEET

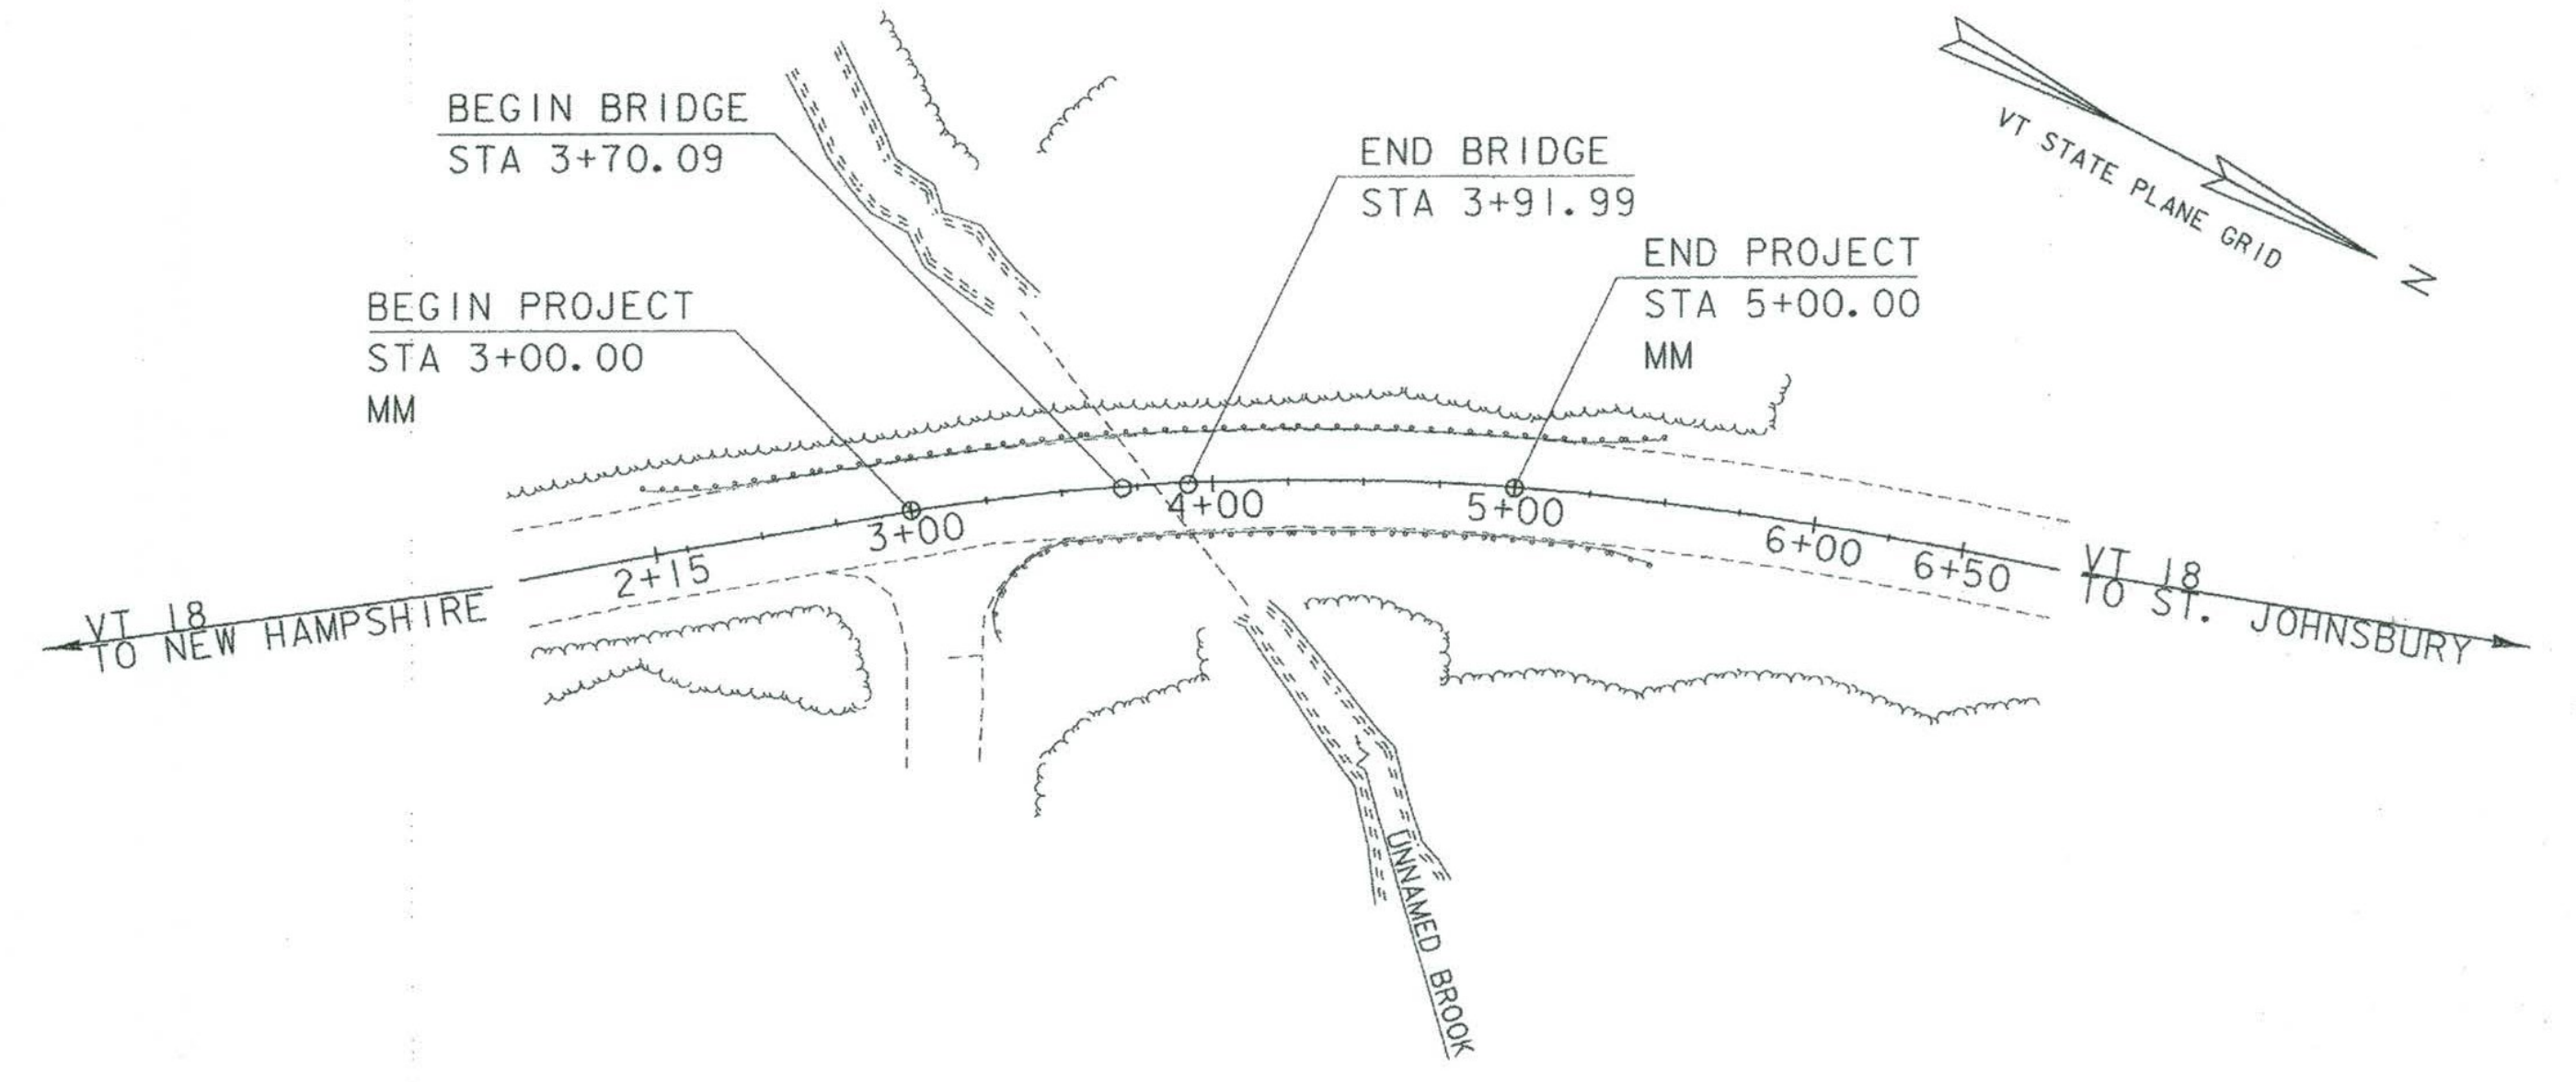

	<p>GM2 Associates, Inc. 197 Loudon Road, Suite 310 Concord, NH 03301 Tel: 603-856-7854 Fax: 603-856-7855</p>	DIRECTOR OF PROJECT DELIVERY
		APPROVED <u><i>D. Landry</i></u> DATE <u>01/16/2018</u>
		PROJECT MANAGER : D. LANDRY
		PROJECT NAME : WATERFORD
		PROJECT NUMBER : BF 0225 (4) & BF 0225 (5)
		SHEET 1 OF 63 SHEETS