
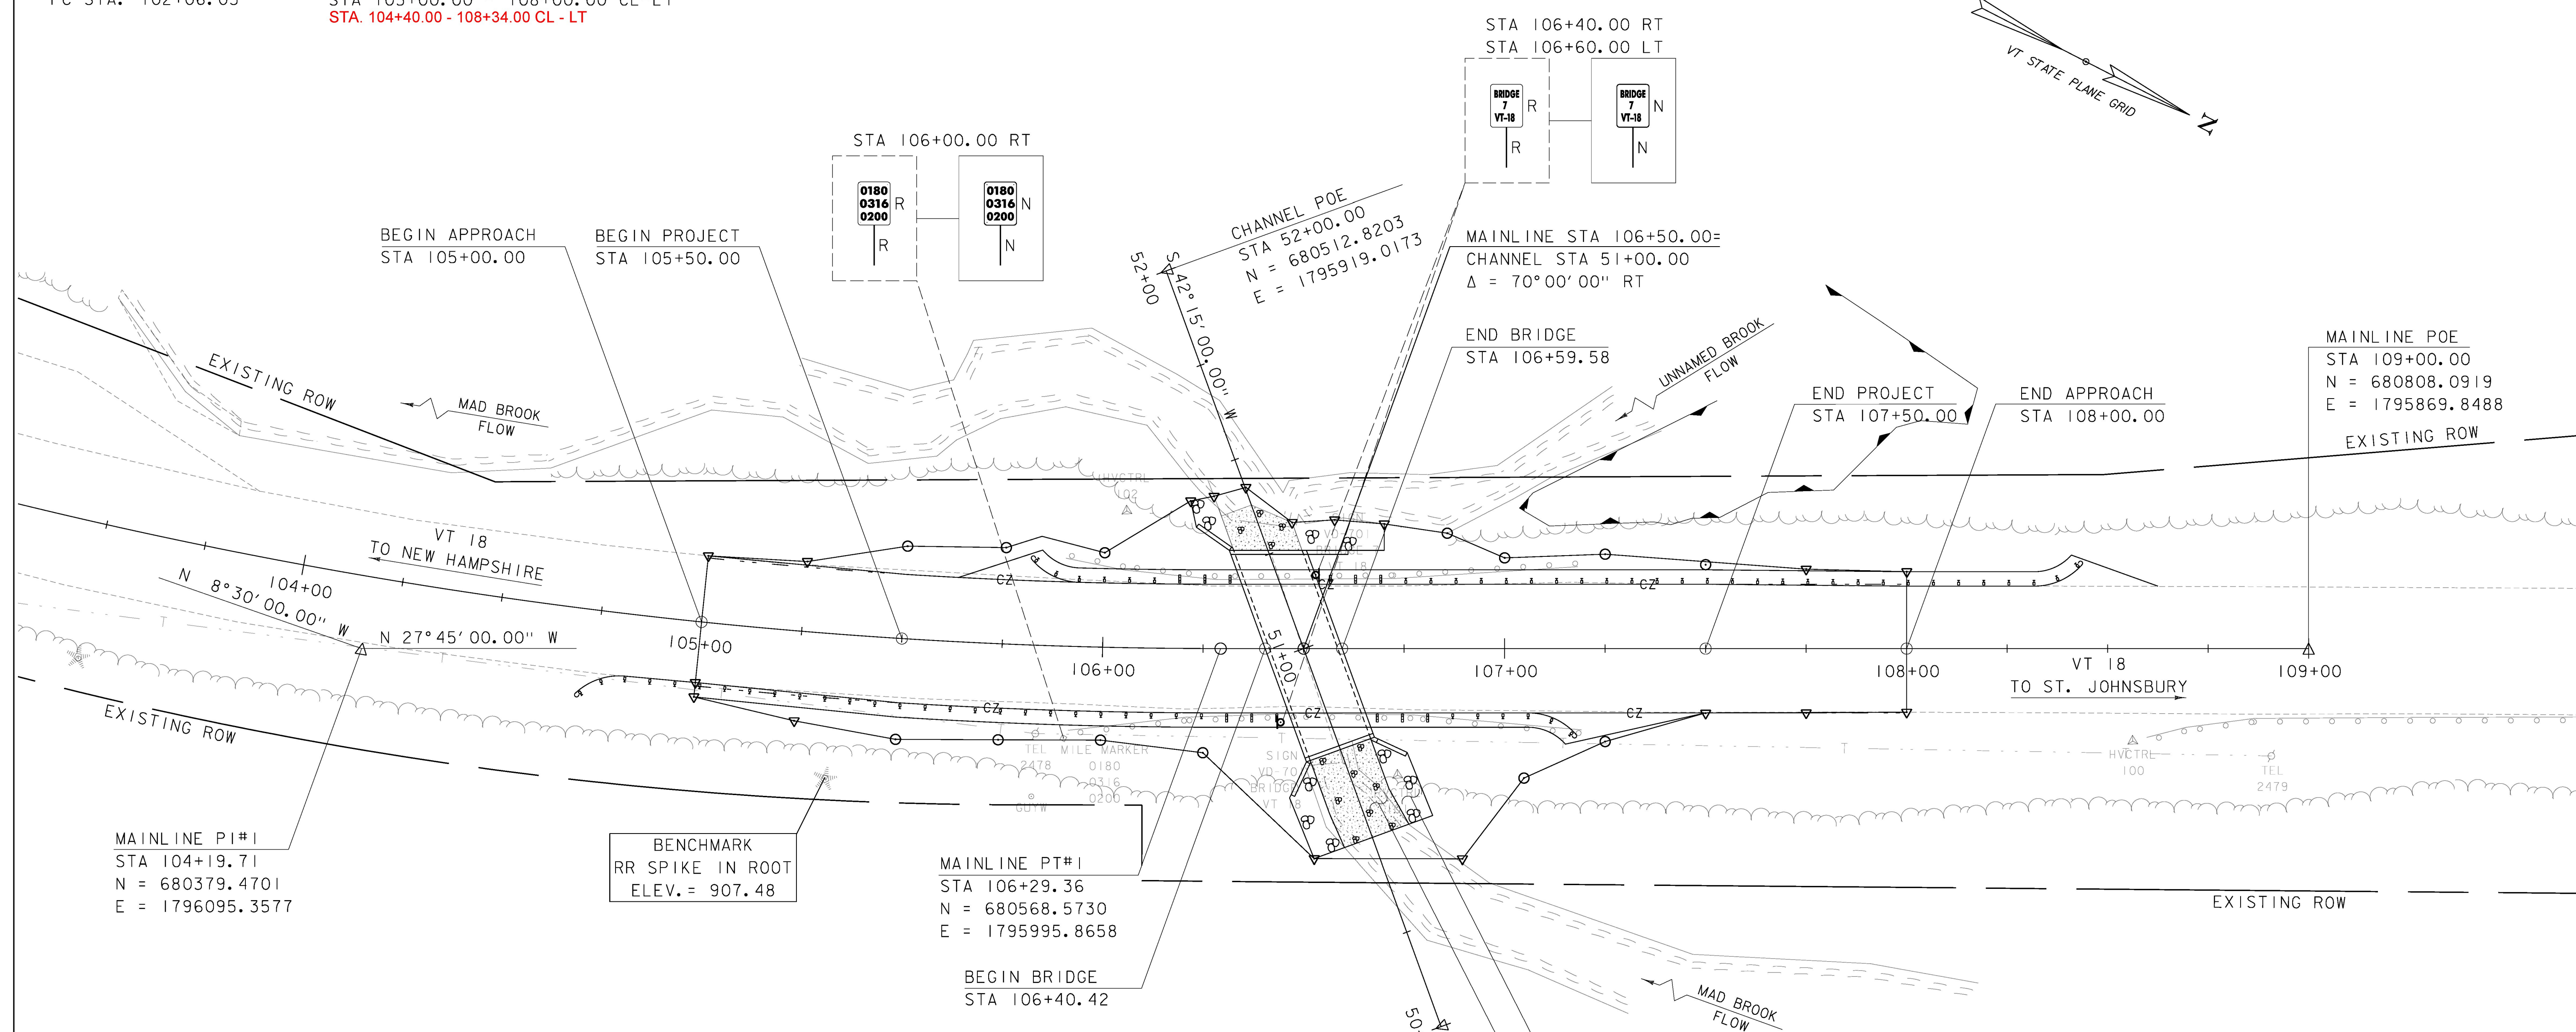


MAINLINE CURVE #1  
 DELTA = 19° 15' 00", LT  
 D = 4° 32' 50"  
 R = 1260.00'  
 T = 213.68'  
 L = 423.33'  
 E = 17.99'  
 PC STA. 102+06.03

4 INCH WHITE LINE  
~~STA 105+00.00 - 108+00.00 LT/RT~~  
~~STA 104+59.00 - 108+34.00 LT/RT~~  
 4 INCH YELLOW LINE (DASHED)  
 STA 105+00.00 - 108+00.00 CL-RT  
~~4 INCH YELLOW LINE~~  
 STA 105+00.00 - 108+00.00 CL-LT  
 STA 104+40.00 - 108+34.00 CL - LT

REMOVAL AND DISPOSAL OF GUARDRAIL  
 STA. 105+92.0 - 107+19.1, RT  
 STA. 105+90.2 - 107+18.2, LT

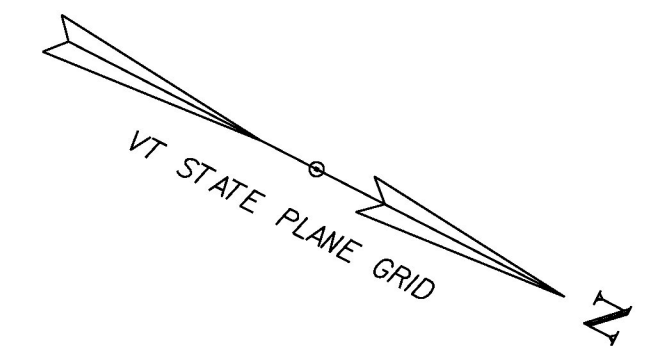

MILEMARKER, STATION, OR SIGN NUMBER	SIGN LEGEND	SIGN DIMENSIONS		NEW SIGN "A"	EXIST POST RELATIVE TO SIGN	NEW SIGN POSTS SQUARE STEEL (In)				REMARKS	SIGN DETAIL						
		WIDTH (In)	HEIGHT (In)			2.0	2.0	2.5	ANCHOR		STUBS	DETAIL IN SHSM	DETAIL ON SHEET NUMBER	STD. SHEET NUMBER			
106+40.00 RT		6	10	0.42		2.0	2.0	2.5									
106+60.00 LT		6	10	0.42		2.0	2.0	2.5									
106+00.00 RT		6	10	0.42		2.0	2.0	2.5									


FINAL POST LENGTHS ARE TO BE DETERMINED IN THE FIELD. POST SIZES ARE COMPUTED BASED ON INFORMATION FURNISHED ON THE STANDARD SHEETS AND THE VTRANS "SIGN POST DESIGN GUIDELINE."

TOTALS	SF	EA	FT
	1.25		24

SIGN LEGEND  
 N = NEW  
 R = REMOVE  
 S = SALVAGE  
 RET = RETAIN  
 SHSM = STANDARD HIGHWAY SIGNS AND MARKINGS (MUTCD) (APPROVED BY THE FHWA)

CHANNEL POB  
 STA 50+00.00  
 N = 680660.8639  
 E = 1796053.4906

4'-0" STONE FILL TYPE IV (TYP)  
 3'-0" E-STONE TYPE E3 (TYP) (SEE SPECIAL PROVISION)

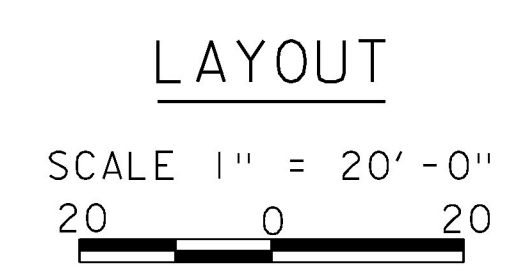

PROJECT NAME:	WATERFORD	PLOT DATE:	09/27/2017
PROJECT NUMBER:	BF 0225(4)	DRAWN BY:	J. MERCER
FILE NAME:	z13c268bdr.dgn	CHECKED BY:	T. LEVINS
PROJECT LEADER:	T. LEVINS	LAYOUT SHEET	SHEET 11 OF 63