




105+00
BEGIN APPROACH

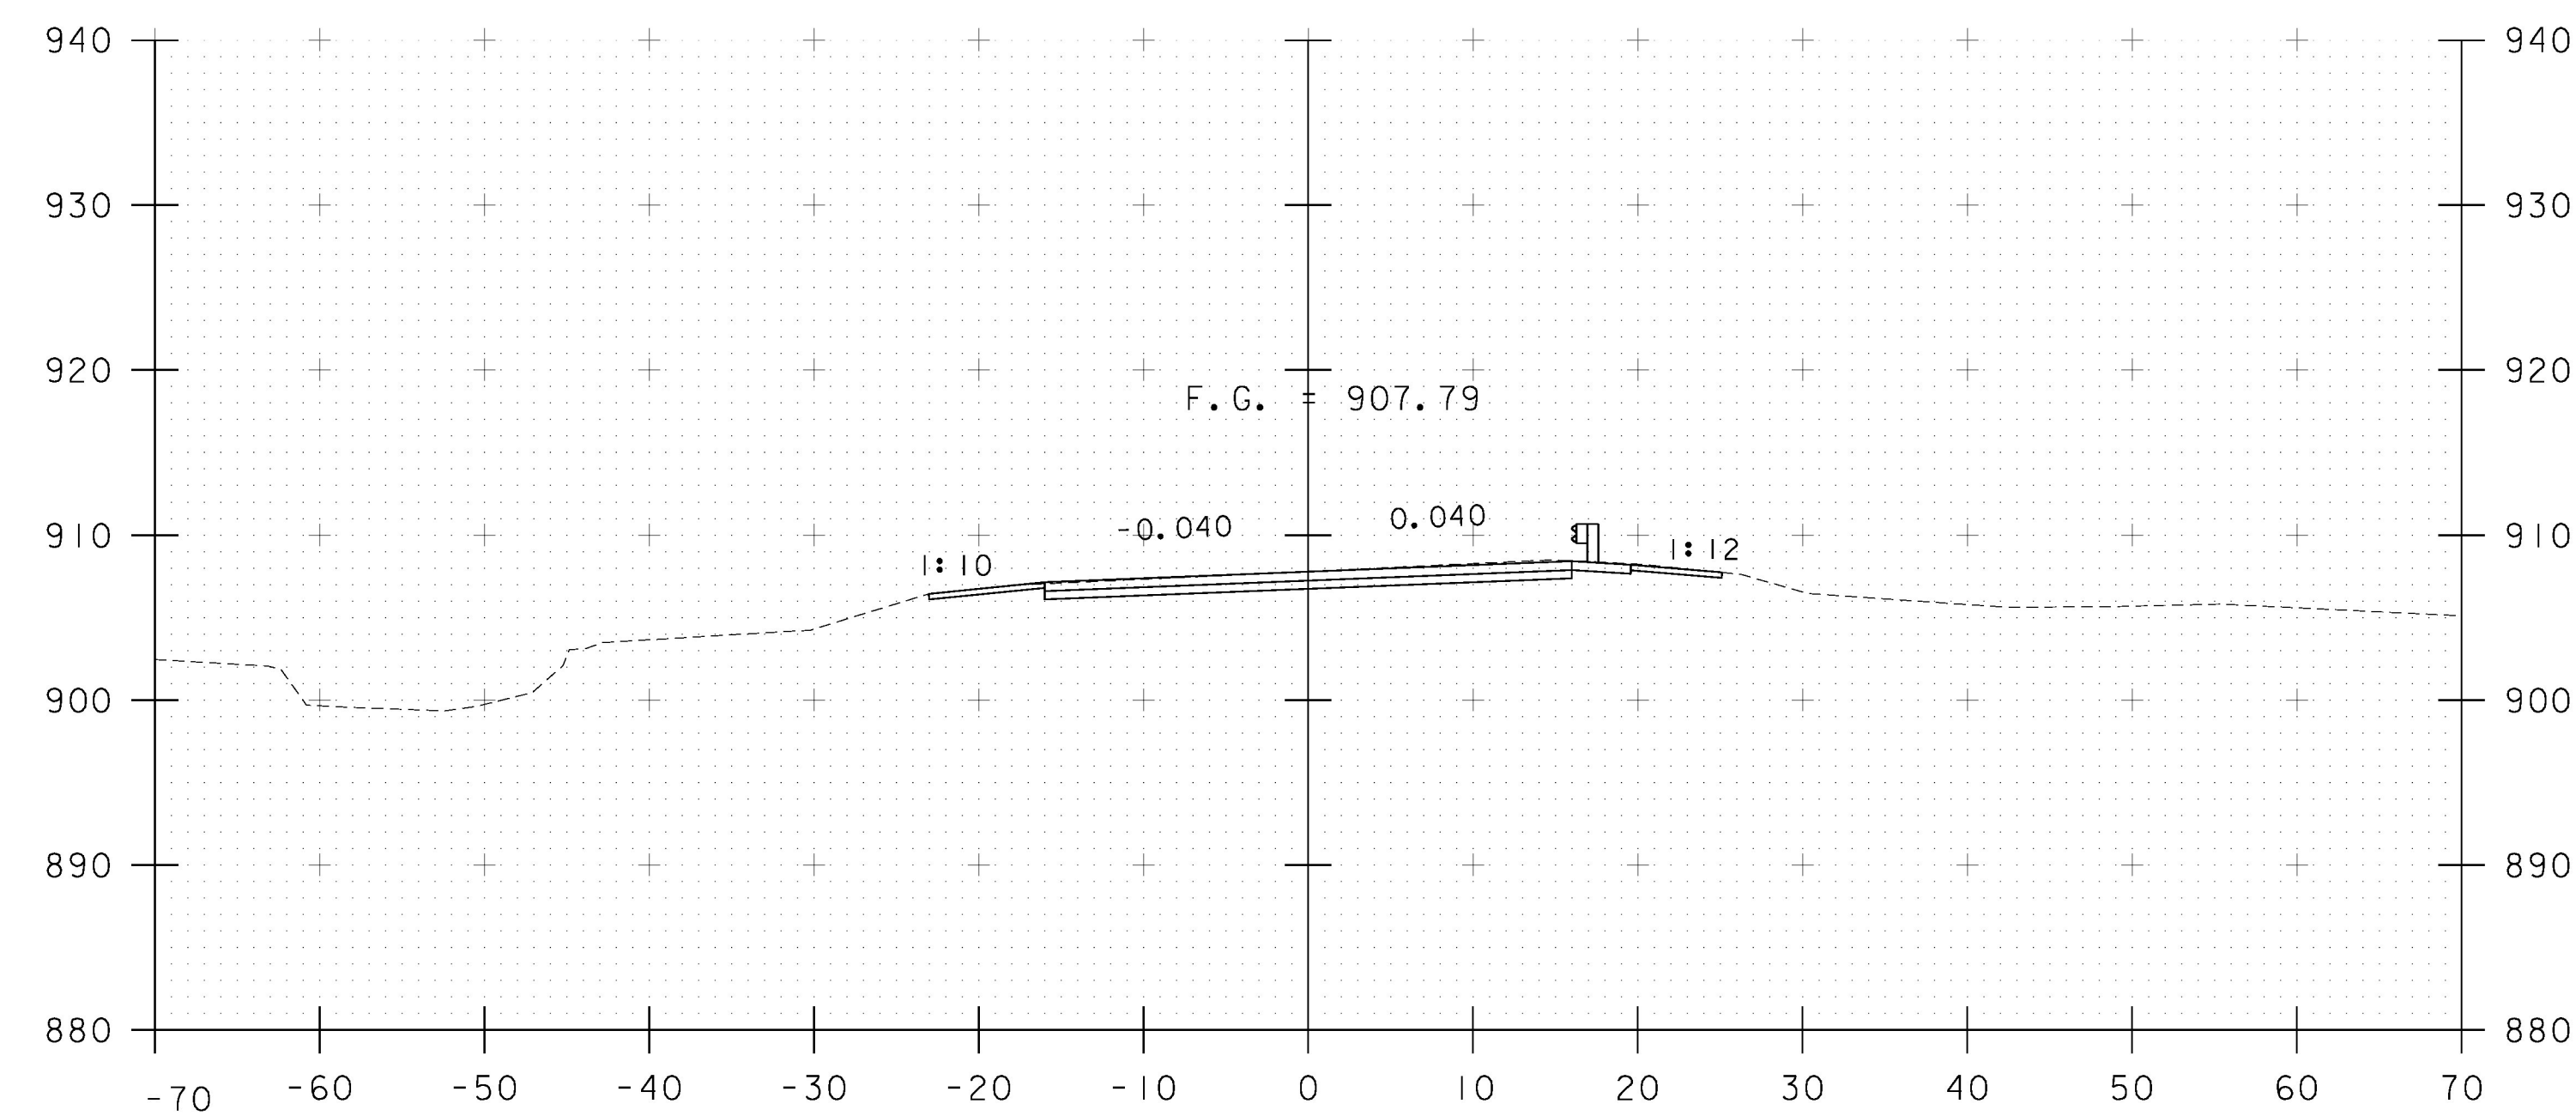

105+50
BEGIN PROJECT

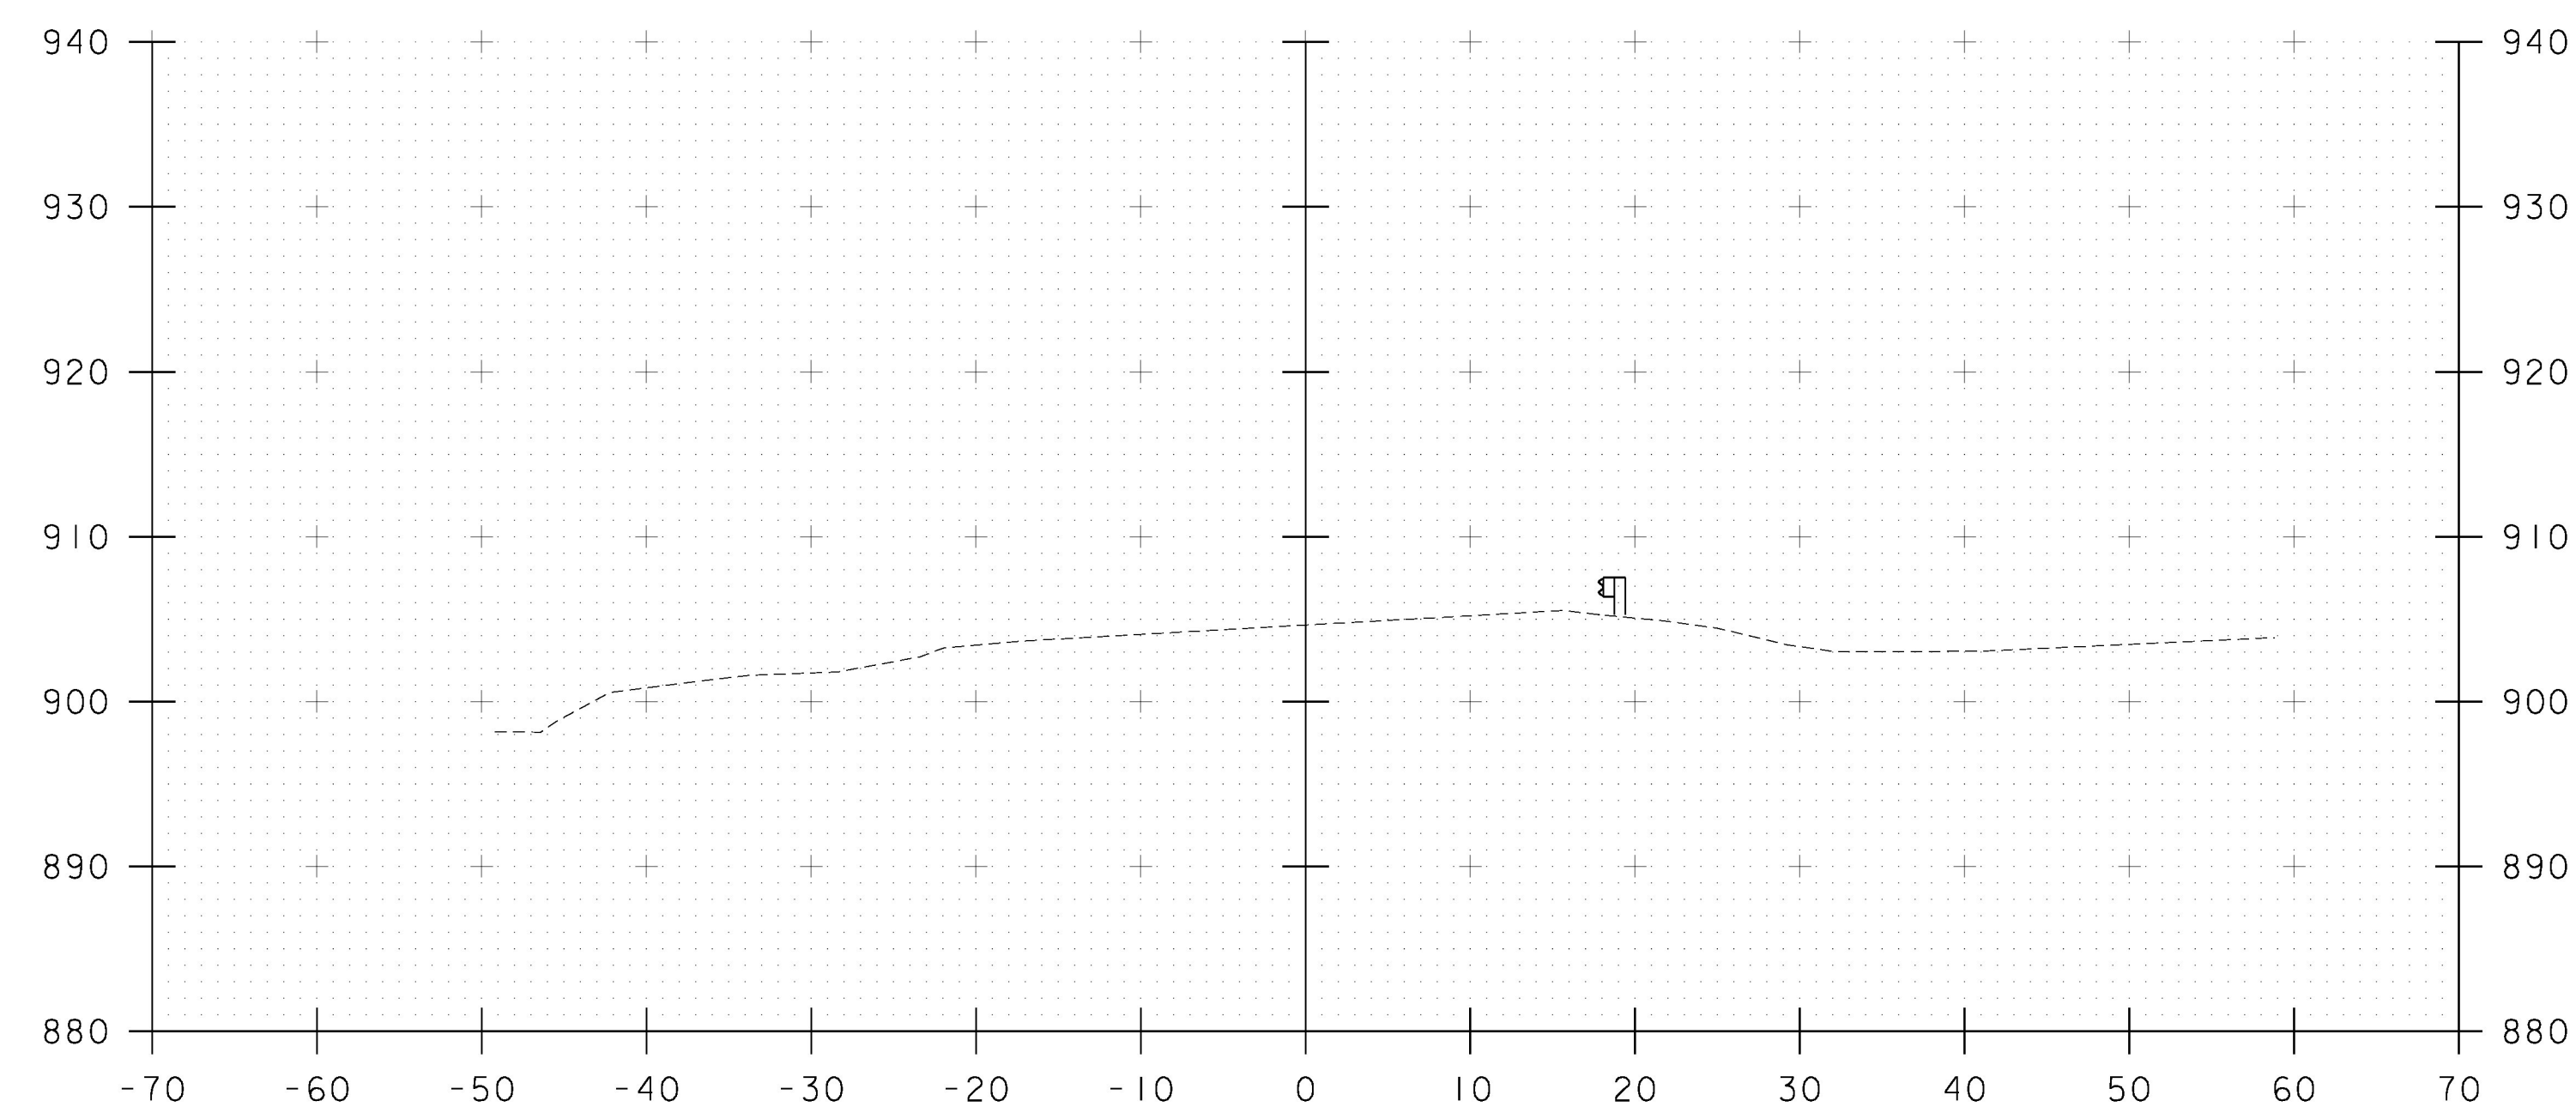

104+75

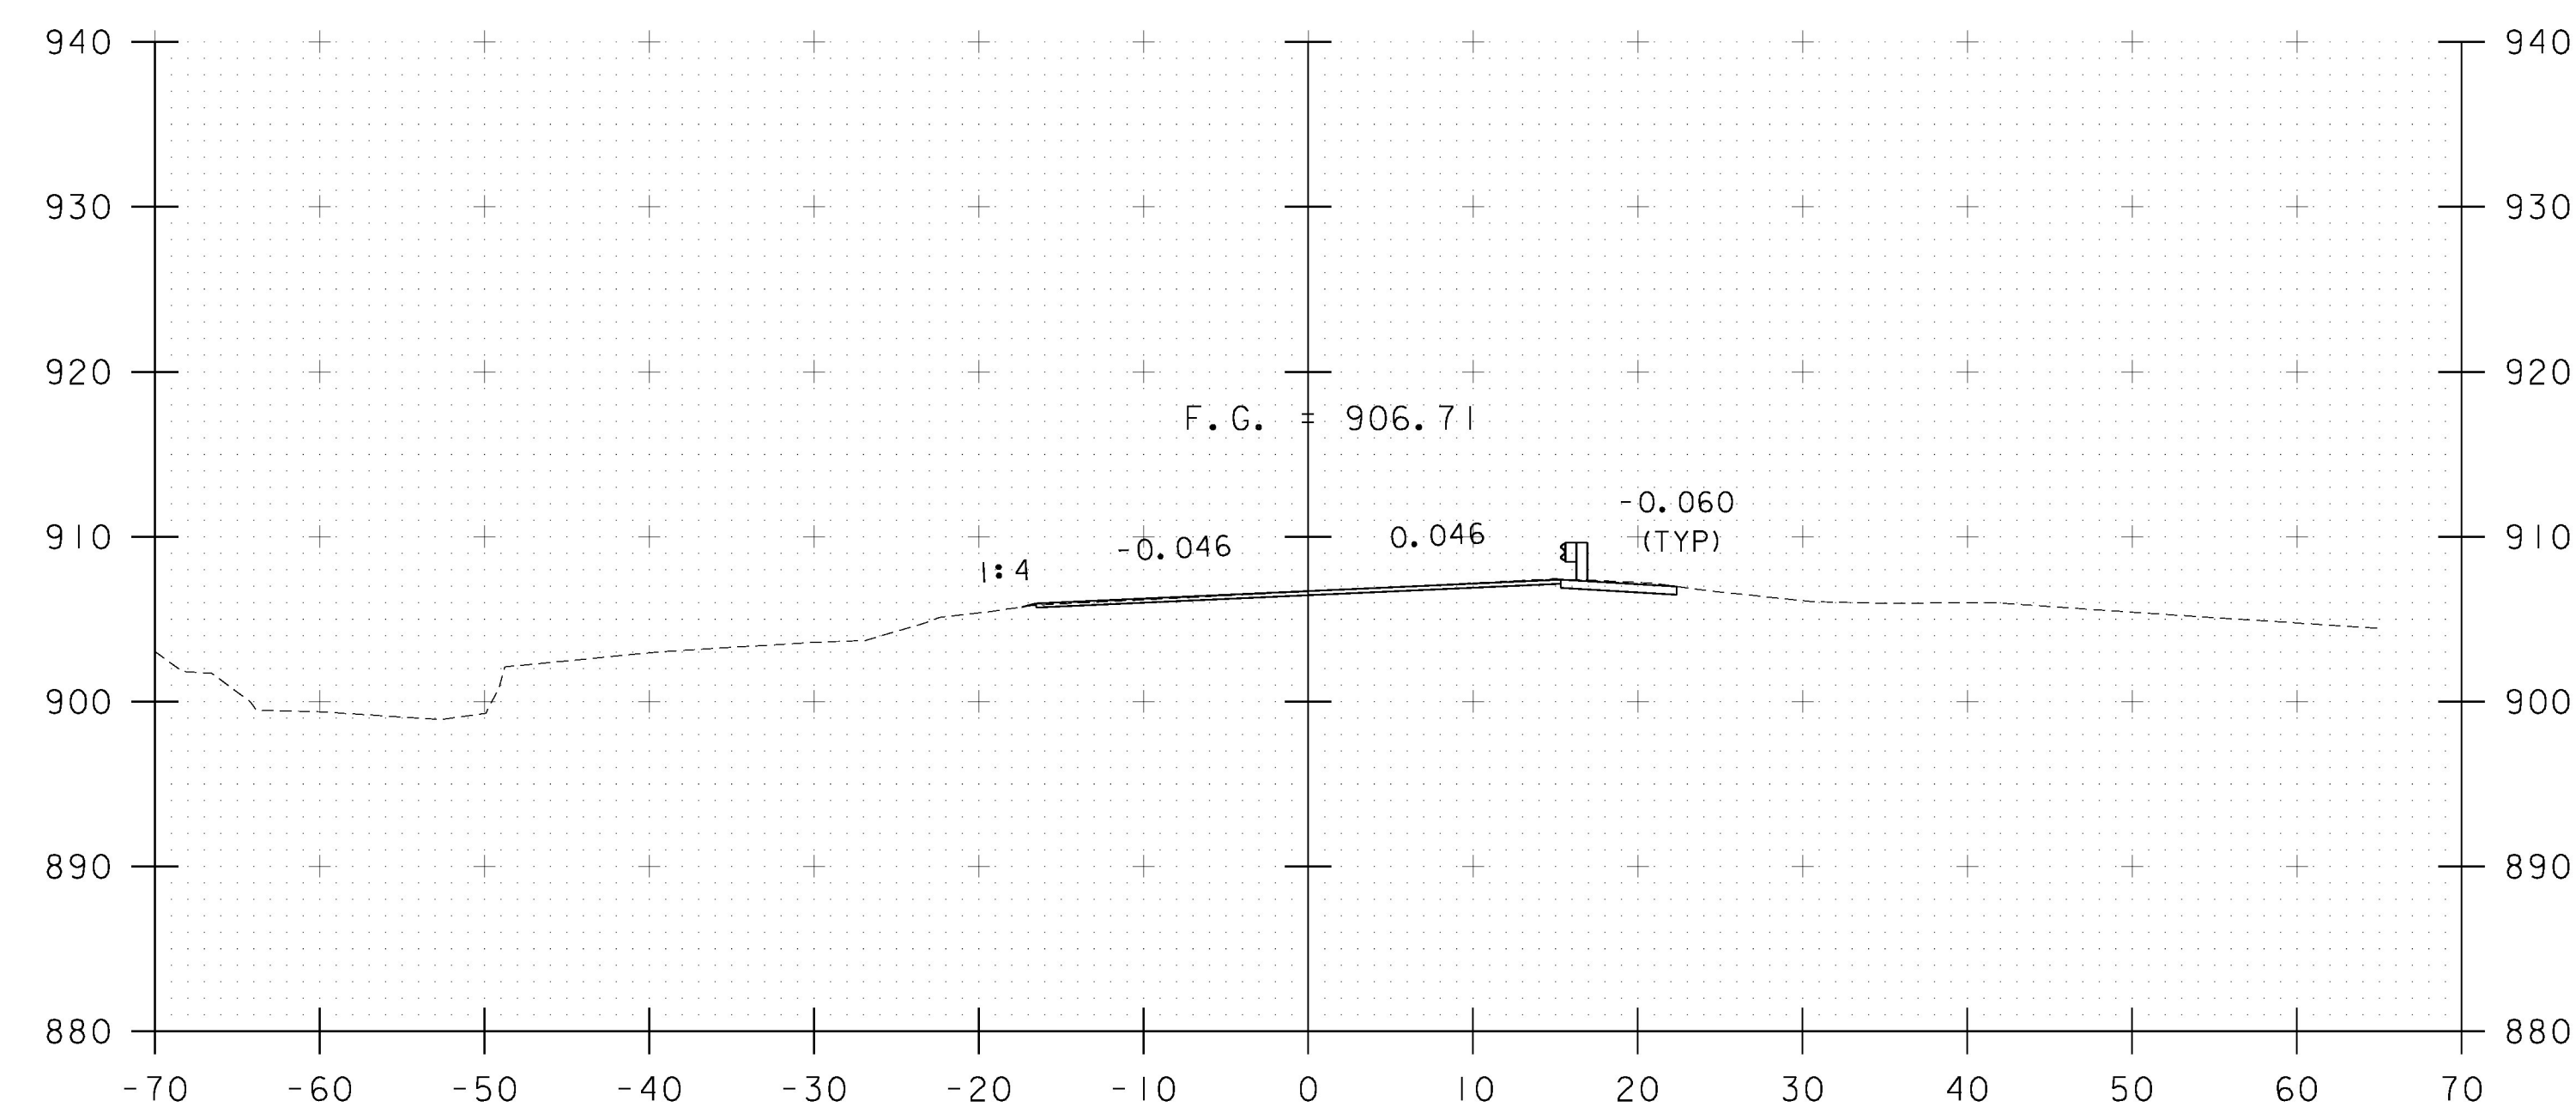

105+25

STA. 104+75 TO STA. 105+50



PROJECT NAME: WATERFORD	
PROJECT NUMBER: BF 0225(4)	
FILE NAME: z13c268xs.dgn	PLOT DATE: 09/27/2017
PROJECT LEADER: T. LEVINS	DRAWN BY: A. KURDEKAR
DESIGNED BY: J. MERCER	CHECKED BY: T. LEVINS
MAINLINE SECTIONS I	SHEET 21 OF 63