




107+00

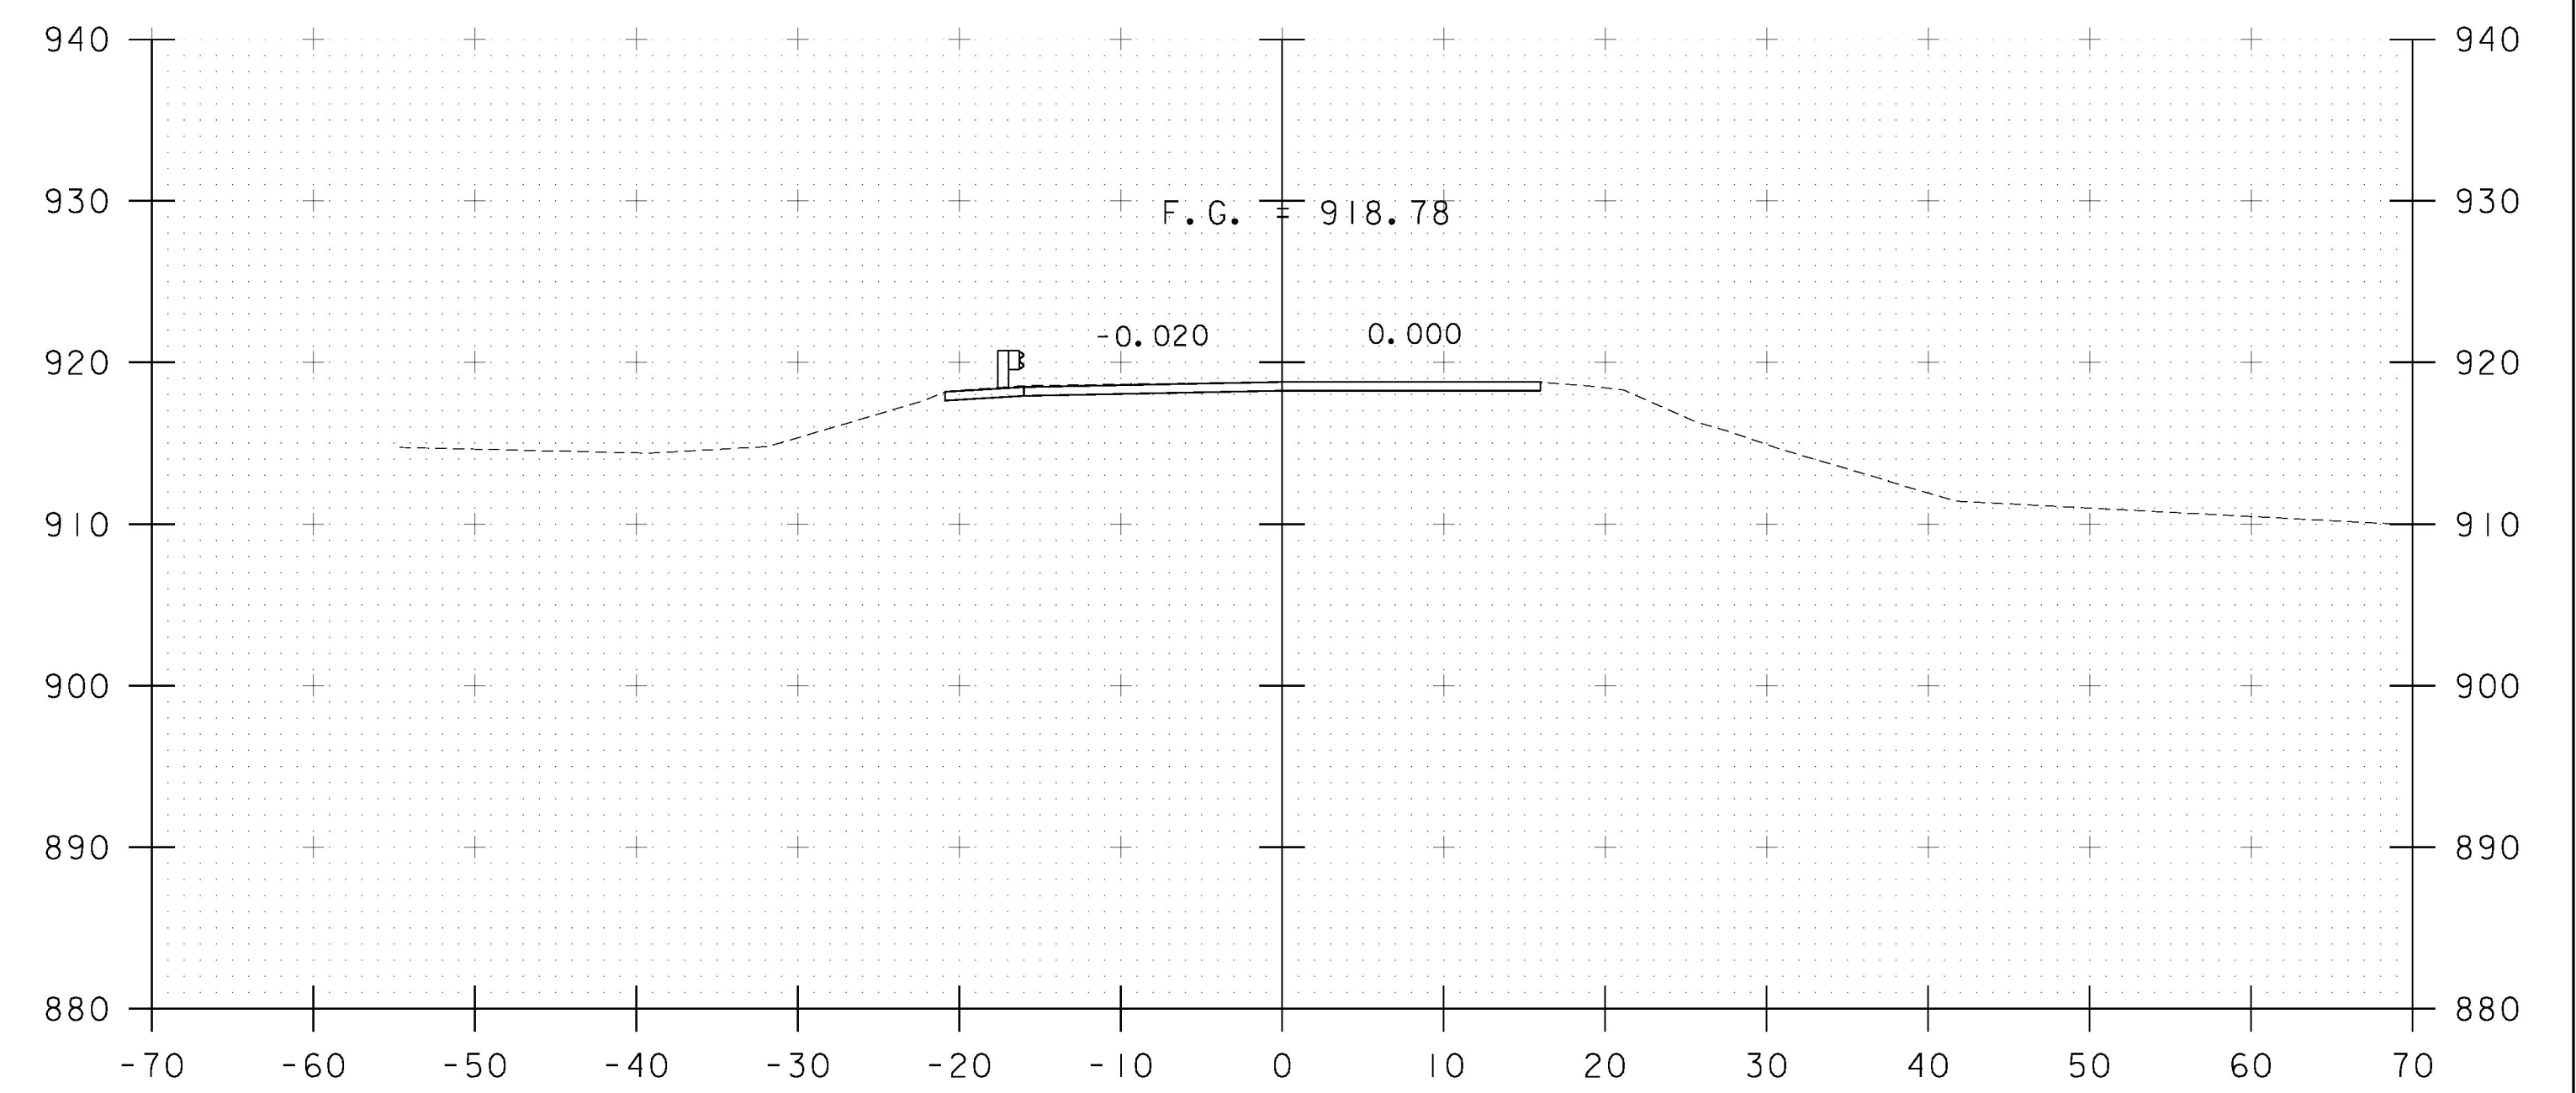

107+50
END PROJECT

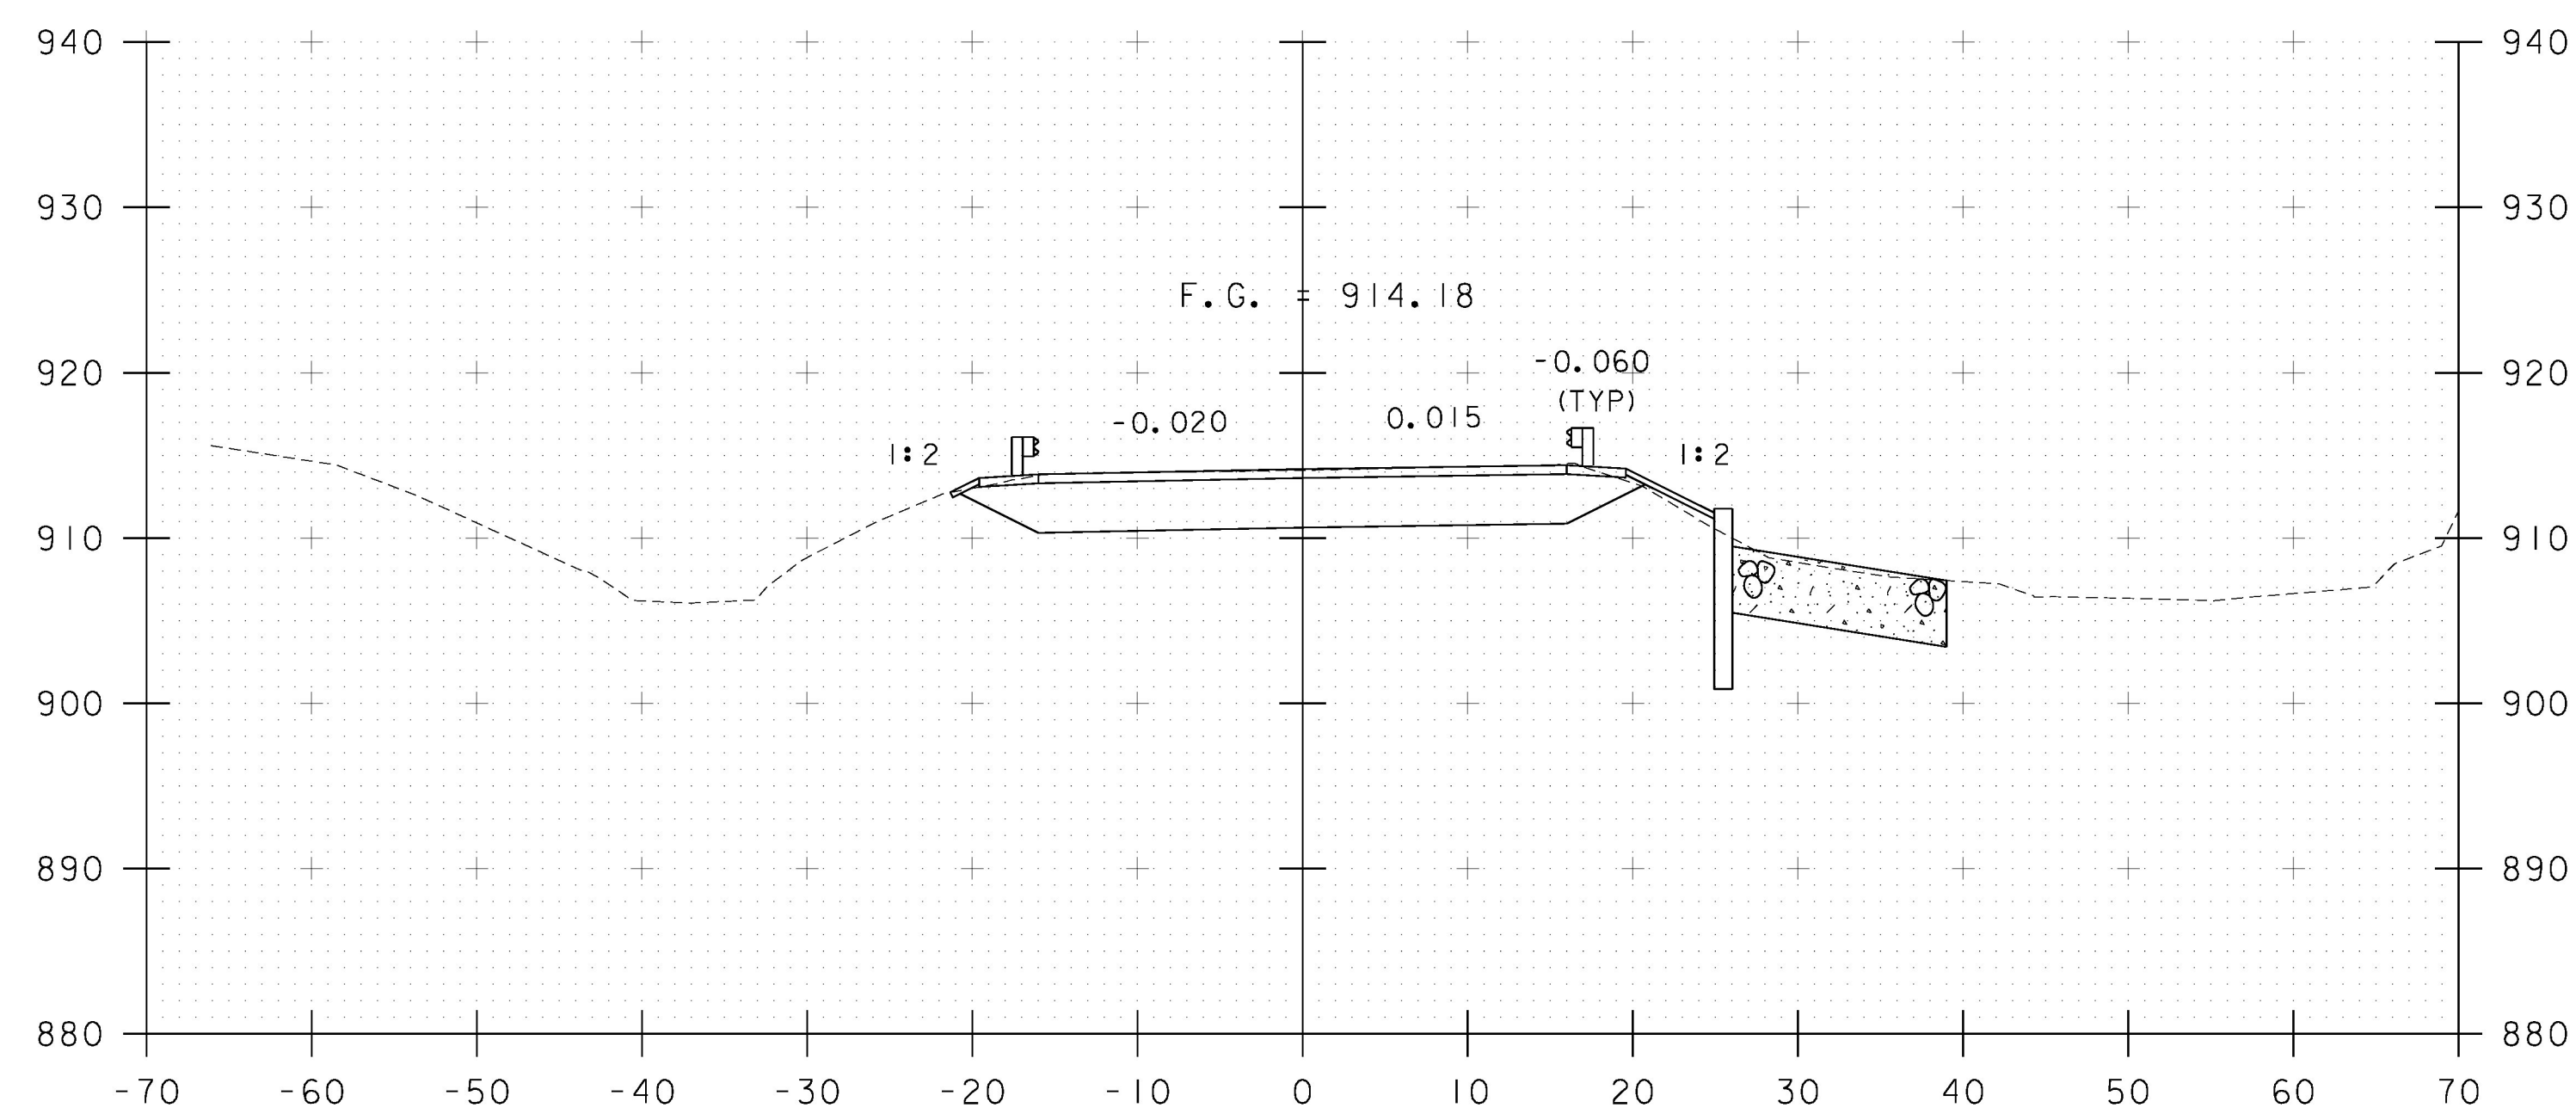

106+75
END BRIDGE @ 106+59.58

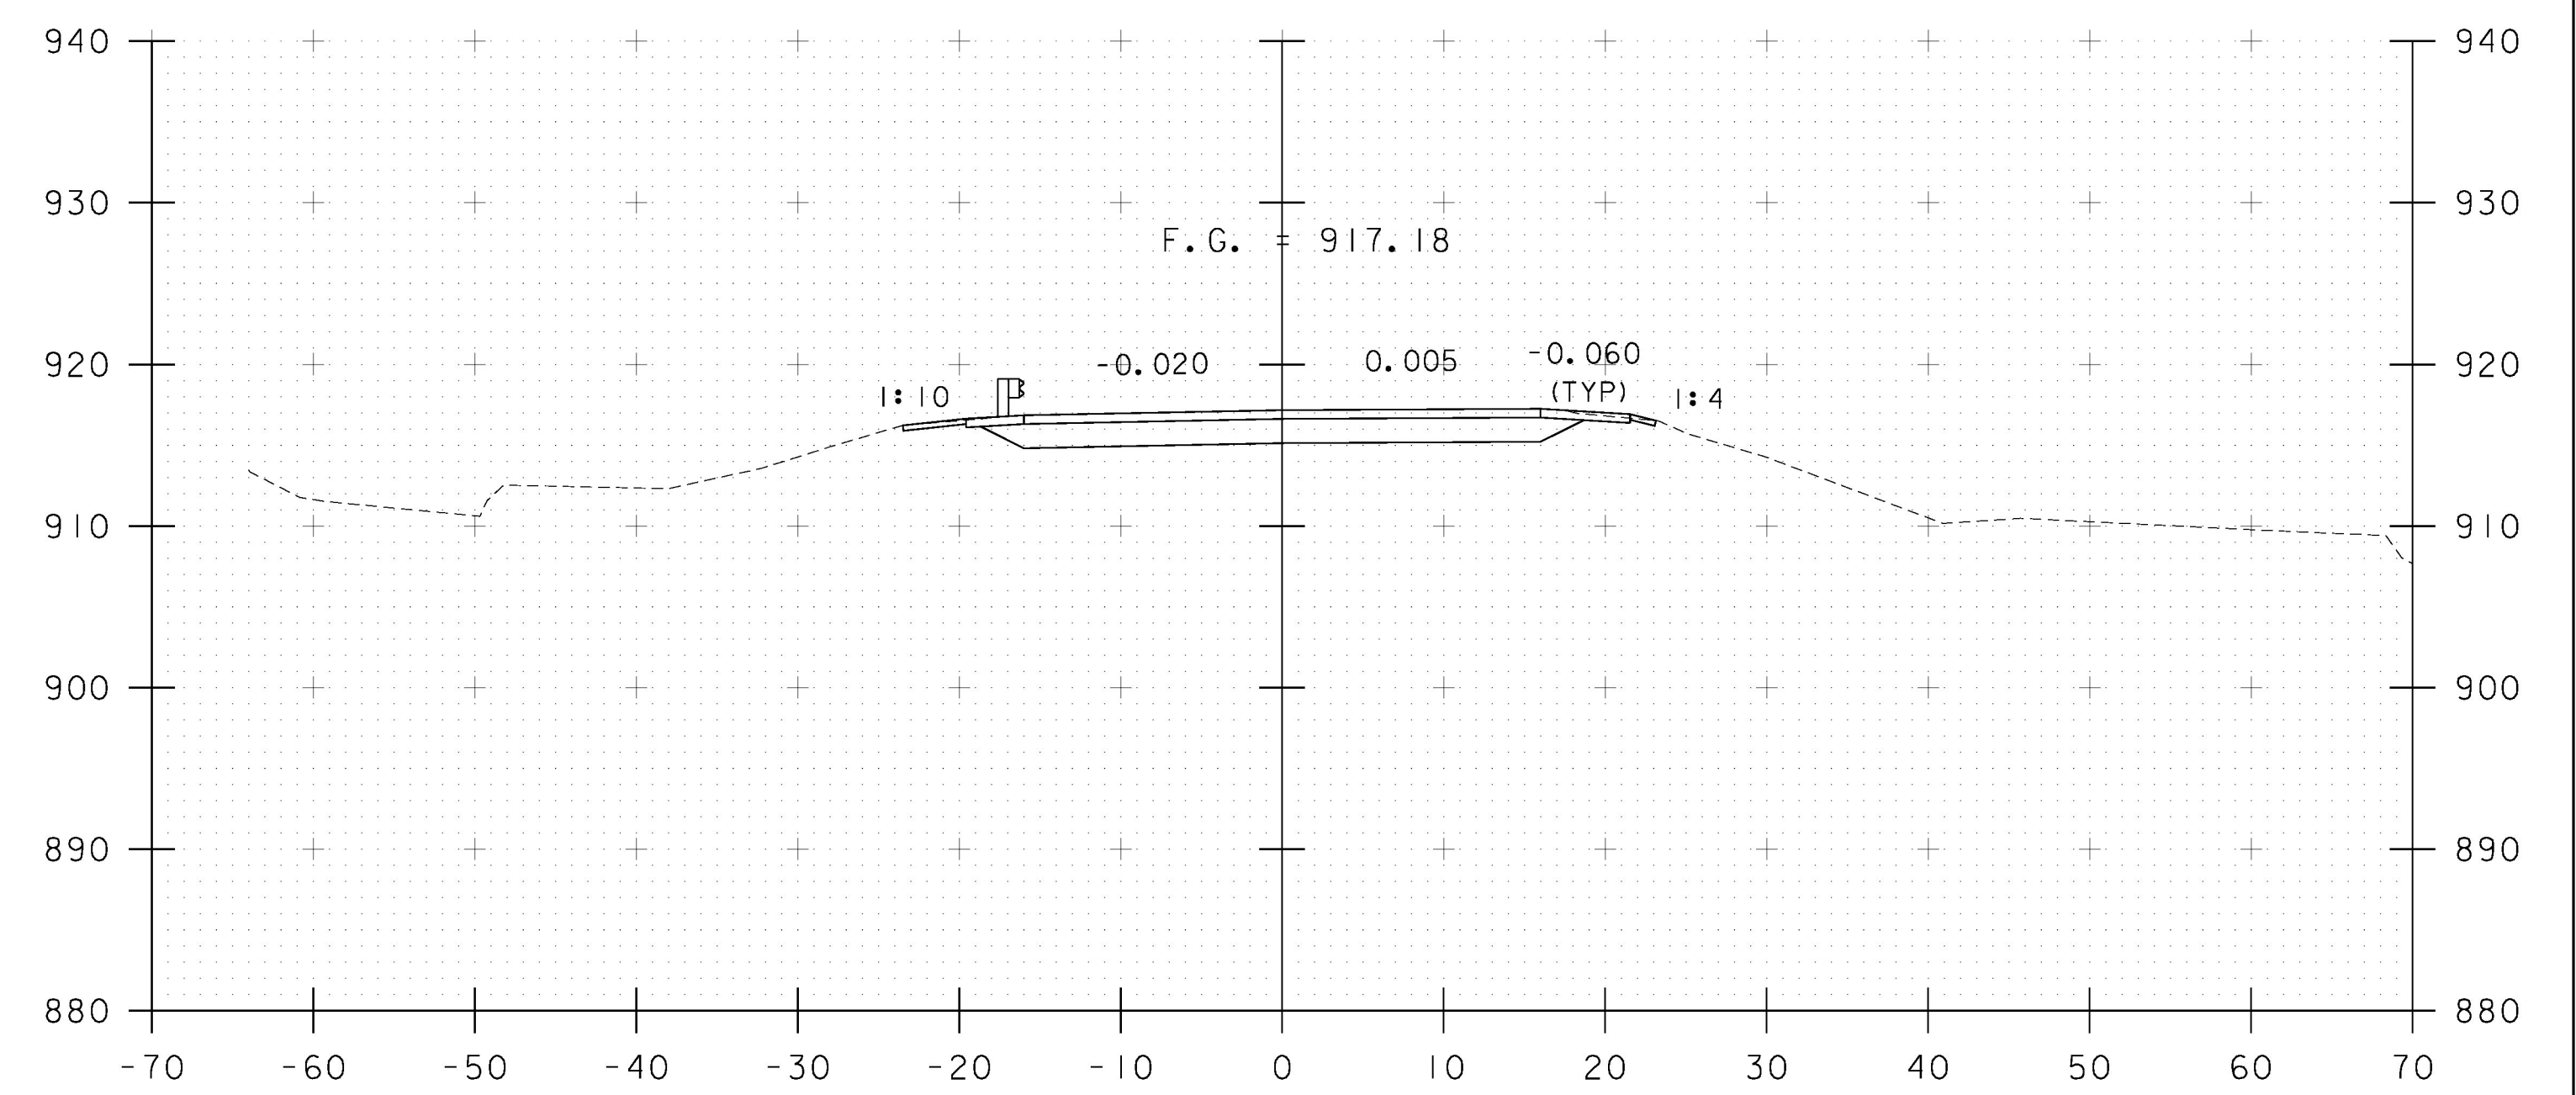

107+25

STA. 106+75 TO STA. 107+50



PROJECT NAME:	WATERFORD	
PROJECT NUMBER:	BF 0225(4)	
FILE NAME:	z13c268xs.dgn	PLOT DATE: 09/27/2017
PROJECT LEADER:	T. LEVINS	DRAWN BY: A. KURDEKAR
DESIGNED BY:	J. MERCER	CHECKED BY: T. LEVINS
MAINLINE SECTIONS 3		SHEET 23 OF 63