


STEEL BEAM GUARDRAIL, GALVANIZED
 STA. 3+23.6 - ~~4+86.2~~, RT 5+36.2 RT
 STA. 2+63.5 - ~~5+69.5~~, LT 6+19.5 LT

ANCHOR FOR STEEL BEAM RAIL
 STA. 3+23.0, RT
 STA. ~~4+79.5~~, RT 5+53.4 RT
 STA. 2+69.8, LT
 STA. ~~5+62.9~~, LT 5+87.9 LT

DELINEATOR WITH STEEL POST
 STA. 2+62, LT (GREEN)
 STA. 3+24, RT (BLUE)
 STA. ~~4+88~~, RT (GREEN) 5+38 RT
 STA. 5+71, ~~LT (BLUE)~~ 6+21 LT

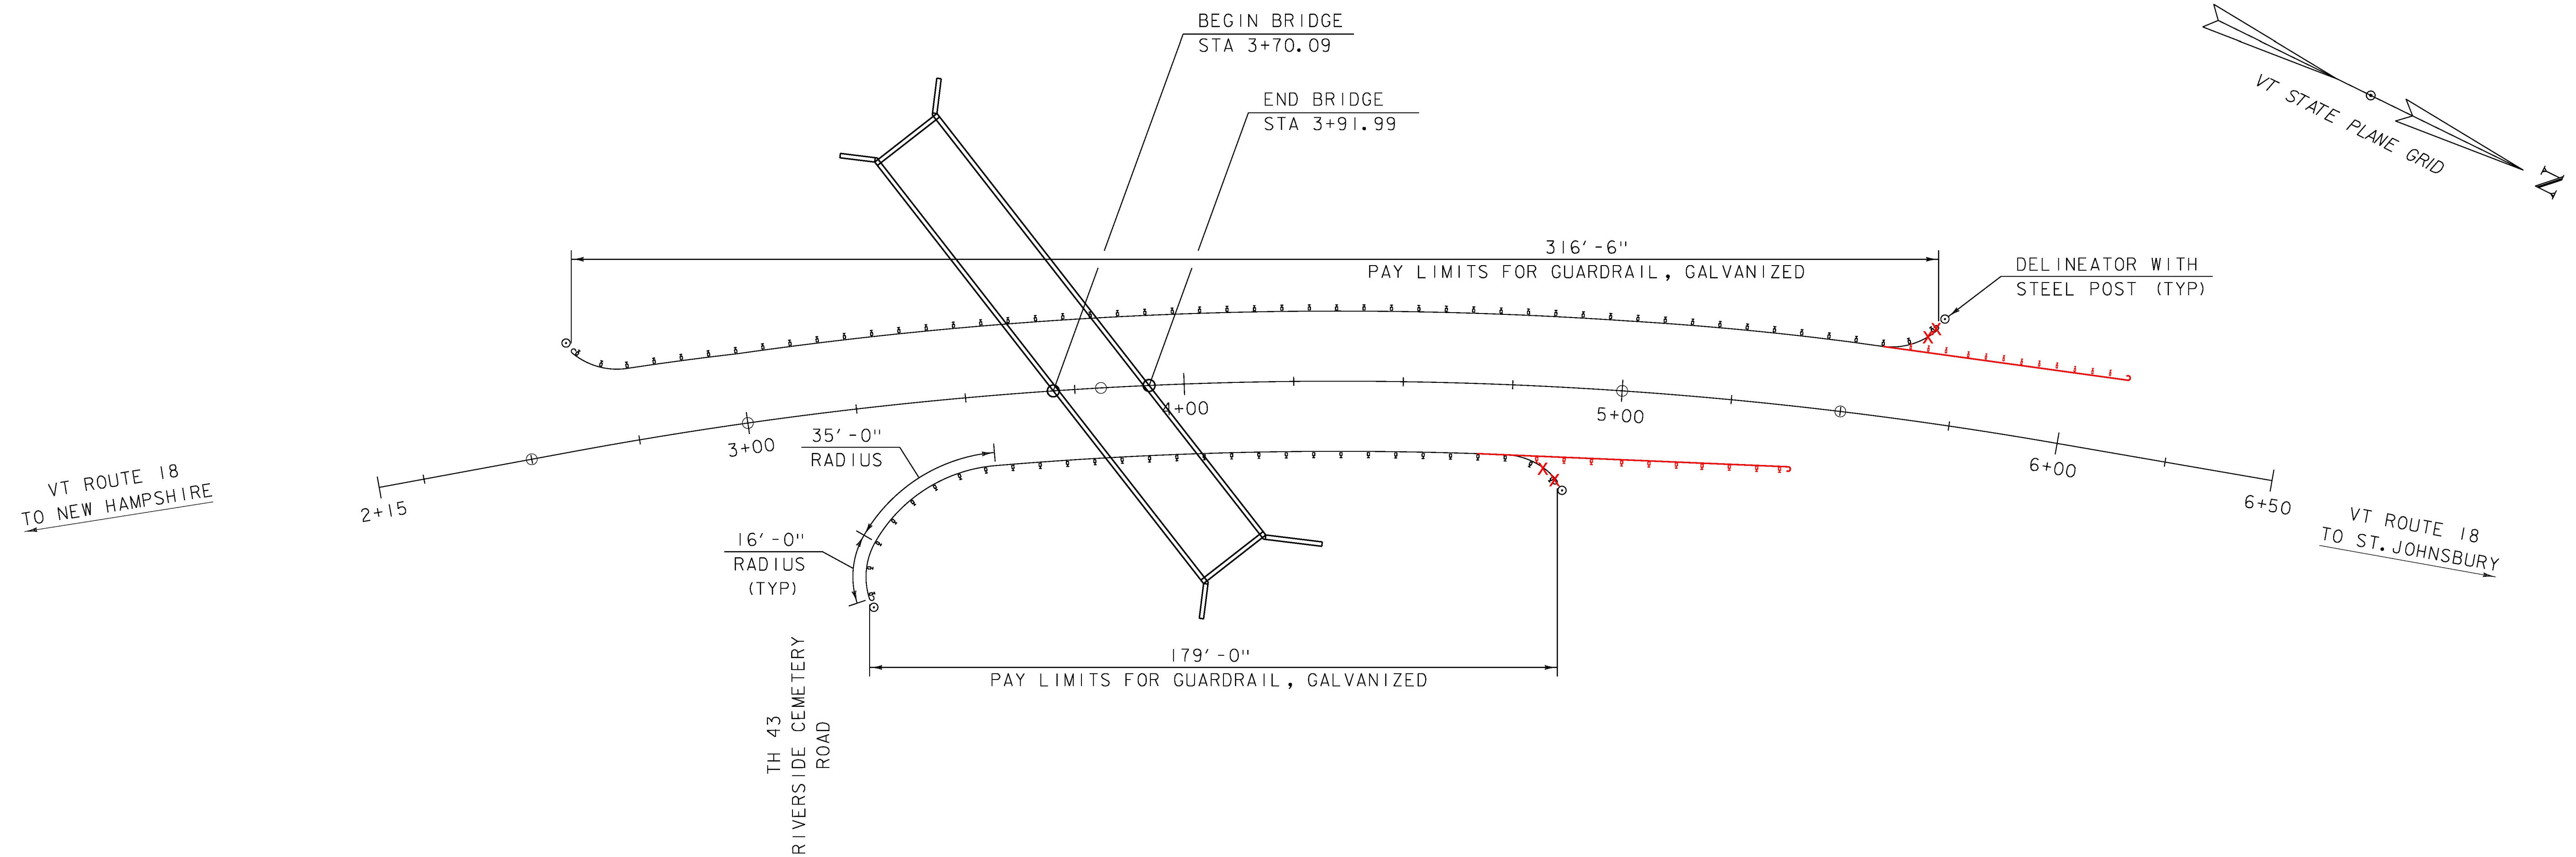

NOTES:

1) SEE STANDARDS G-1 AND G-1d FOR ADDITIONAL INFORMATION.

RAIL LAYOUT

SCALE 1" = 20'-0"
 20 0 20



PROJECT NAME:	WATERFORD	
PROJECT NUMBER:	BF 0225(5)	
FILE NAME:	z15b051r-all.dgn	PLOT DATE: 09/27/2017
PROJECT LEADER:	T. LEVINS	DRAWN BY: B. WILLIAMS
DESIGNED BY:	J. MERCER	CHECKED BY: T. LEVINS
RAIL LAYOUT SHEET		SHEET 48 OF 63