




2+50  
BEGIN APPROACH

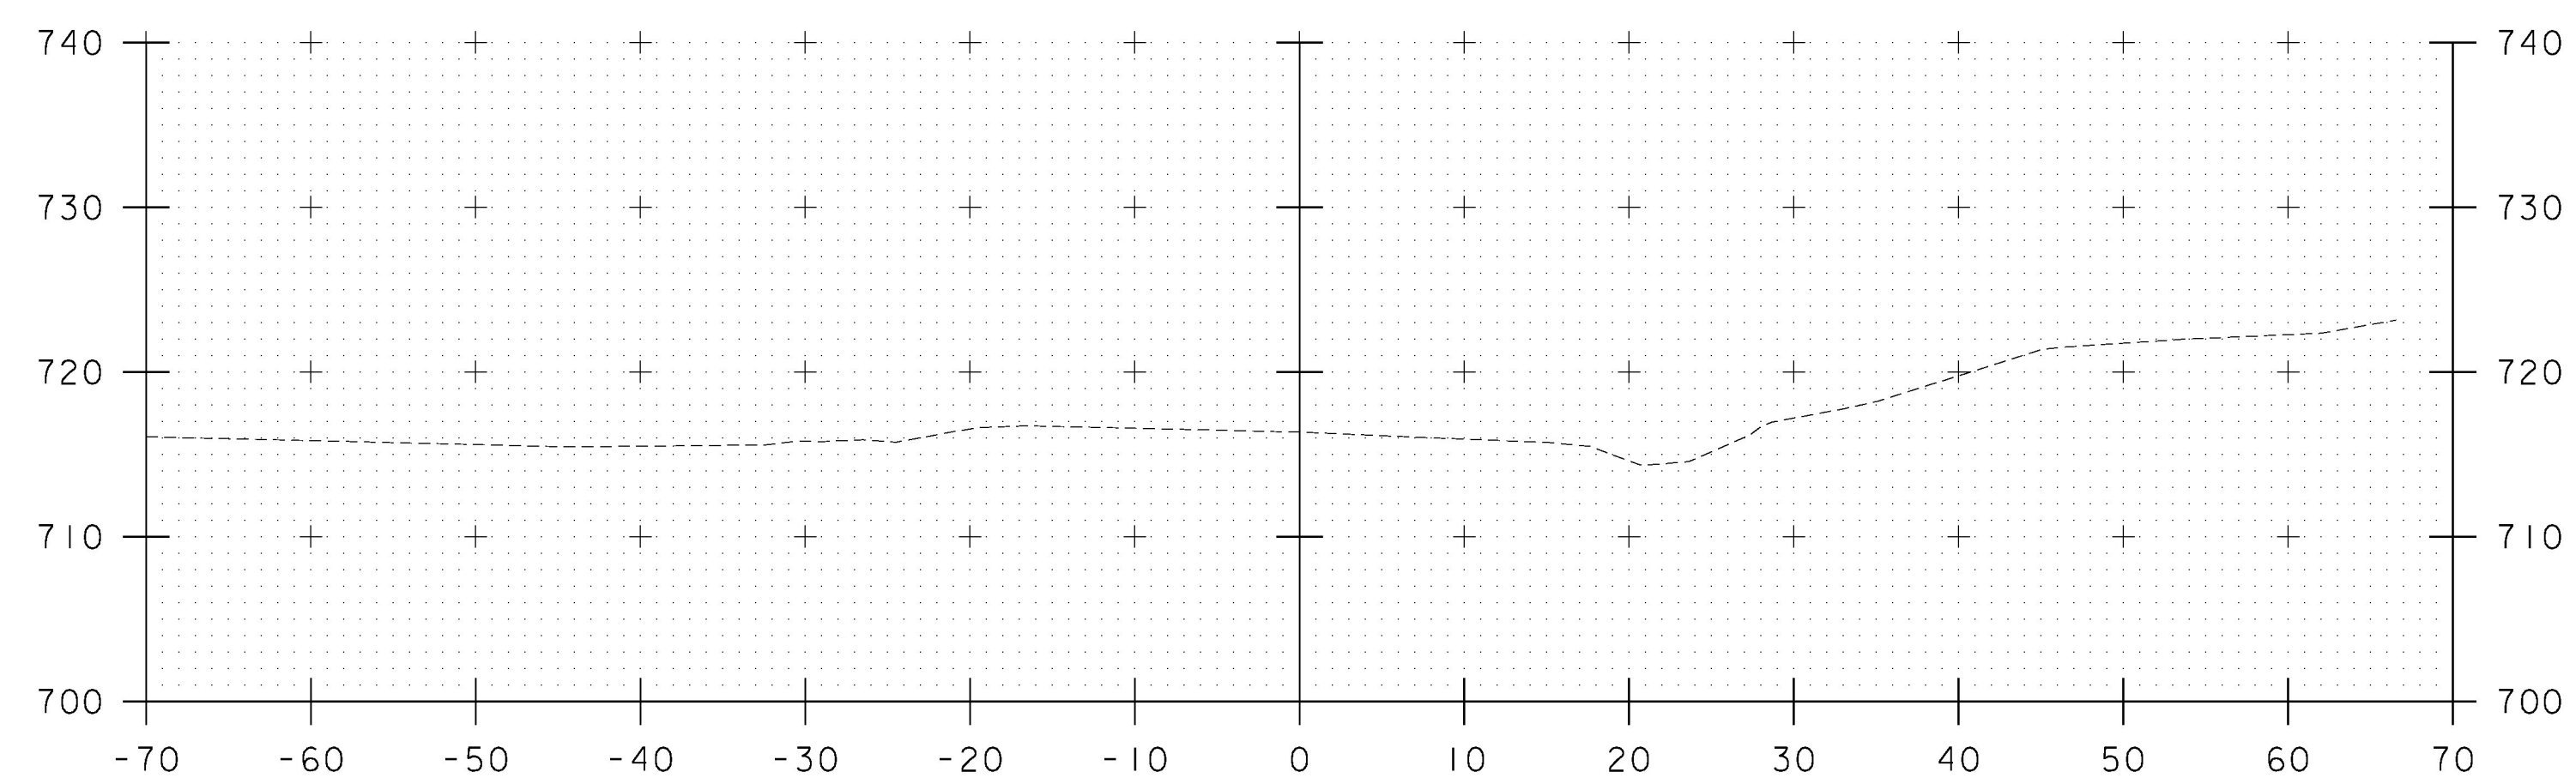


2+25

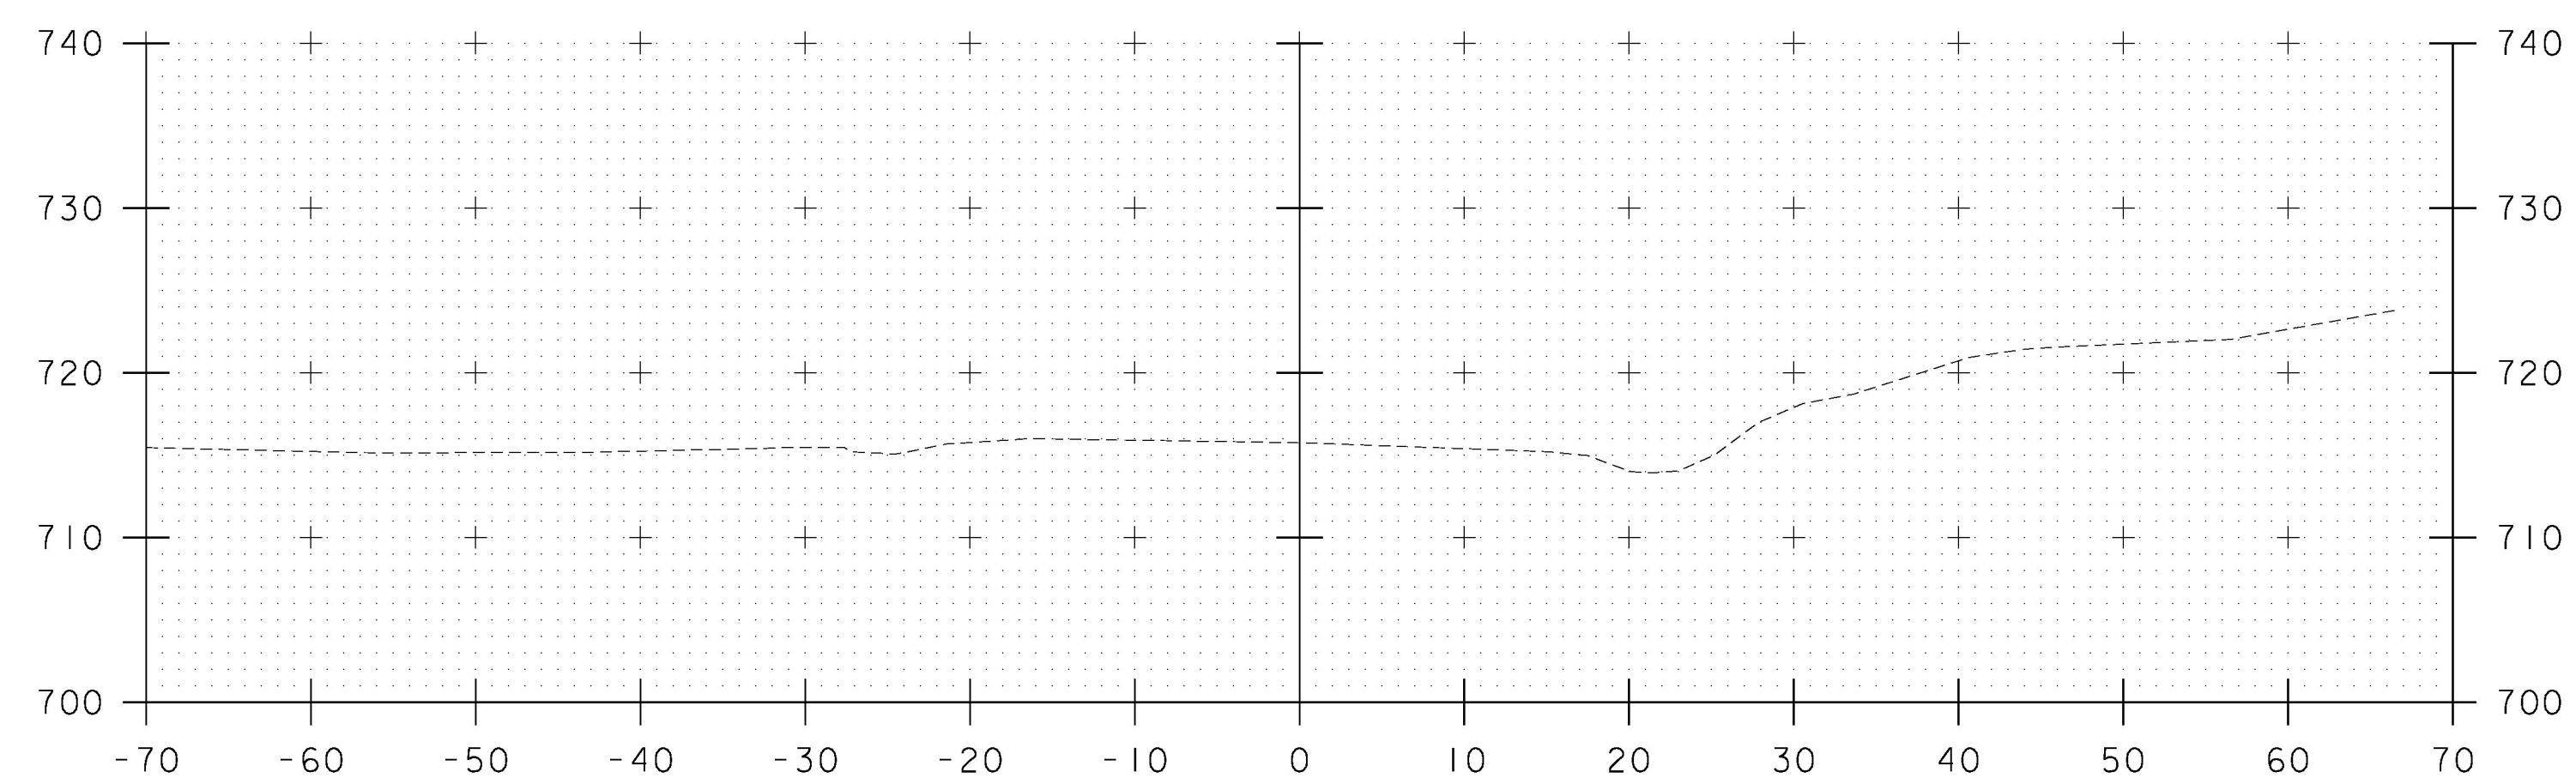

2+15

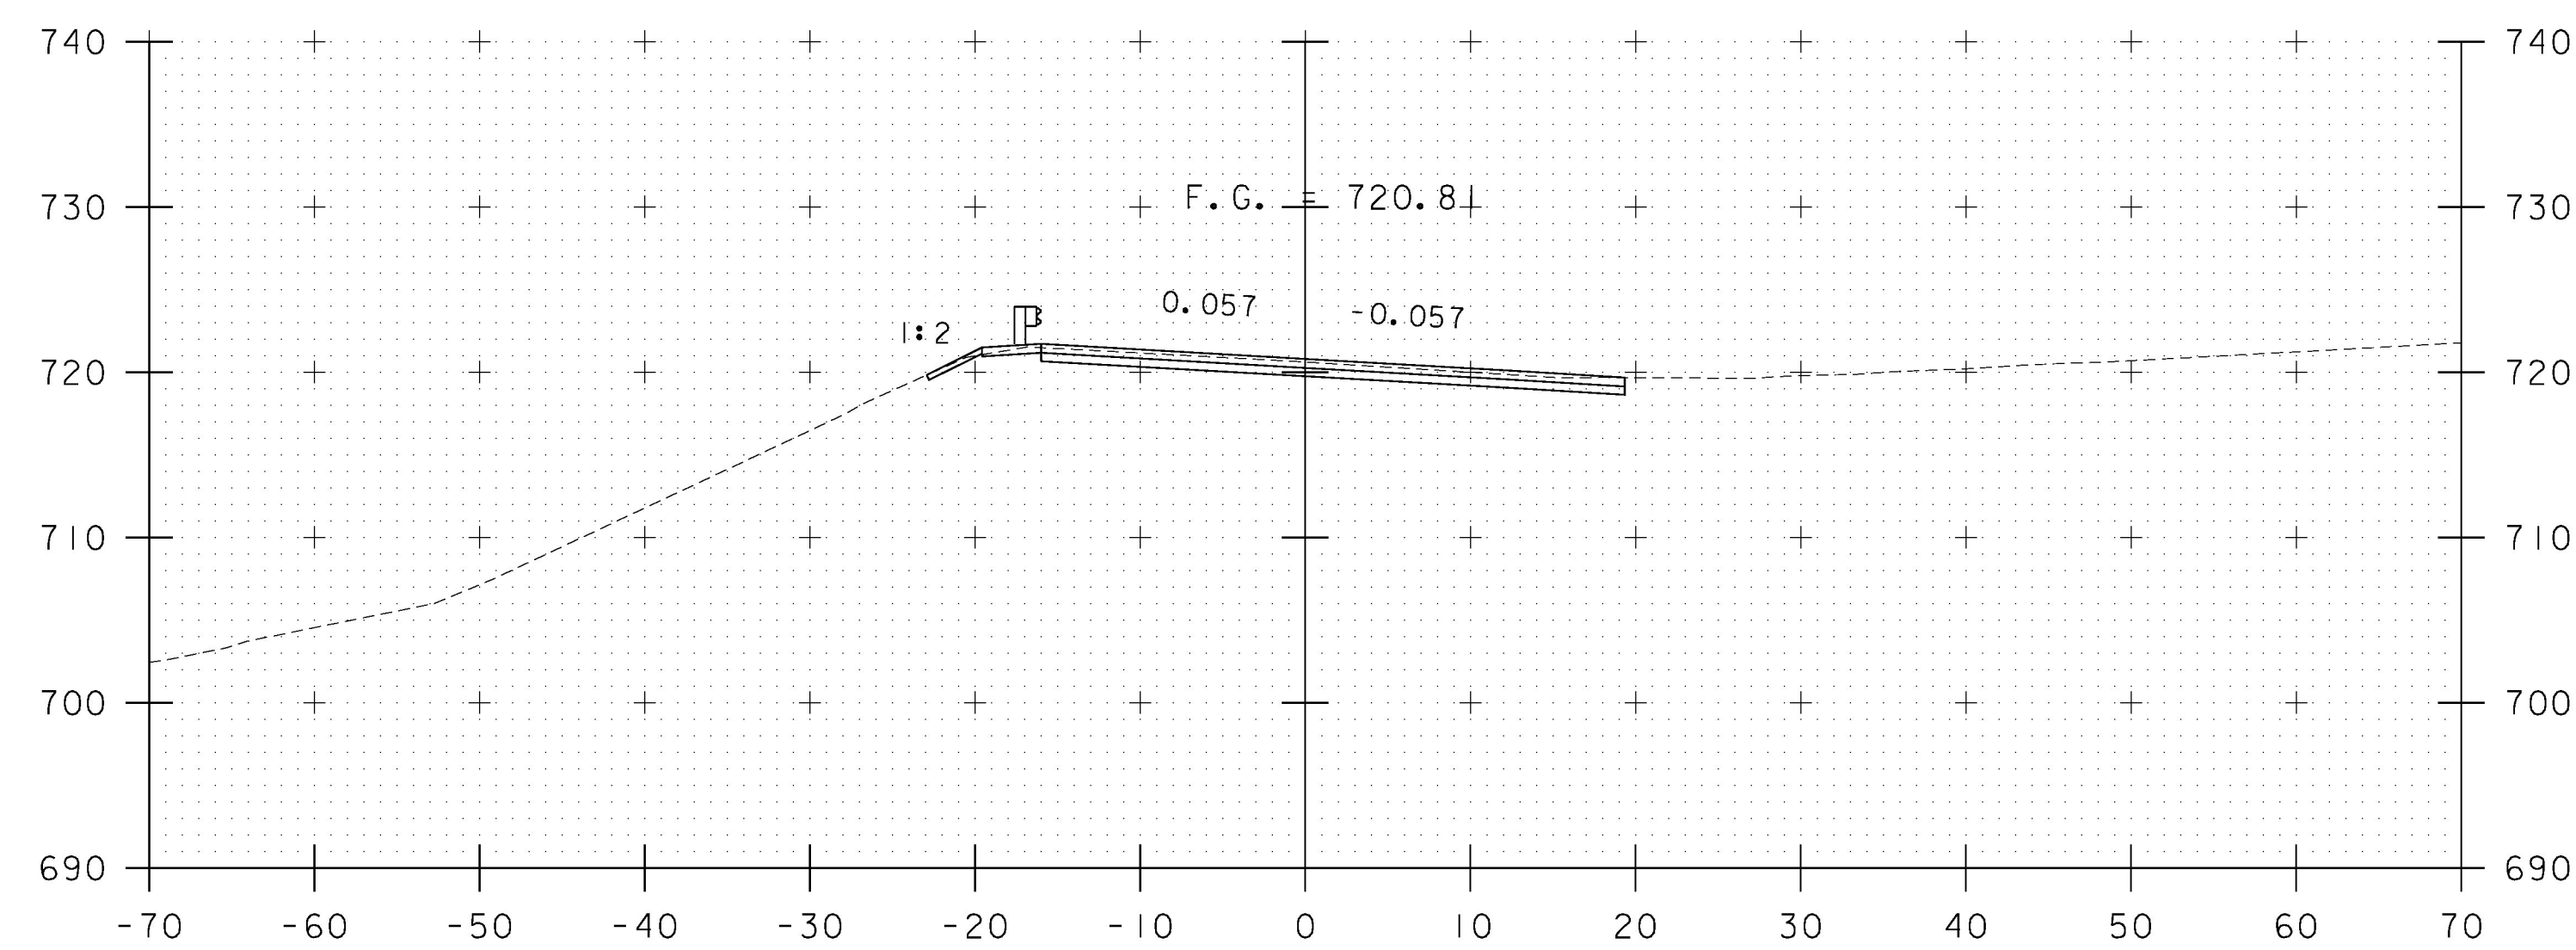

3+00  
BEGIN PROJECT

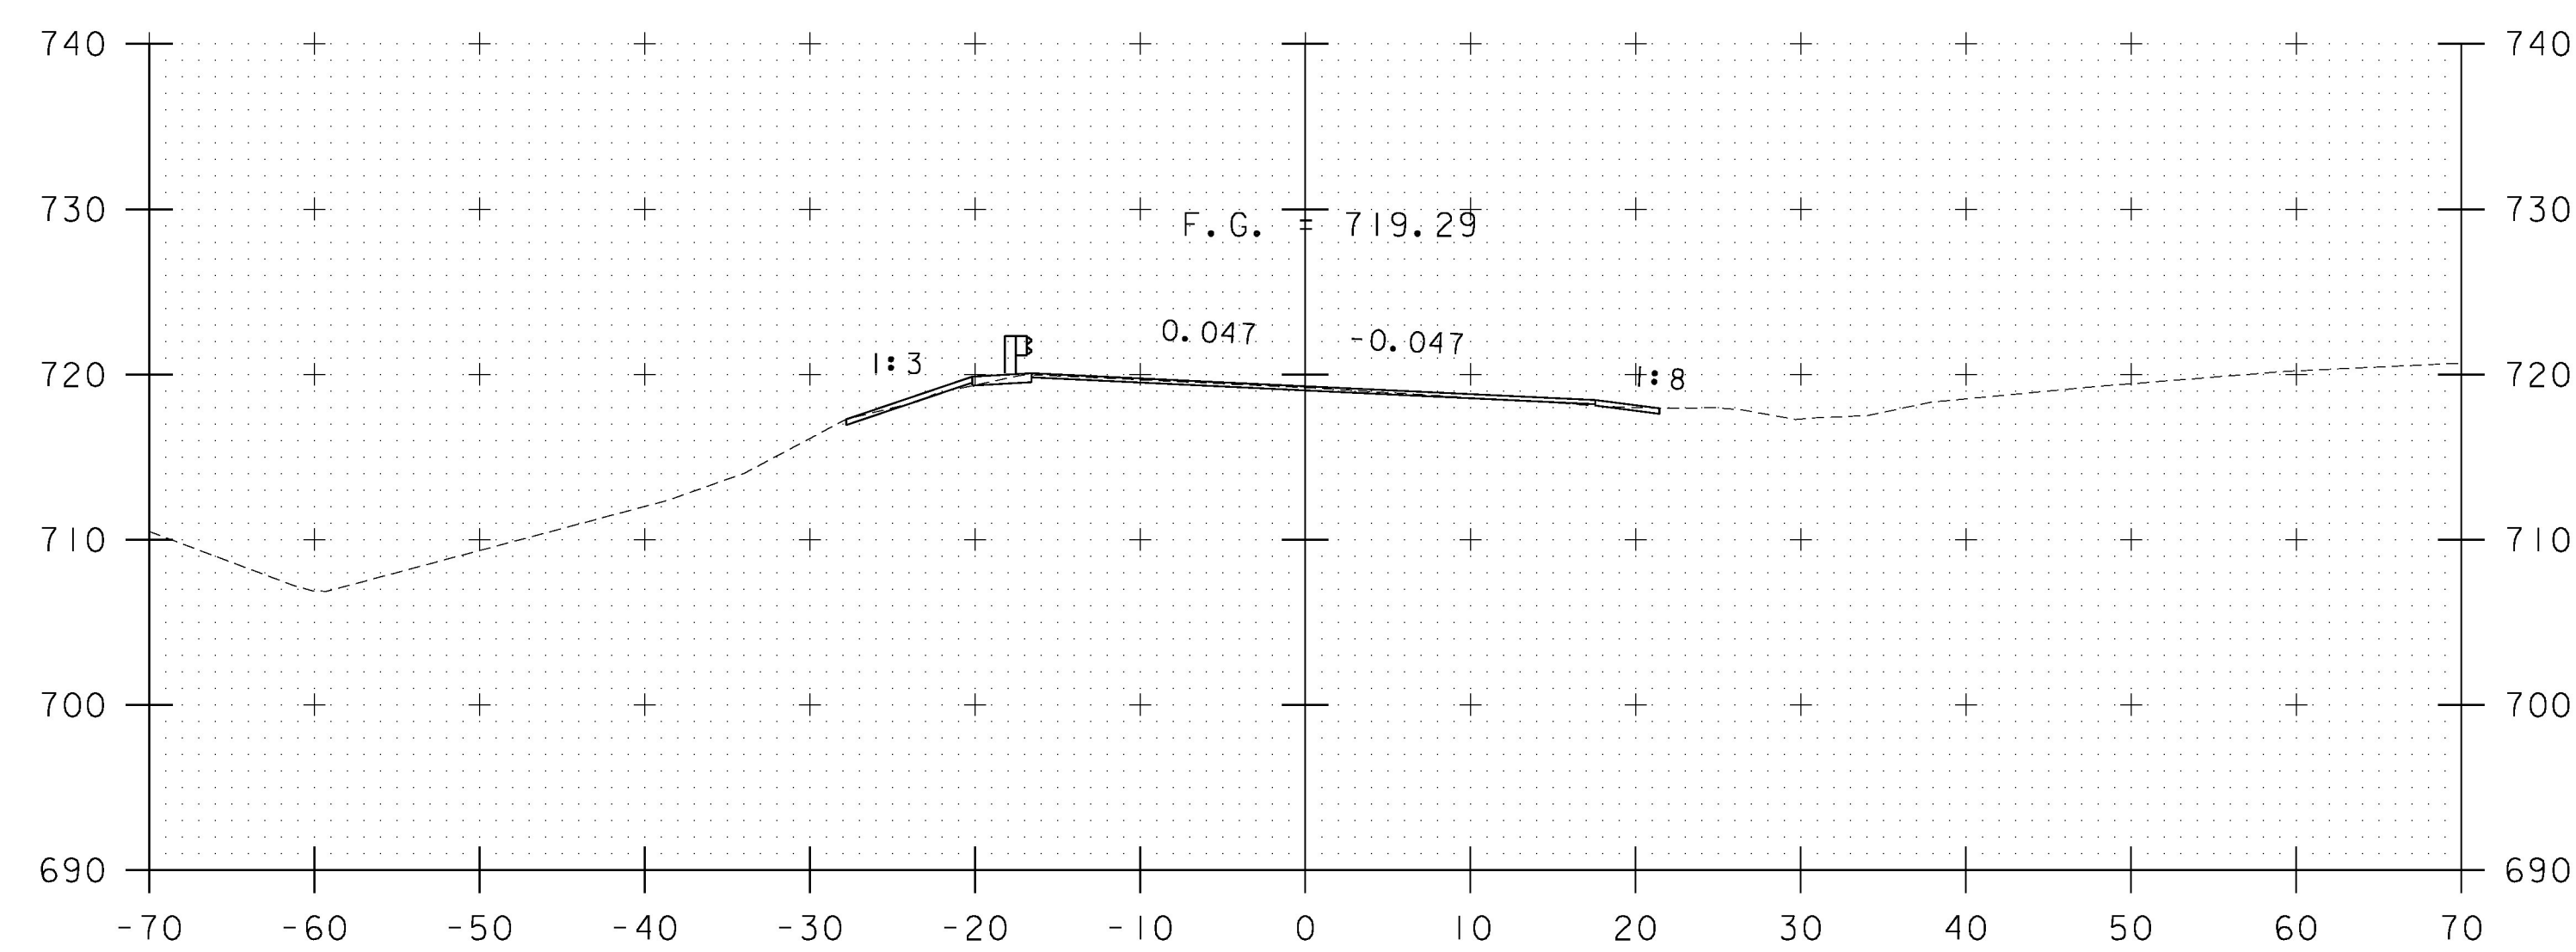

2+75

STA. 2+15 TO STA. 3+00



PROJECT NAME: WATERFORD	
PROJECT NUMBER: BF 0225(5)	
FILE NAME: z15b051xs.dgn	PLOT DATE: 09/27/2017
PROJECT LEADER: T. LEVINS	DRAWN BY: A. KURDEKAR
DESIGNED BY: A. KURDEKAR/J. MERCER	CHECKED BY: T. LEVINS
MAINLINE SECTIONS I	SHEET 49 OF 63