




APPROX. LOCATION OF EXISTING  
UTILITY OHW TO REMAIN IN PLACE  
(VISUAL SHIELDING TO BE INSTALLED  
BY FAIRPOINT PRIOR TO CONSTRUCTION)

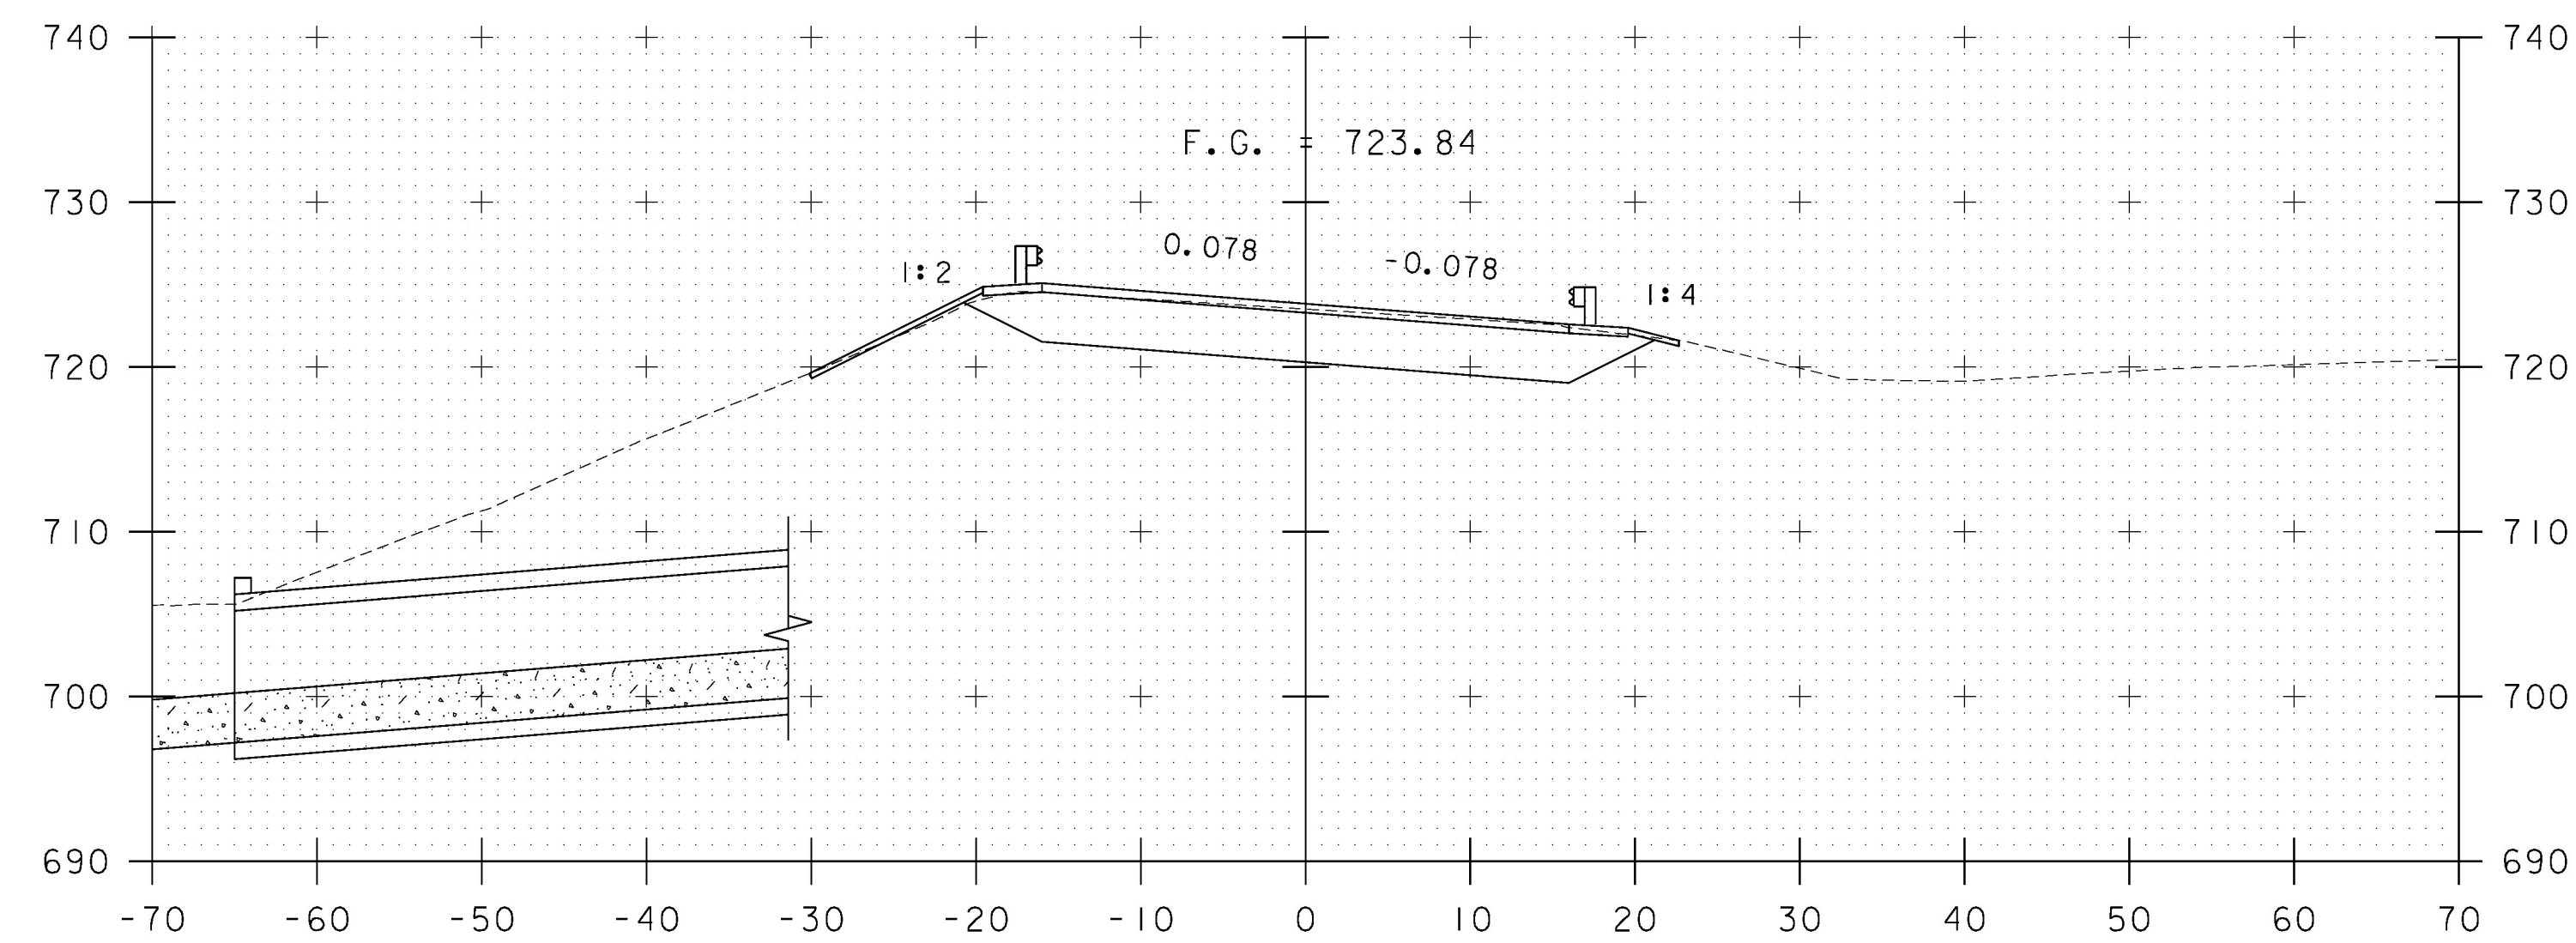


3+50

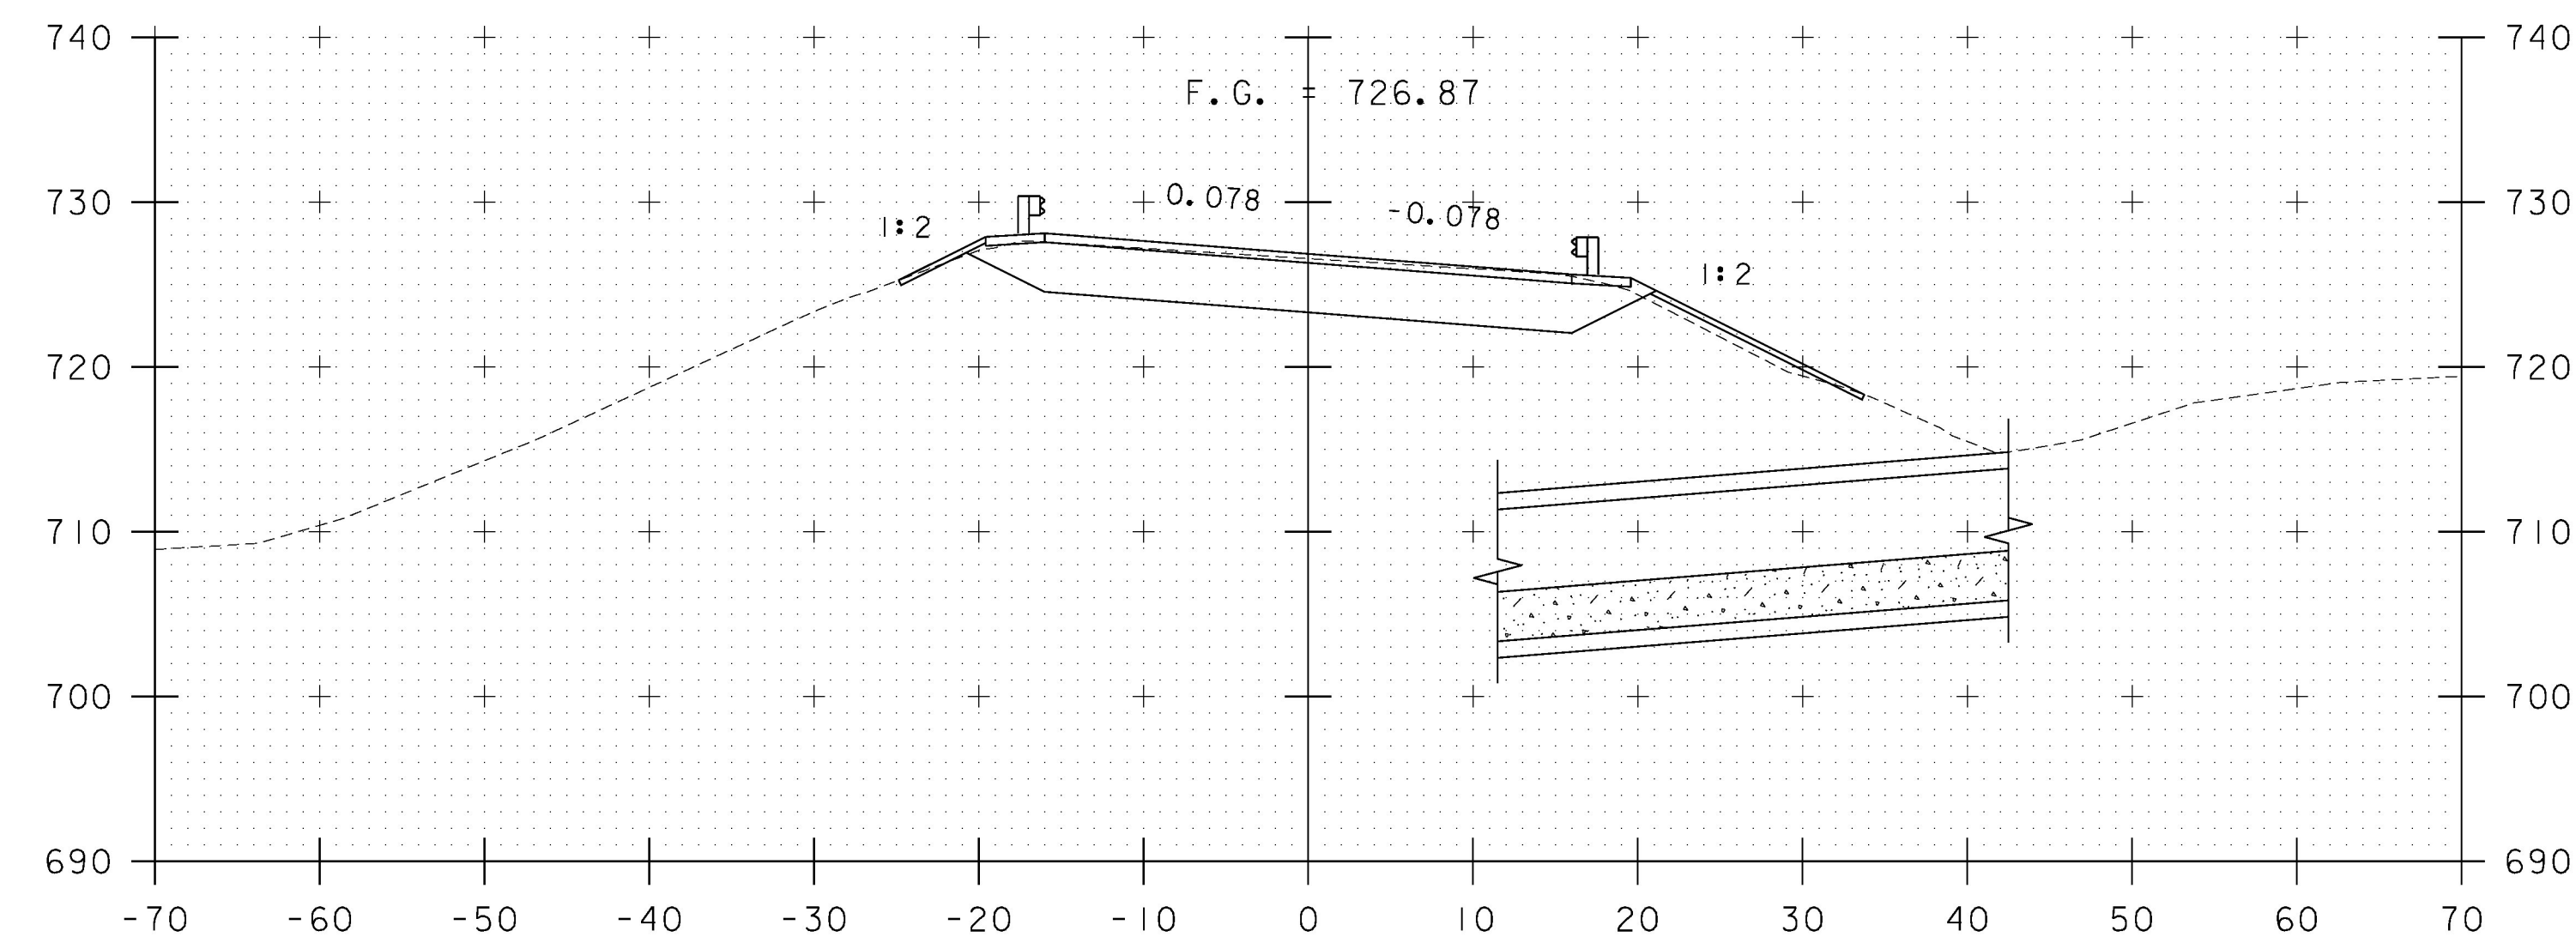

4+00  
END BRIDGE @ 3+91.99

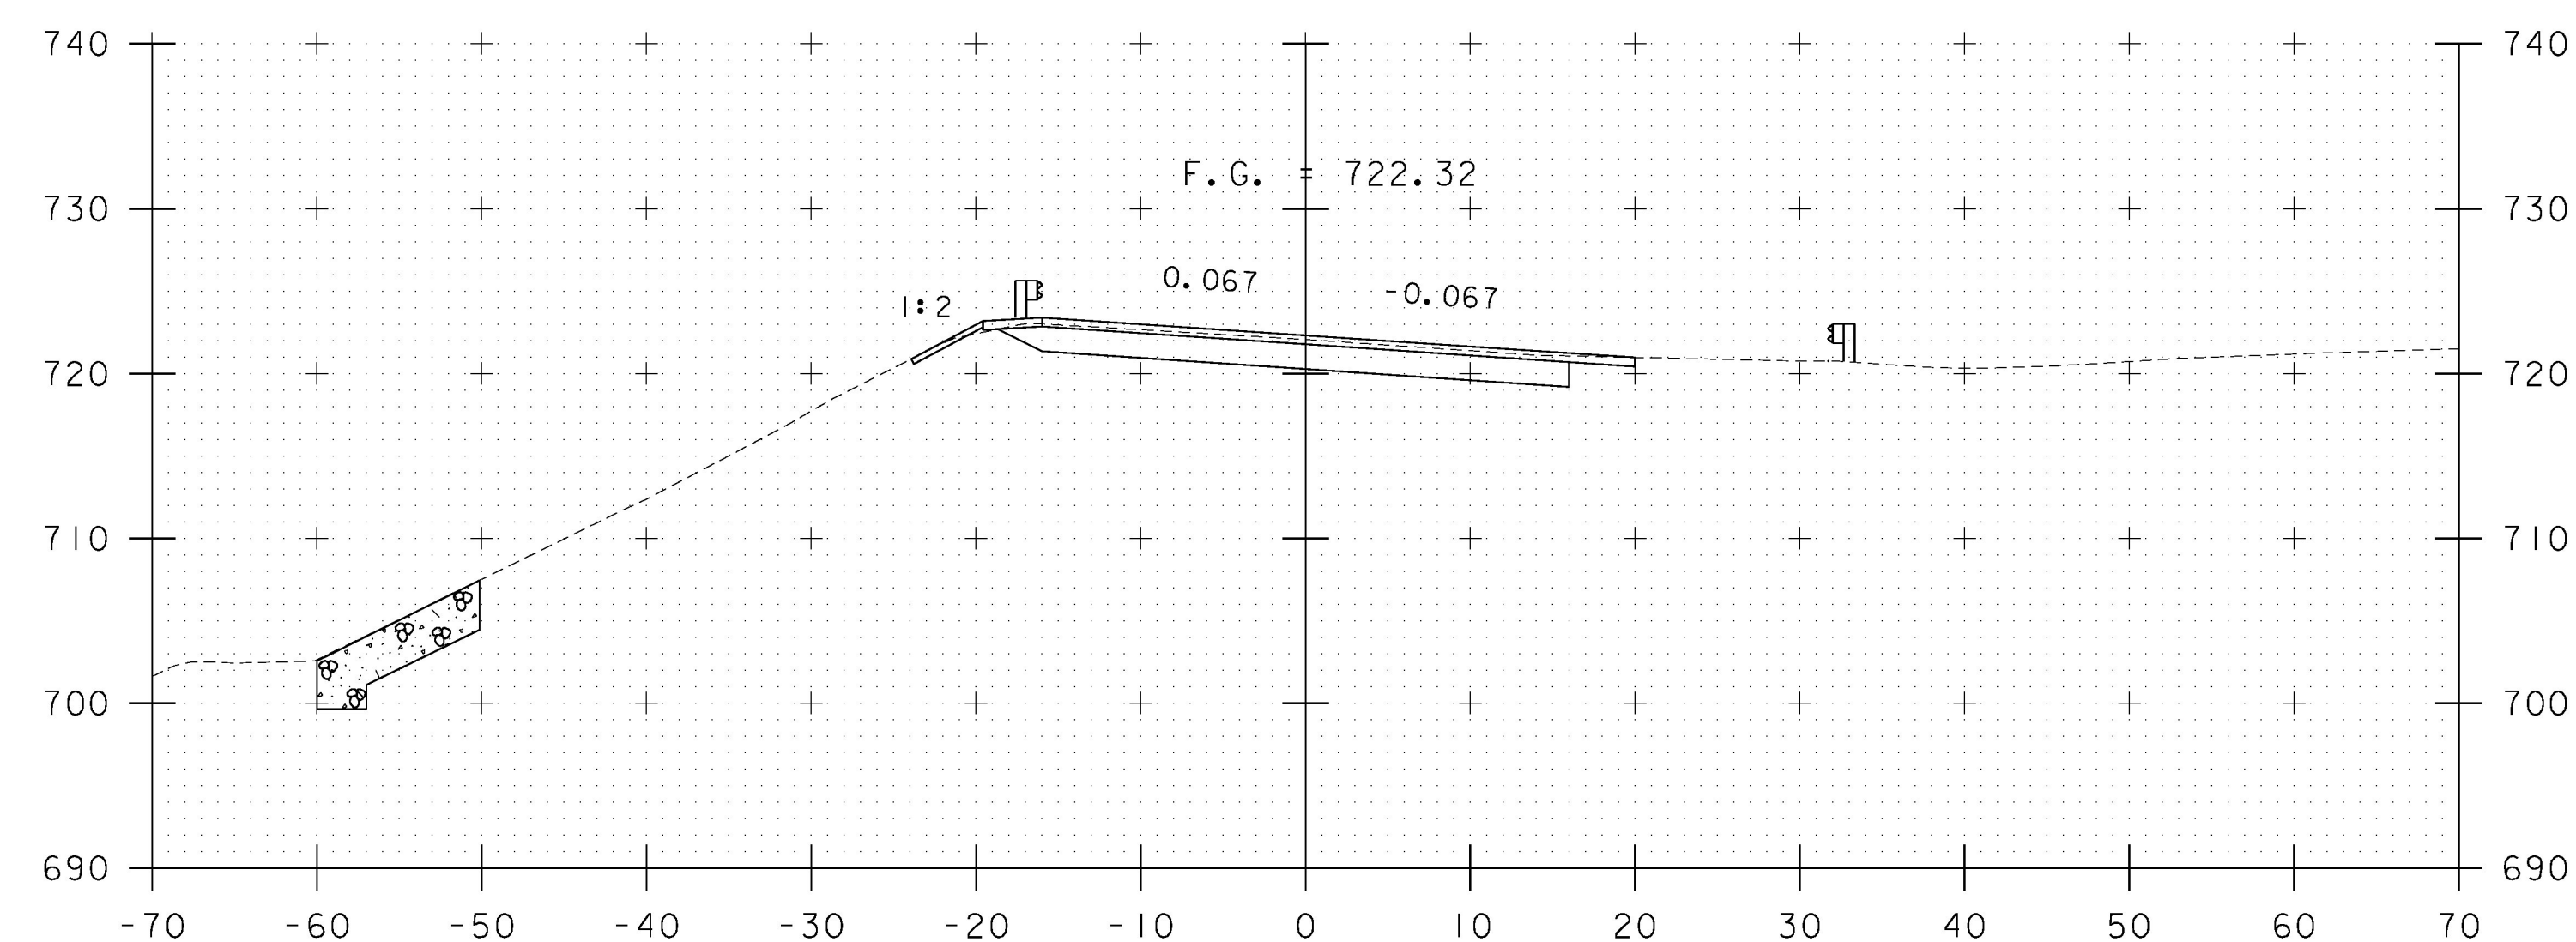

3+25

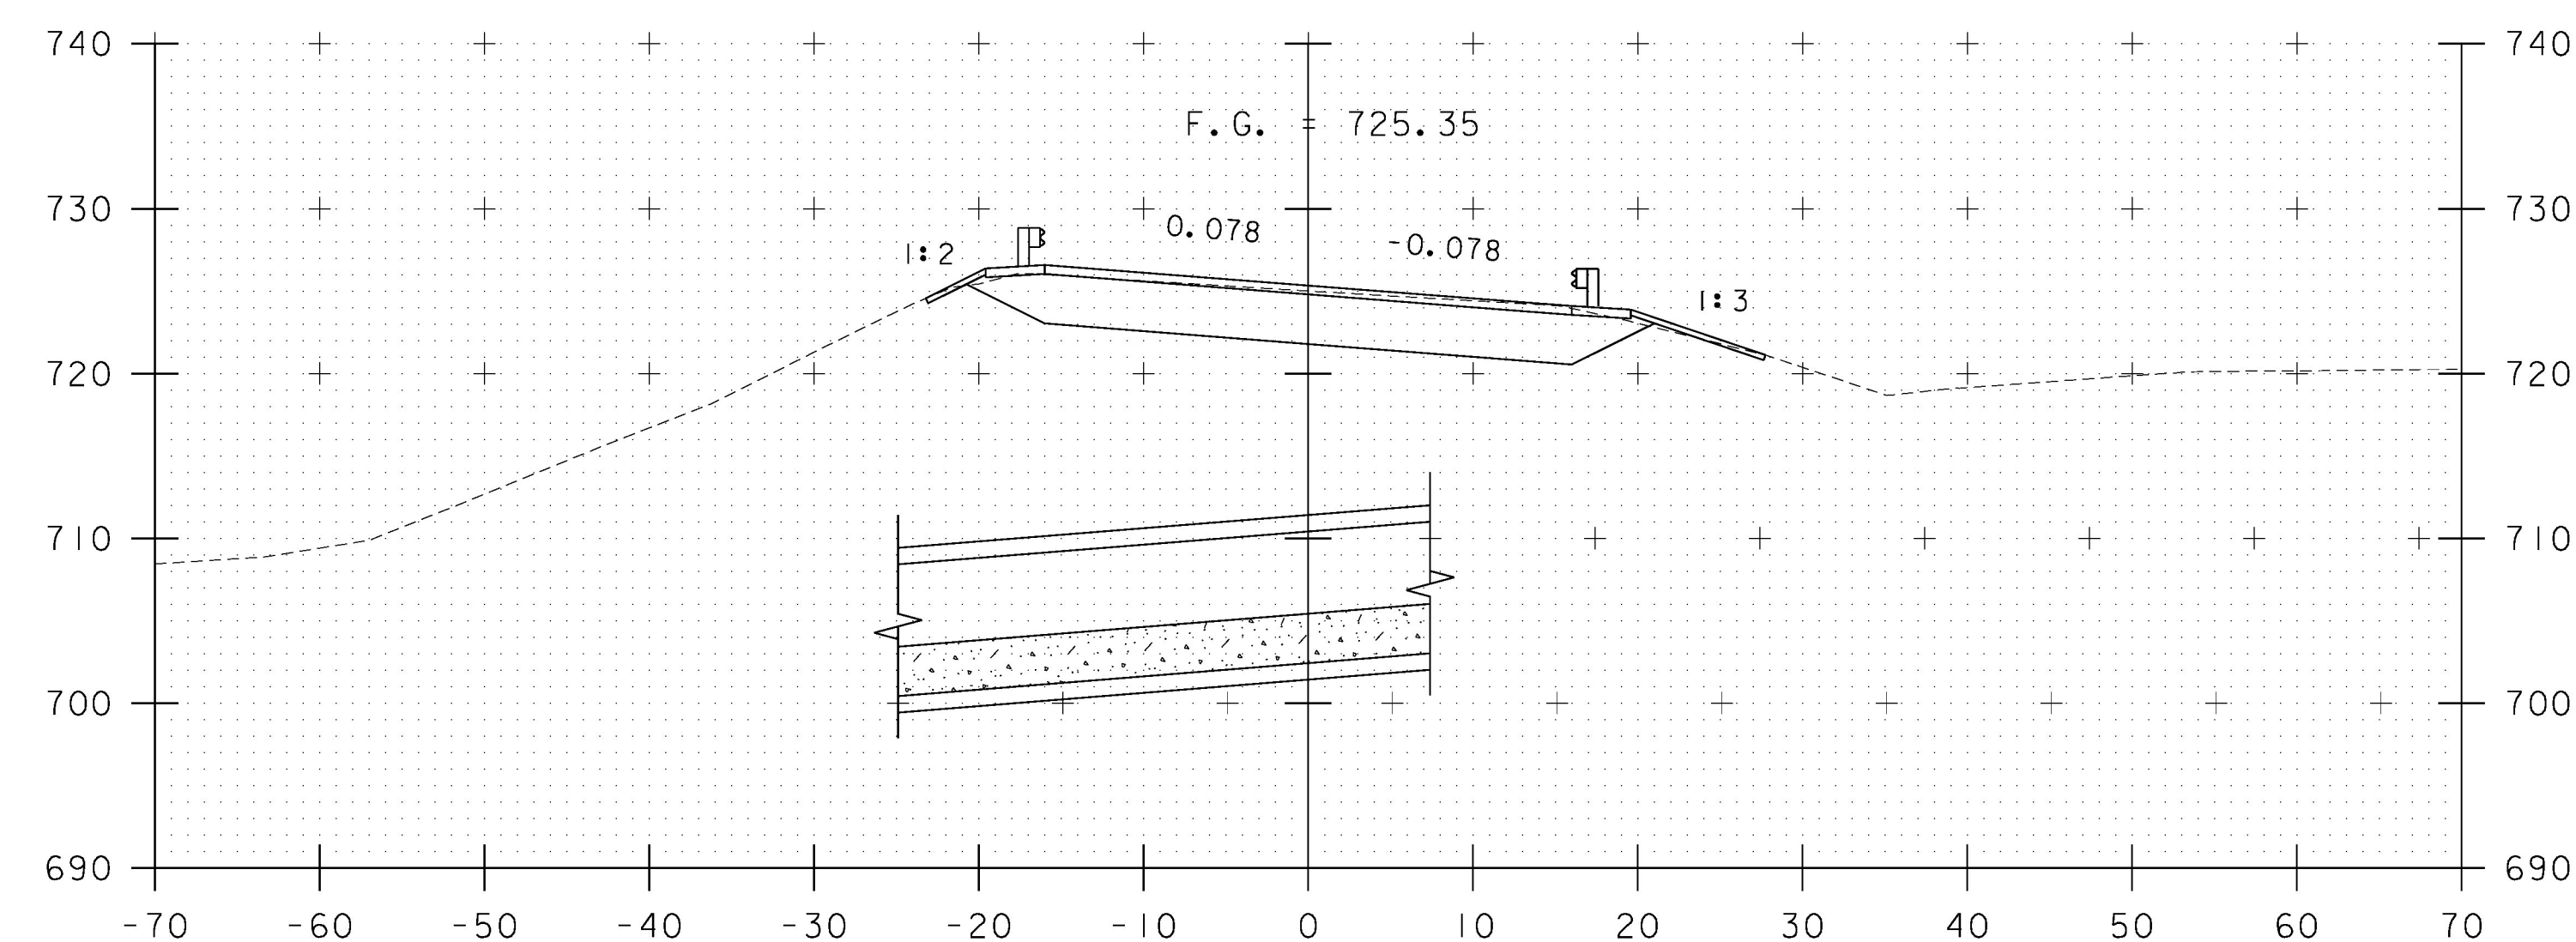

3+75  
BEGIN BRIDGE @ 3+70.09

STA. 3+25 TO STA. 4+00



PROJECT NAME: WATERFORD	
PROJECT NUMBER: BF 0225(5)	
FILE NAME: z15b051xs.dgn	PLOT DATE: 09/27/2017
PROJECT LEADER: T. LEVINS	DRAWN BY: A. KURDEKAR
DESIGNED BY: A. KURDEKAR/ J. MERCER	CHECKED BY: T. LEVINS
MAINLINE SECTIONS 2	SHEET 50 OF 63