




4+50

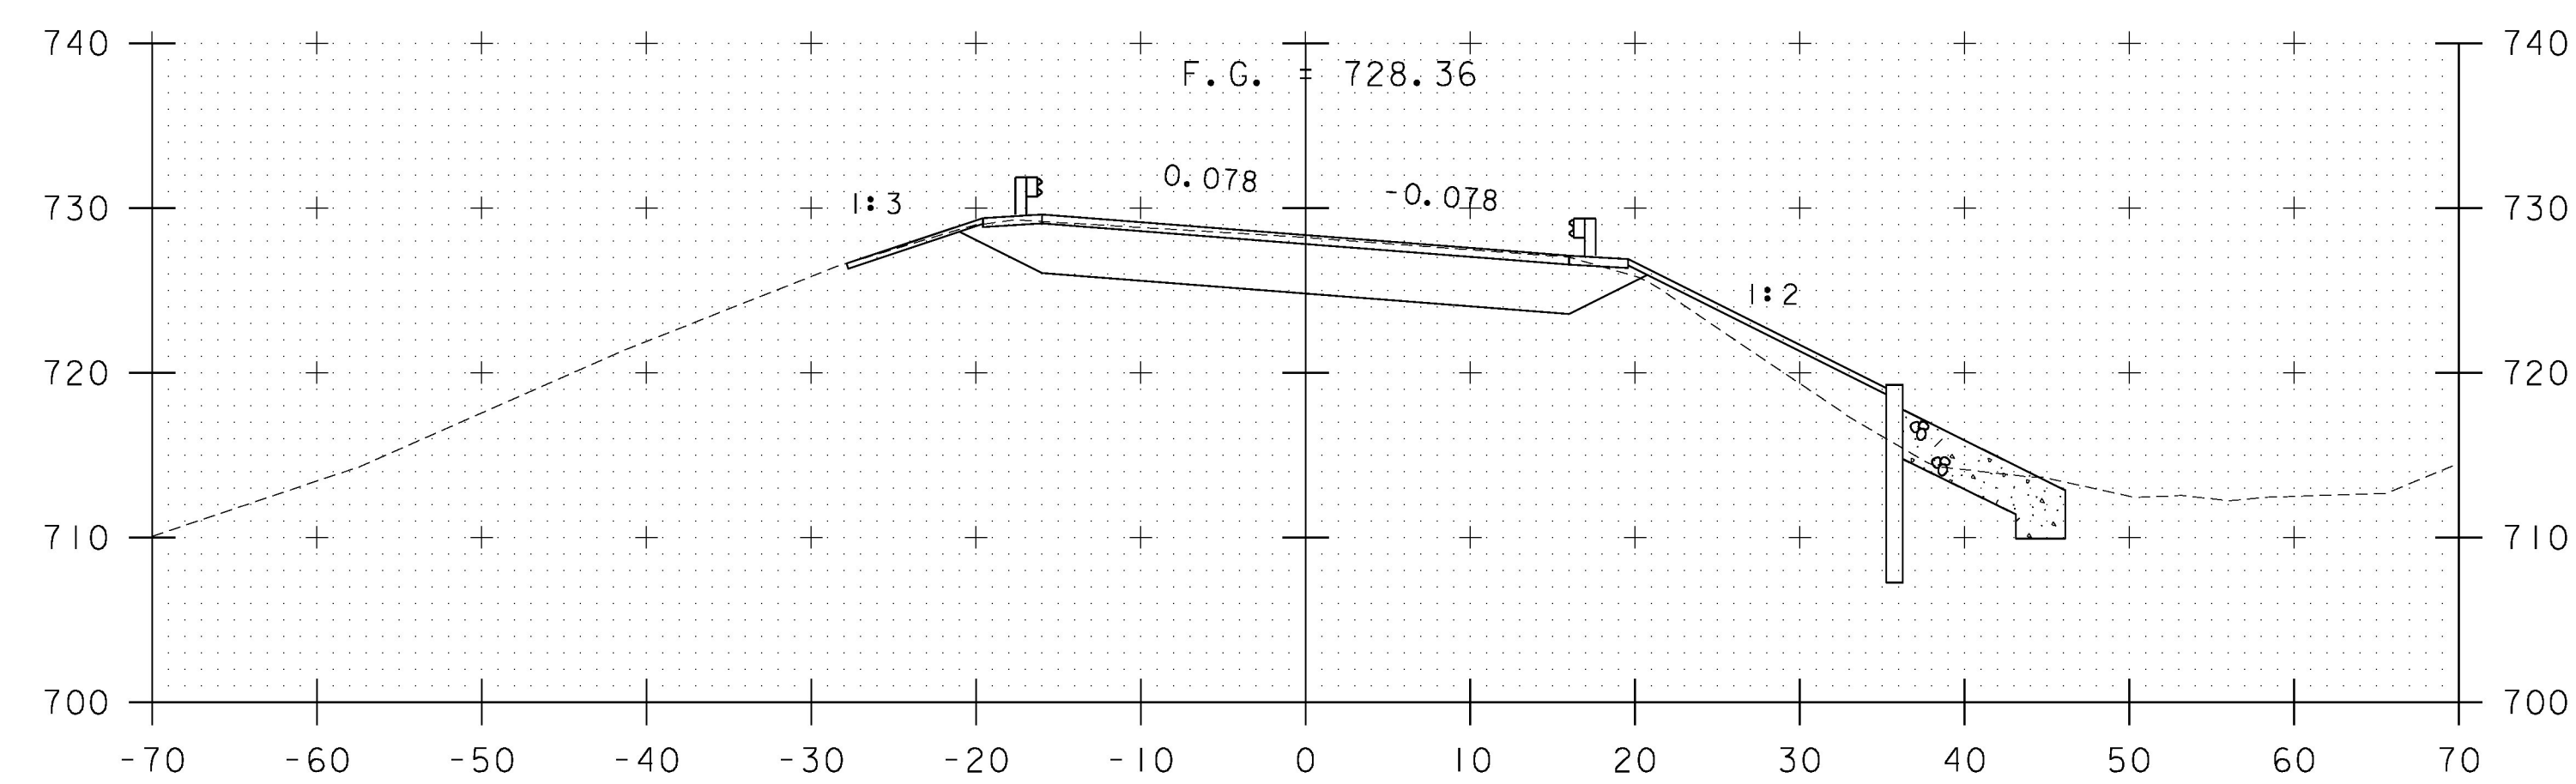

4+25

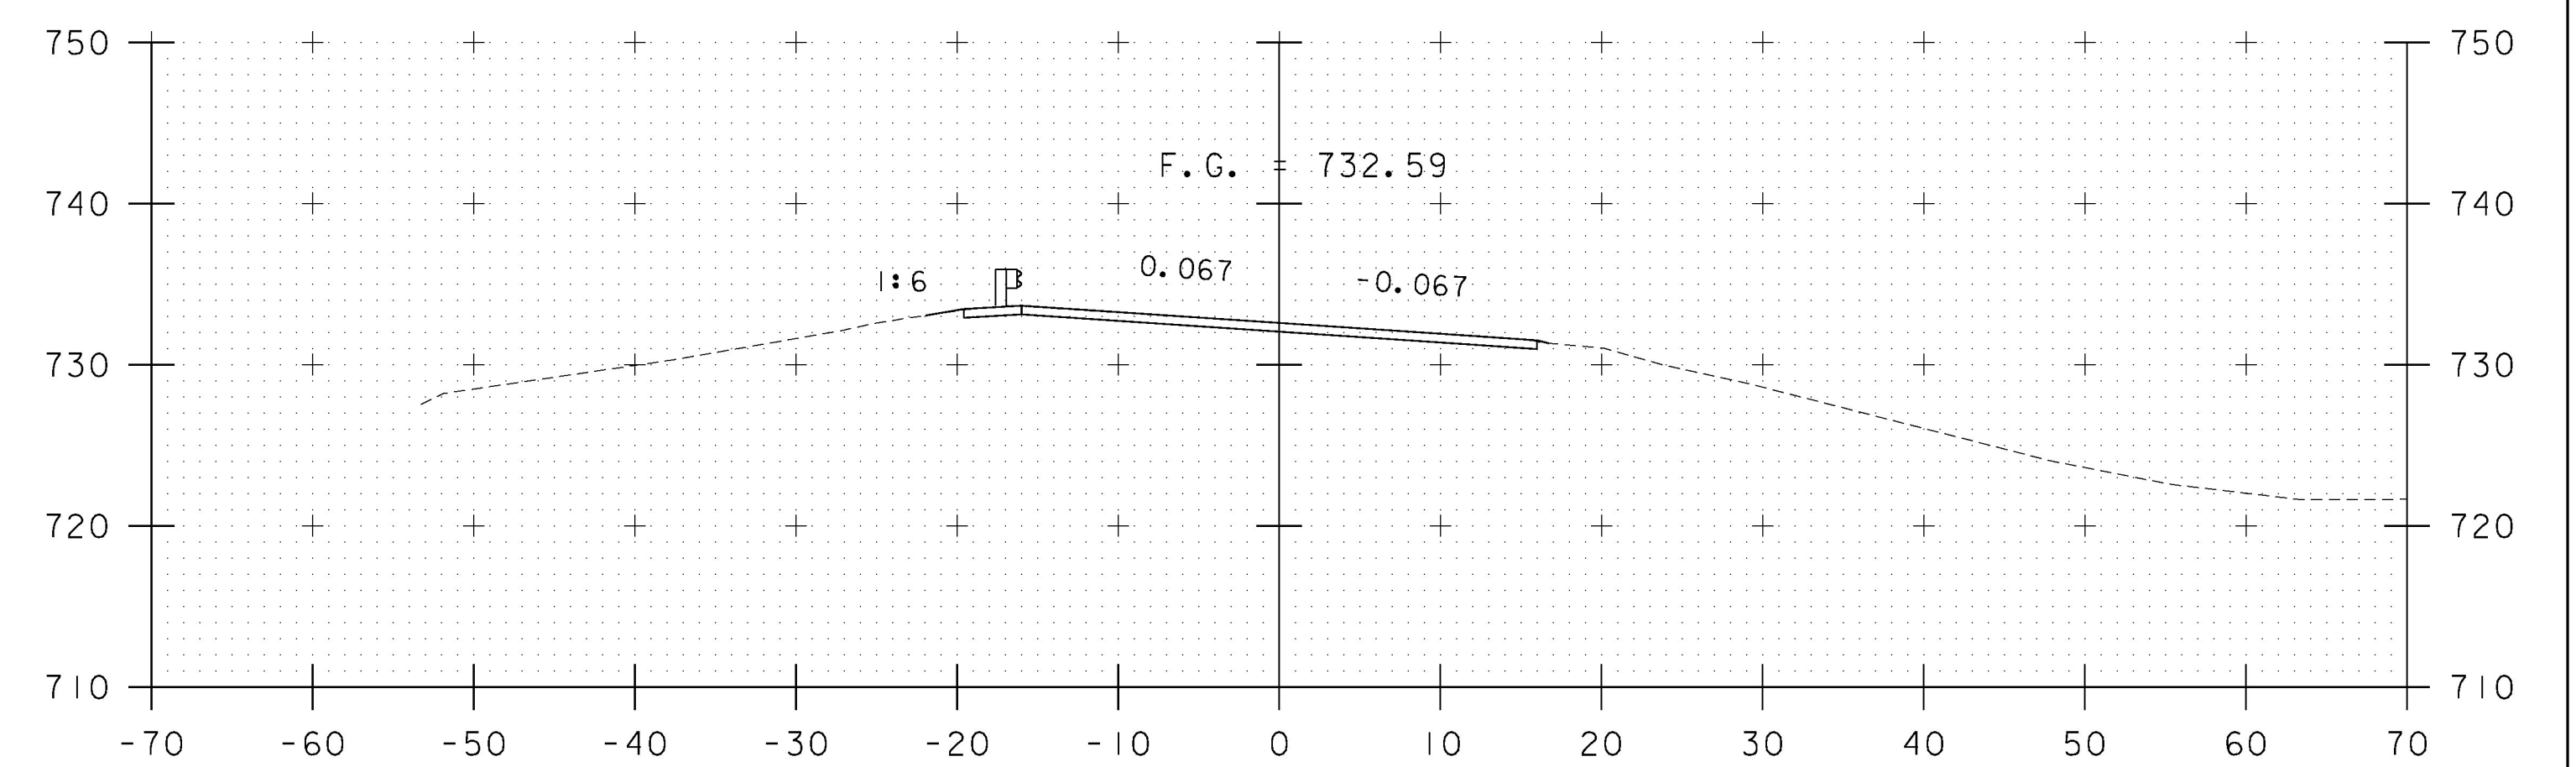

5+00
END PROJECT

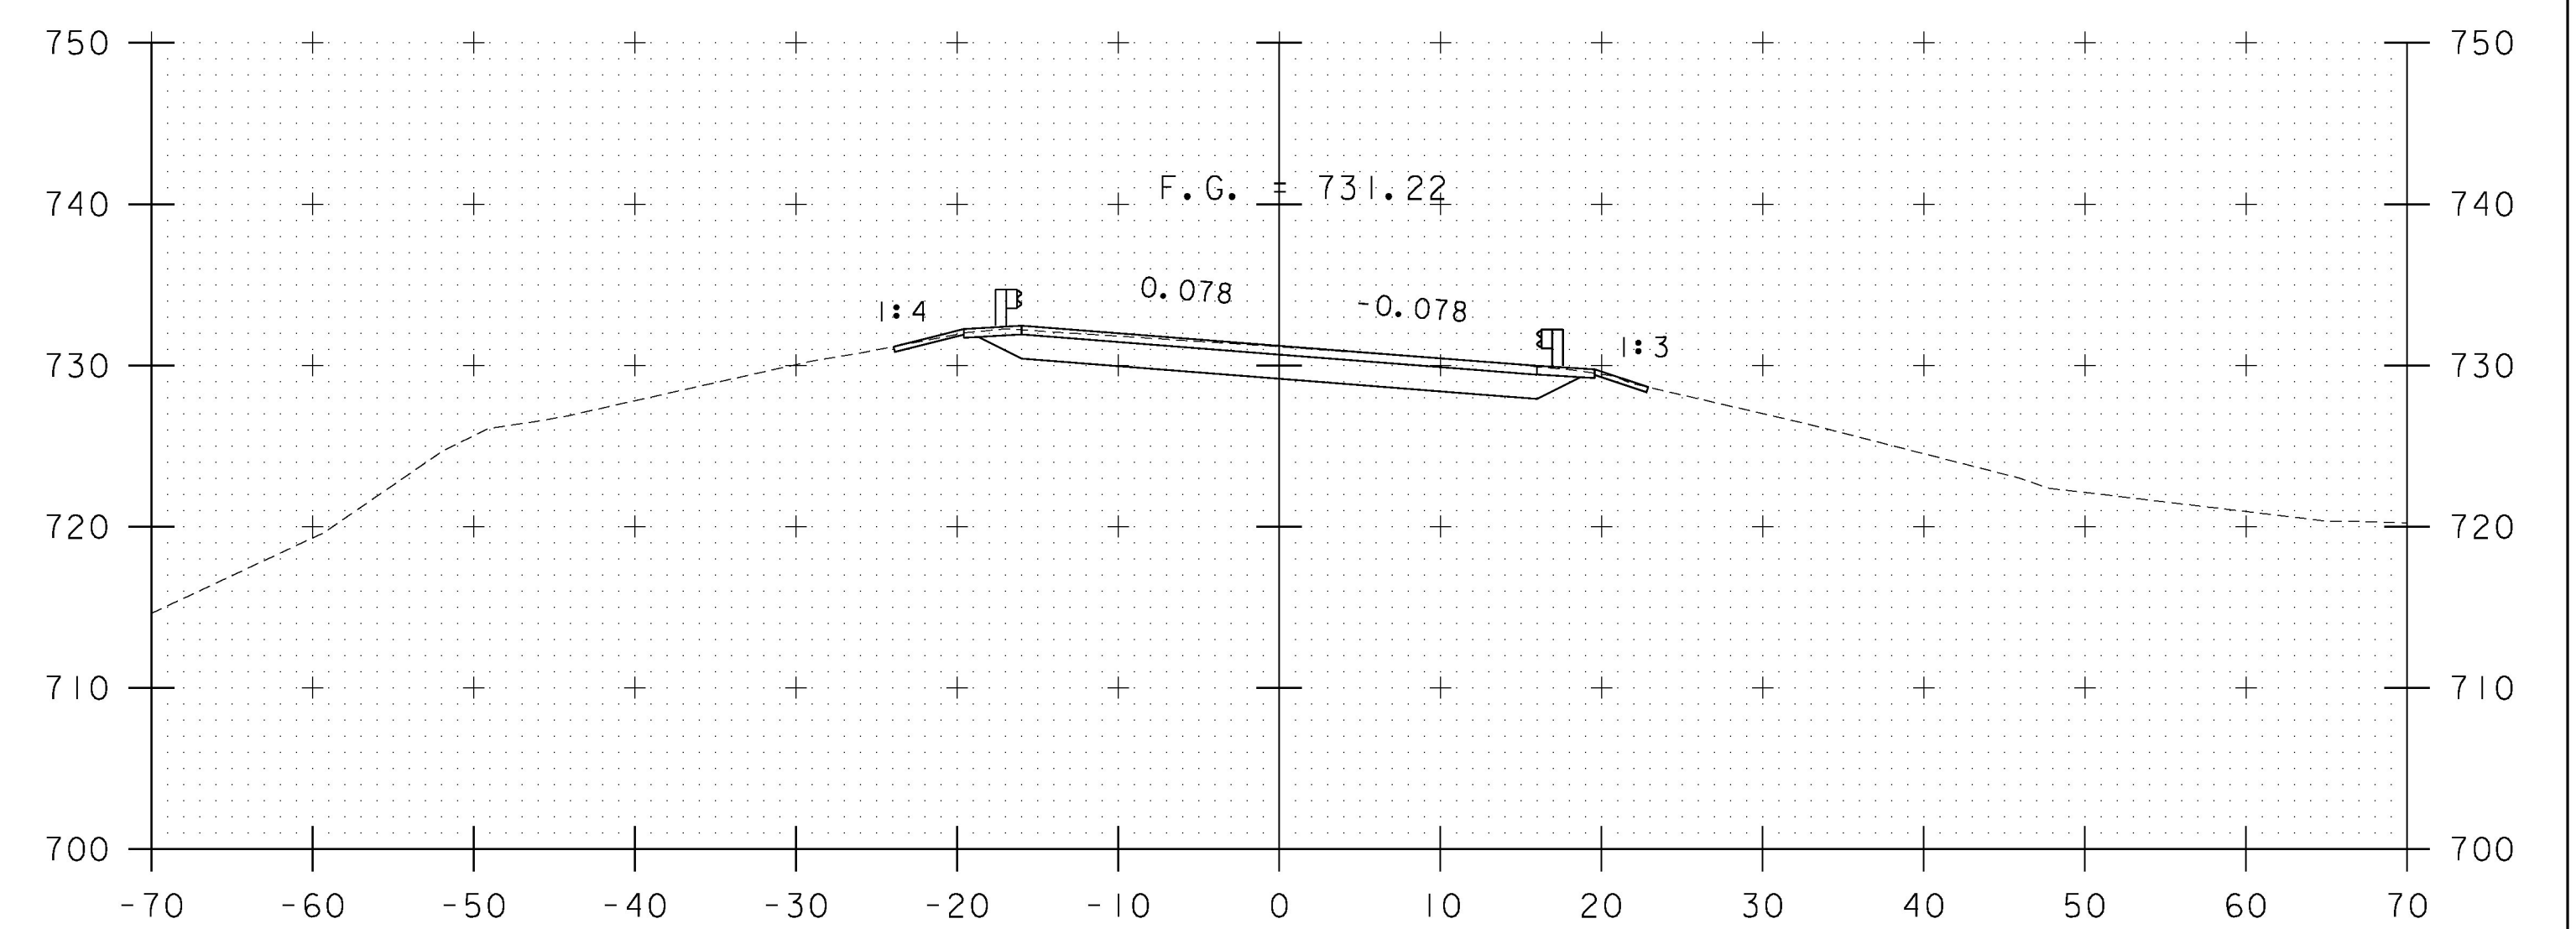

4+75

STA. 4+25 TO STA. 5+00



PROJECT NAME: WATERFORD	
PROJECT NUMBER: BF 0225(5)	
FILE NAME: z15b051xs.dgn	PLOT DATE: 09/27/2017
PROJECT LEADER: T. LEVINS	DRAWN BY: A. KURDEKAR
DESIGNED BY: A. KURDEKAR/ J. MERCER	CHECKED BY: T. LEVINS
MAINLINE SECTIONS 3	SHEET 51 OF 63