



PLAN MK BC-1

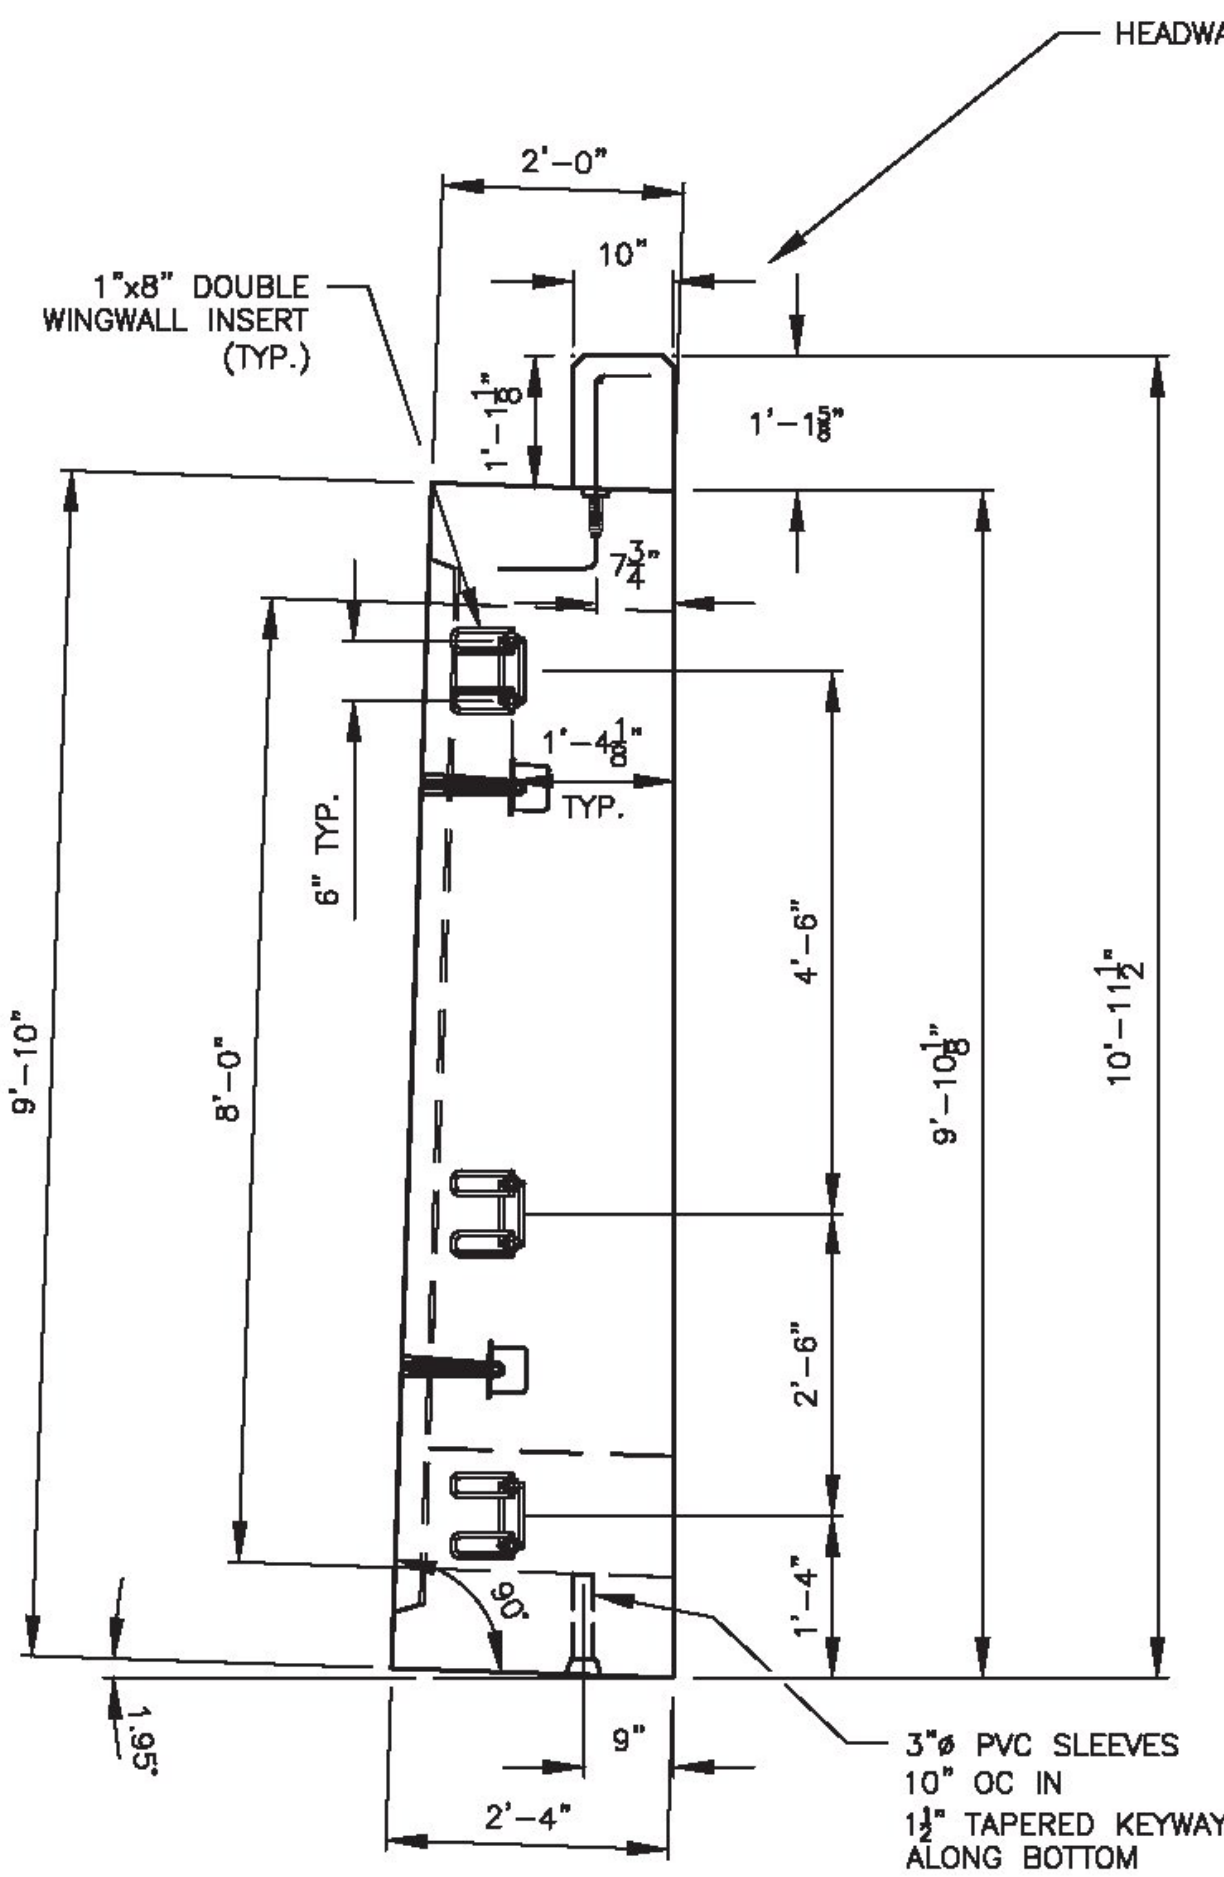

ELEVATION VIEW
MK BC-1 NARROW END

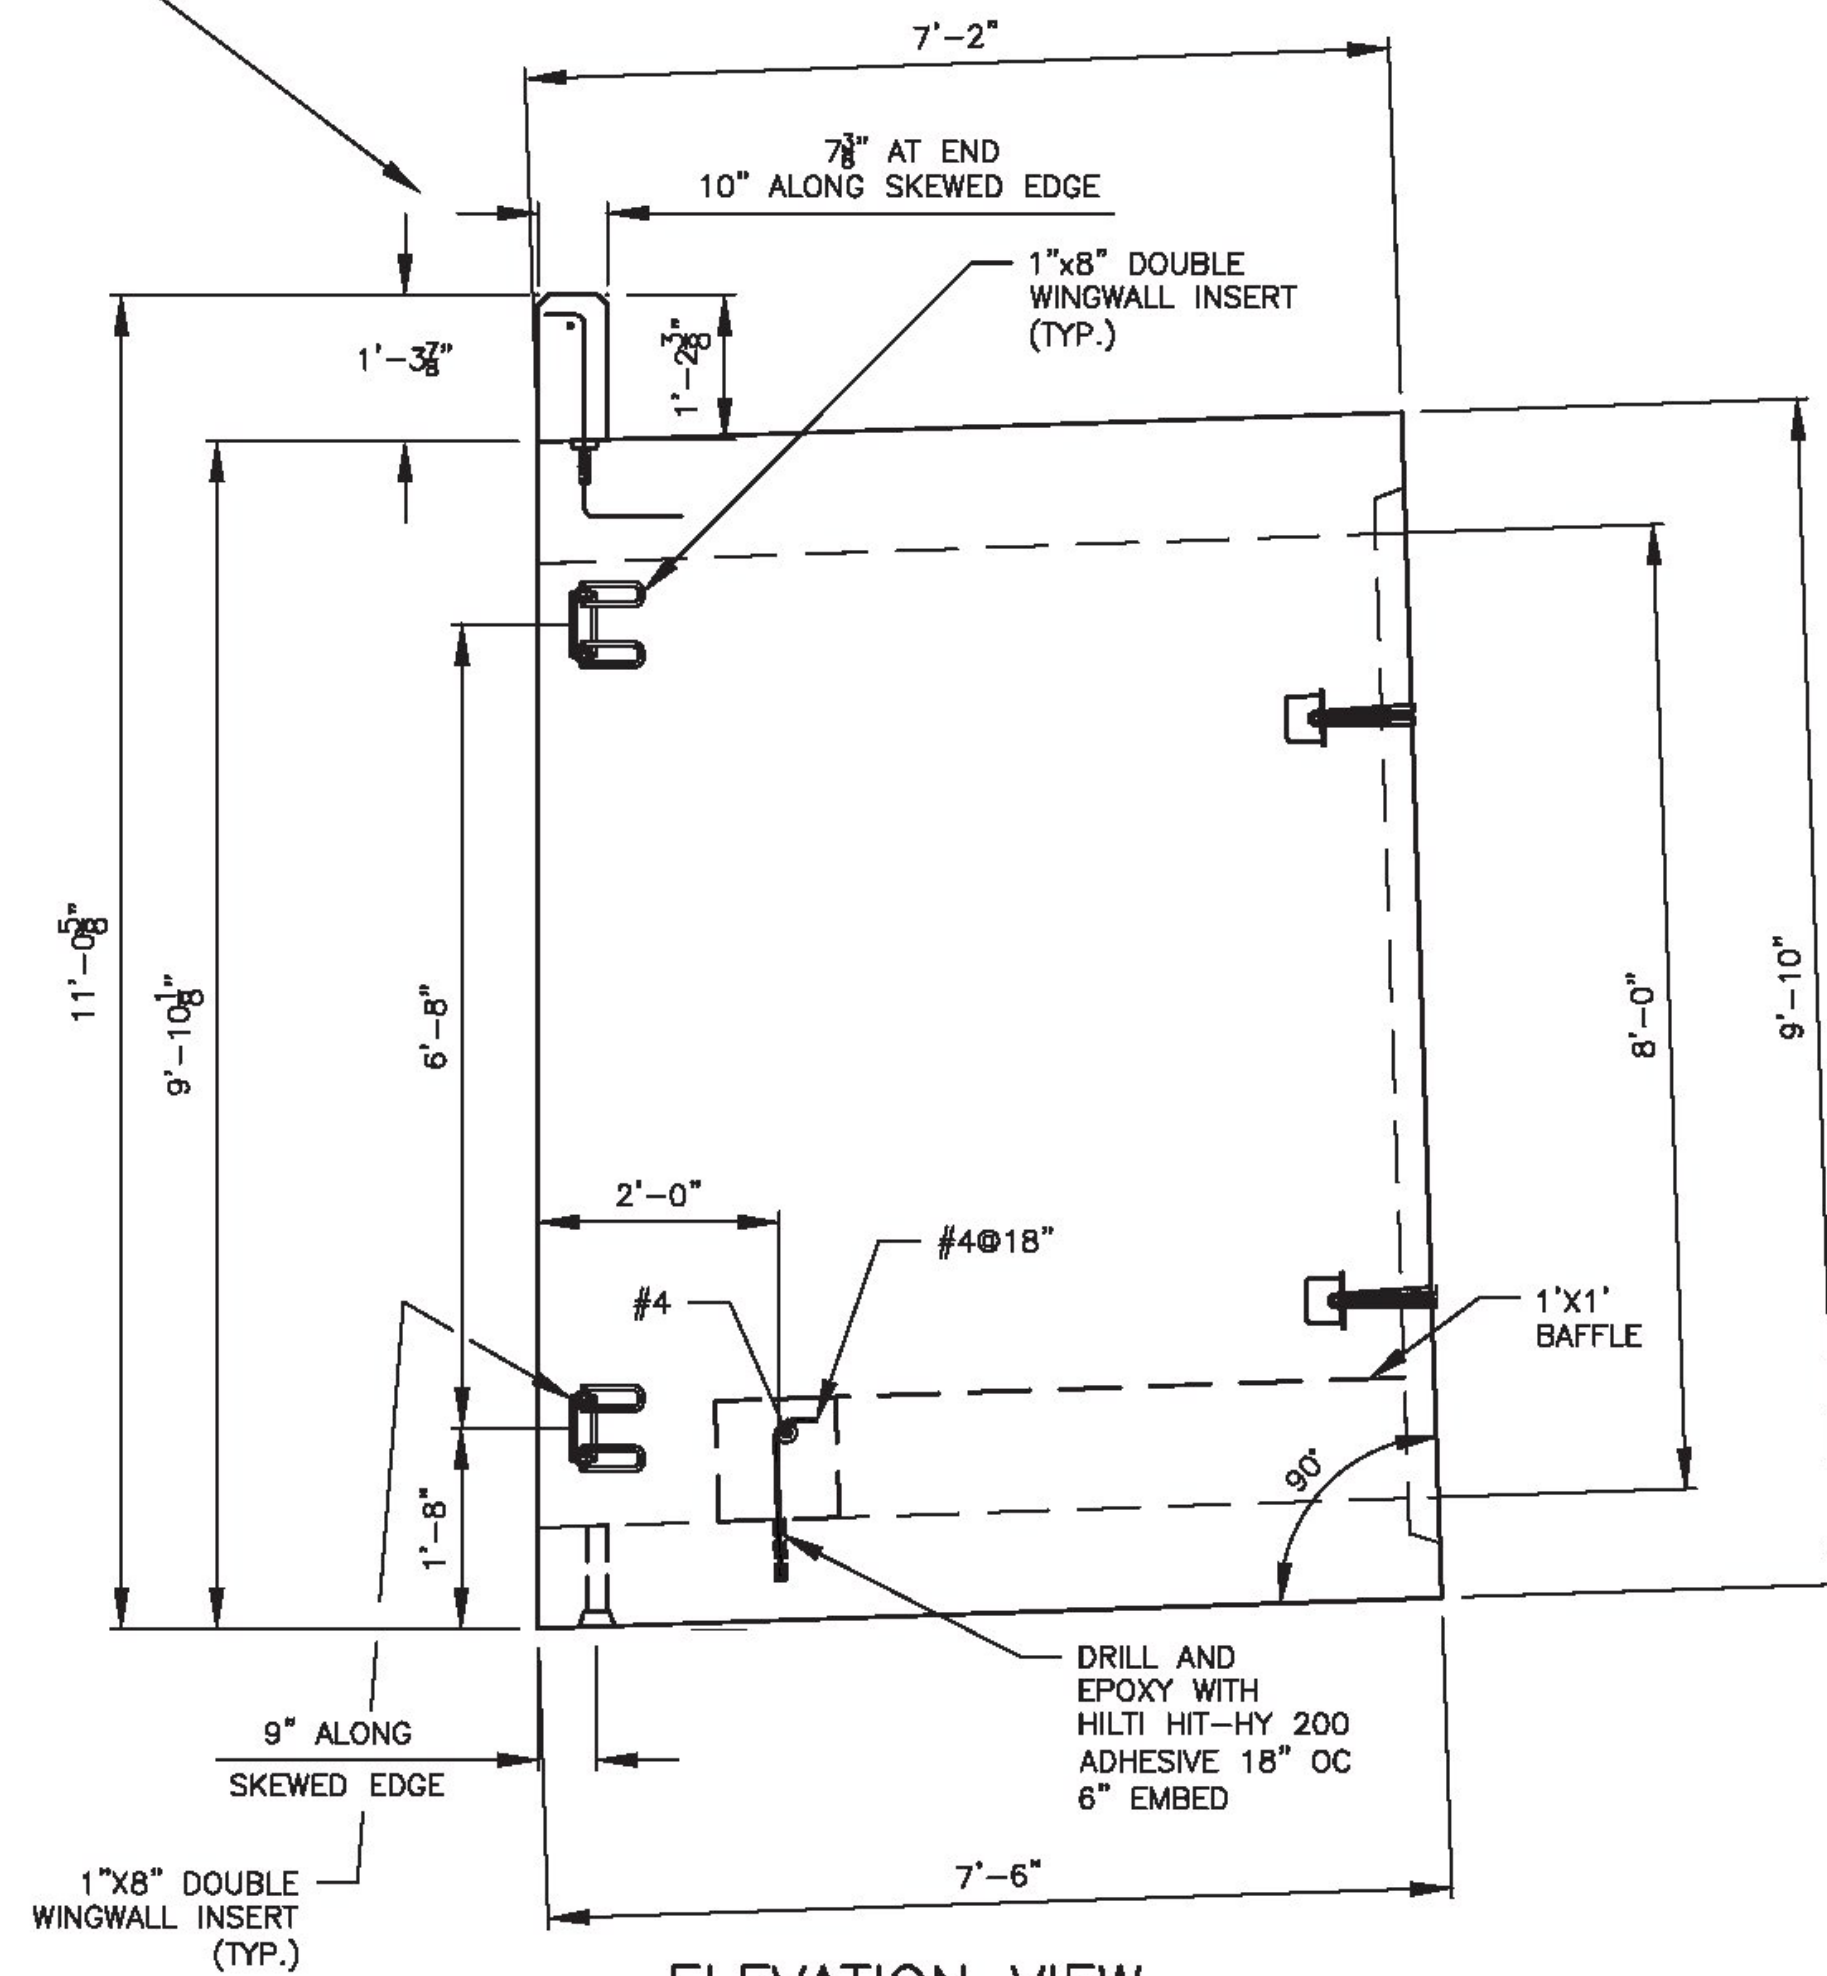

ELEVATION VIEW
MK BC-1 WIDE END



REV. NO.			DATE			REVISION					
PREPARED FOR:						CAMP PRECAST CONCRETE PRODUCTS					
						78 PRECAST RD MILTON, VT 05468 PHONE: (802)893-2401 FAX: (802)893-1542					
DATE: 4/20/18						SHEET TITLE: BC-1 DETAILS					
SCALE: N.T.S.						DRAWN BY: BJC CHKD BY: RPJ/RJA					
PREPARED BY:						PROJECT: TOWN OF WATERFORD, CALEDONIA, VT 16' x 8' BOX CULVERT BF 0225(4) VT RT. 18 BRIDGE #7					
CONTRACTOR:						DWG. NO. PD-02					
DELTA PROJ. NO.: 2018.477.003						SHT. NO. 7 OF 16					

