

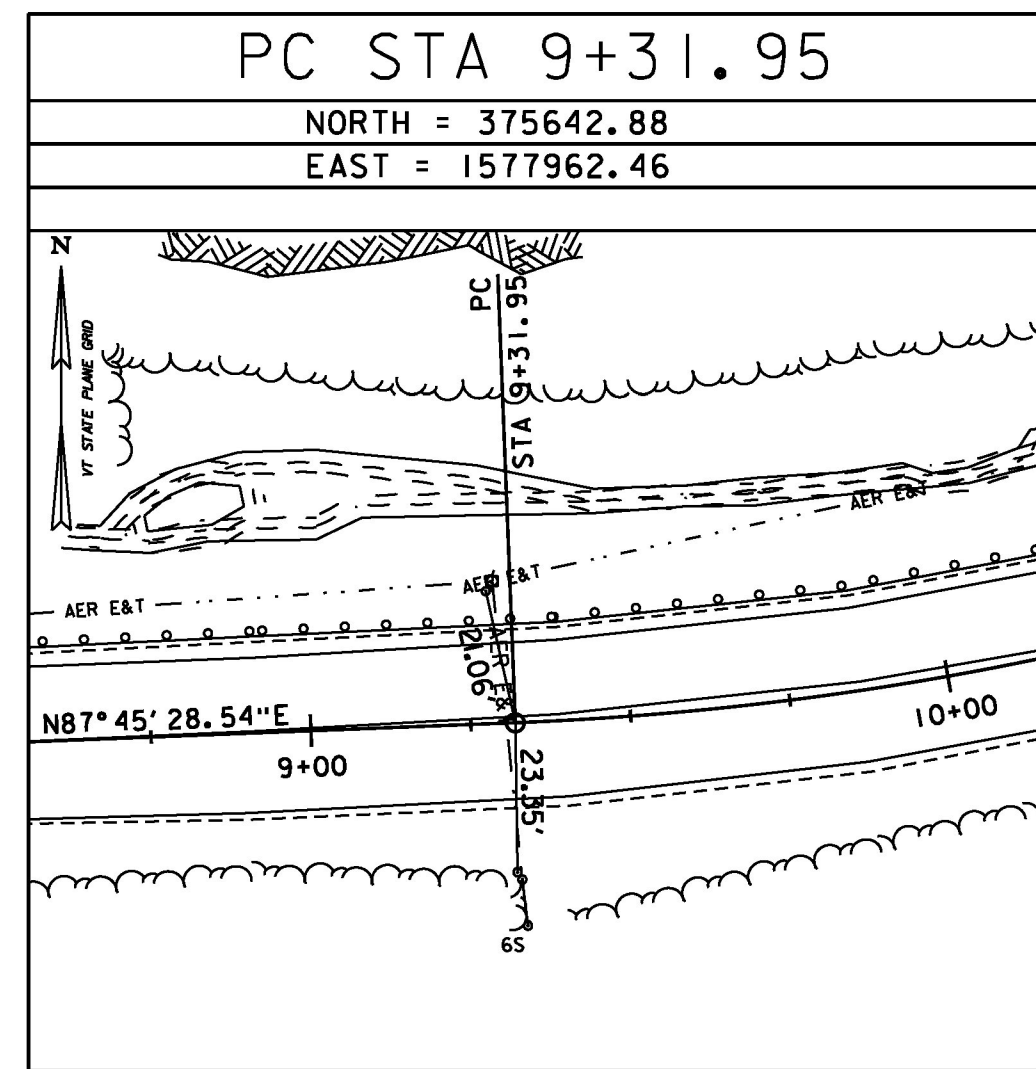
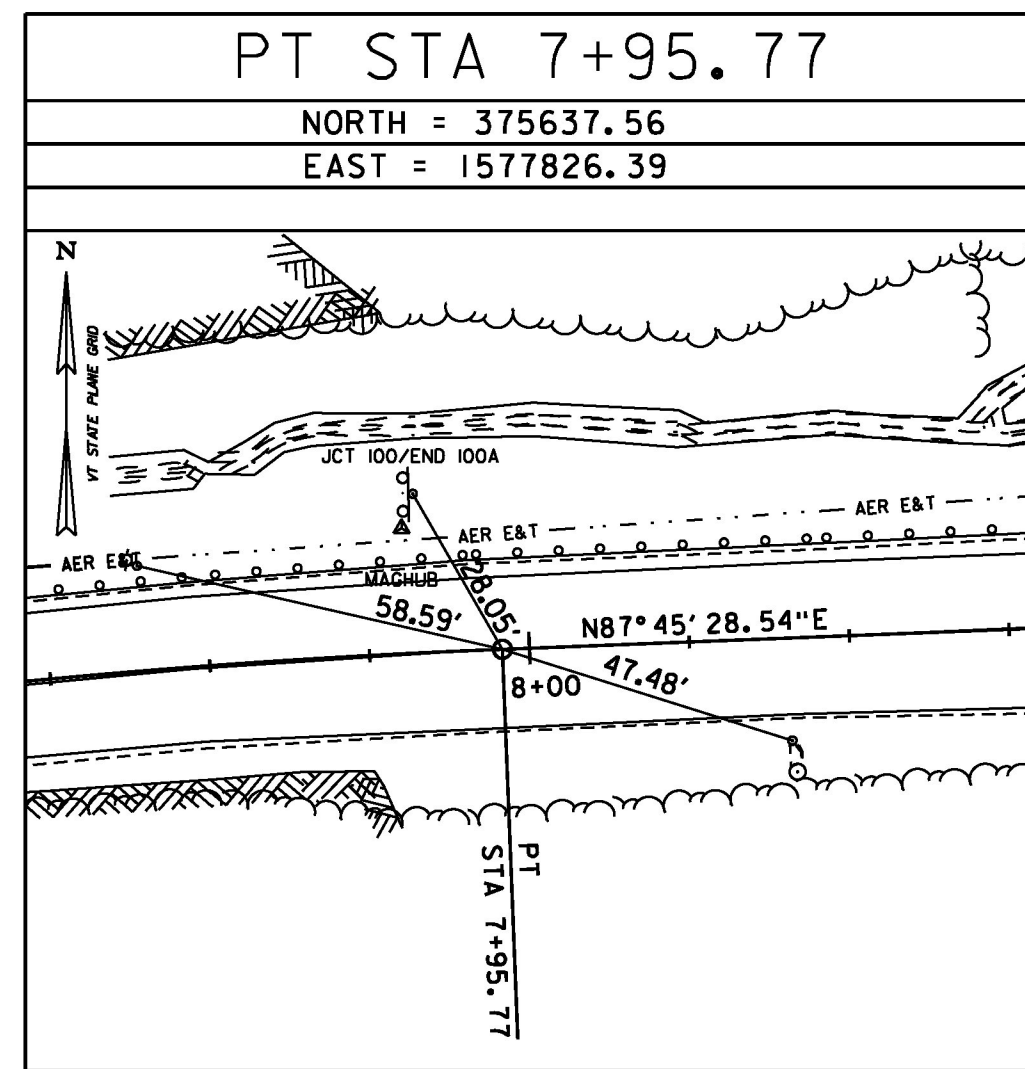
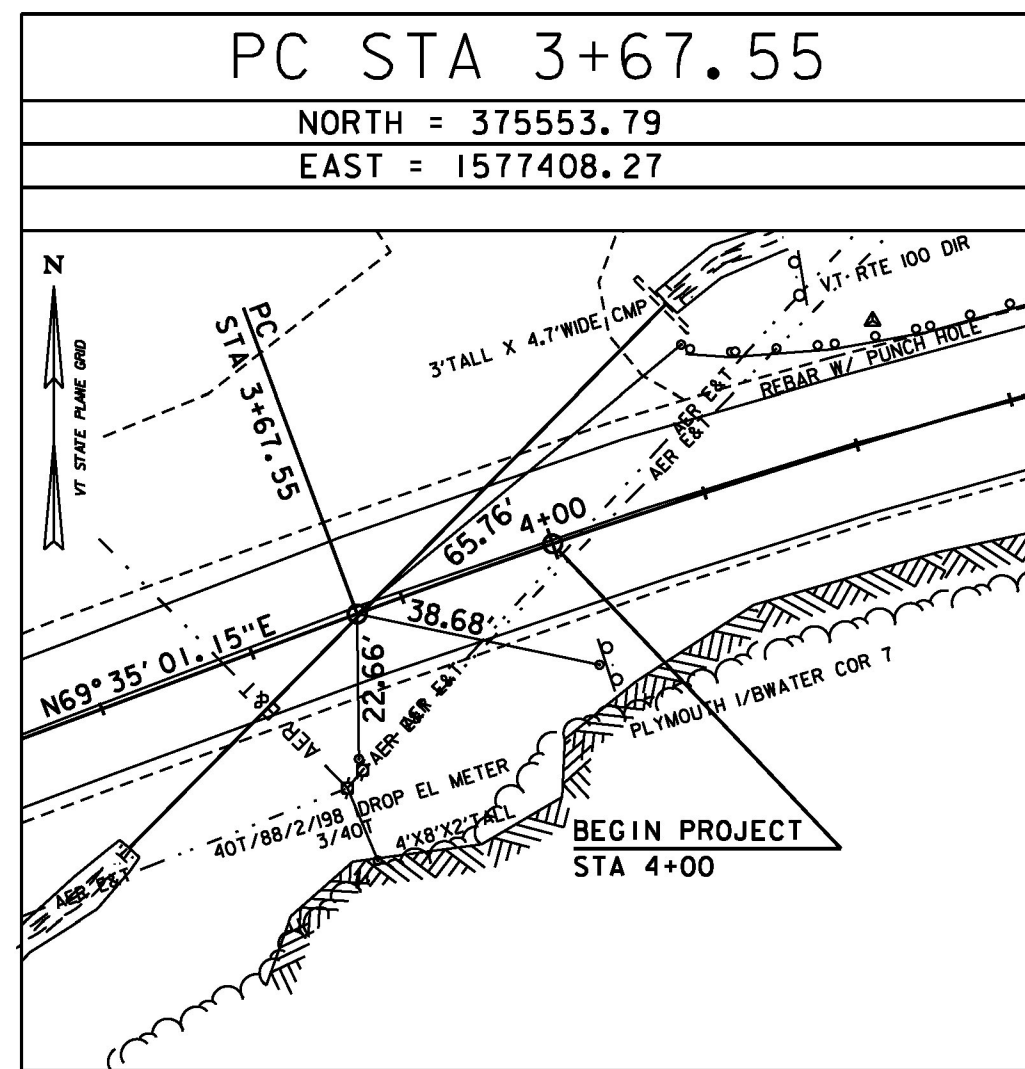
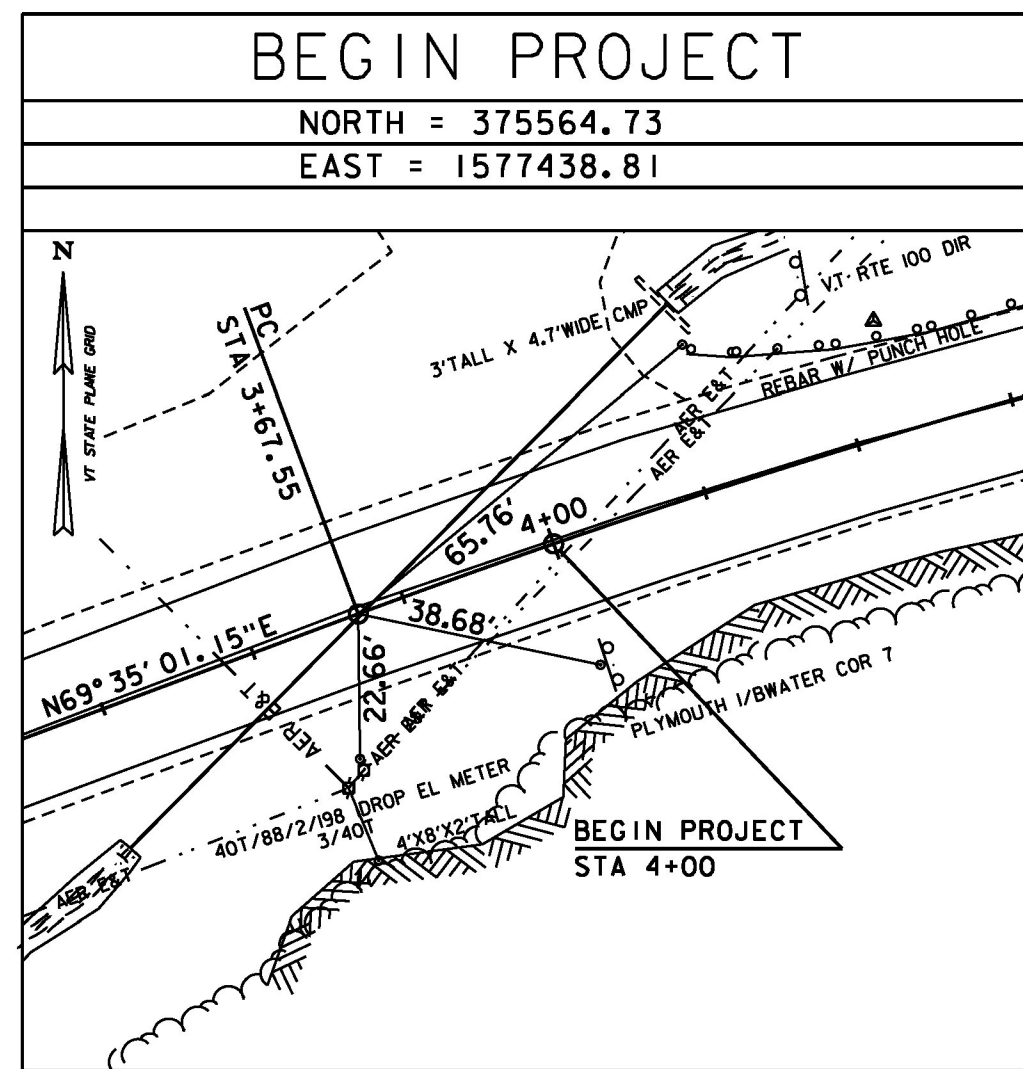 
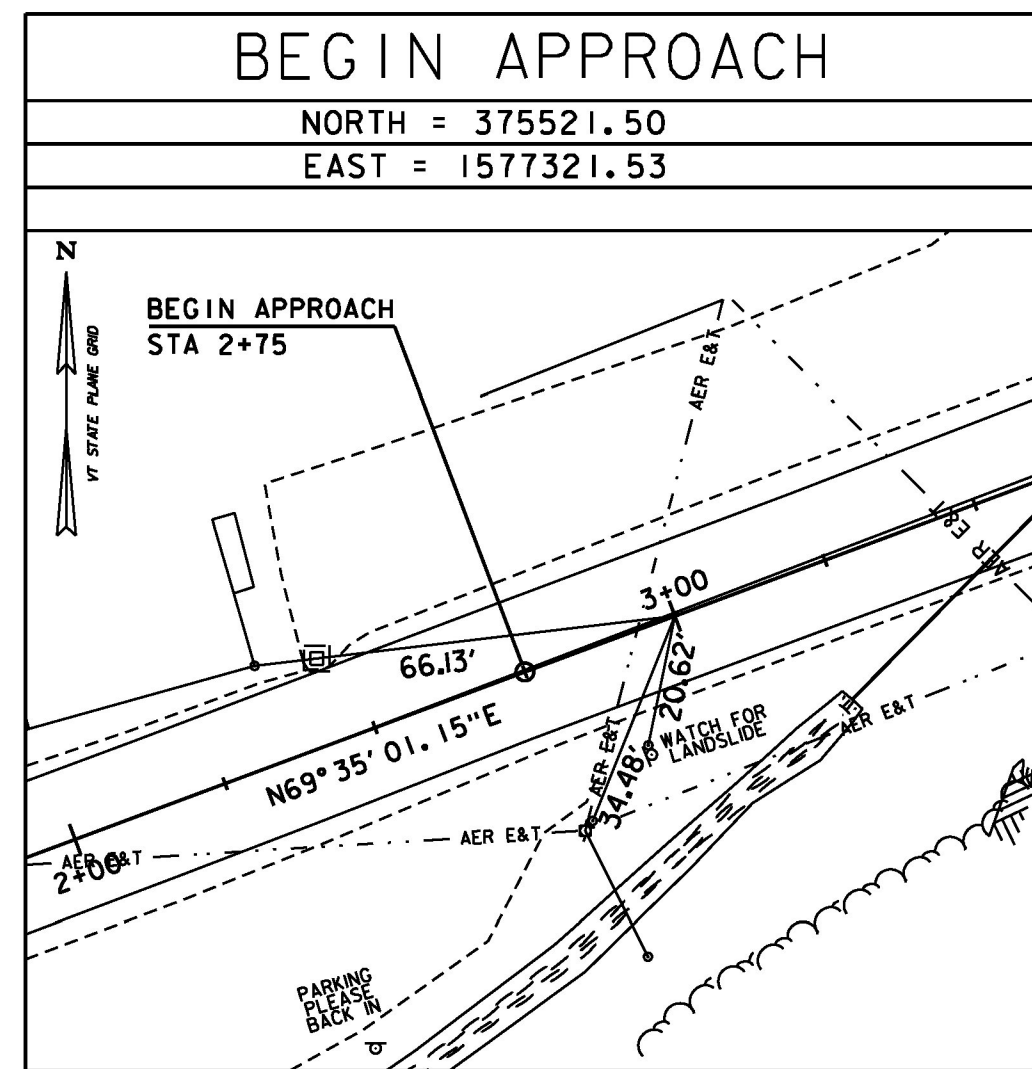

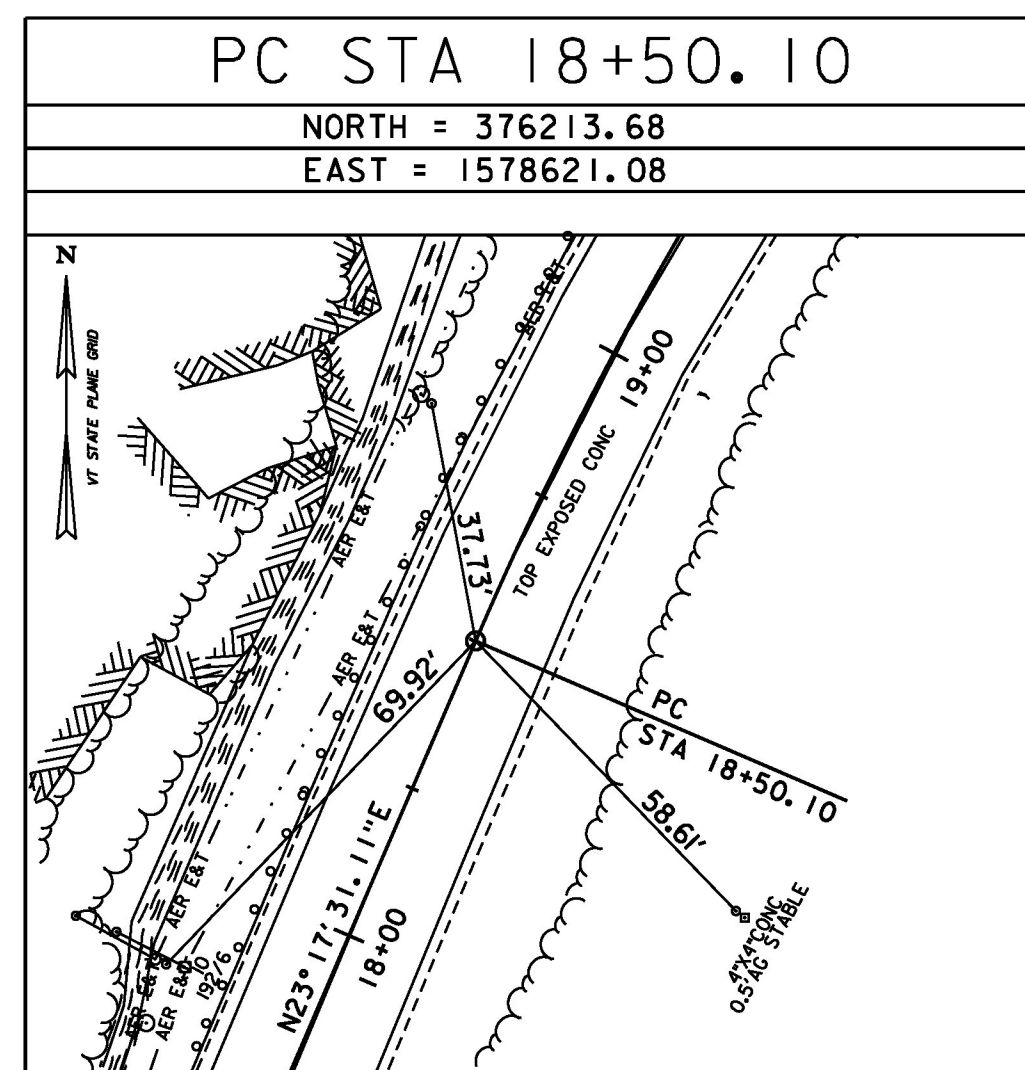
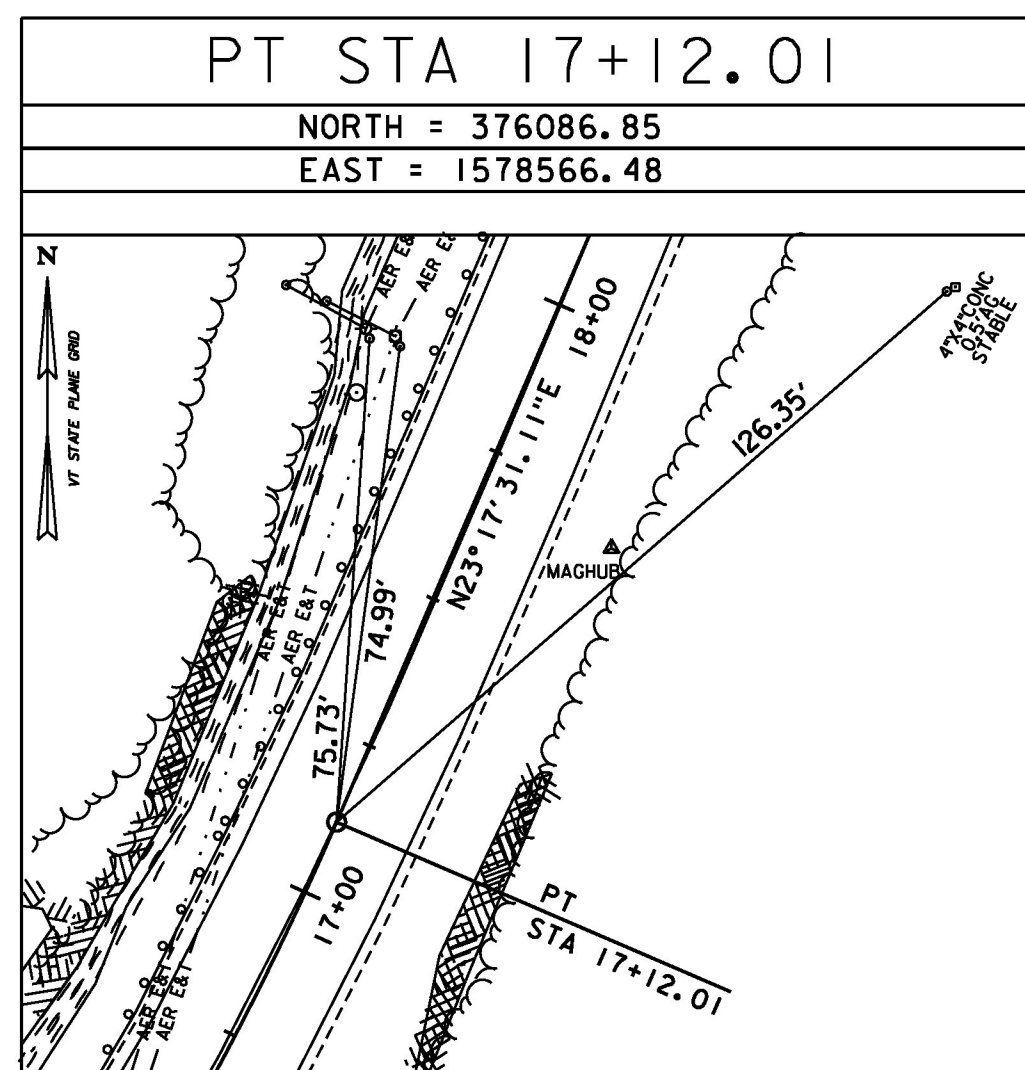







ALIGNMENT TIES

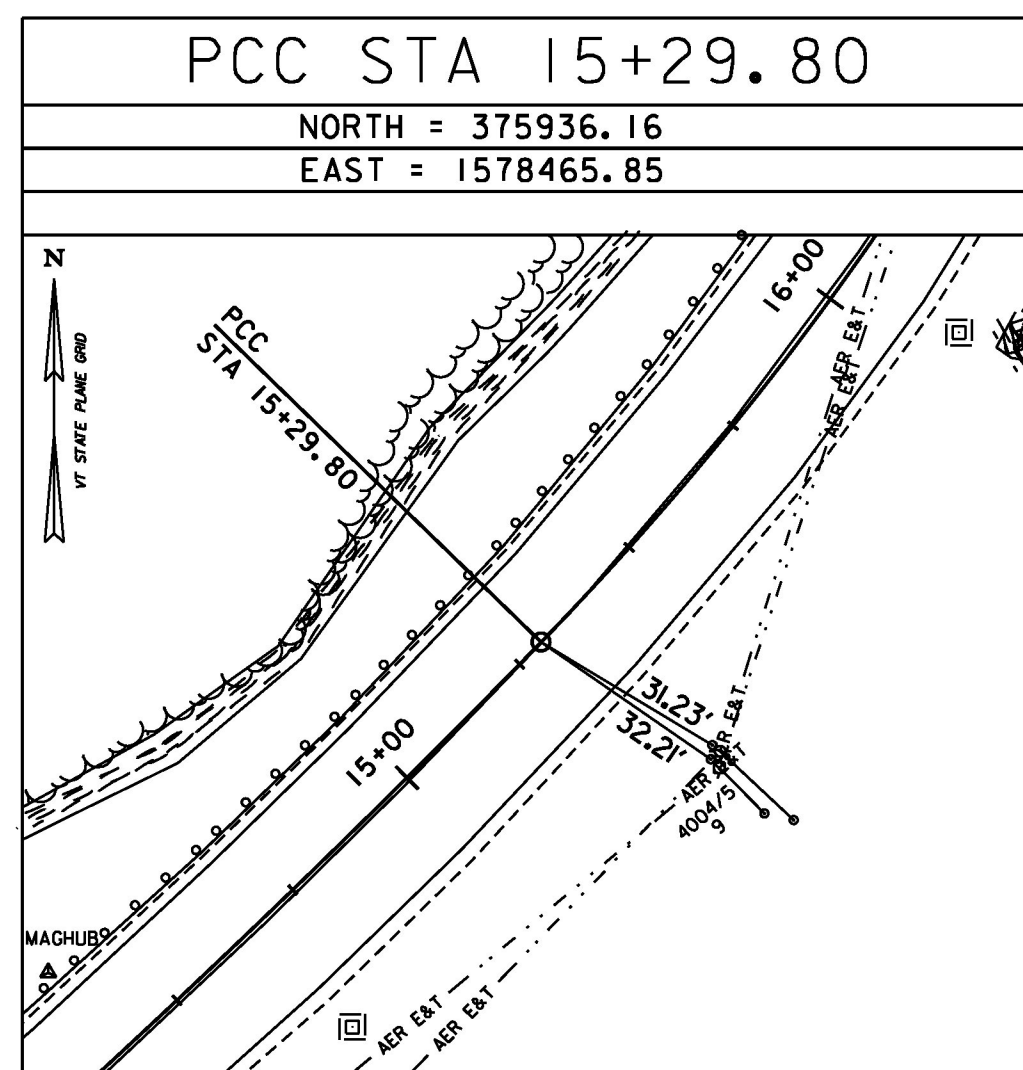

ALIGNMENT TIES

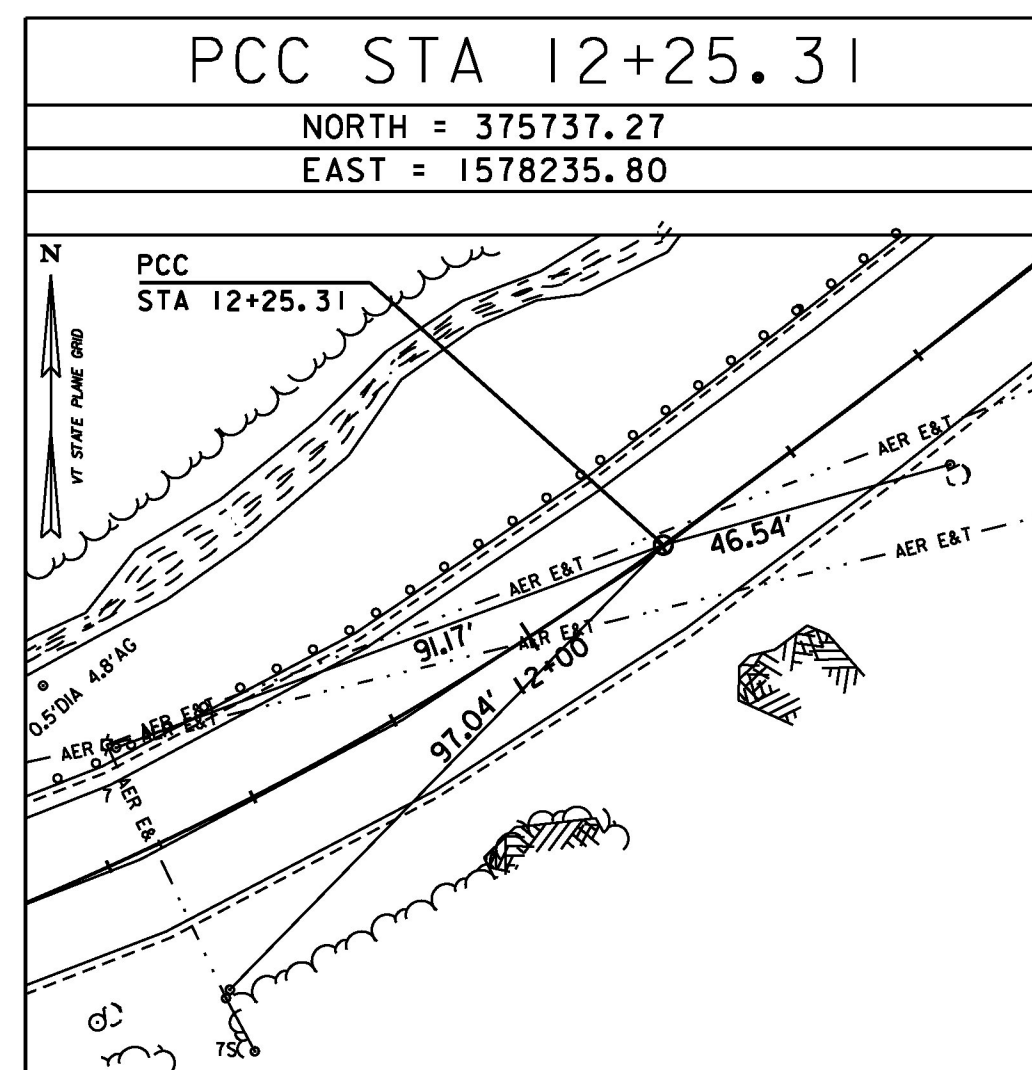

  ALIGNMENT TIES

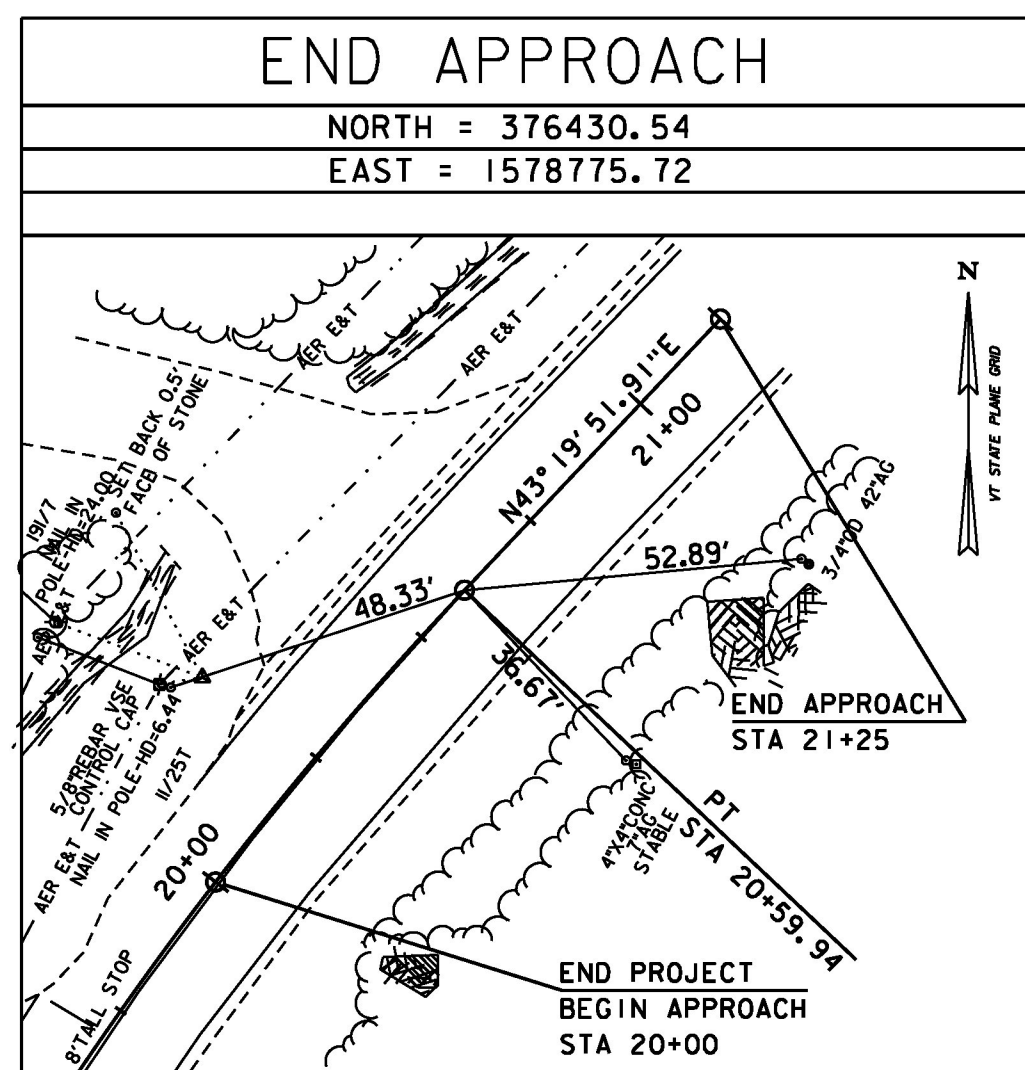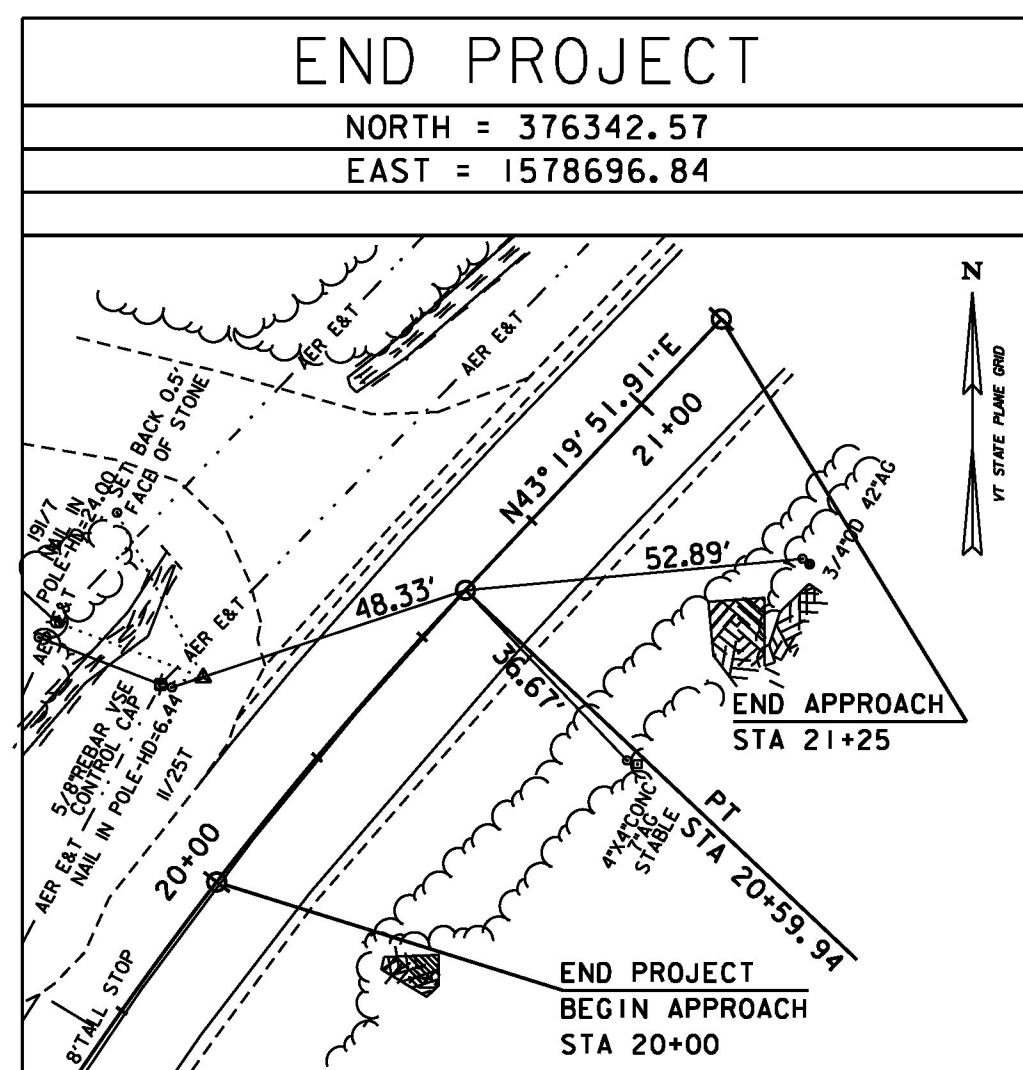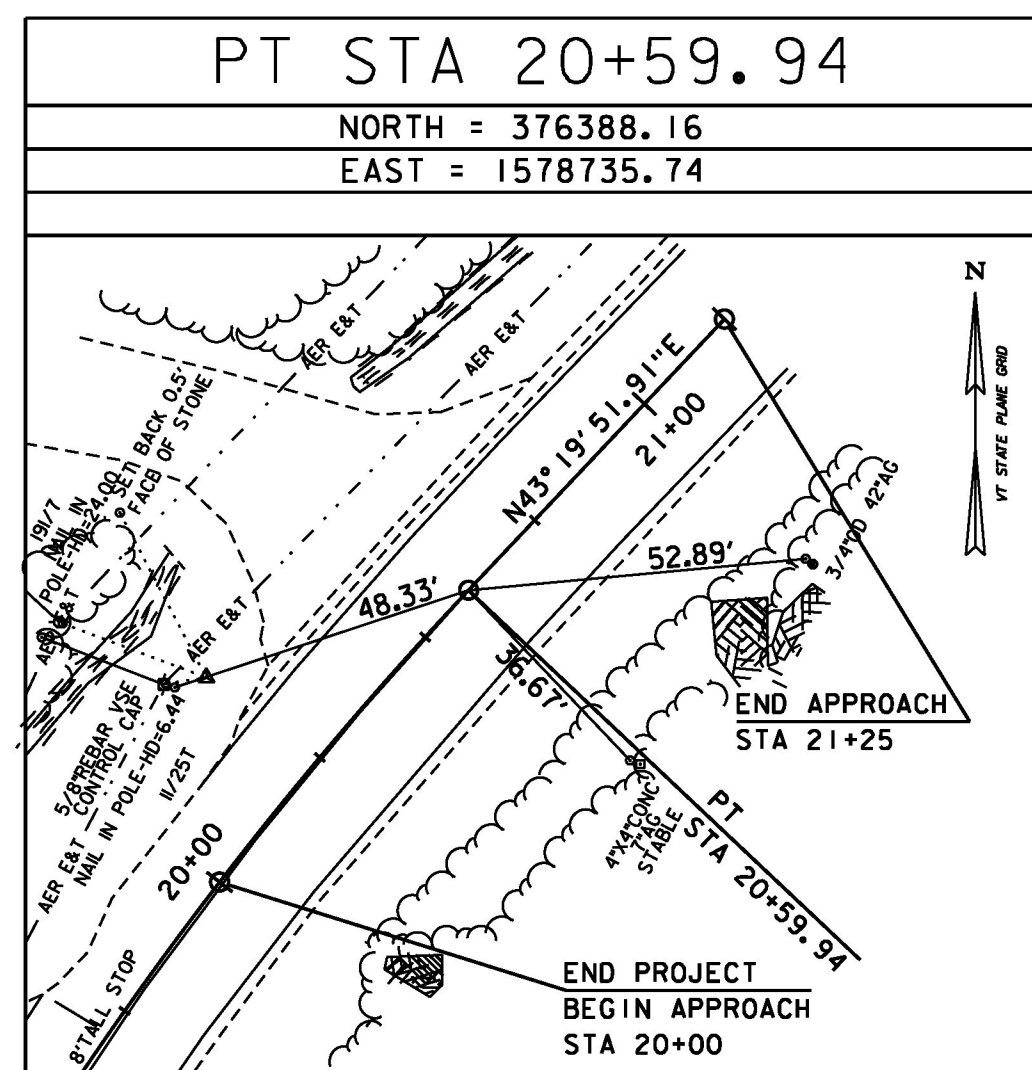

DATUM
 VERTICAL NAVD 88(GEOD12A) FT
 HORIZONTAL NAD 83(2011) sFT
 ADJUSTMENT LSO

PROJECT NAME: PLYMOUTH
 PROJECT NUMBER: ER 0149(6)

FILE NAME: z13c318t1.dgn
 PROJECT LEADER: J. SANTACRUCE
 DESIGNED BY: M. HASKINS
 TIE SHEET 2

PLOT DATE: 5/17/2016
 DRAWN BY: M. LOVETT
 CHECKED BY: B. COLBURN
 SHEET 7 OF 68

