




1 **CROSS SLOPE UNDERDRAIN CARRIER**
N.T.S.

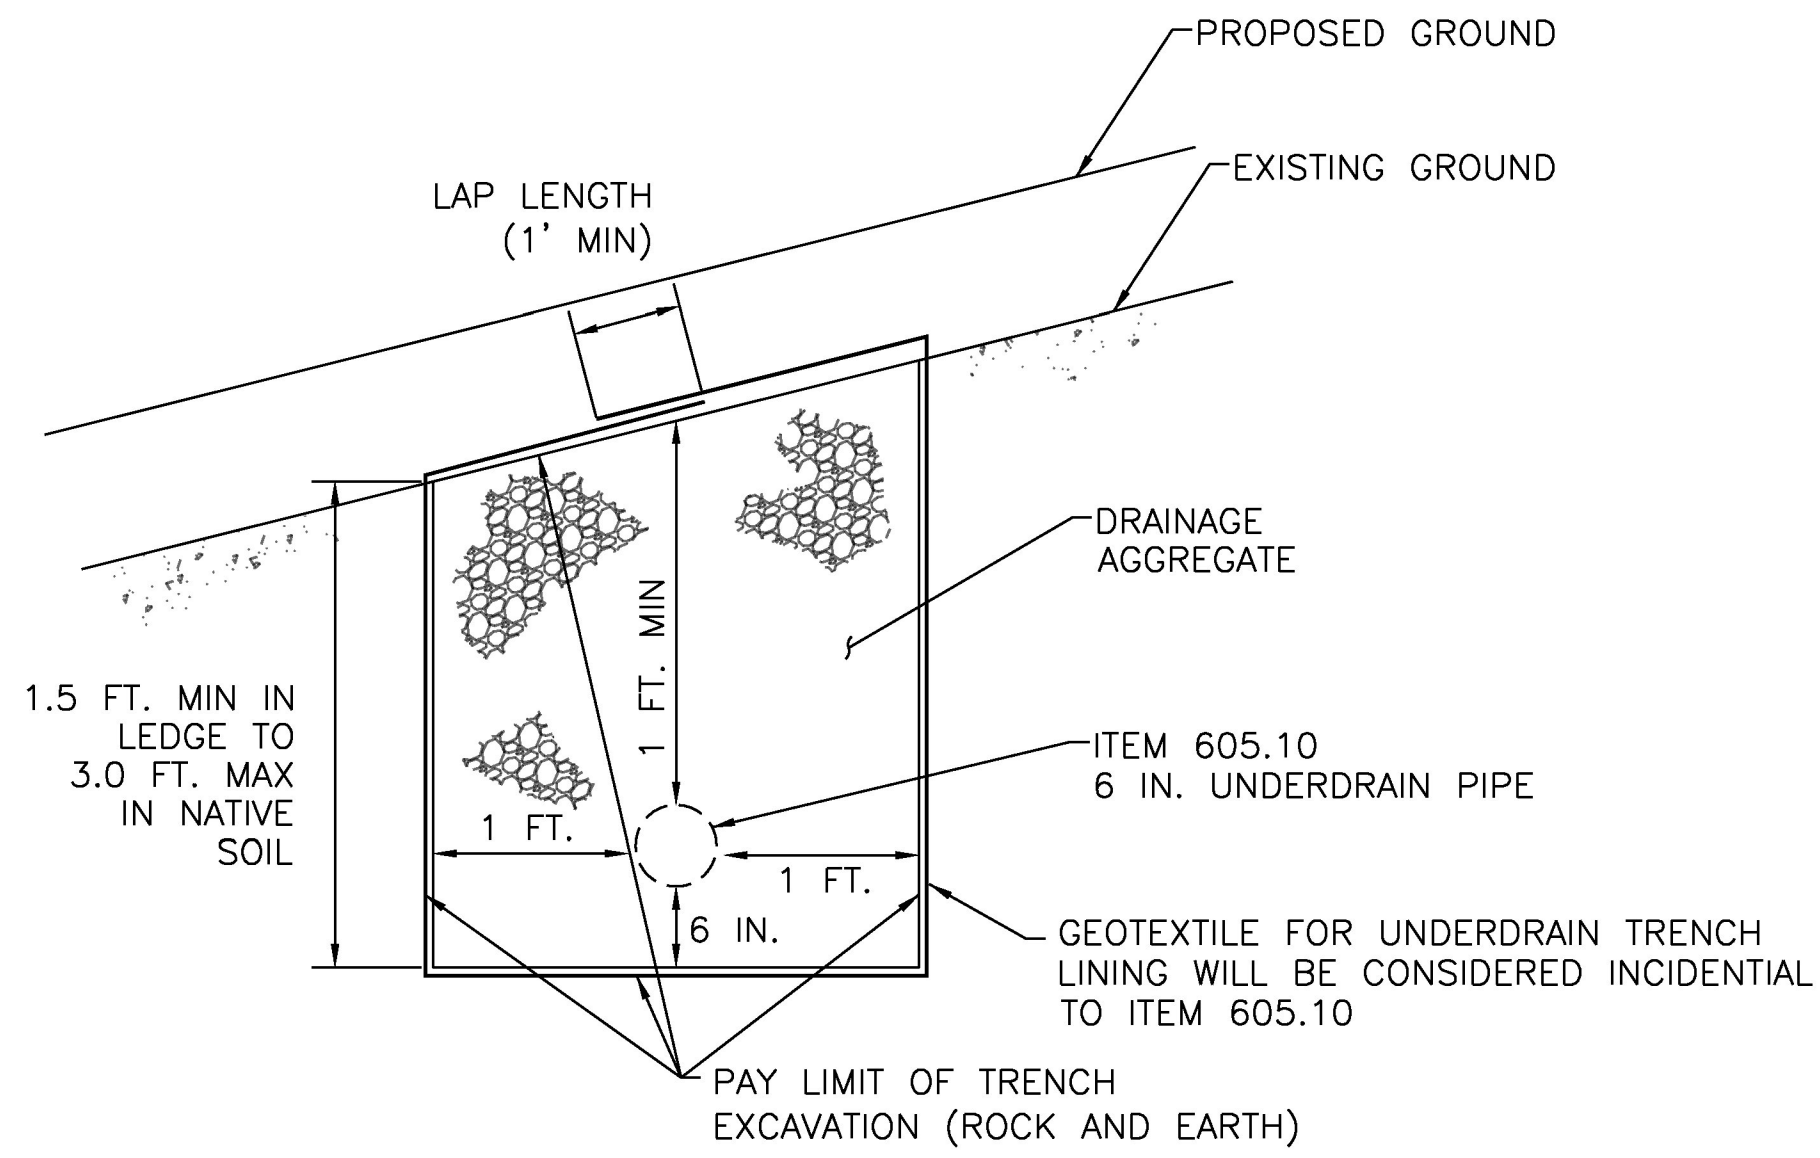


2 **CROSS SLOPE UNDERDRAIN**
N.T.S.

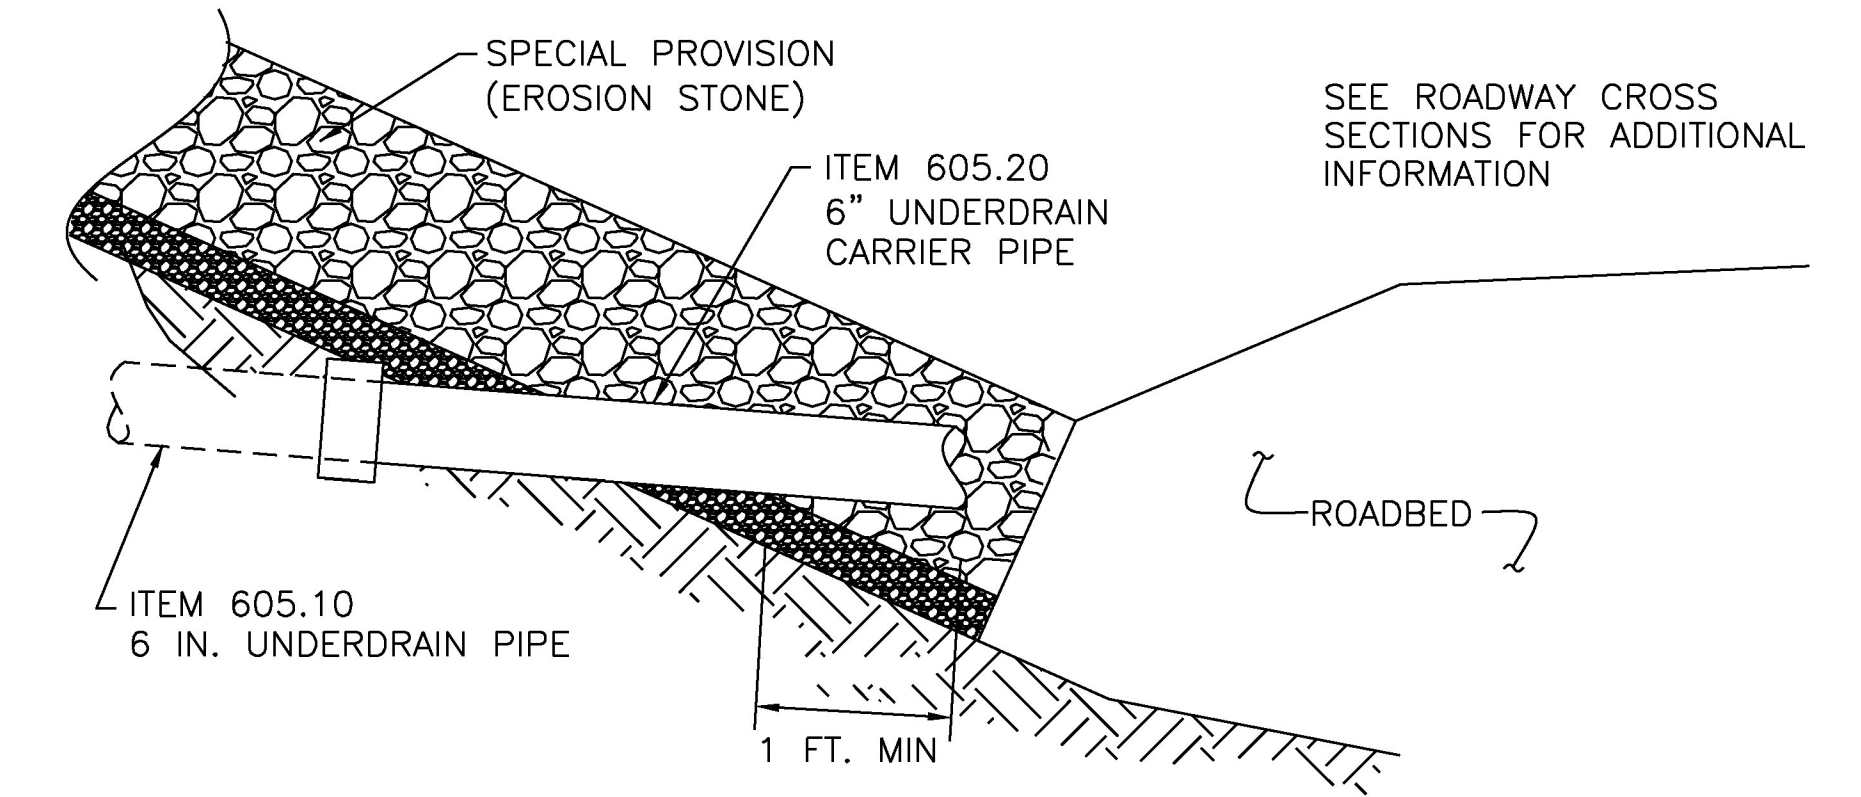

3 **UNDERDRAIN DITCH OUTLET**
N.T.S.

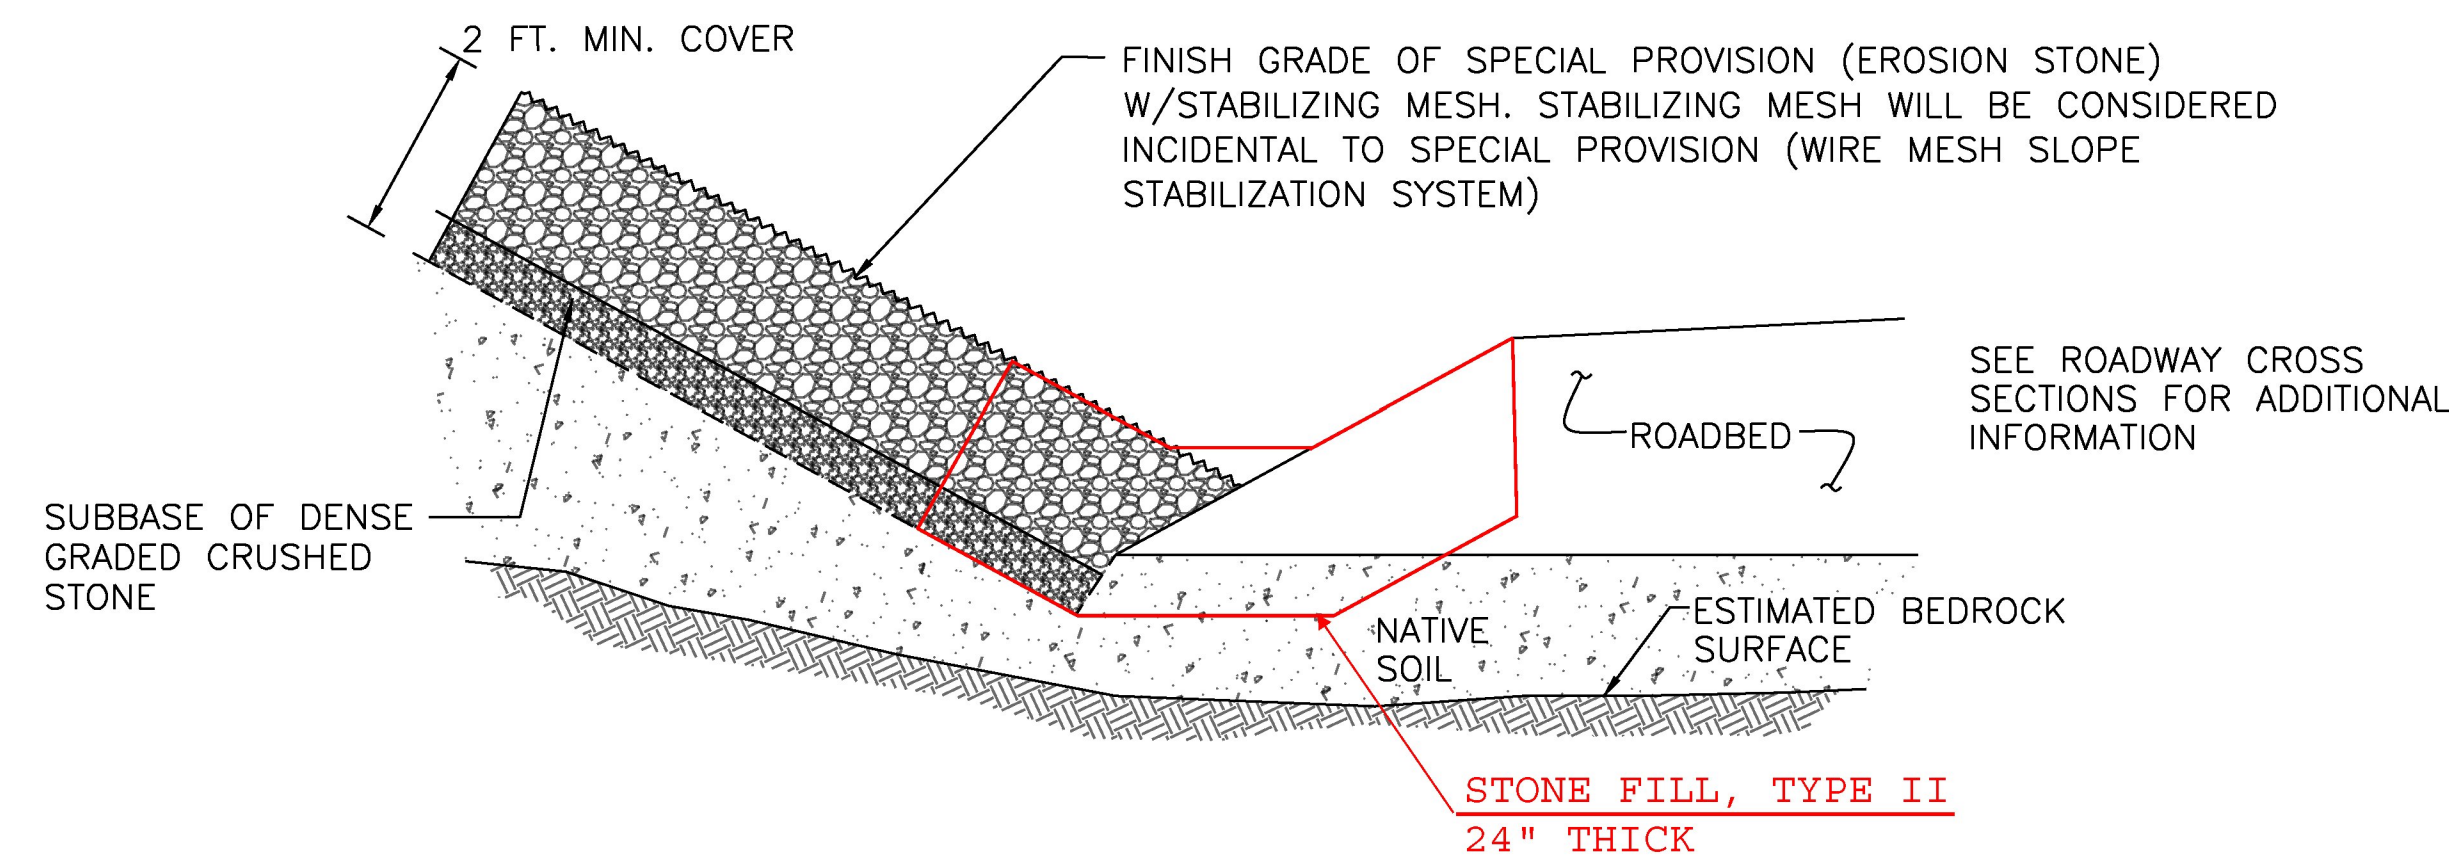

4 **DITCH DETAIL NATIVE SOIL AS BEARING SURFACE**
N.T.S.

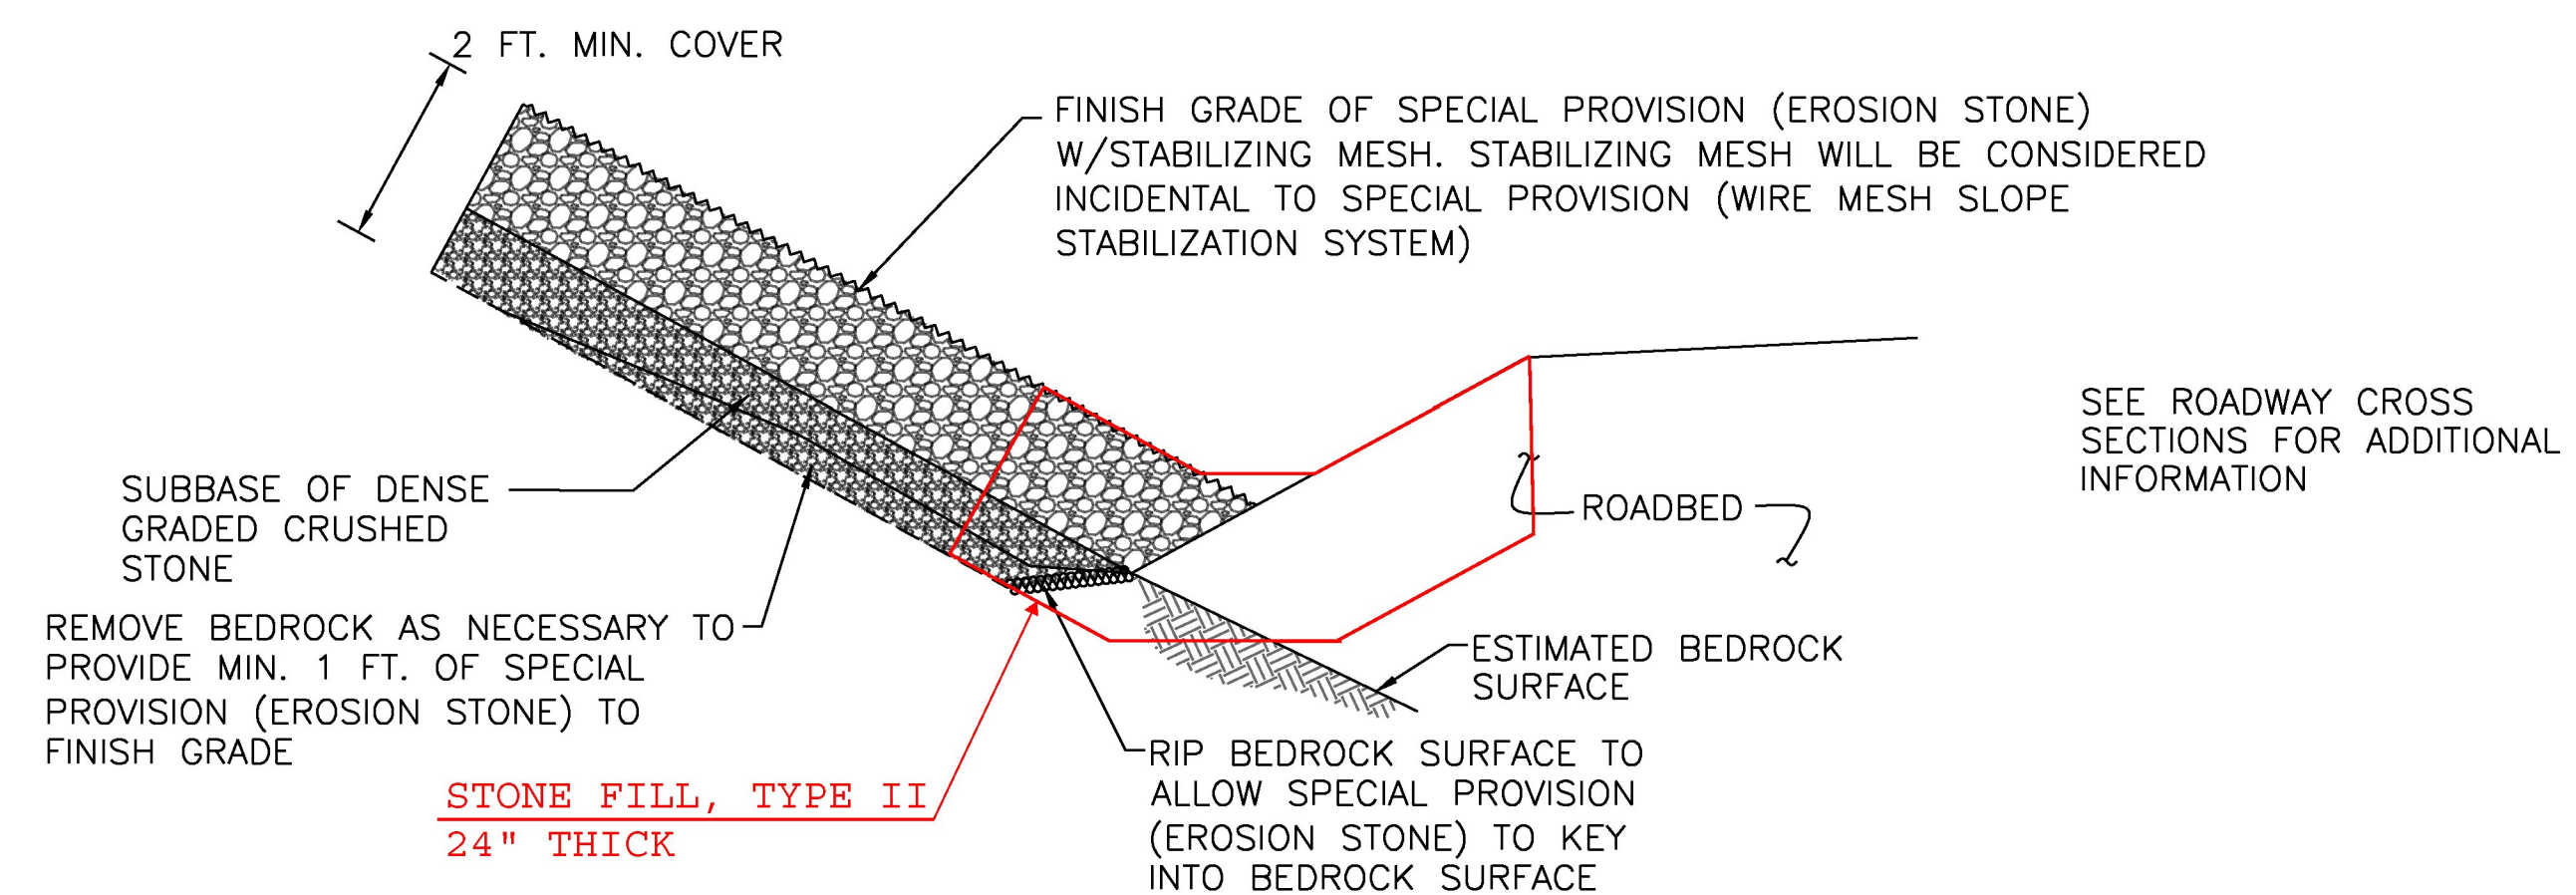

5 **DITCH DETAIL BEDROCK AS BEARING SURFACE**
N.T.S.



PROJECT NAME: PLYMOUTH	PLOT DATE: 5/17/2016
PROJECT NUMBER: ER 0149(6)	DRAWN BY: GOLDER ASSOC.
FILE NAME: I13874IIA006.dgn	CHECKED BY: GOLDER ASSOC.
PROJECT LEADER: J. SANTACRUCE	SHEET 31 OF 68
DESIGNED BY: GOLDER ASSOCIATES	
SLOPE STABILITY DETAILS I	