



TEMPORARY STONE CHECK DAM, TYPE I
 STA 10+75, RT TO STA 16+50, RT
EROSION LOG
 STA 10+75, RT TO STA 11+15, RT
 STA 11+45, RT TO STA 12+77, RT
PROJECT DEMARCATION FENCE
 STA 14+60, LT TO STA 16+50, LT
 STA 10+75, RT TO STA 16+50, RT
INLET PROTECTION DEVICE, TYPE I
 STA 11+15, RT
 STA 12+66, RT
 STA 14+67, RT
 STA 16+07, RT

PREFABRICATED CHECK DAM
 STA 13+00.0, LT
 STA 14+50.0, LT

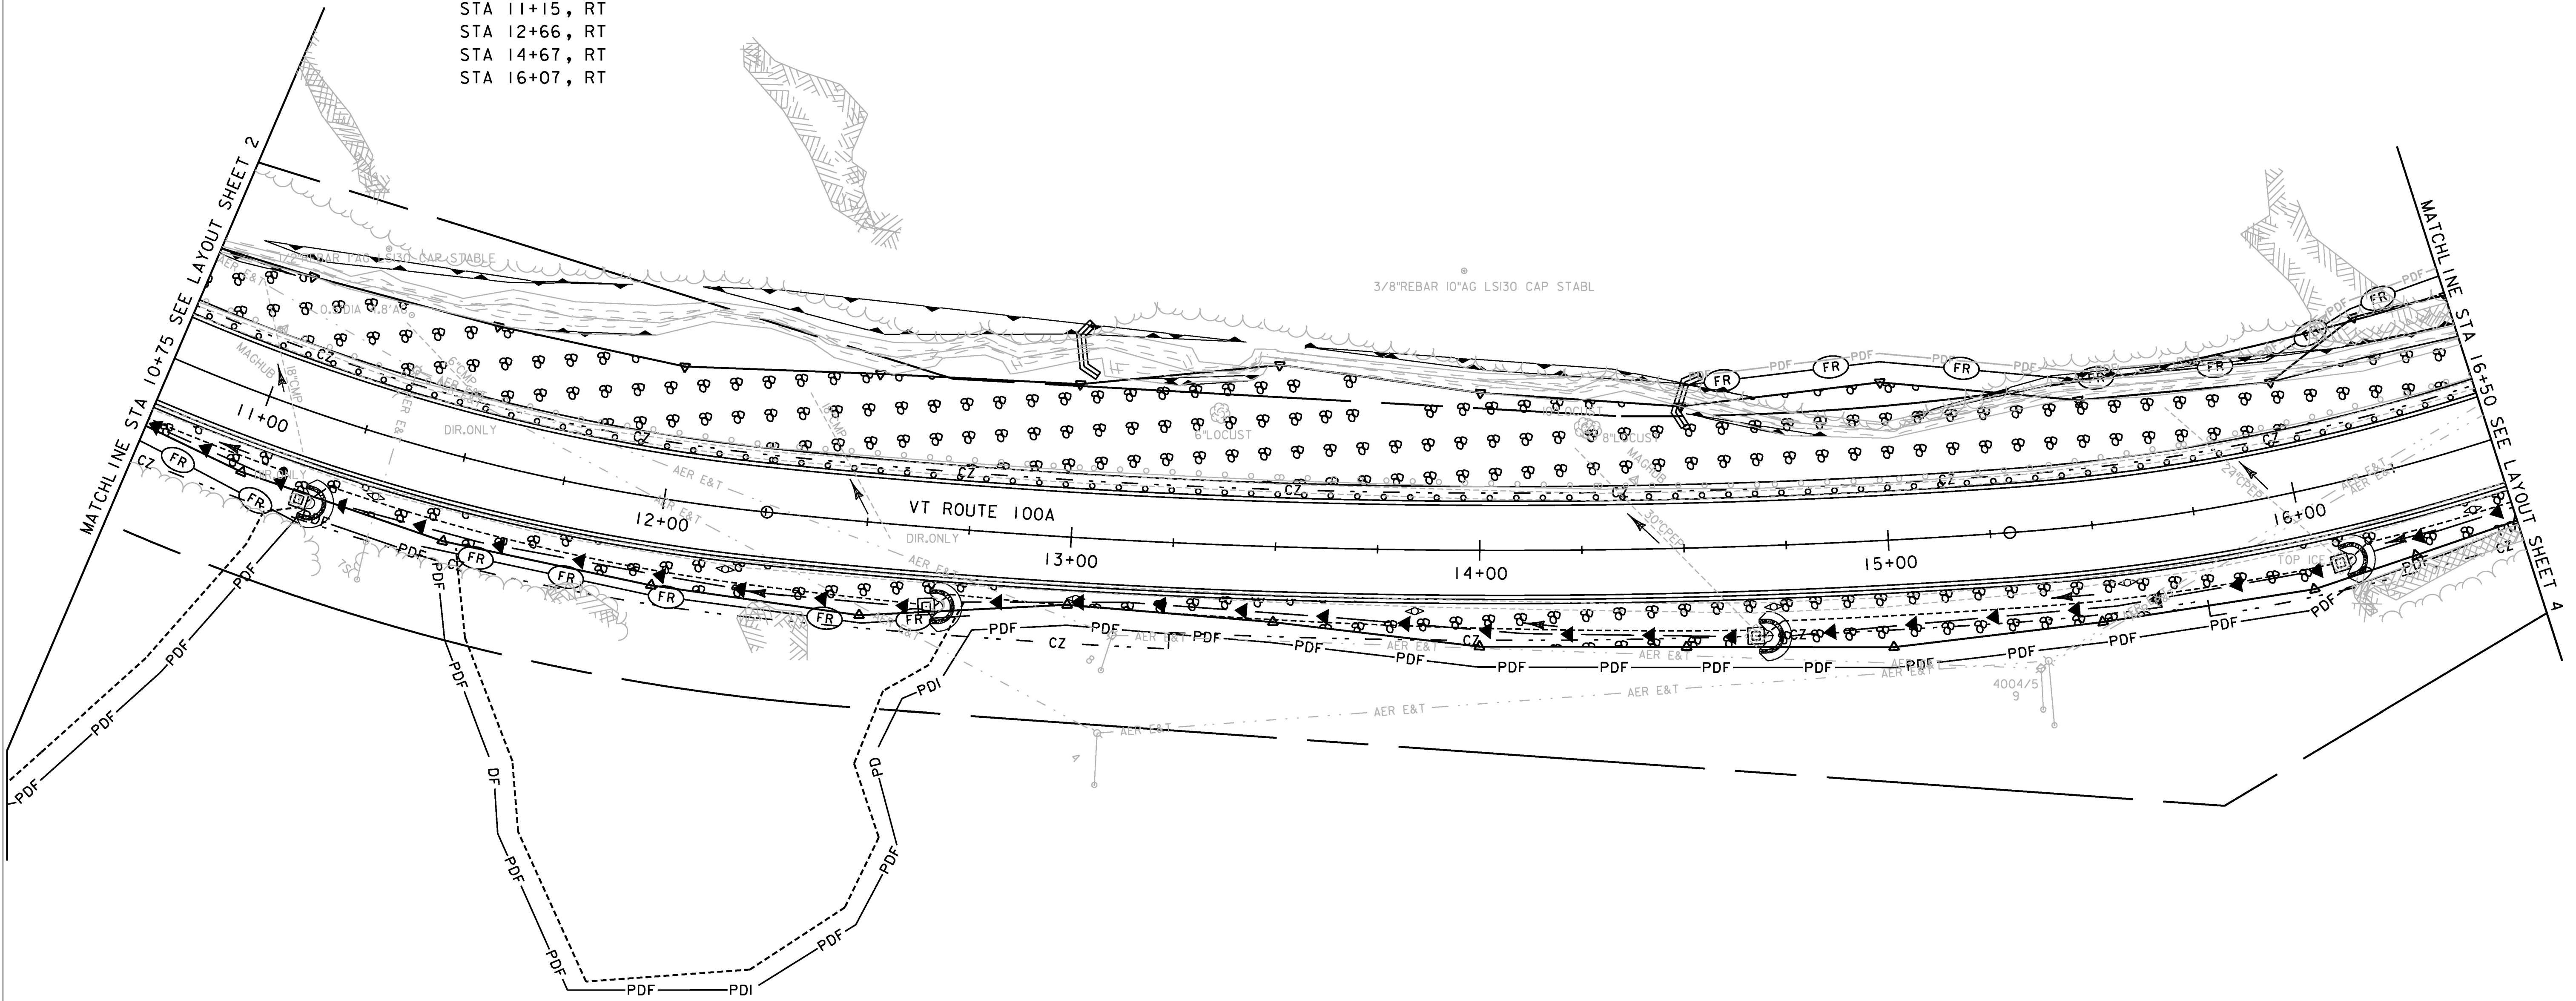

4

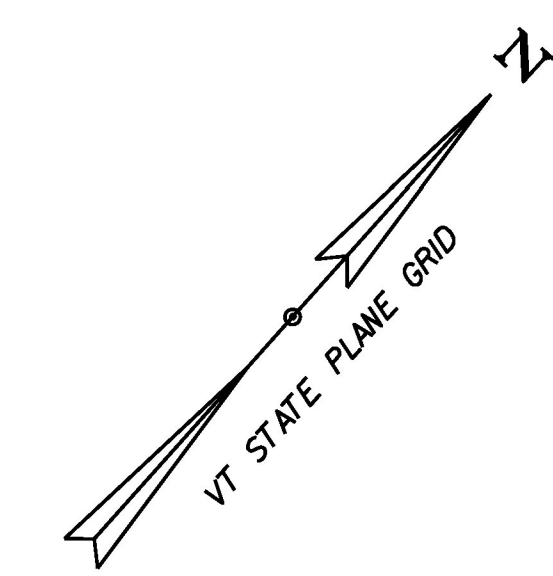

PROJECT NAME: PLYMOUTH	PLOT DATE: 5/17/2016
PROJECT NUMBER: ER 0149(6)	DRAWN BY: M. LOVETT
FILE NAME: z13c318bdr_ero.dgn	CHECKED BY: B. COLBURN
PROJECT LEADER: J.SANTACRUCE	SHEET 41 OF 68
DESIGNED BY: M.HASKINS	
EPSC CONSTRUCTION LAYOUT SHEET 3	