




8+50

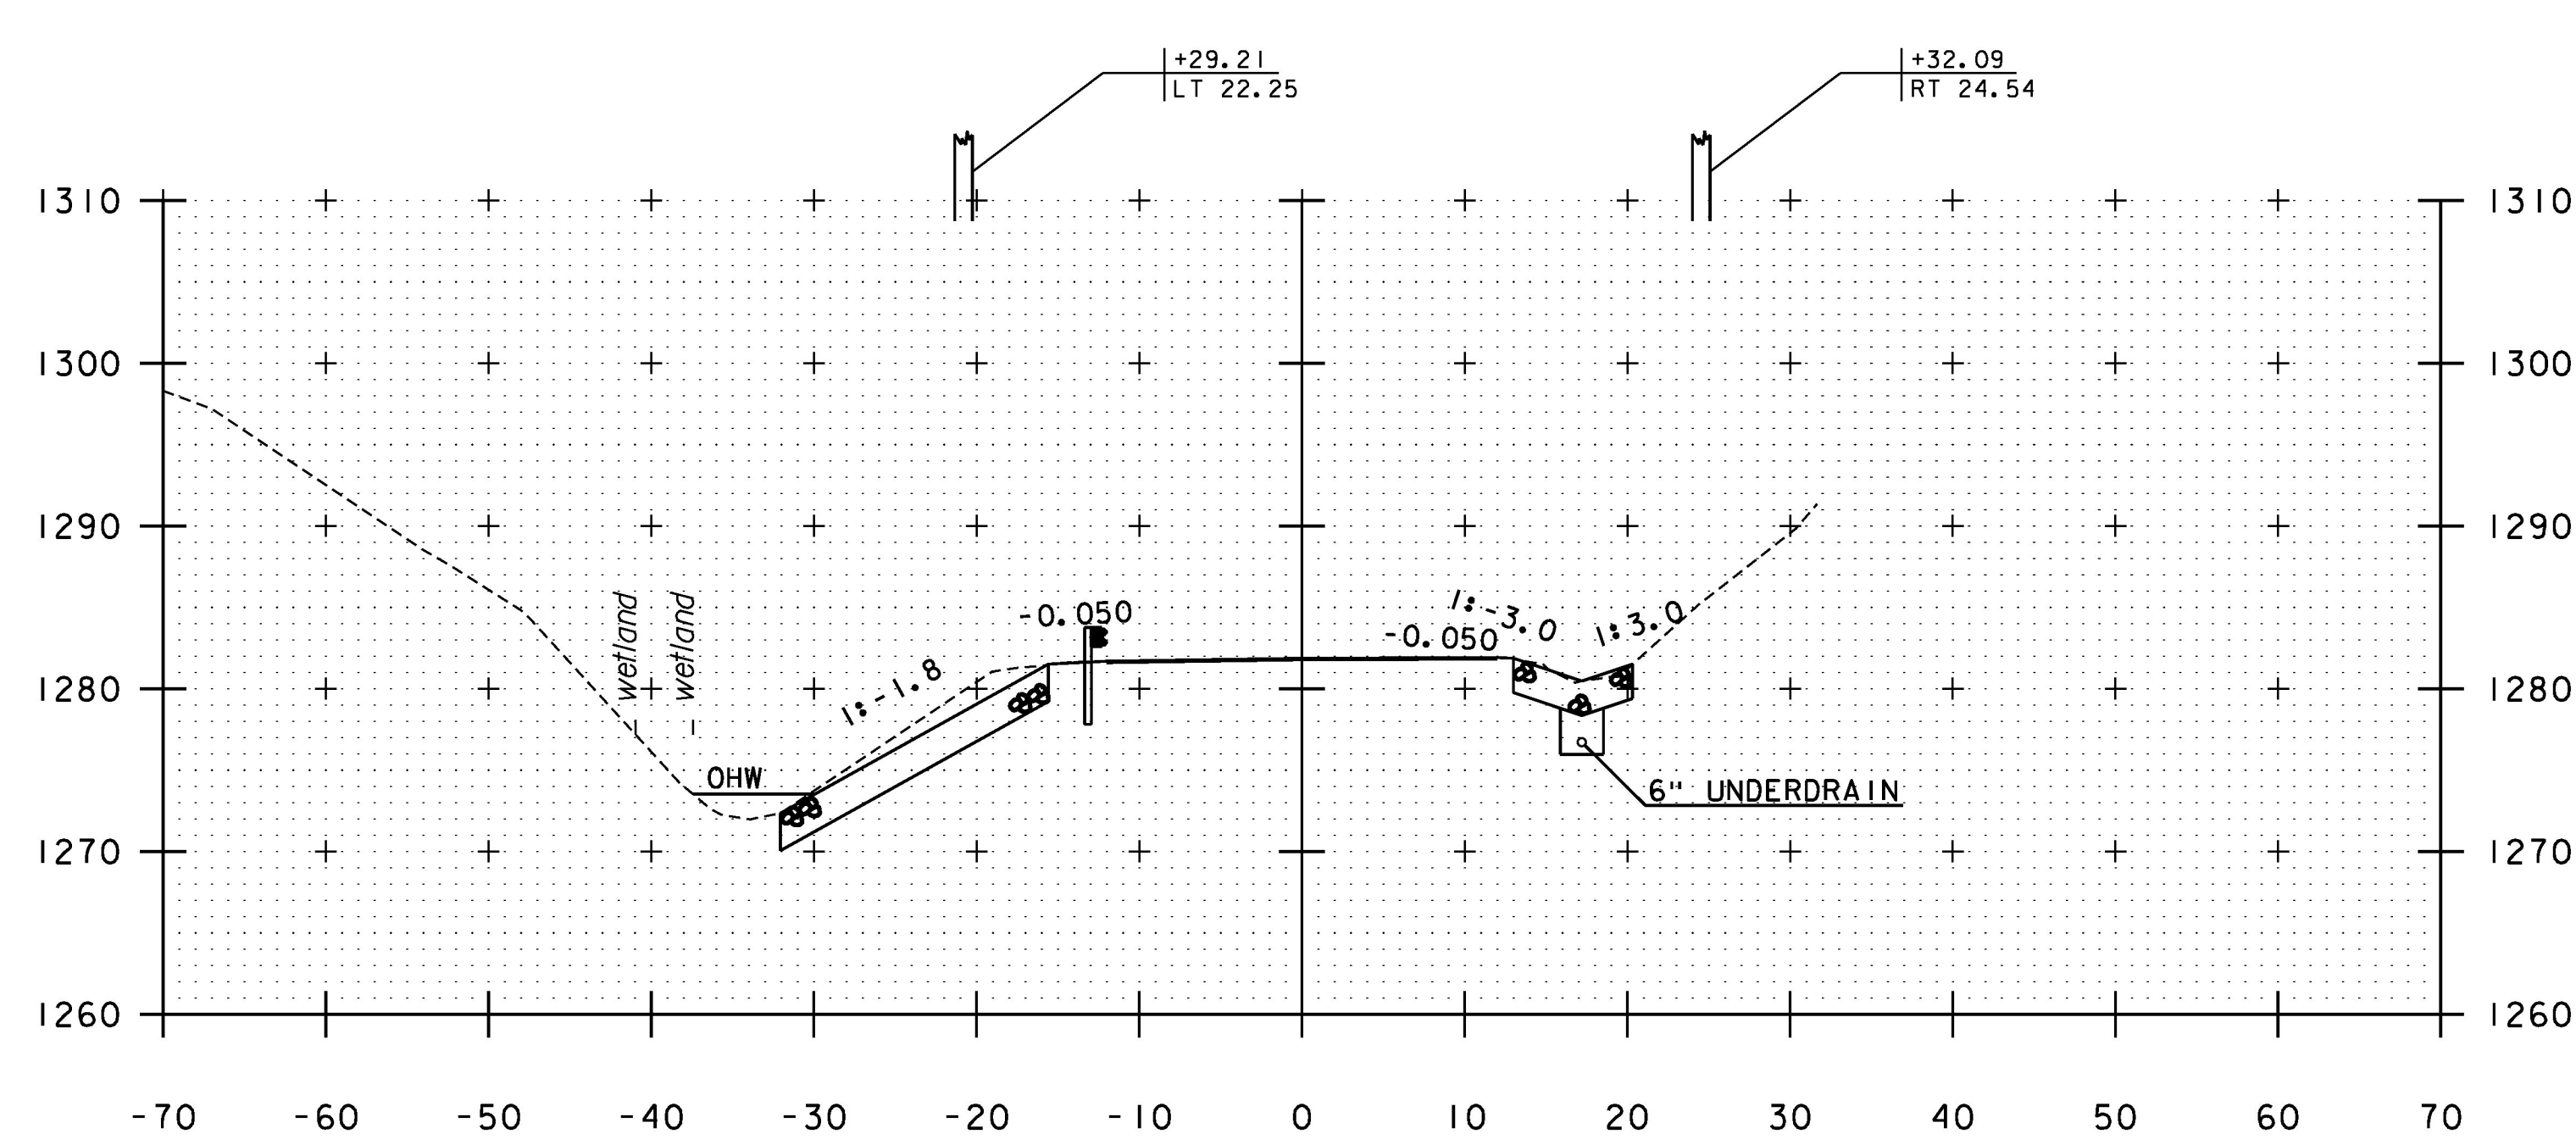

9+50

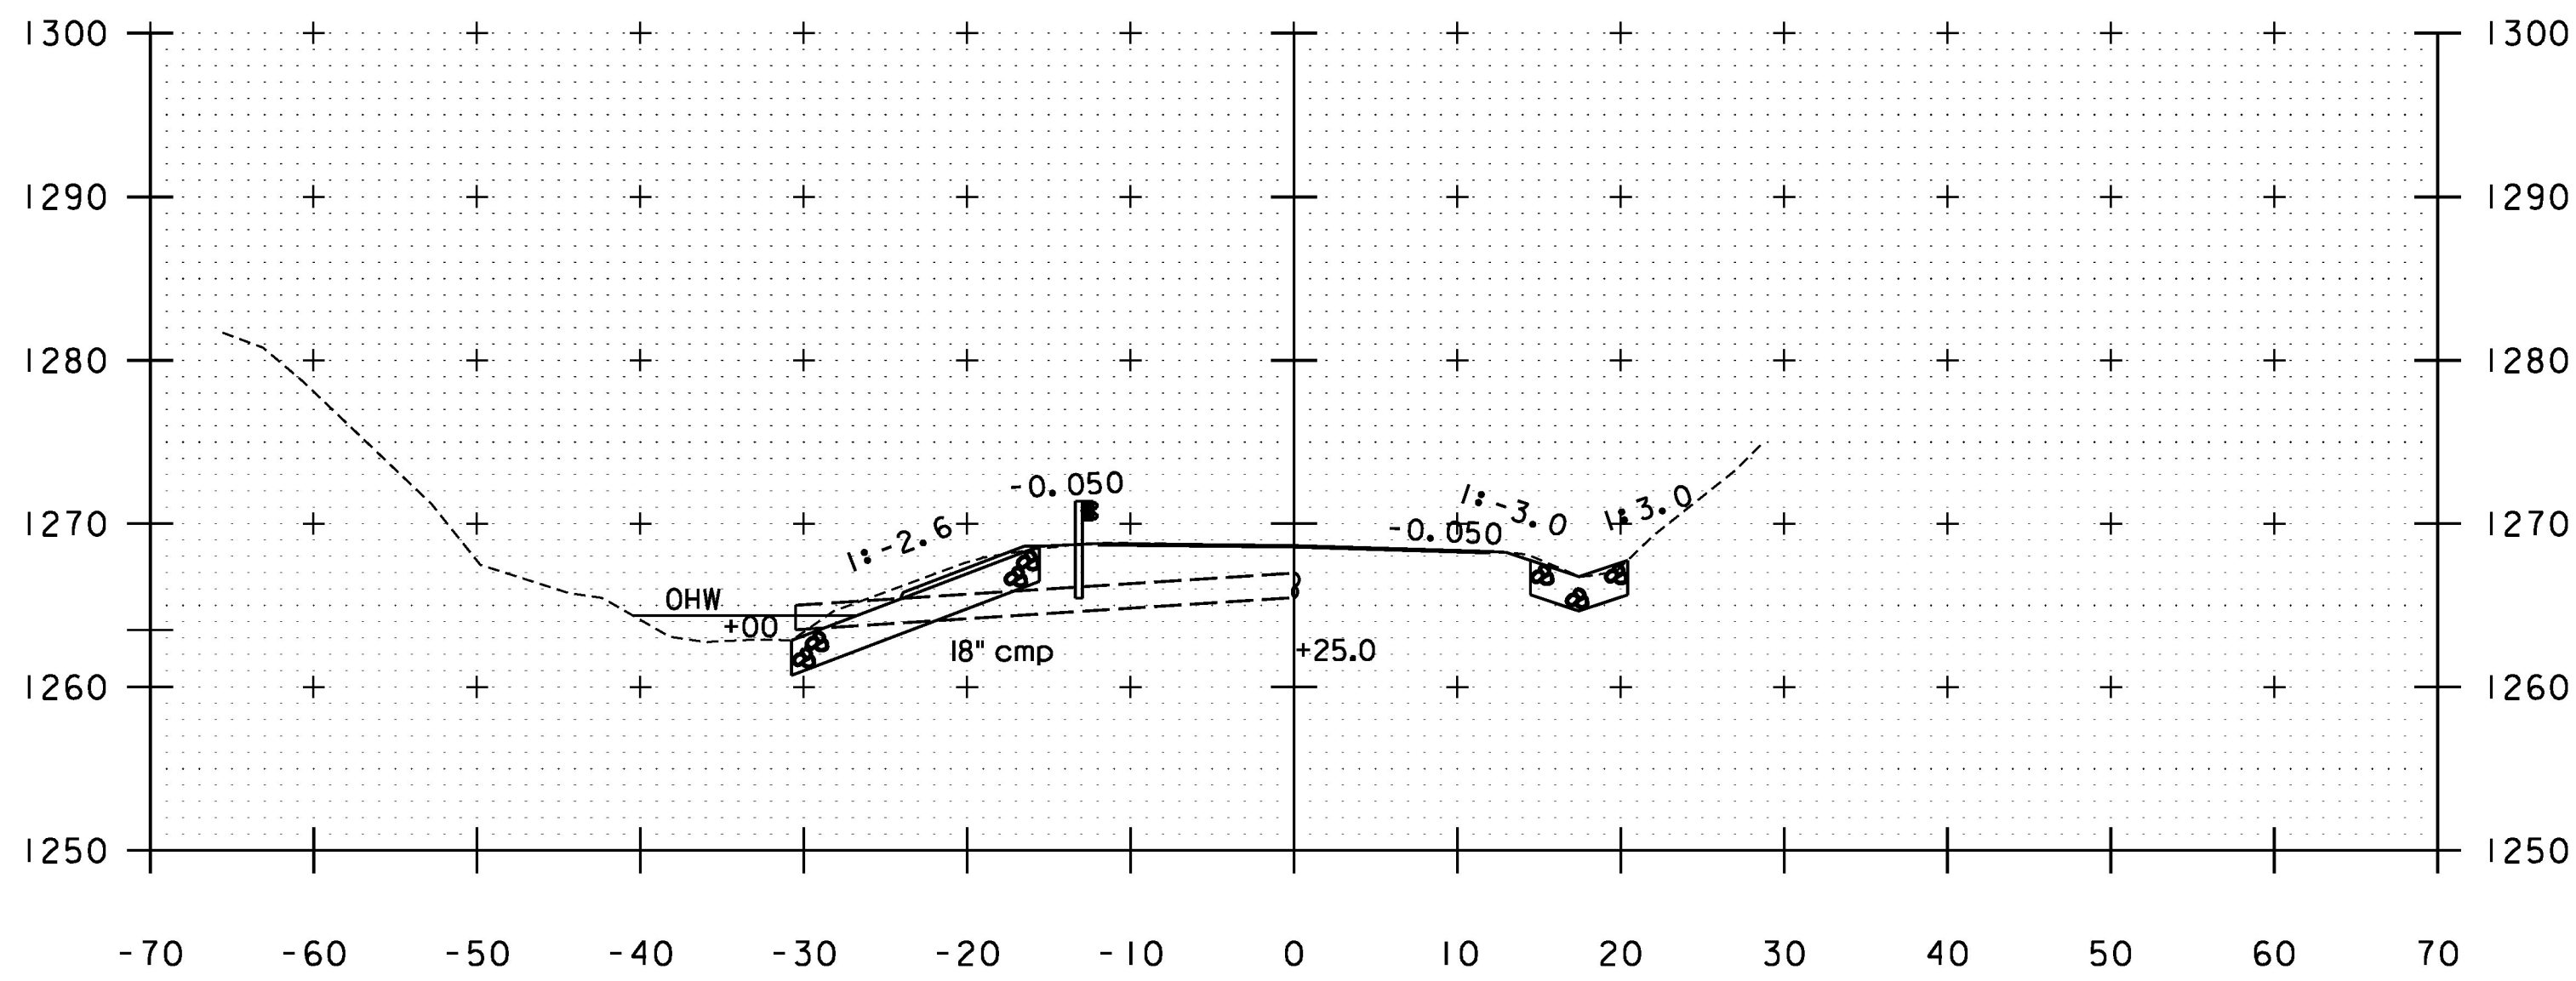

8+00

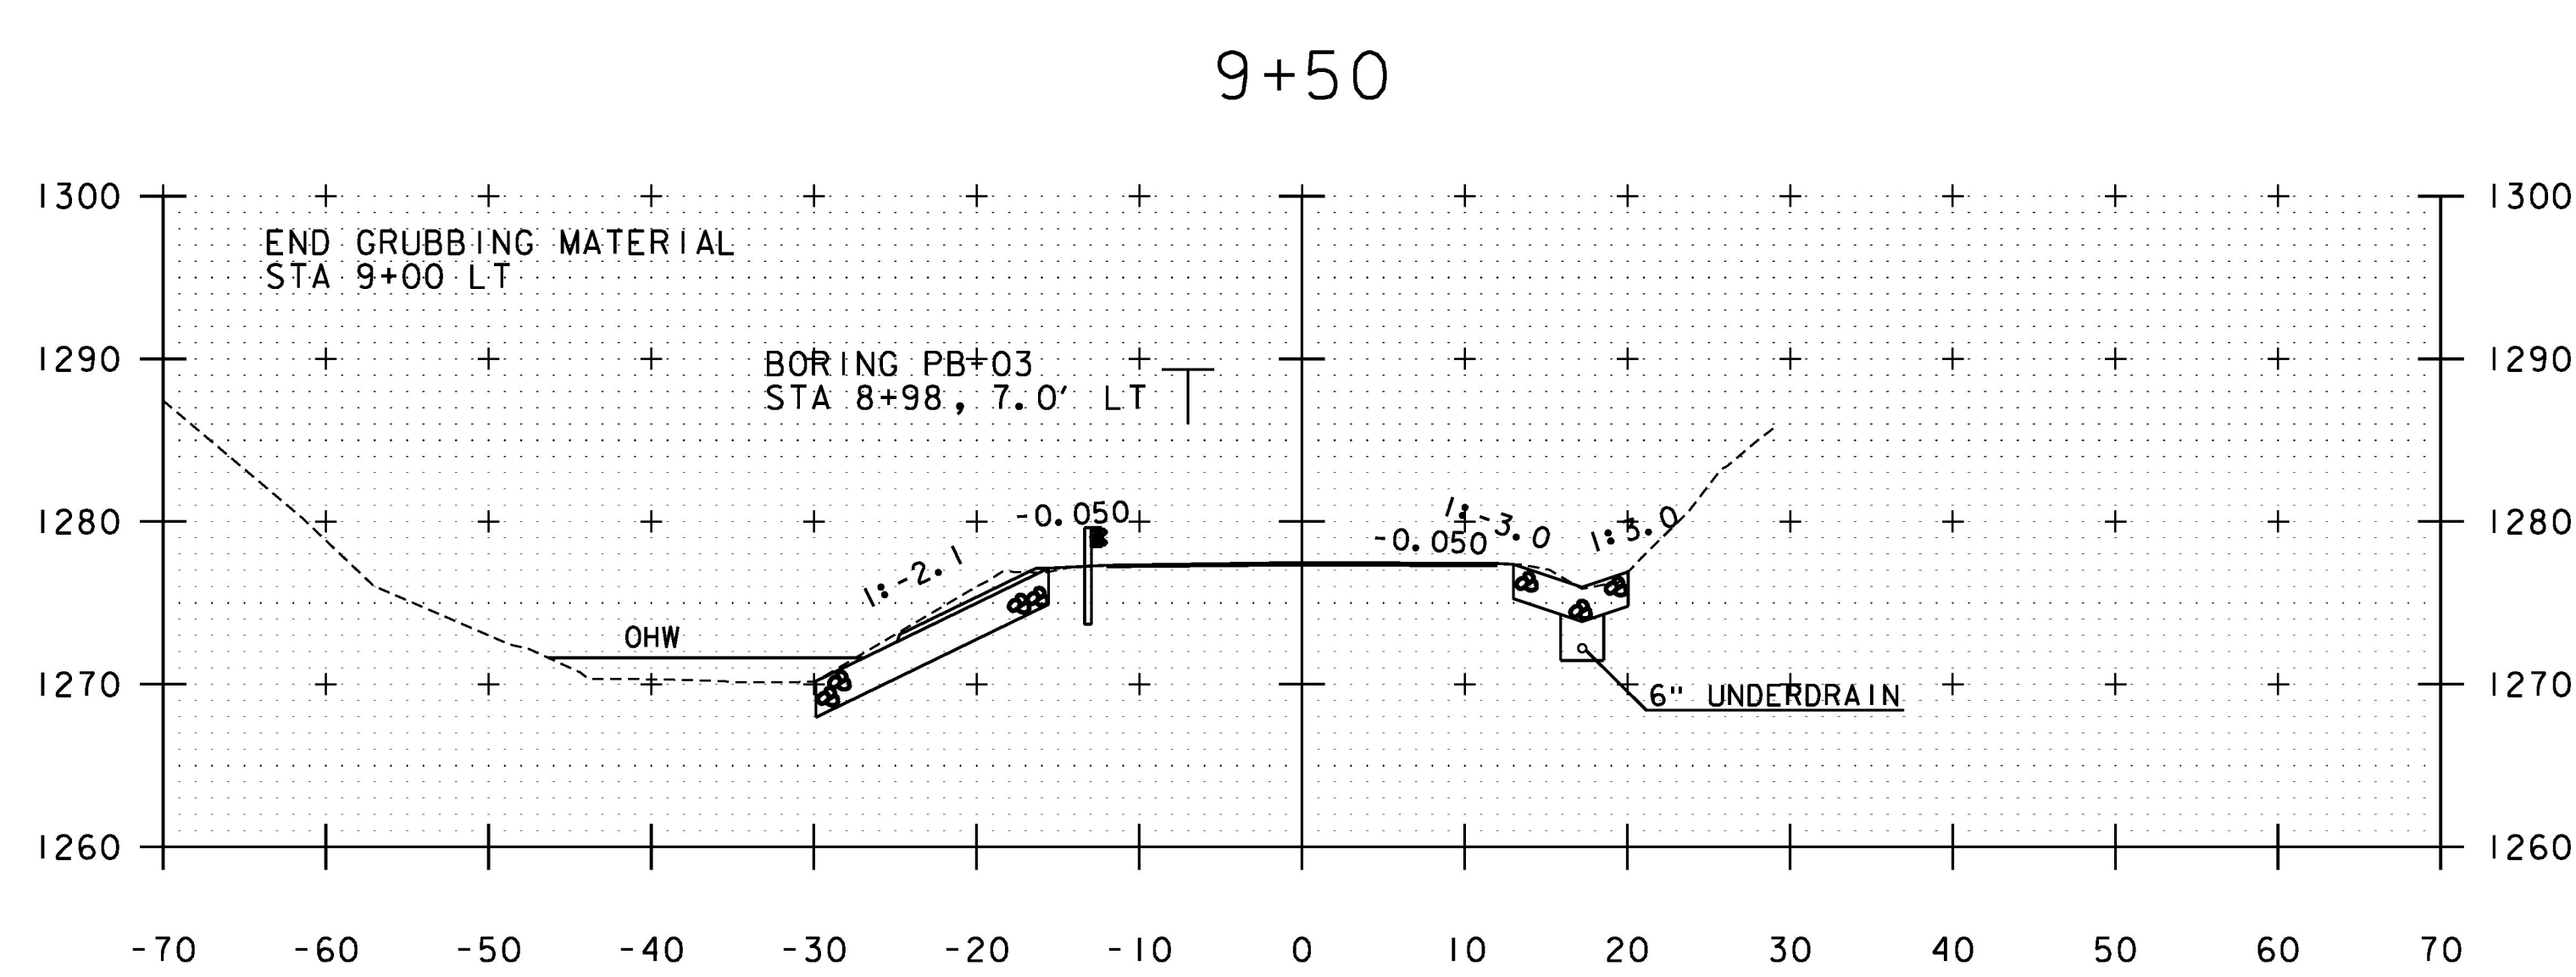

9+00

SCALE IN FEET



PROJECT NAME: PLYMOUTH	PLOT DATE: 5/17/2016
PROJECT NUMBER: ER 0149(6)	DRAWN BY: M. LOVETT
FILE NAME: z13c318xsl.dgn	CHECKED BY: B. COLBURN
PROJECT LEADER: J. SANTACRUCE	SHEET 54 OF 68
DESIGNED BY: M. HASKINS	
VT ROUTE 100A CROSS SECTIONS 3	