




14+50

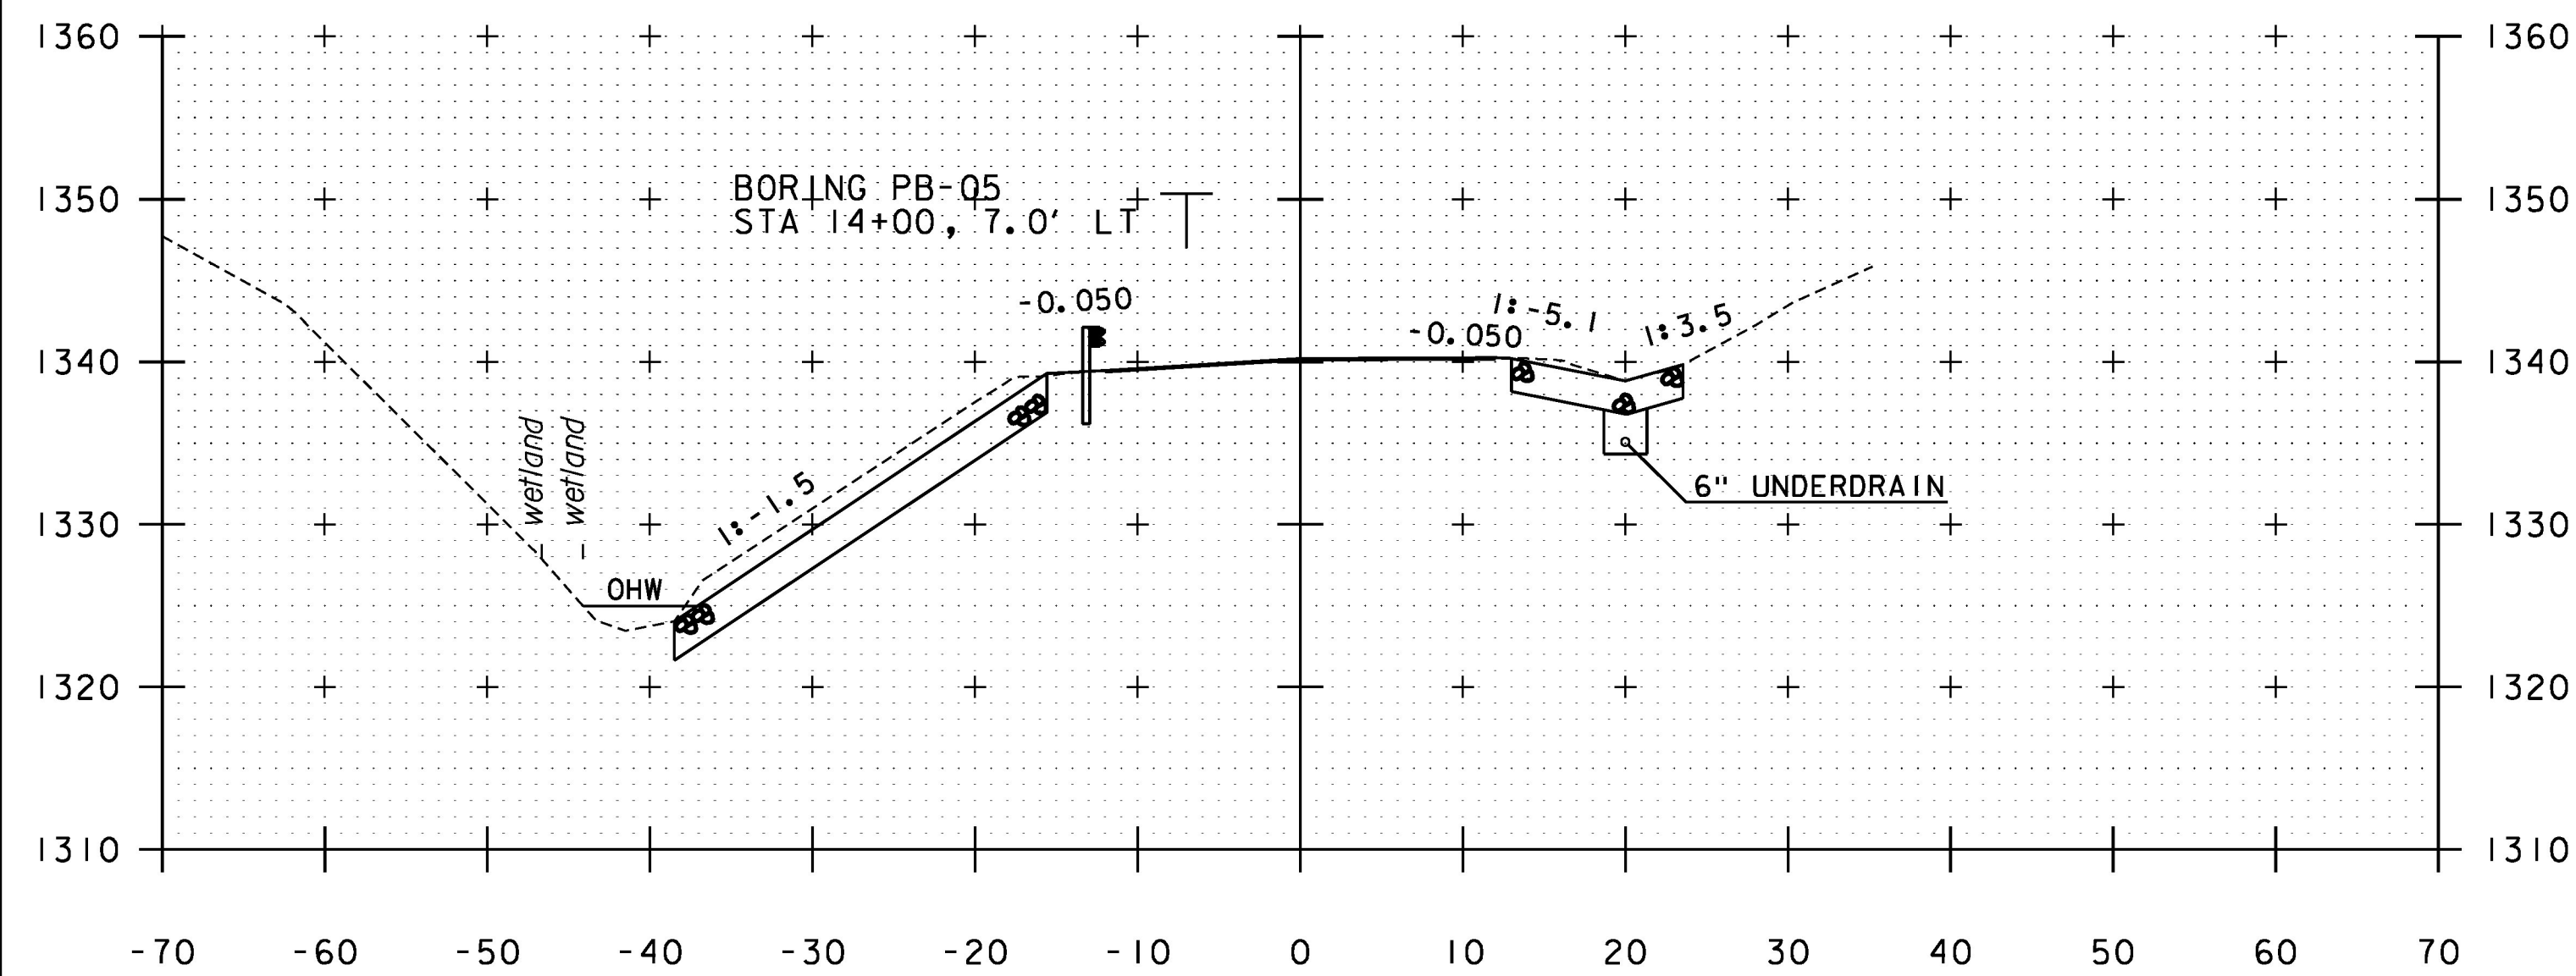

14+00

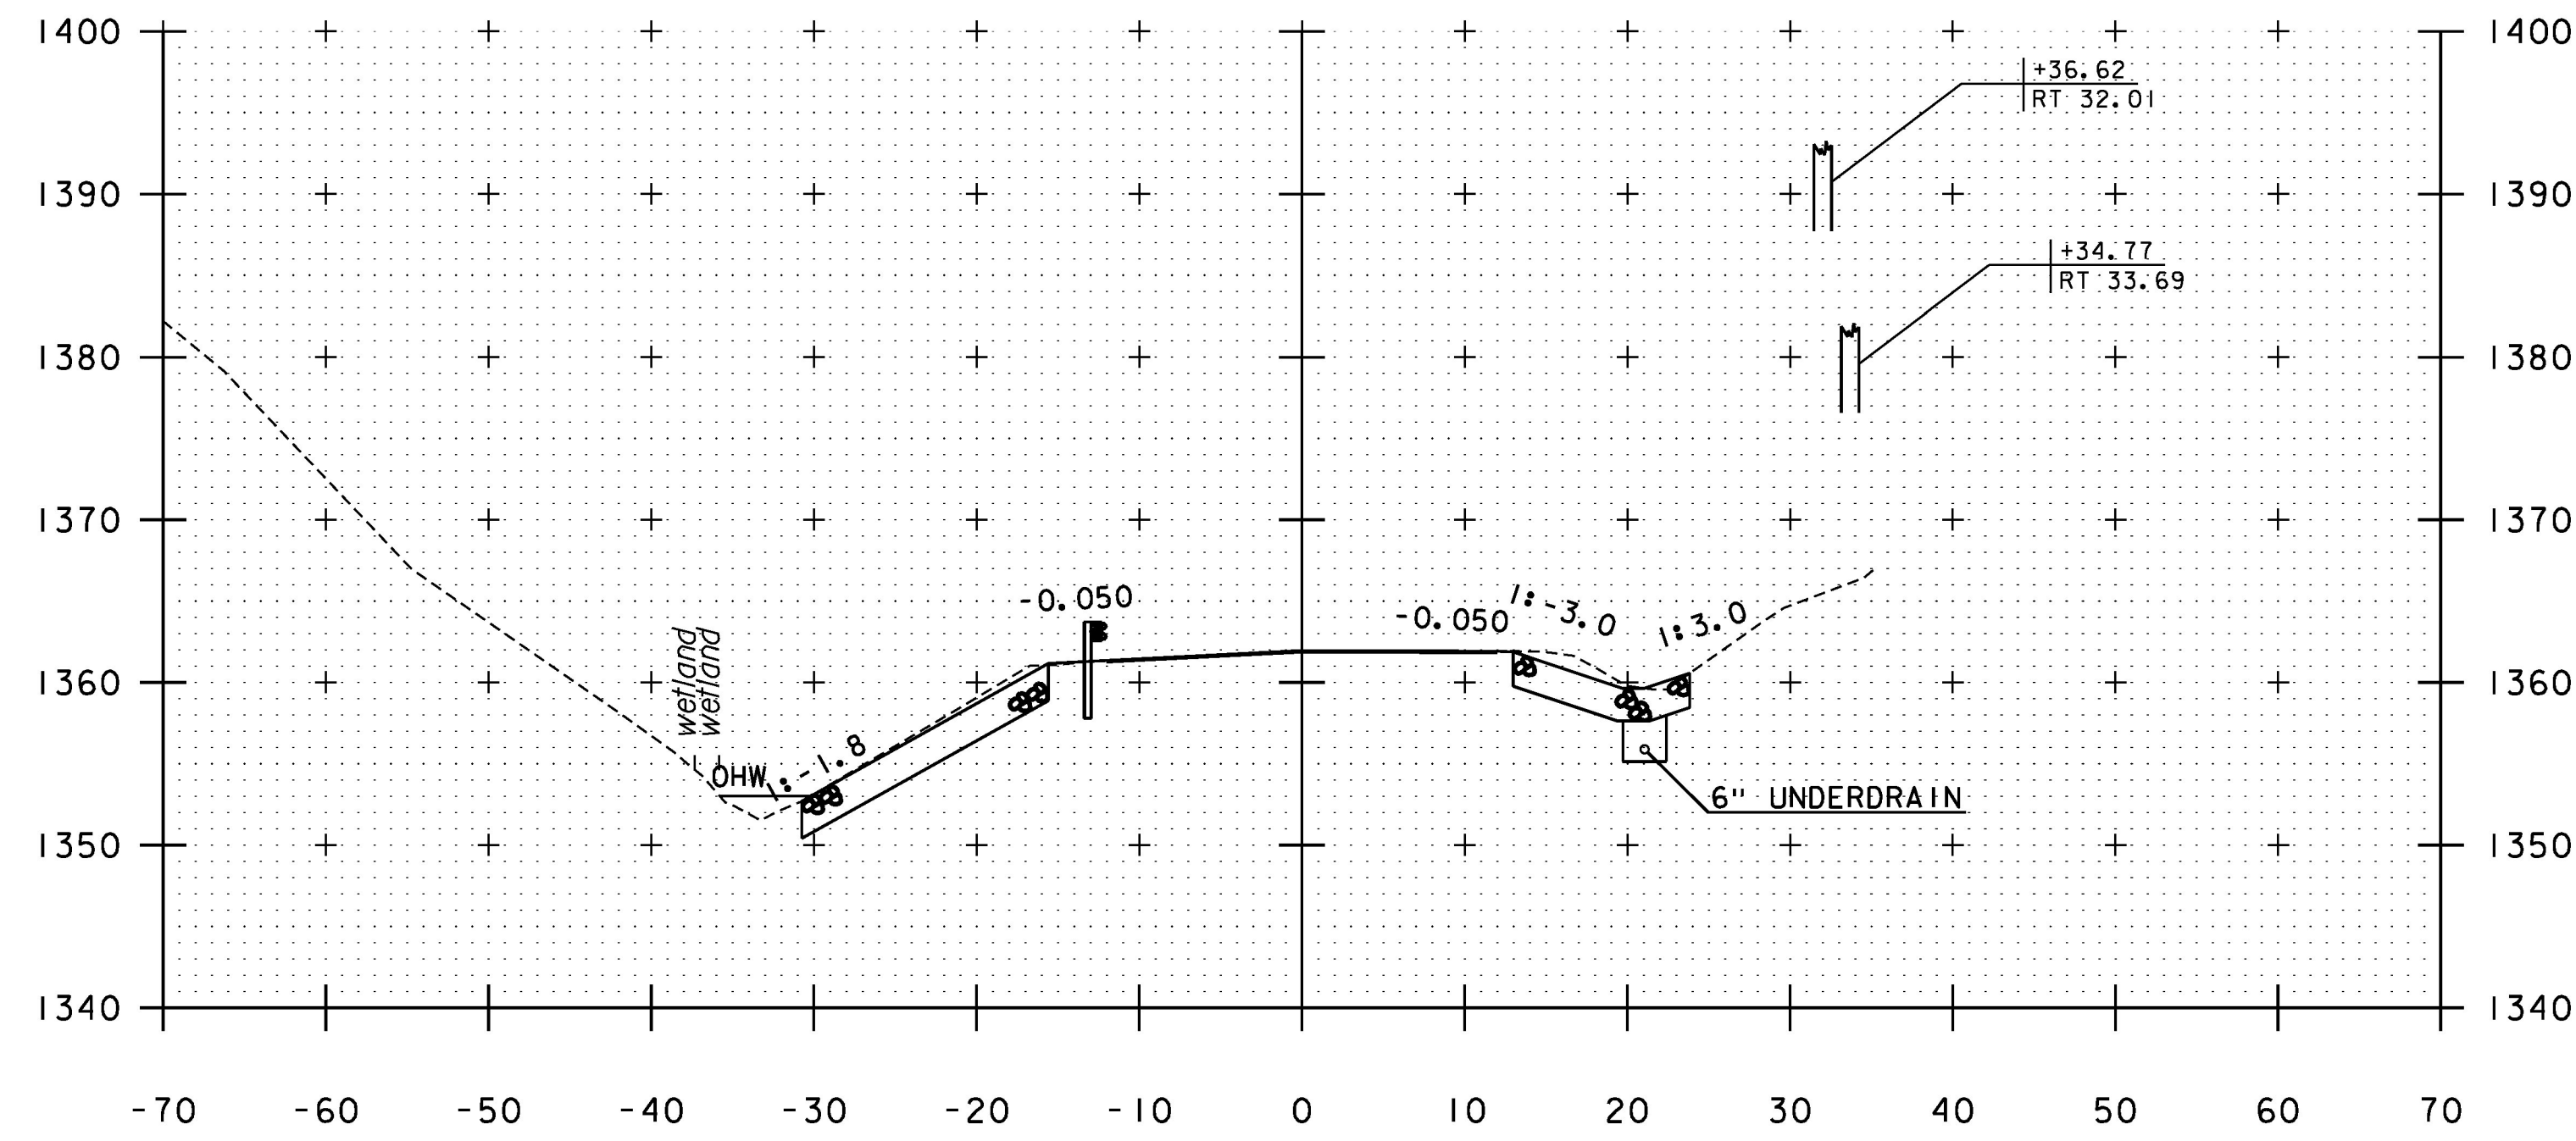

15+50

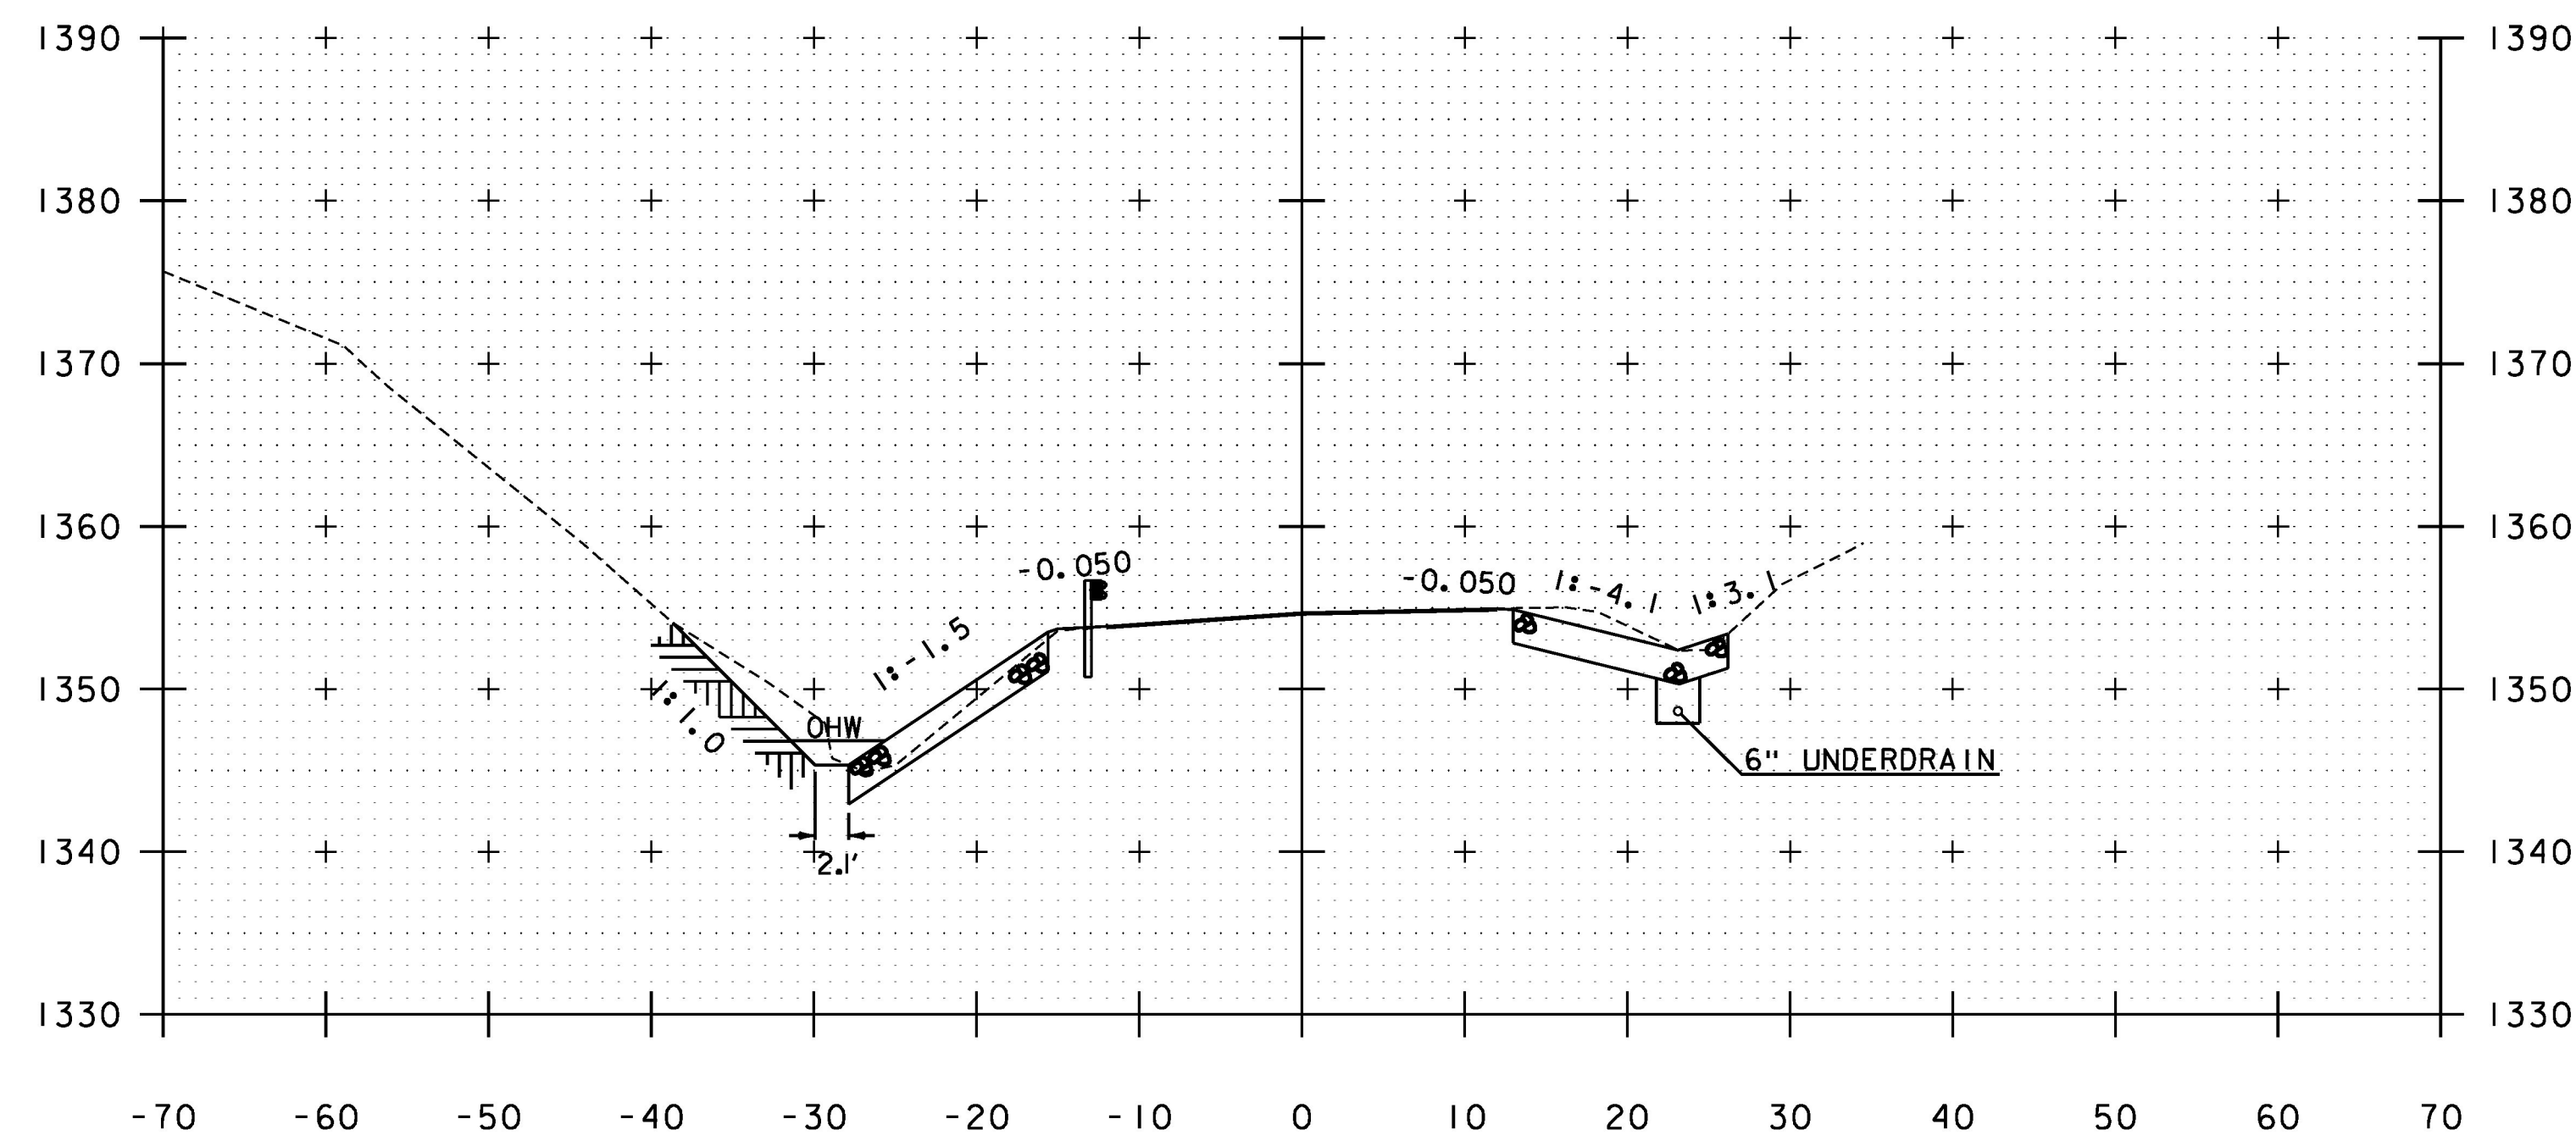

15+00

SCALE IN FEET



PROJECT NAME: PLYMOUTH	FILE NAME: z13c318xsl.dgn	PLOT DATE: 5/17/2016
PROJECT NUMBER: ER 0149(6)	PROJECT LEADER: J. SANTACRUCE	DRAWN BY: M. LOVETT
	DESIGNED BY: M. HASKINS	CHECKED BY: B. COLBURN
	VT ROUTE 100A CROSS SECTIONS 6	SHEET 57 OF 68