


10+75



11+00

SCALE IN FEET

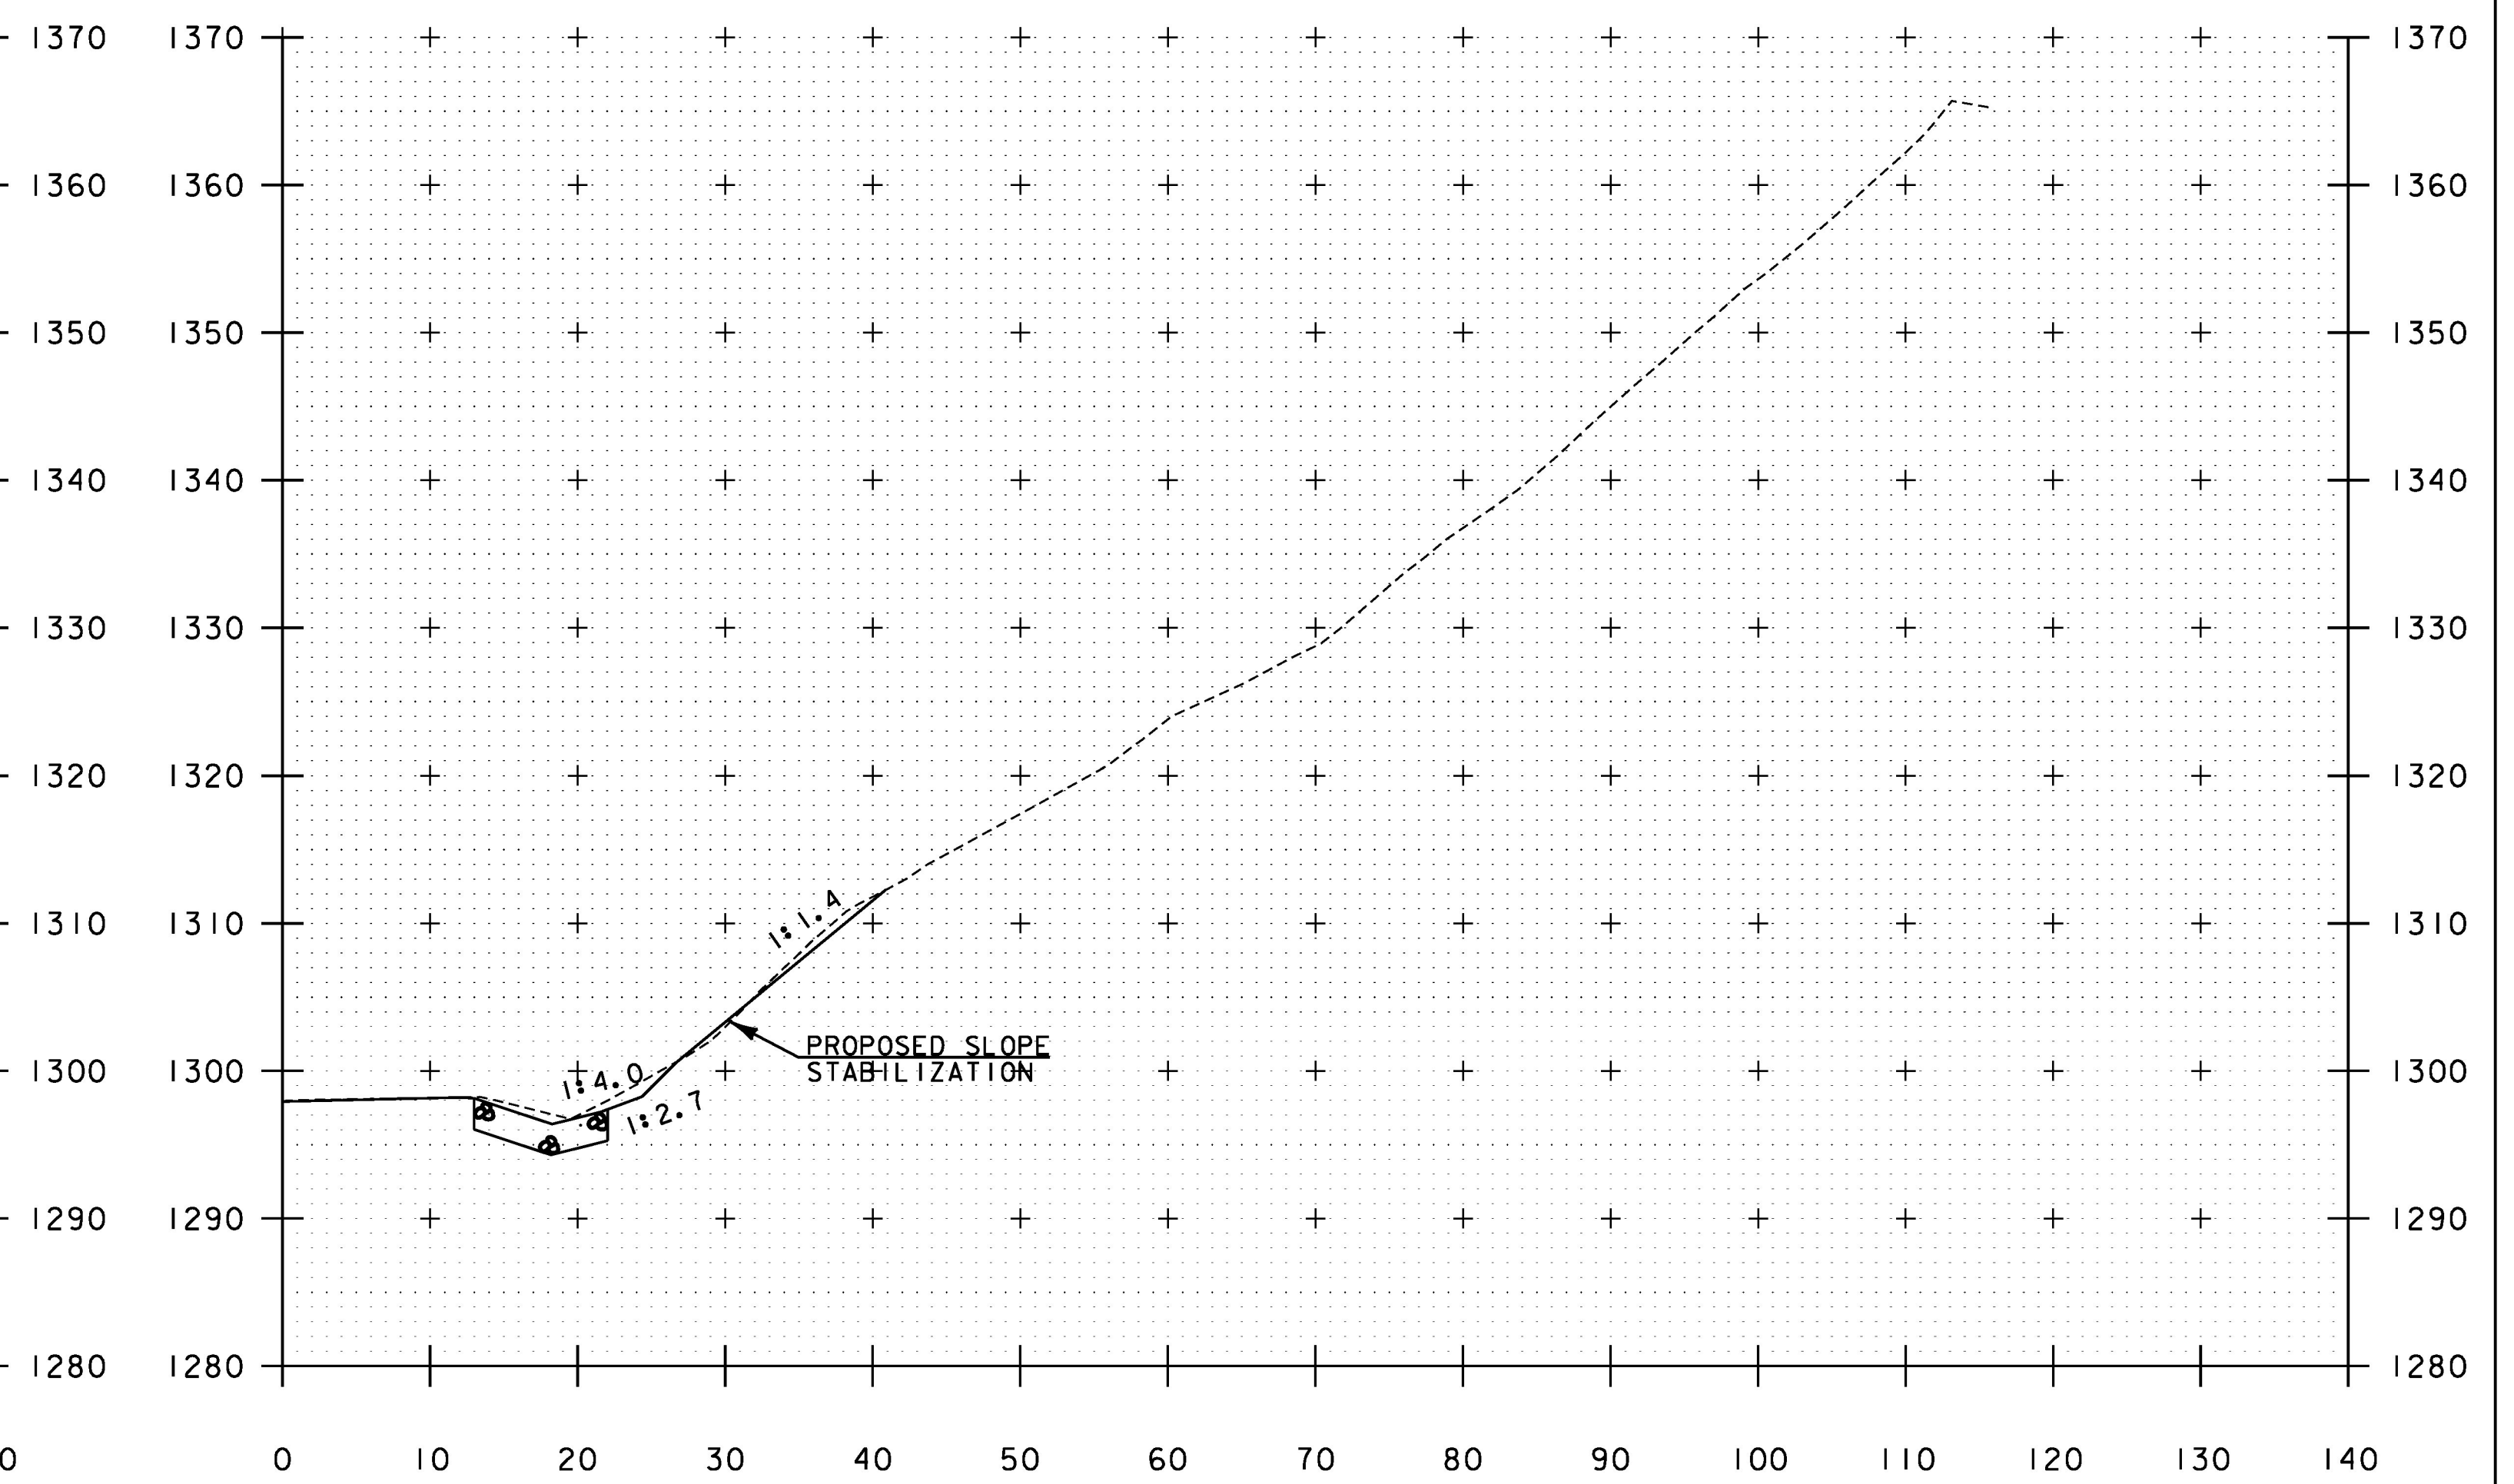

PROJECT NAME: PLYMOUTH	
PROJECT NUMBER: ER 0149(6)	
FILE NAME: z13c318xsl.dgn	PLOT DATE: 5/17/2016
PROJECT LEADER: J. SANTACRUCE	DRAWN BY: M. LOVETT
DESIGNED BY: M. HASKINS	CHECKED BY: B. COLBURN
SLOPE STABILITY CROSS SECTIONS 3	SHEET 64 OF 68